
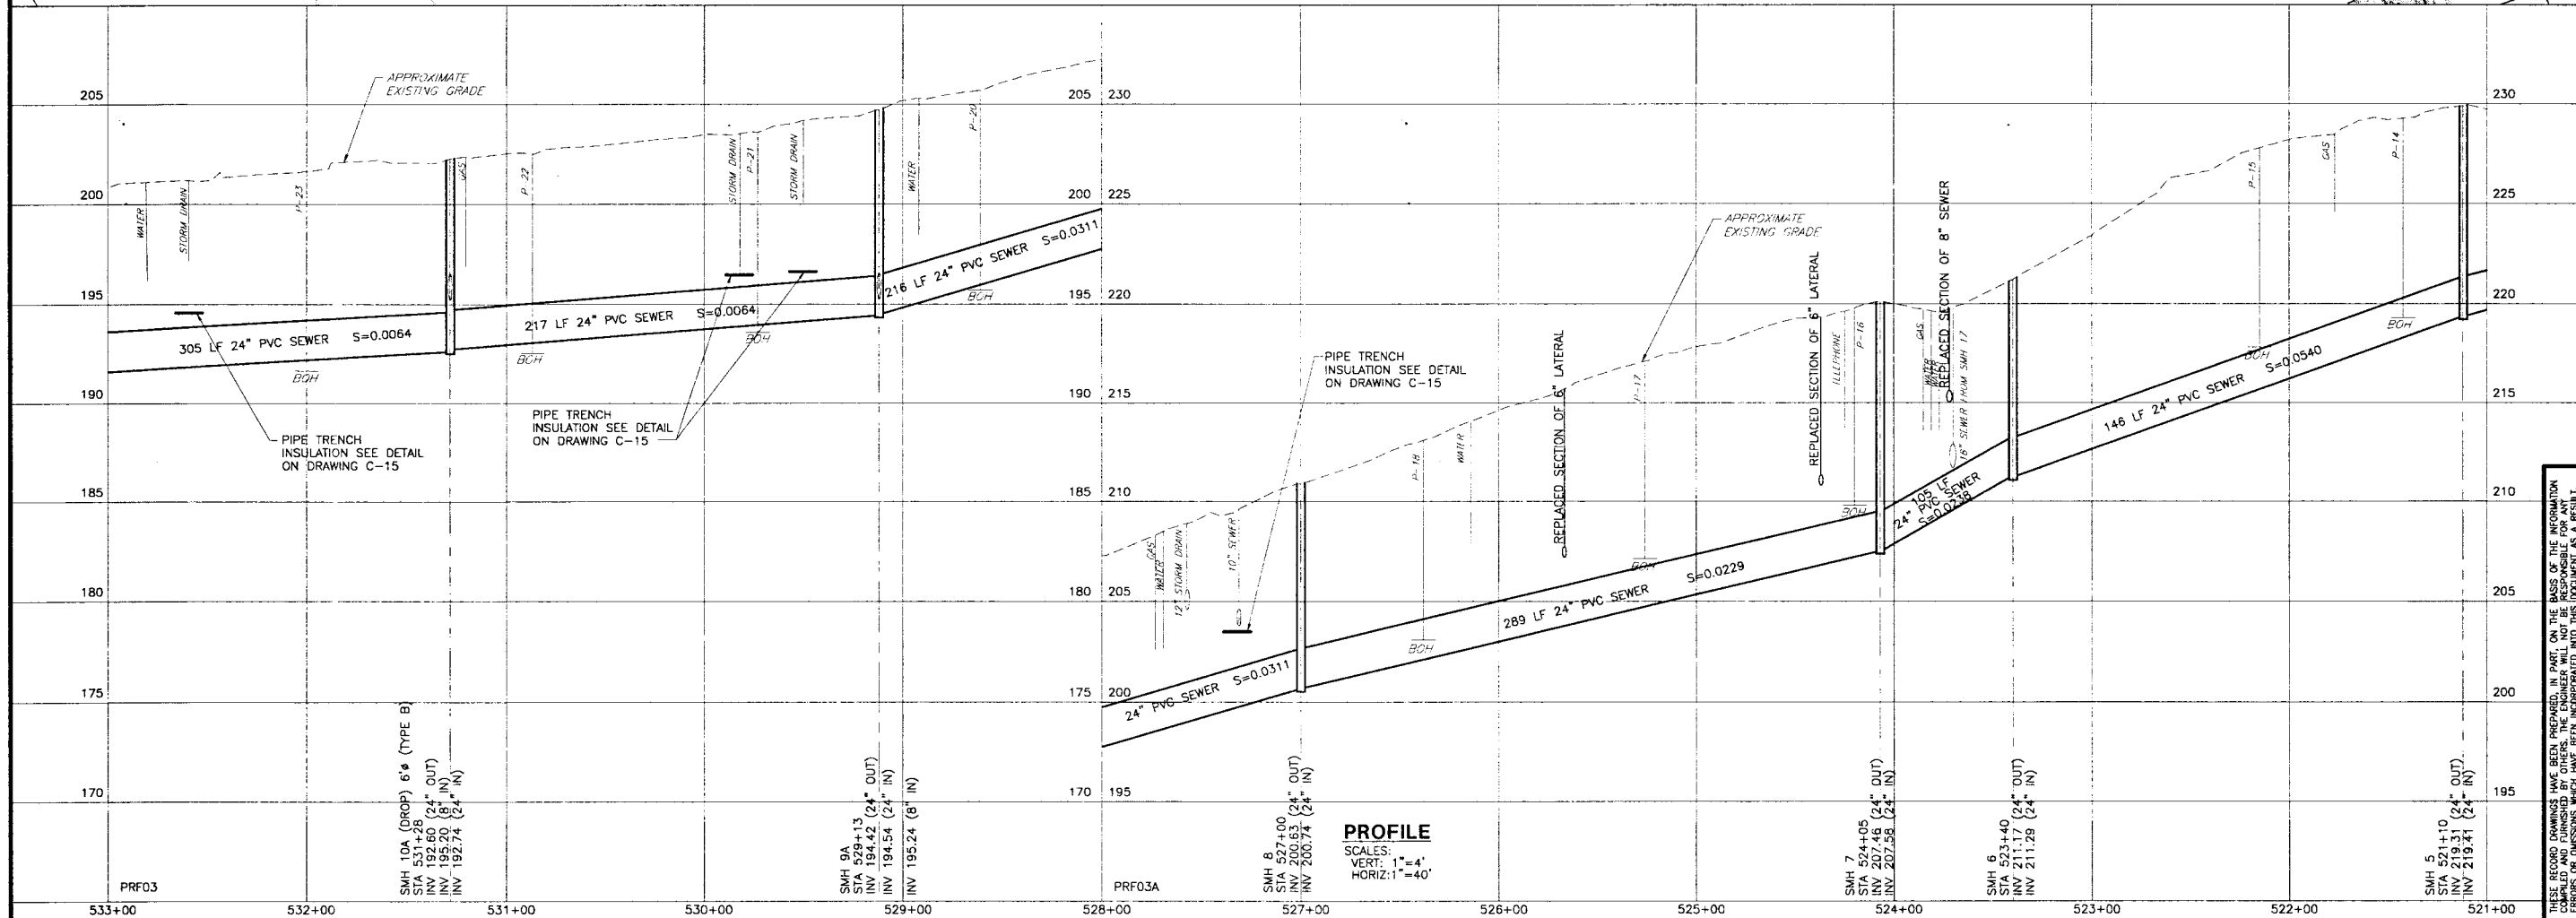


G:\dwgs\7051K\Record Dwgs\CIV\7051KC10.dwg, 1/7/2005 2:39:15 PM, cjb

- NOTES:**
1. REMOVE EXISTING PAVEMENT IN AREAS SHOWN WITH SHADE AND PROVIDE 3 1/2" OF NEW BITUMINOUS PAVEMENT. CONTRACTOR TO SAW CUT AT EXISTING DRIVEWAYS, ROADWAYS, ETC WHICH ARE TO REMAIN. SEE TYPICAL ROAD SECTION DETAIL FOR PAVEMENT REQUIREMENTS ON SHEET C-14.
 2. CONTRACTOR TO PERFORM TEST PITS PRIOR TO INSTALLATION OF FORCE MAIN AND SEWER PIPING.
 3. CONTRACTOR TO REMOVE AND REINSTALL EXISTING GRANITE CURBING AS NEEDED FOR THE INSTALLATION OF THE NEW GRAVITY SEWER, WATER MAIN, AND SERVICES.
 4. REFER TO DRAWING C-12 FOR NEW WATER MAIN PIPING WORK.
 5. NOT ALL WATER, SEWER, AND GAS SERVICES ARE SHOWN ON THE DRAWINGS. CONTRACTOR TO VERIFY SERVICE LOCATIONS PRIOR TO THE INSTALLATION OF THE NEW FORCE MAIN, GRAVITY SEWER, AND WATER MAIN.

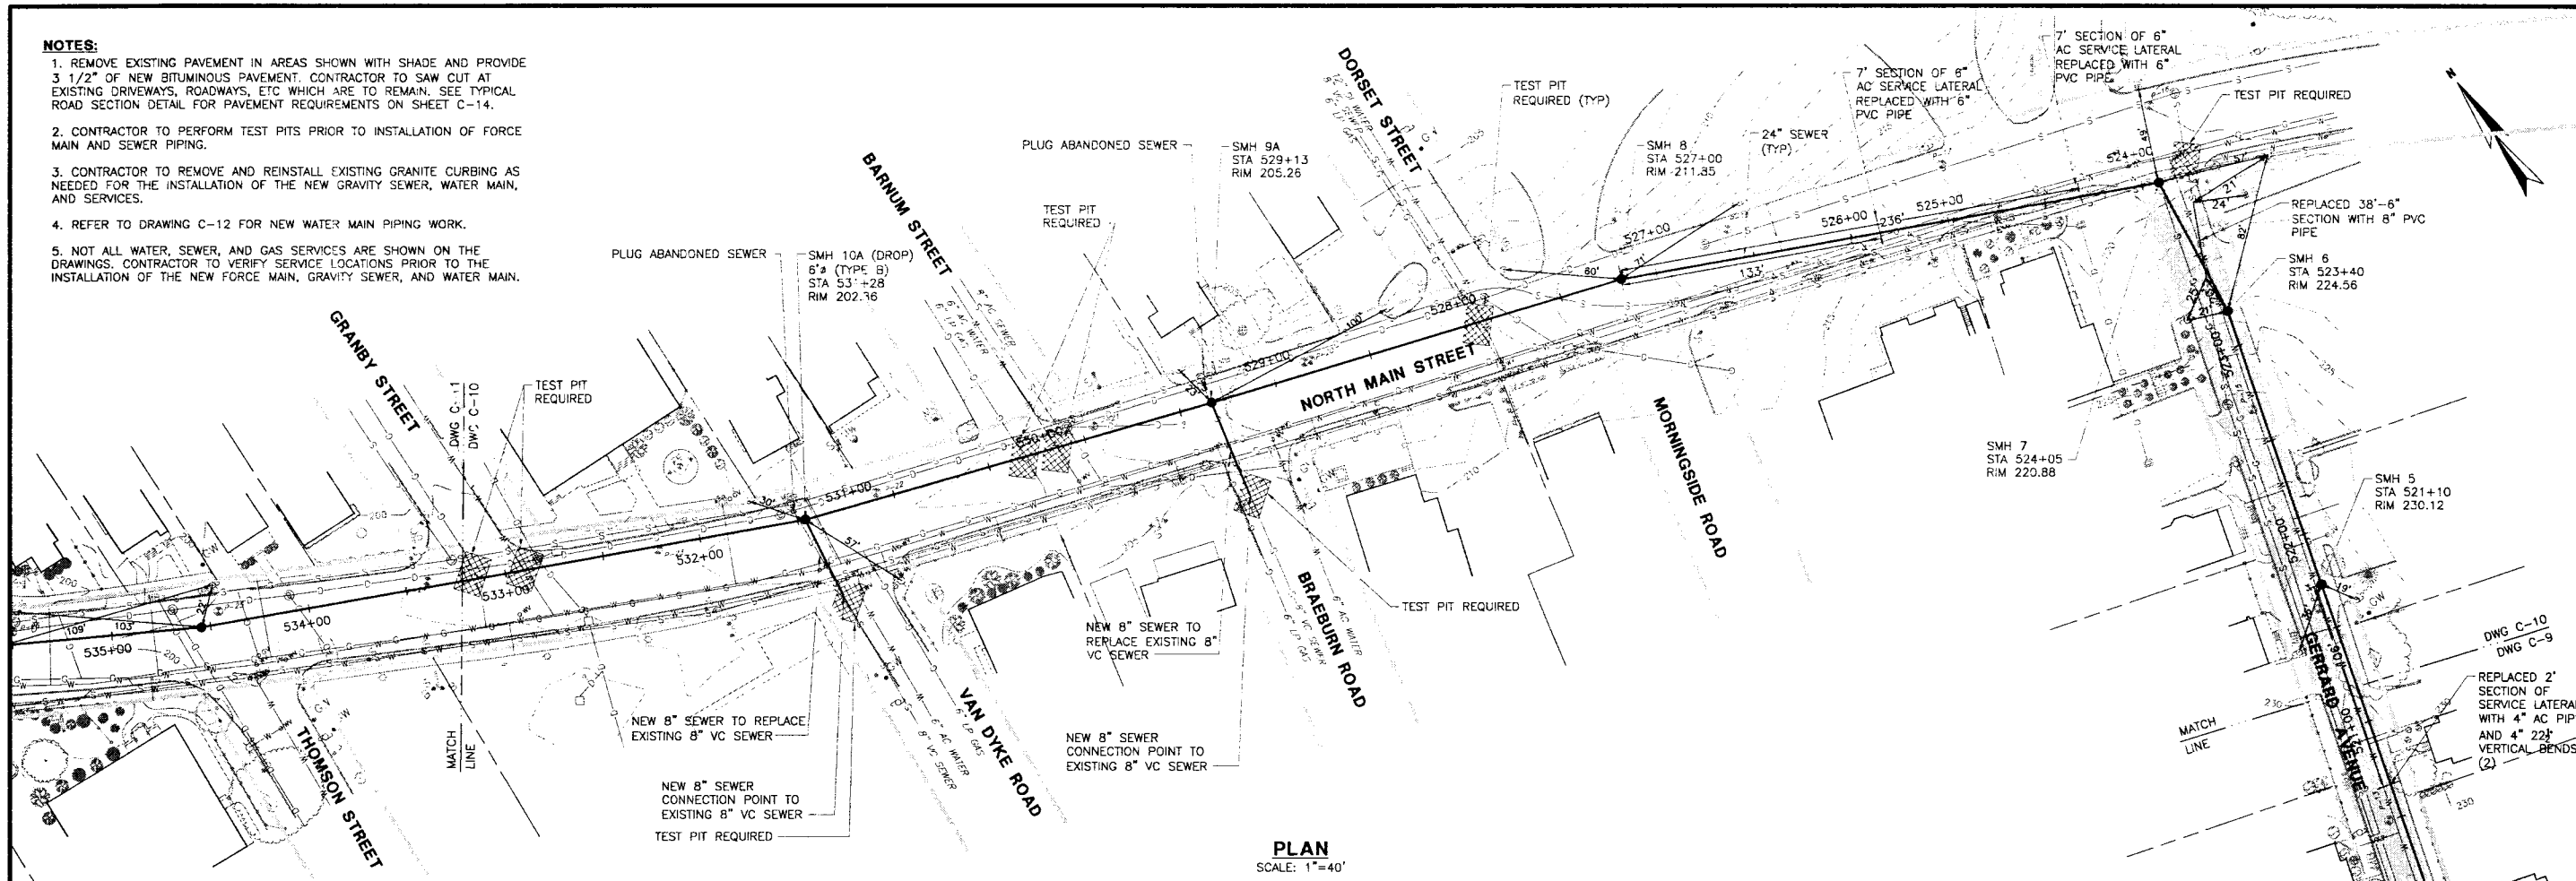

DESIGNED BY	DATE	12-02
CHECKED BY	DATE	2-03
APPROVED BY	DATE	2-03
PROJECT NO.	7051K	
SCALE	AS NOTED	

DEPARTMENT OF PUBLIC WORKS
TOWN OF EAST LONGMEADOW, MA
VINELAND AVENUE PUMP STATION
CONTRACTS NO. 1 AND NO. 2
GRAVITY SEWER
STA 521+00 TO 533+00

Wright-Pierce
189 Main Street 700 Plaza Middlesex
Middletown, Connecticut USA 06457
TEL (860) 343-9297 FAX (860) 343-9504

DWG C-10
10 OF 49