


G:\dwgs\7051K\Record Dwgs\CIV\7051KC12.dwg, 1/7/2005 2:40:18 PM, cjb

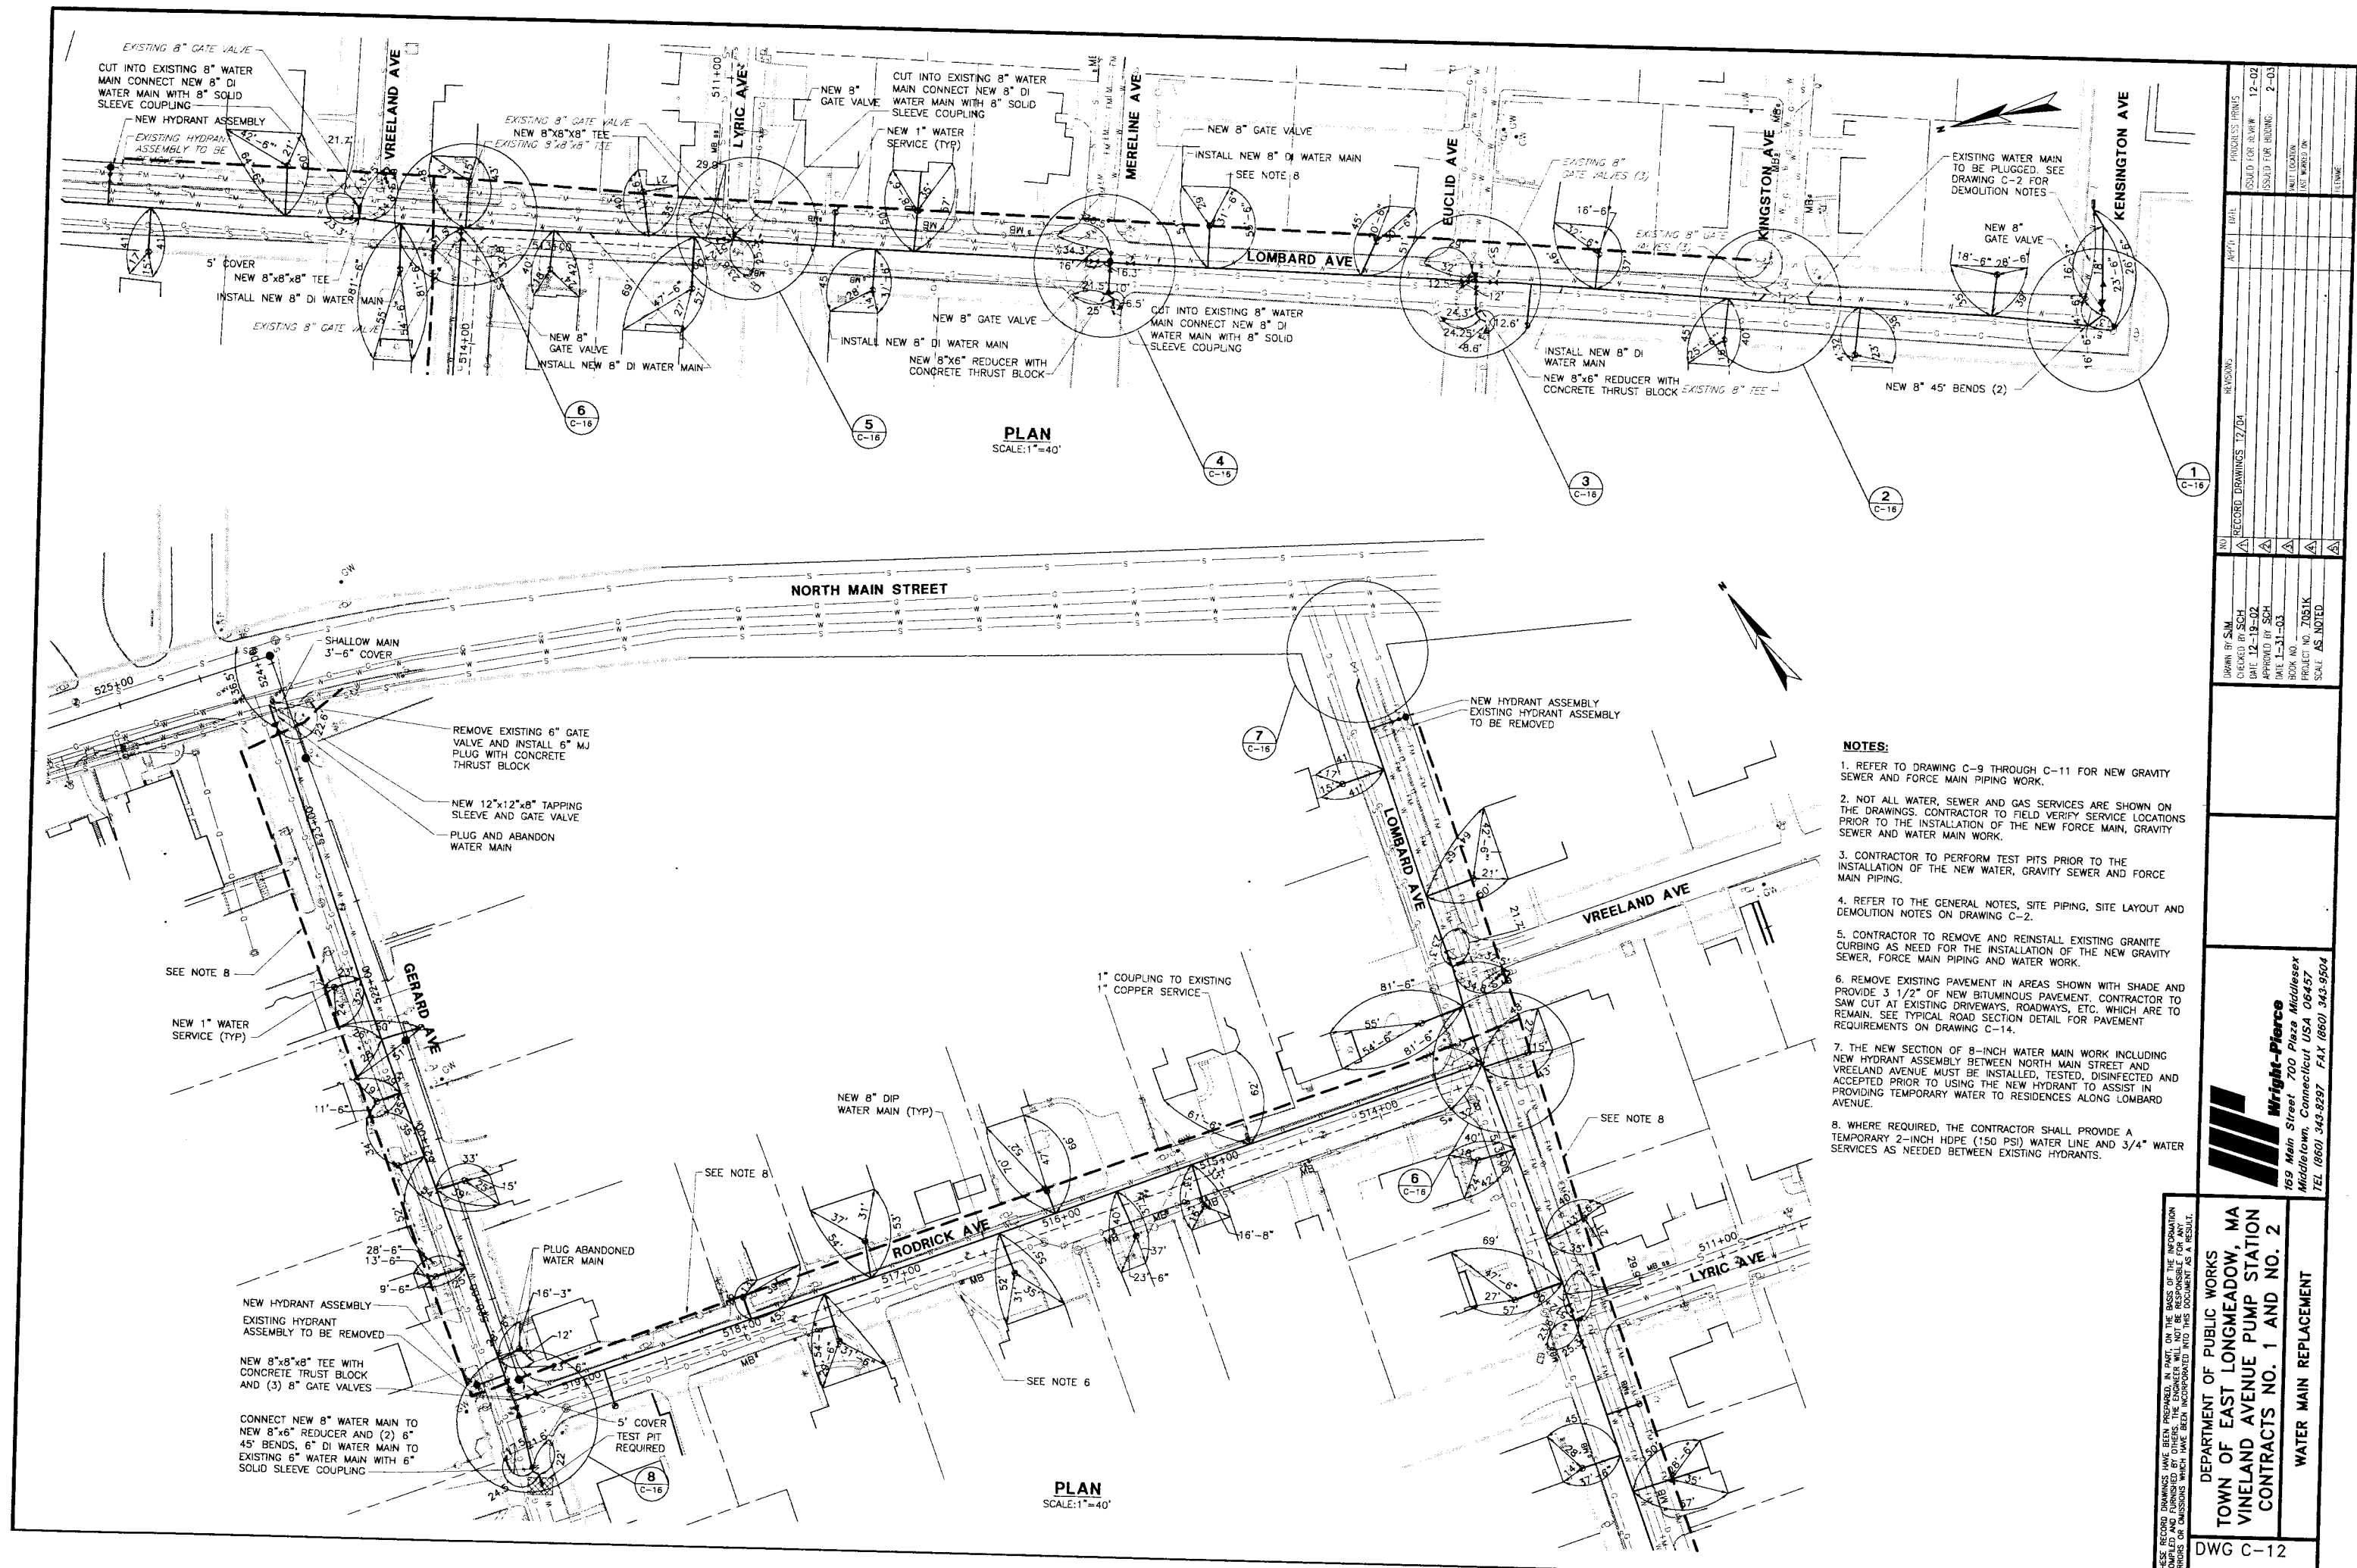

- NOTES:**
1. REFER TO DRAWING C-9 THROUGH C-11 FOR NEW GRAVITY SEWER AND FORCE MAIN PIPING WORK.
 2. NOT ALL WATER, SEWER AND GAS SERVICES ARE SHOWN ON THE DRAWINGS. CONTRACTOR TO FIELD VERIFY SERVICE LOCATIONS PRIOR TO THE INSTALLATION OF THE NEW FORCE MAIN, GRAVITY SEWER AND WATER MAIN WORK.
 3. CONTRACTOR TO PERFORM TEST PITS PRIOR TO THE INSTALLATION OF THE NEW WATER, GRAVITY SEWER AND FORCE MAIN PIPING.
 4. REFER TO THE GENERAL NOTES, SITE PIPING, SITE LAYOUT AND DEMOLITION NOTES ON DRAWING C-2.
 5. CONTRACTOR TO REMOVE AND REINSTALL EXISTING GRANITE CURBING AS NEEDED FOR THE INSTALLATION OF THE NEW GRAVITY SEWER, FORCE MAIN PIPING AND WATER WORK.
 6. REMOVE EXISTING PAVEMENT IN AREAS SHOWN WITH SHADE AND PROVIDE 3 1/2" OF NEW BITUMINOUS PAVEMENT. CONTRACTOR TO SAW CUT AT EXISTING DRIVEWAYS, ROADWAYS, ETC. WHICH ARE TO REMAIN. SEE TYPICAL ROAD SECTION DETAIL FOR PAVEMENT REQUIREMENTS ON DRAWING C-14.
 7. THE NEW SECTION OF 8-INCH WATER MAIN WORK INCLUDING NEW HYDRANT ASSEMBLY BETWEEN NORTH MAIN STREET AND VREELAND AVENUE MUST BE INSTALLED, TESTED, DISINFECTED AND ACCEPTED PRIOR TO USING THE NEW HYDRANT TO ASSIST IN PROVIDING TEMPORARY WATER TO RESIDENCES ALONG LOMBARD AVENUE.
 8. WHERE REQUIRED, THE CONTRACTOR SHALL PROVIDE A TEMPORARY 2-INCH HDPE (150 PSI) WATER LINE AND 3/4" WATER SERVICES AS NEEDED BETWEEN EXISTING HYDRANTS.

THESE RECORD DRAWINGS HAVE BEEN PREPARED BY THE ENGINEER OR HIS DELEGATED REPRESENTATIVE ON THE BASIS OF THE INFORMATION FURNISHED BY THE OWNER. THE ENGINEER WILL NOT BE RESPONSIBLE FOR ANY ERRORS OR OMISSIONS WHICH HAVE BEEN INCORPORATED INTO THIS DOCUMENT AS A RESULT.

DEPARTMENT OF PUBLIC WORKS
TOWN OF EAST LONGMEADOW, MA
VINELAND AVENUE PUMP STATION
CONTRACTS NO. 1 AND NO. 2
WATER MAIN REPLACEMENT

DWG C-12

Wright-Pierce
169 Main Street 700 Plaza Middlesex
Middletown, Connecticut USA 06457
TEL (860) 348-8287 FAX (860) 348-9504

NO.	RECORD DRAWINGS 12/04	REVISIONS	DATE	BY	FOR
1	AS NOTED				
2					
3					
