


G:\dwgs\7051K\Record Dwgs\ARC\7051Ka01.dwg, 1/7/2005 2:47:21 PM, cjb

ARCHITECTURAL NOTES

- 1. THE BUILDING SECTIONS INDICATE THE MATERIALS TO BE USED IN THE VARIOUS STRUCTURES. ALSO REFER TO THE STRUCTURAL DRAWINGS.
- 2. ALL ROUGH OPENINGS (RO) ARE NOMINAL. COORDINATE ALL ROUGH OPENINGS WITH THE ITEMS AND EQUIPMENT TO BE INSTALLED.
- 3. EXPANSION ANCHORS SHALL HAVE A MINIMUM OF 4" EMBEDMENT UNLESS INDICATED OTHERWISE.
- 4. USE A PIPE SLEEVE AT ALL WALL PENETRATIONS IN THE CONCRETE WALLS. REFER TO PROCESS DRAWINGS FOR THE TYPICAL PIPE SLEEVE DETAILS.
- 5. THE FOLLOWING AREAS ARE TO BE TREATED AS FIRE RATED ASSEMBLIES:
SPACE
A. STAIR B02 AND 109 1 HOUR
B. MECHANICAL ROOM 106 1 HOUR
C. GENERATOR ROOM 108 1 HOUR
C. FUEL STORAGE 101 1 HOUR
- 6. SEAL ALL PENETRATIONS THROUGH FIRE WALLS AND CEILINGS WITH THE REQUIRED BLOCKING, FIRESTOPPING AND FIRE RATED SEALANT. SEE SPECIFICATION SECTION 07270.
- 7. ALL WOOD IN CONTACT WITH CONCRETE SHALL BE PRESSURE TREATED.
- 8. ALL STRUCTURAL STEEL, MISCELLANEOUS METALS AND STEEL ITEMS (SUCH AS DOOR FRAMES) IN CONTACT WITH CONCRETE SHALL RECEIVE AN EPOXY PRIMER APPLIED TO THE SURFACES IN CONTACT. TREAT GALVANIZED SURFACES AS PER MANUFACTURERS RECOMMENDATIONS FOR APPLICATION OF AN EPOXY PRIMER.
- 9. IN AREAS DESIGNATED TO HAVE SUSPENDED ACOUSTICAL CEILINGS, THE GYPSUM WALL BOARD ON THE WALLS SHALL CONTINUE UP TO THE TOP OF THE WALL.
- 10. THE DIMENSIONS TO THE TOILET ROOM ACCESSORIES ARE THE CLEAR DISTANCE INCLUDING FINISHES. INSTALL ALL ITEMS IN ACCORDANCE WITH THE AMERICANS WITH DISABILITIES ACT AND THE ARCHITECTURAL ACCESS BOARD.
- 11. INSULATE ALL INTERIOR AND EXTERIOR METAL STUD WALLS WITH FIBERGLASS BATT INSULATION.
- 12. THE STUD SPACING FOR EXTERIOR WALLS SHALL BE 16" ON CENTER. STUD SPACING FOR INTERIOR NON-LOAD BEARING WALLS SHALL BE 2'-0" ON CENTER UNLESS OTHERWISE NOTED.
- 13. ALL DIMENSIONS INDICATED ON THE PLANS ARE NOMINAL. REFER TO THE DETAILS FOR MORE SPECIFIC INFORMATION. ALL DIMENSIONS INDICATED TO BE "CLEAR" SHALL BE THE CLEAR DIMENSION FROM THE FACE OF THE WALLBOARD OR CONCRETE.
- 14. THE GENERAL CONTRACTOR SHALL COORDINATE WORK OF ALL SUB-BIDDERS REQUIRED TO COMPLETE THIS WORK.
- 15. * INDICATES DIMENSION SHALL BE FIELD VERIFIED.

ARCHITECTURAL ABBREVIATIONS

AFF	ABOVE FINISH FLOOR	LP	LOW POINT
ACP	ACOUSTIC CEILING PANEL	MFR	MANUFACTURER
ALUM (AL)	ALUMINUM	MAX	MAXIMUM
&	AND	MECH (M)	MECHANICAL
L	ANGLE	MIN	MINIMUM
@	AT	MO	MASONRY OPENING
BIT	BITUMINOUS	MOD	MOTOR OPERATED DAMPER
BCT	BOTTOM		MODULAR
BLDG	BUILDING	MRACP	MOISTURE RESISTANT ACOUSTICAL
CAB	CABINET		CEILING PANEL
C	CAULK	MRGWB	MOISTURE RESISTANT GYPSUM
CTR	CENTER		WALLBOARD
@	CENTERLINE	MT	METAL THRESHOLD
CL	CLEAR	MTD	MOUNTED
COL	COLUMN	NV	NARROW VISION
CONC	CONCRETE	NIC	NOT IN CONTRACT
CO	CONCRETE OPENING	NO (#)	NUMBER
CONT	CONTINUOUS	NTS	NOT TO SCALE
CJ	CONTROL JOINT	OC	ON CENTER
CONSTR	CONSTRUCTION	OPP HD	OPPOSITE HAND
DET	DETAIL	PC	PIECE
DIM	DIMENSION	PL	PLATE
Ø DIA	DIAMETER	P (PT)	PLUMBING (PAINT)
DN	DOWN		(PRESSURE TREATED)
DWLS	DOWELS	/	PER
DWG	DRAWING	PTD	PAPER TOWEL DISPENSER
ES	EACH SIDE	PERIM	PERIMETER
EL	ELEVATION (HEIGHT)	PR	PROCESS
ELEV	ELEVATION (PICTORAL)	RWC	RAIN WATER CONDUCTOR
ELECT (E)	ELECTRICAL	REINF	REINFORCING
EP	EPOXY PAINT	REQ'D	REQUIRED
EQ	EQUAL	RO	ROUGH OPENING
EXP	EXPANSION	R	RISER (ROLL-UP) (RADIUS) (RUBBER
EXT	EXTERIOR	S	SEALANT (STRUCTURAL)
FD	FLOOR DRAIN	SCHED (SCH)	SCHEDULE
FT	FEET (FOOT)	SECT	SECTION
FE	FIRE EXTINGUISHER	SIM	SIMILAR
FIN	FINISH	SD	SOAP DISPENSER
FIN FL	FINISH FLOOR	SPEC	SPECIFICATION
FL	FLOOR	SQ	SQUARE
F	FLUSH (DOOR)	S/S (SS)	STAINLESS STEEL
FG	FULL GLASS	STRUCT	STRUCTURAL
GALV	GALVANIZED	SUSP	SUSPENDED
GA	GAUGE	T PL	TEMPERED PLATE
GL	GLASS	THK	THICKNESS
GWB	GYPSUM WALL BOARD	T	TREAD
HC	HALF GLASS	TOC	TOP OF CONCRETE
HDWE	HARDWARE	TOS	TOP OF STEEL
HTR	HEATER	TTD	TOILET TISSUE DISPENSER
H	HIGH	TP	TOWEL PIN
HP	HIGH POINT	TS	TUBE STEEL
HPL	HIGH PRESSURE LAMINATE	TYP	TYPICAL
HM	HOLLOW METAL	VCT	VINYL COMPOSITION TILE
HORIZ (HOR)	HORIZONTAL	VERT	VERTICAL
INSUL	INSULATION (INSULATED)	VIN (V)	VINYL
		VTS	VINYL TRANSITION STRIP
		W	WIDE
		W/	WITH
		WWF	WELDED WIRE FABRIC
		W GL	WIRE GLASS

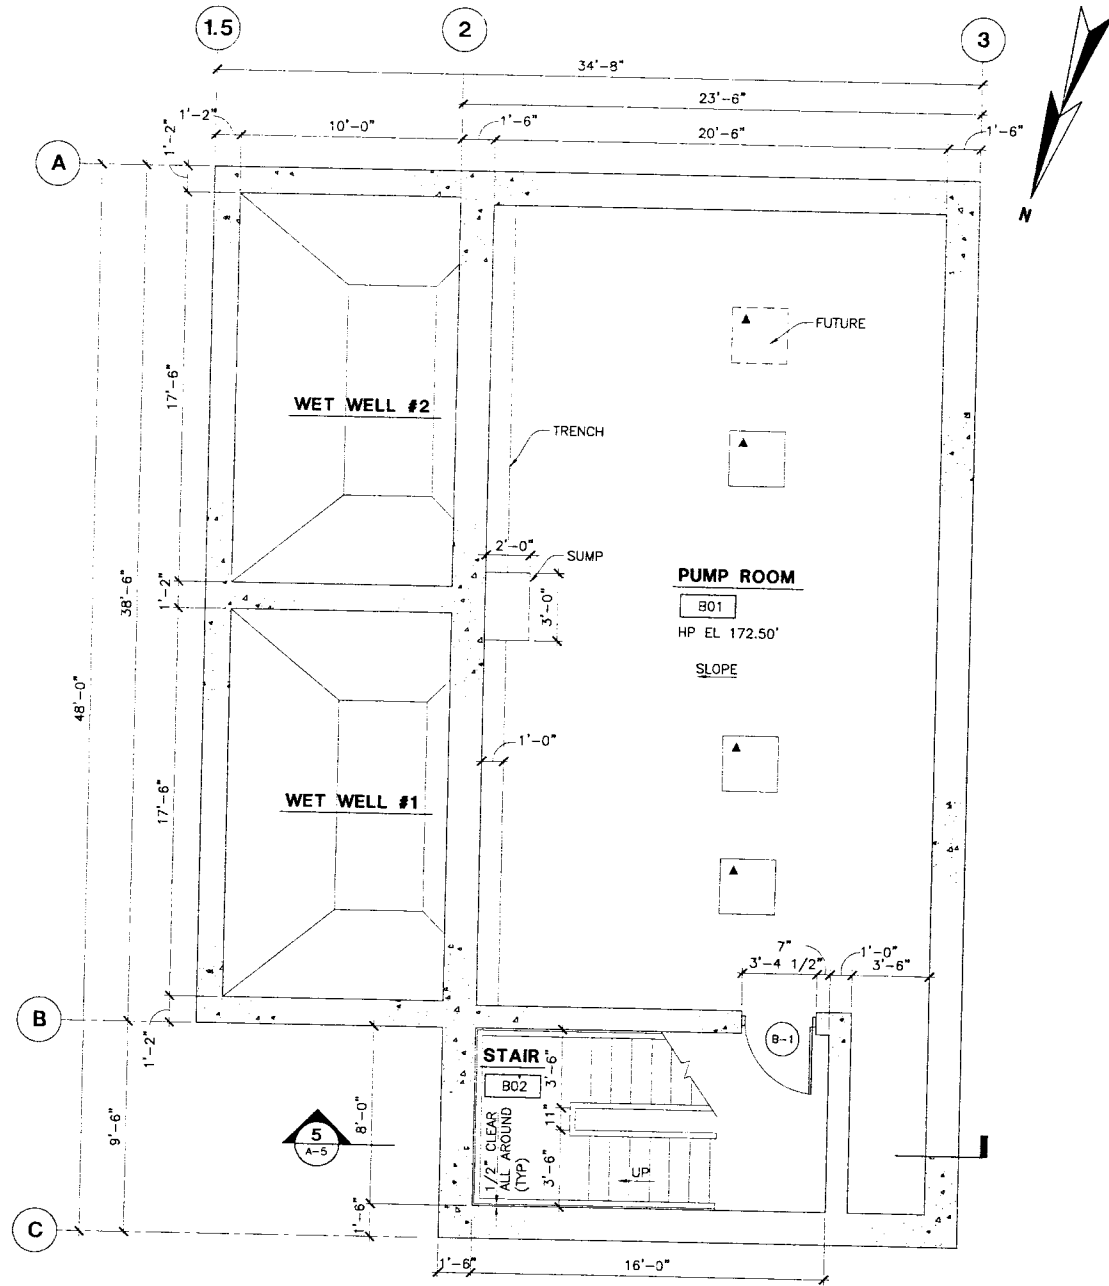

SYMBOLS LEGEND

- SECTION NUMBER BUILDING SECTION DRAWING NUMBER
- WALL OR PARTIAL SECTION
- DETAIL DESIGNATION
- DATUM
- INTERIOR ELEVATION SYMBOL
- EXTERIOR ELEVATION SYMBOL
- DOOR NUMBER
- ROOM NUMBER
- EQUIPMENT PAD
- CAULKING (FIRE RATED WHERE APPLICABLE)
- SEALANT
- PARTITION TYPE
- HATCH TYPE

MATERIALS LEGEND

- CONCRETE MASONRY UNIT (CMU)
- CONCRETE
- EARTH
- GYPSUM WALLBOARD (GWB) GROUT AND SAND
- RIGID INSULATION
- ALUMINUM
- BATT INSULATION
- PLYWOOD
- DIMENSION LUMBER OR WOOD BLOCKING
- FINISH WOOD
- METAL
- METAL (SMALL SCALE)

THESE RECORD DRAWINGS HAVE BEEN PREPARED, IN PART, ON THE BASIS OF THE INFORMATION FURNISHED BY THE CLIENT. THE ENGINEER WILL NOT BE RESPONSIBLE FOR ANY ERRORS OR OMISSIONS THAT HAVE BEEN INCORPORATED INTO THIS DOCUMENT AS A RESULT.

DEPARTMENT OF PUBLIC WORKS
TOWN OF EAST LONGMEADOW, MA
VINELAND AVENUE PUMP STATION
CONTRACTS NO. 1 AND NO. 2
LEGEND, NOTES AND ABBREVIATIONS
DWG A-1
17 OF 49

Wright-Pierce
169 Main Street 700 Plaza Middlesex
Middletown, Connecticut USA 06457
TEL (860) 343-8297 FAX (860) 343-9504