
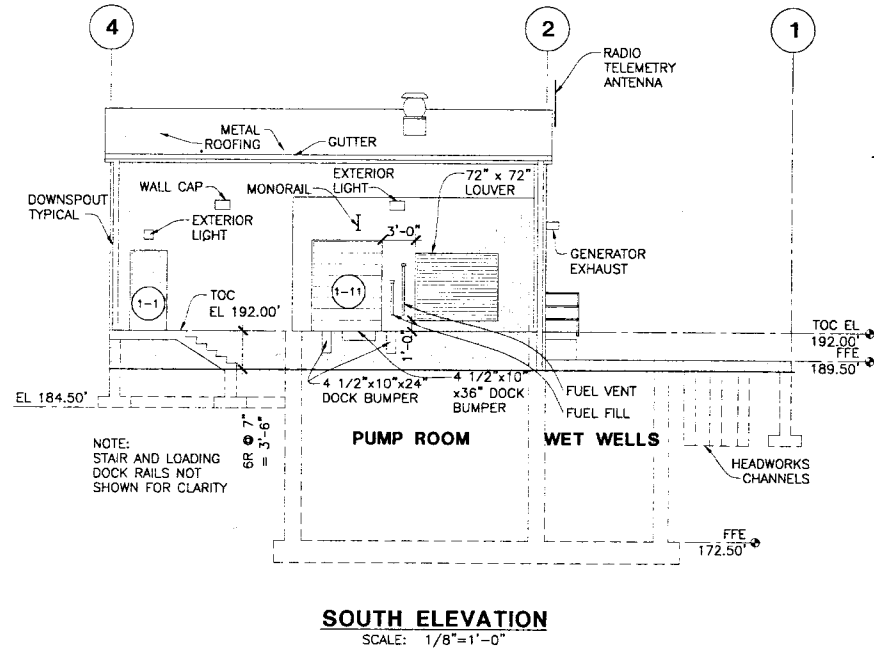
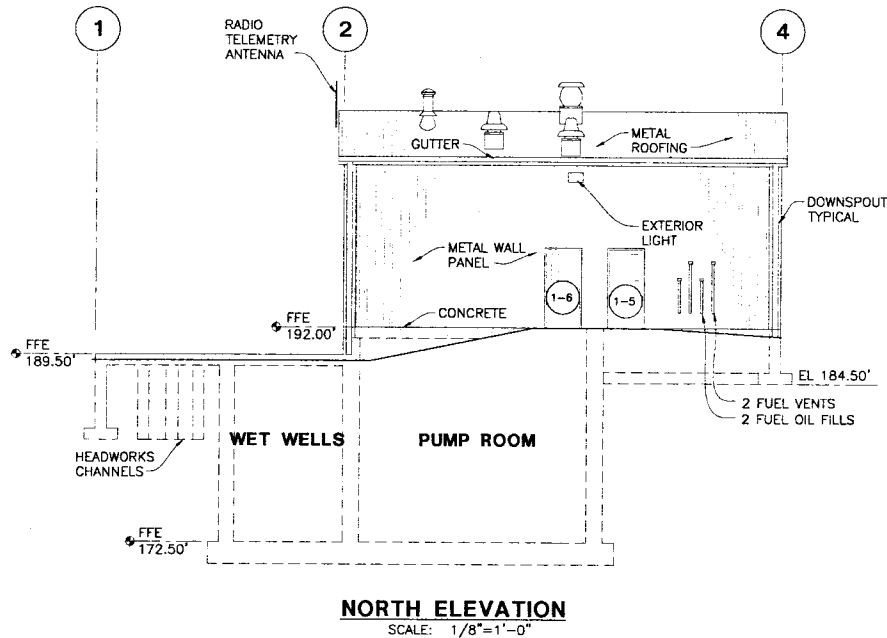
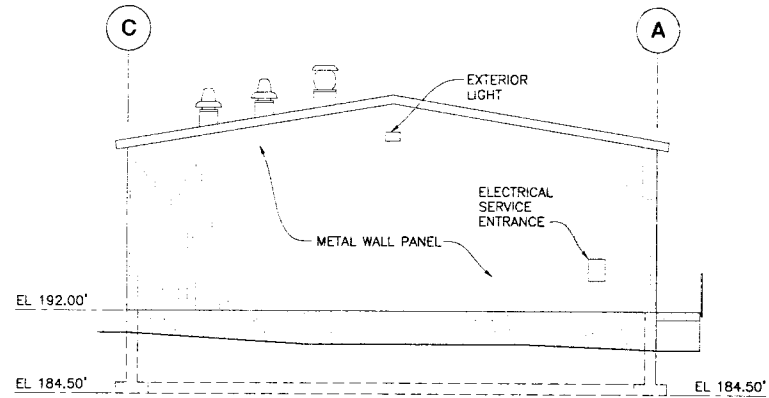


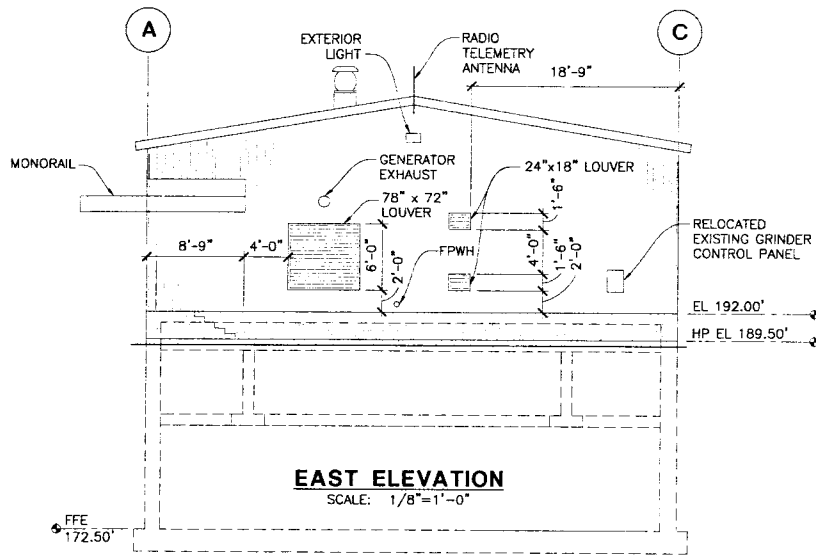

NOTES:
1. REFER TO DRAWING A-1 FOR ARCHITECTURAL NOTES.

THESE RECORD DRAWINGS HAVE BEEN PREPARED, IN PART, ON THE BASIS OF THE INFORMATION FURNISHED BY THE TOWN OF EAST LONGMEADOW, MA. THE ENGINEER WILL NOT BE RESPONSIBLE FOR ANY ERRORS OR OMISSIONS WHICH HAVE BEEN INCORPORATED INTO THIS DOCUMENT AS A RESULT.

DEPARTMENT OF PUBLIC WORKS
TOWN OF EAST LONGMEADOW, MA
VINELAND AVENUE PUMP STATION
CONTRACTS NO. 1 AND NO. 2

DWG A-3

19 OF 49

Wright-Pierce
169 Main Street 700 Plaza Middlesex
Middletown, Connecticut USA 06457
TEL (860) 343-8297 FAX (860) 343-9504

NO.	REVISIONS	DATE	ISSUED FOR REVIEW	12-02
1	RECORD DRAWINGS 12/04		ISSUED FOR REVIEW	12-02
2			ISSUED FOR REVIEW	2-03
3			ISSUED FOR REVIEW	2-03
