
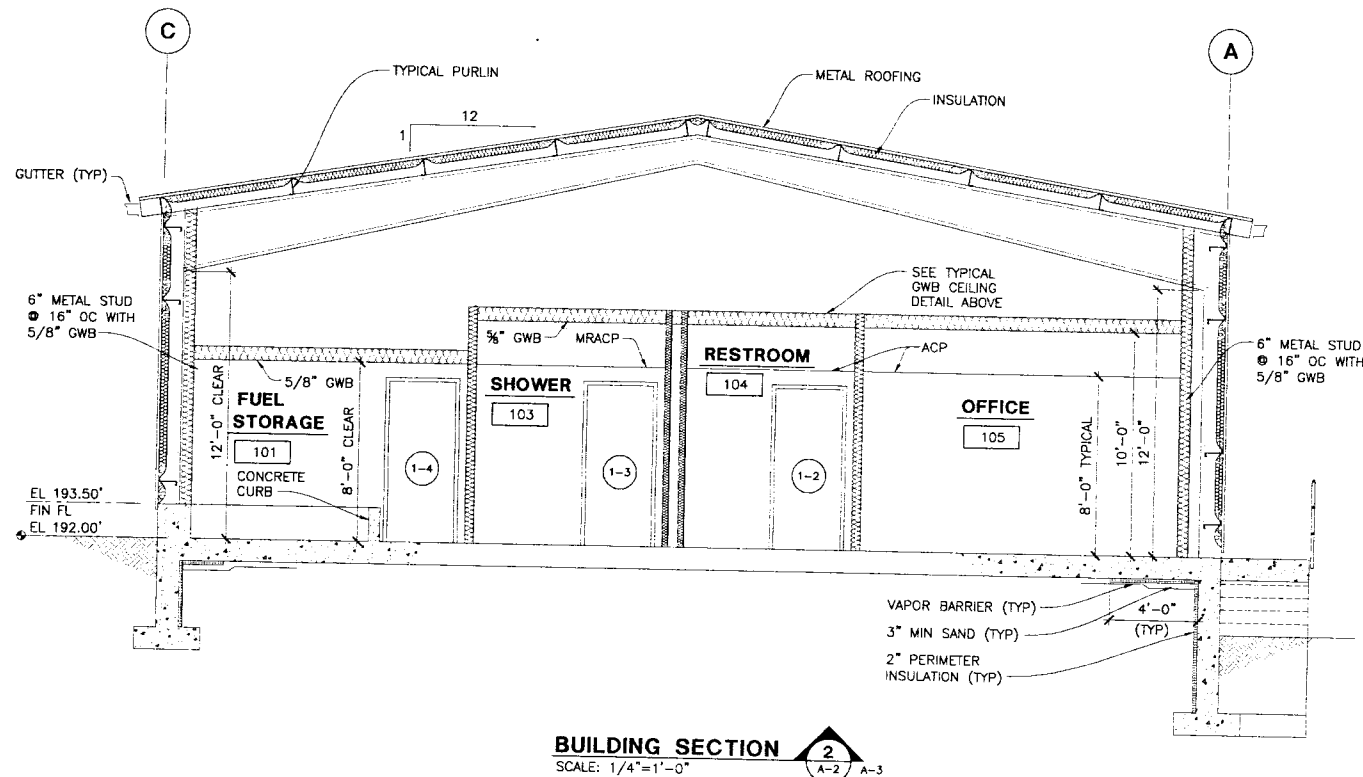
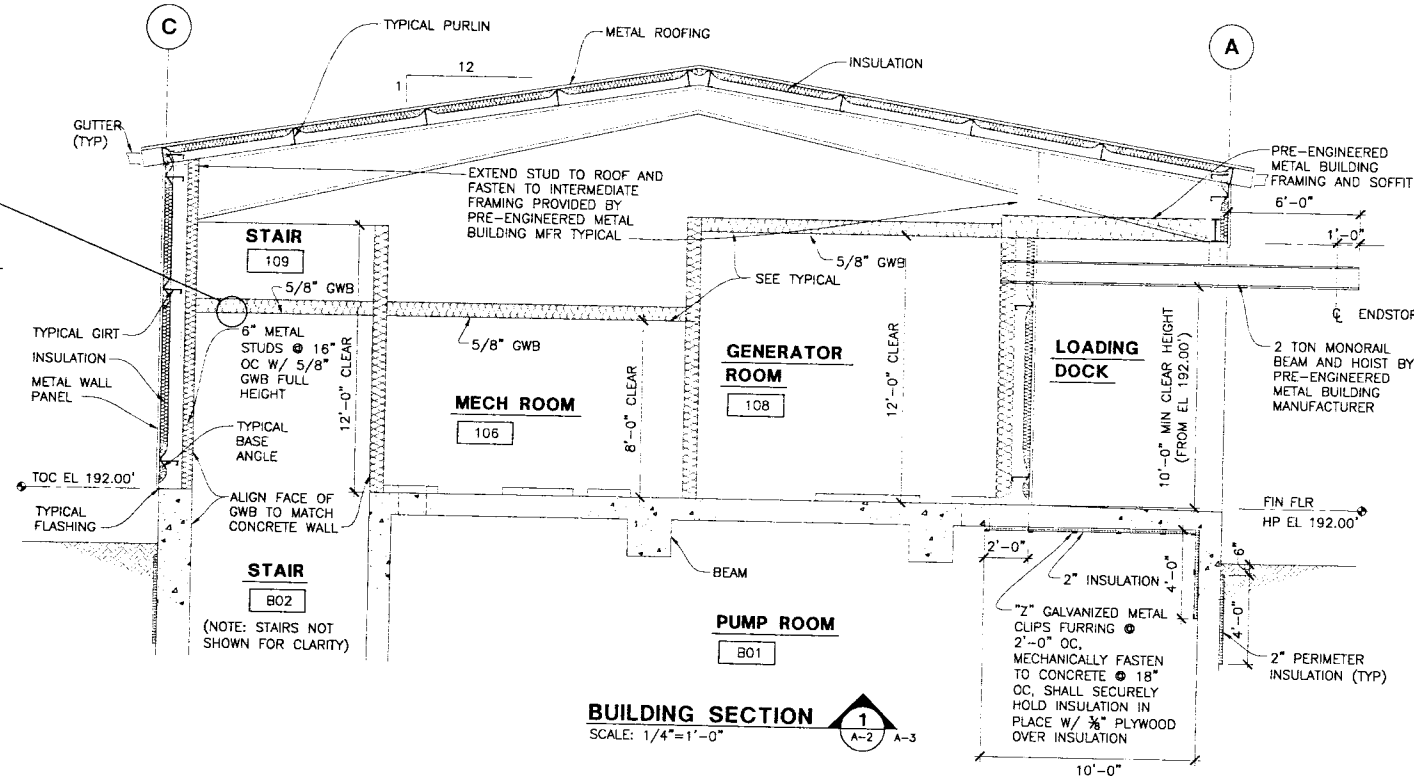


G:\dwgs\7051K\Record Dwgs\ARC\7051ka04.dwg, 1/7/2005 2:52:47 PM, cjb

TYPICAL GWB CEILING DETAIL

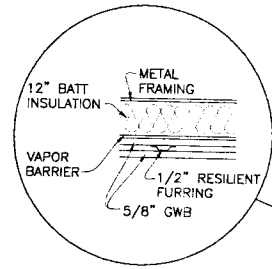

NOTES:  
1. REFER TO DRAWING A-1 FOR ARCHITECTURAL NOTES.

DEPARTMENT OF PUBLIC WORKS TOWN OF EAST LONGMEADOW, MA VINELAND AVENUE PUMP STATION CONTRACTS NO. 1 AND NO. 2		BUILDING SECTIONS	
DWG A-4		20 OF 49	
Wright-Pierce 169 Main Street 700 Plaza Middlesex Middletown, Connecticut USA 06457 TEL (860) 343-8297 FAX (860) 343-9504		REVISIONS NO. DATE DESCRIPTION 1 12/04 RECORD DRAWINGS 2 12/04 ISSUED FOR REVIEW 3 12/04 ISSUED FOR BIDDING 4 12/04 AS NOTED	
DRAWN BY CJB CHECKED BY DIP/WLF DATE 12-13-02 APPROVAL BY WLF DATE 12-20-02 BOOK NO. 7051K PROJECT NO. AS NOTED SCALE AS NOTED		PROGRESS PRINTS ISSUED FOR REVIEW 12-02 ISSUED FOR BIDDING 2-03 LAST REVISION ON DATE	