




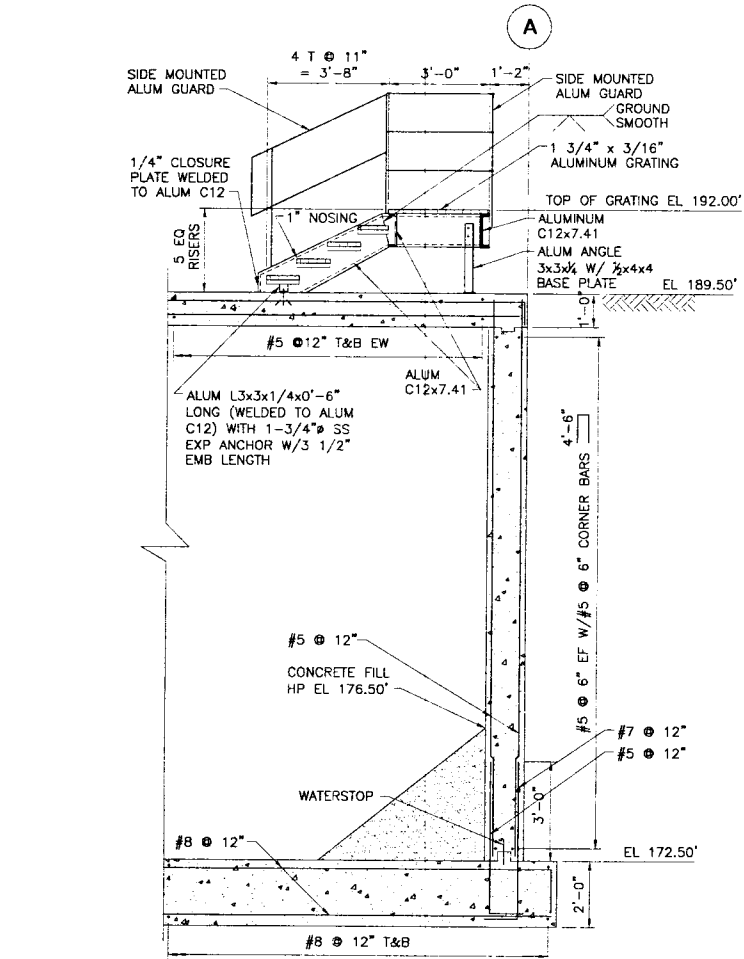


SECTION 6  
SCALE: 3/8"=1'-0" S-1 S-2

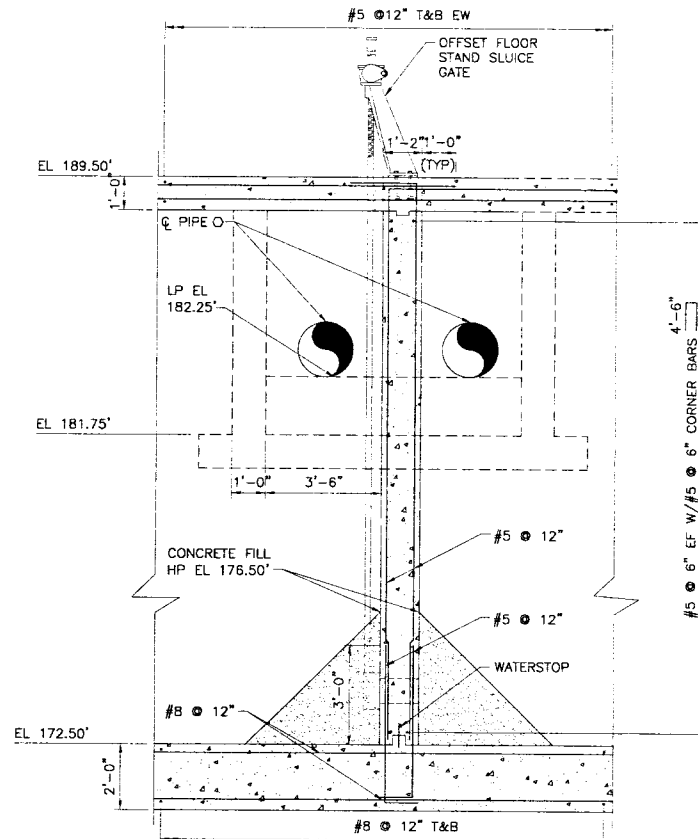


SECTION 7  
SCALE: 3/8"=1'-0" S-1 S-2

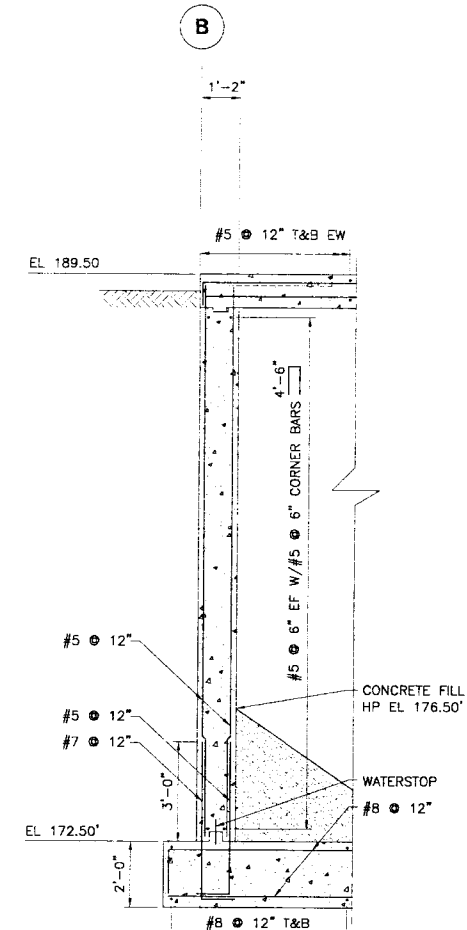


SECTION 8  
SCALE: 3/8"=1'-0" S-1 S-2

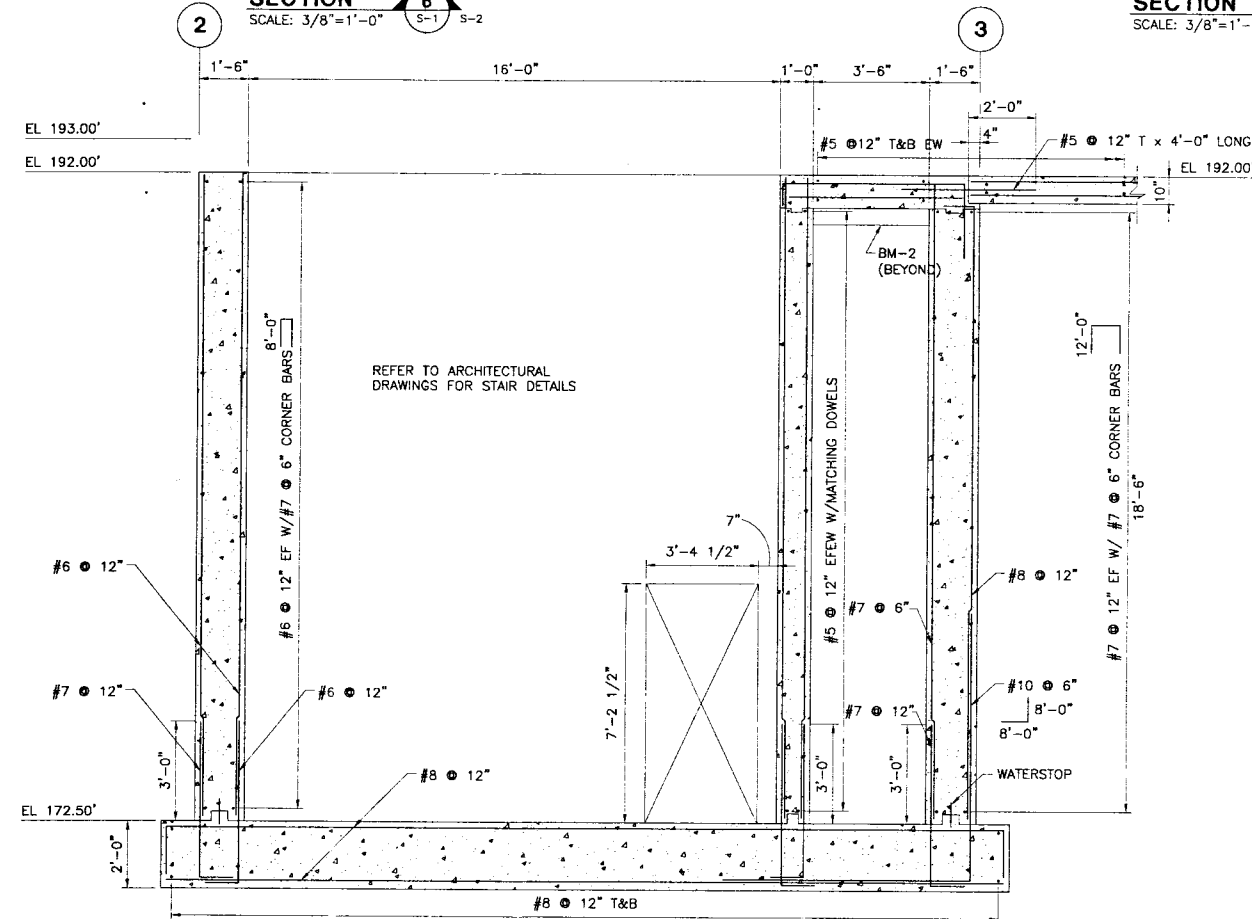

SECTION 9  
SCALE: 3/8"=1'-0" S-1 S-2

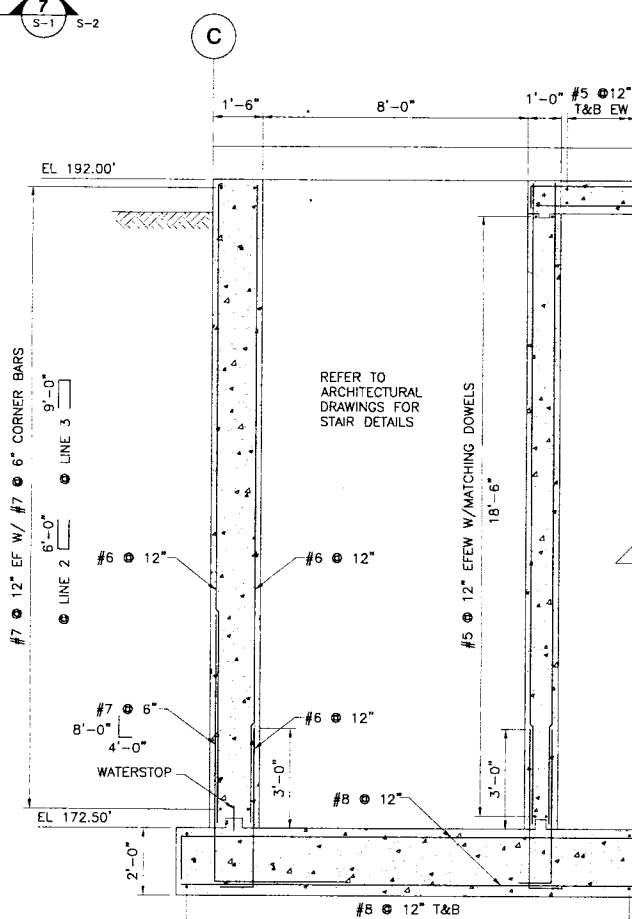

SECTION 10  
SCALE: 3/8"=1'-0" S-1 S-2

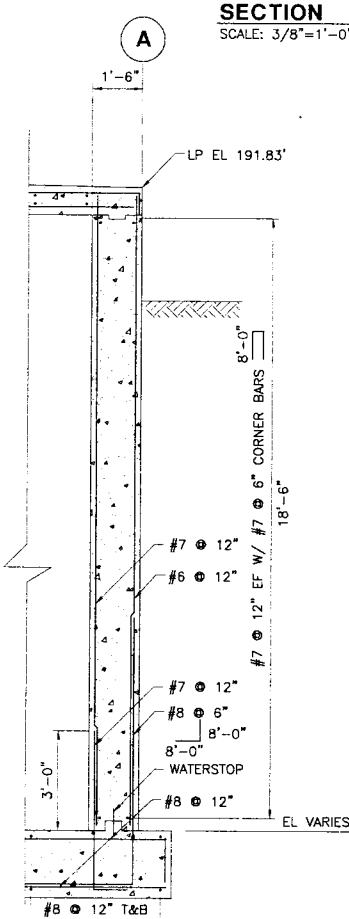

SECTION 11  
SCALE: 3/8"=1'-0" S-1 S-2

NOTES:  
1. FOR GENERAL STRUCTURAL NOTES AND STANDARD DETAILS, SEE DRAWINGS S-6 AND S-7.

THESE RECORD DRAWINGS HAVE BEEN PREPARED, IN PART, ON THE BASIS OF THE INFORMATION FURNISHED BY THE ENGINEER. THE ENGINEER WILL NOT BE RESPONSIBLE FOR ANY ERRORS OR OMISSIONS WHICH HAVE BEEN INCORPORATED INTO THIS DOCUMENT AS A RESULT.

DEPARTMENT OF PUBLIC WORKS  
TOWN OF EAST LONGMEADOW, MA  
VINELAND AVENUE PUMP STATION  
CONTRACTS NO. 1 AND NO. 2

DWG S-4

26 OF 49

**Wright-Pierce**  
169 Main Street 700 Plaza Middlesex  
Middletown, Connecticut USA 06457  
TEL (860) 342-8297 FAX (860) 342-9504

SECTIONS II

| NO. | REVISIONS          | DATE  | BY | CHKD. | APP'D. |
|-----|--------------------|-------|----|-------|--------|
| 1   | ISSUED FOR REVIEW  | 12-02 |    |       |        |
| 2   | ISSUED FOR BIDDING | 2-03  |    |       |        |
| 3   | LAST WORKED ON     |       |    |       |        |
| 4   | LAST WORKED ON     |       |    |       |        |
DRAWN BY CJB  
CHECKED BY JJP/WJF  
DATE 12-13-02  
APPROVED BY WJF  
DATE 12-20-02  
BOOK NO. 1  
PROJECT NO. 7051K  
SCALE AS NOTED