

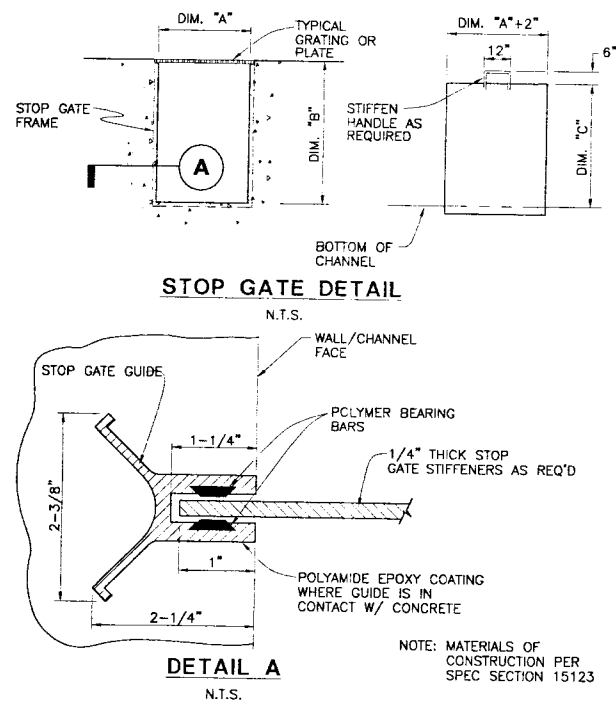


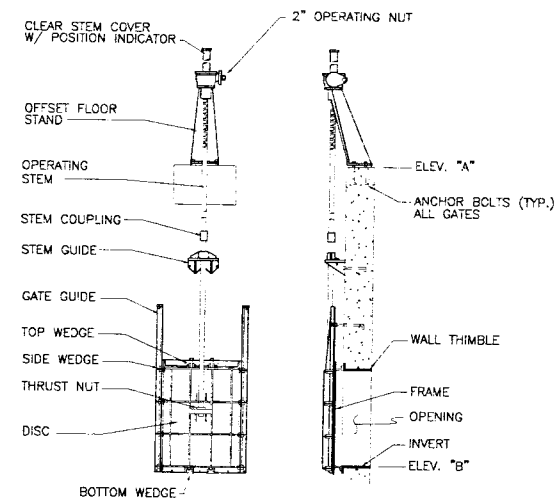

STOP GATE SCHEDULE

STOP GATE	DIMENSIONS			TYPE
	"A"	"B"	"C"	
STOP GATE #1	3'-0"	6'-6"	5'-0"	ALUM
STOP GATE #2	2'-0"	6'-0"	3'-6"	ALUM
STOP GATE #3	2'-0"	6'-9"	3'-6"	ALUM
STOP GATE #4	3'-0"	6'-9"	5'-3"	ALUM
STOP GATE #5	2'-6"	7'-3"	4'-0"	ALUM
STOP GATE #6	2'-6"	7'-3"	4'-0"	ALUM


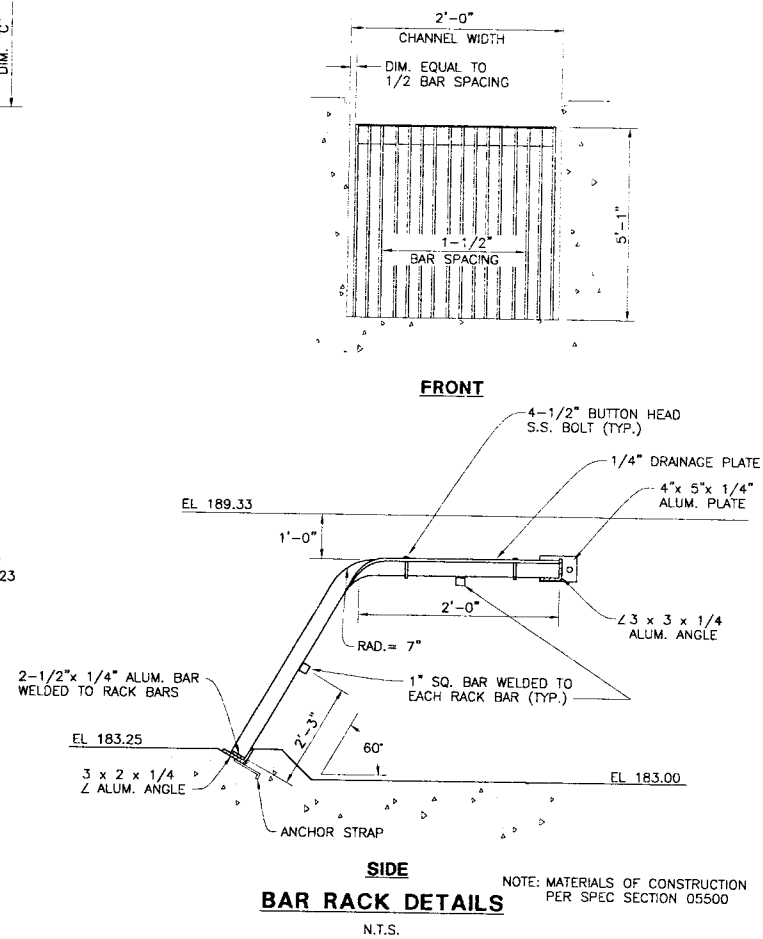


TYPICAL RISING STEM SLUICE GATE
NTS


SLUICE GATE SCHEDULE								
GATE No.	SIZE W x H	TYPE GATE	OPER. HD. FT. OF WTR.	TYPE THIMBLE	TYPE CLOSURE	TYPE OPERATOR	ELEV. A	ELEV. B
SLG#1	16"	STD	14'-8"	FLANGE x FLANGE	FLUSH BOTTOM	OFFSET CRANK	189.50 HP	173.50

NOTES


1. SLG#1 IS LOCATED IN THE HEADWORKS. SEE DWG. PR-2 FOR LOCATION.

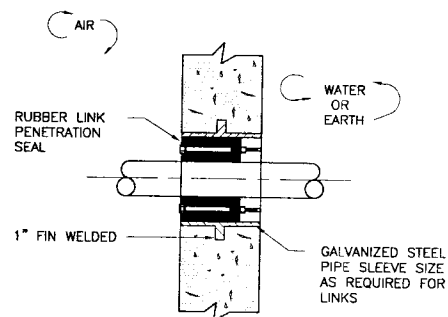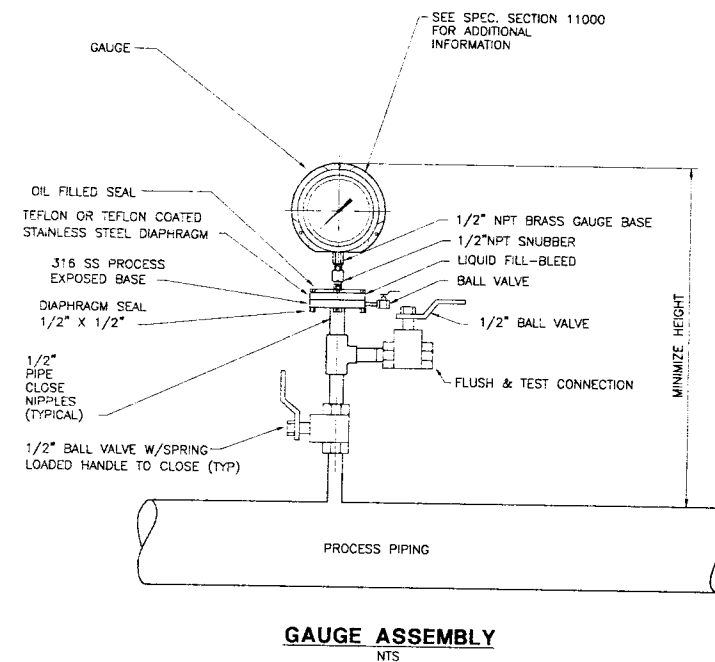


RUBBER LINK SLEEVE DETAIL
NTS

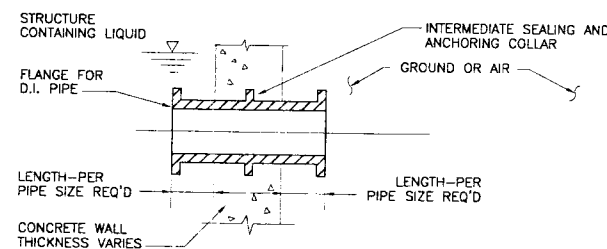

WALL PIPE DETAIL
NTS

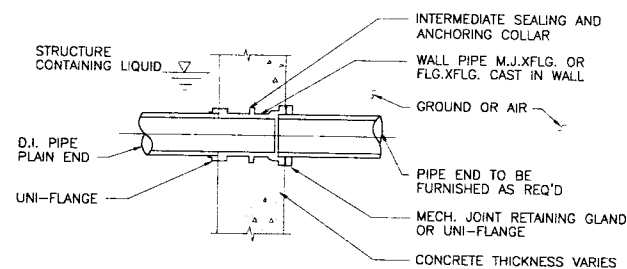

WALL PIPE DETAIL
NTS

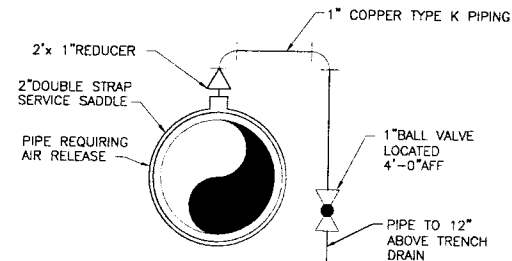

MANUAL AIR RELEASE DETAIL
NTS

THESE RECORD DRAWINGS HAVE BEEN PREPARED, IN PART, ON THE BASIS OF THE INFORMATION COMPILED AND FURNISHED BY OTHERS. THE ENGINEER WILL NOT BE RESPONSIBLE FOR ANY ERRORS OR OMISSIONS WHICH HAVE BEEN INCORPORATED INTO THIS DOCUMENT AS A RESULT.

DEPARTMENT OF PUBLIC WORKS
TOWN OF EAST LONGMEADOW, MA
VINELAND AVENUE PUMP STATION
CONTRACTS NO. 1 AND NO. 2

DETAILS AND SCHEDULES



Wright-Pierce
169 Main Street, 700 Plaza Middlesex
Middletown, Connecticut USA 06457
TEL (860) 343-8297 FAX (860) 343-9504

NO.	REVISION	APP'D.	DATE	PROJECT'S FRONT
△	RECORD DRAWINGS 12/04			ISSUED FOR REVIEW 12-02
△				ASSED FOR BIDDING 2-03
△				FINAL DESIGN
△				LAST REVISION
△				LAST REVISION ON
△				REMARKS