


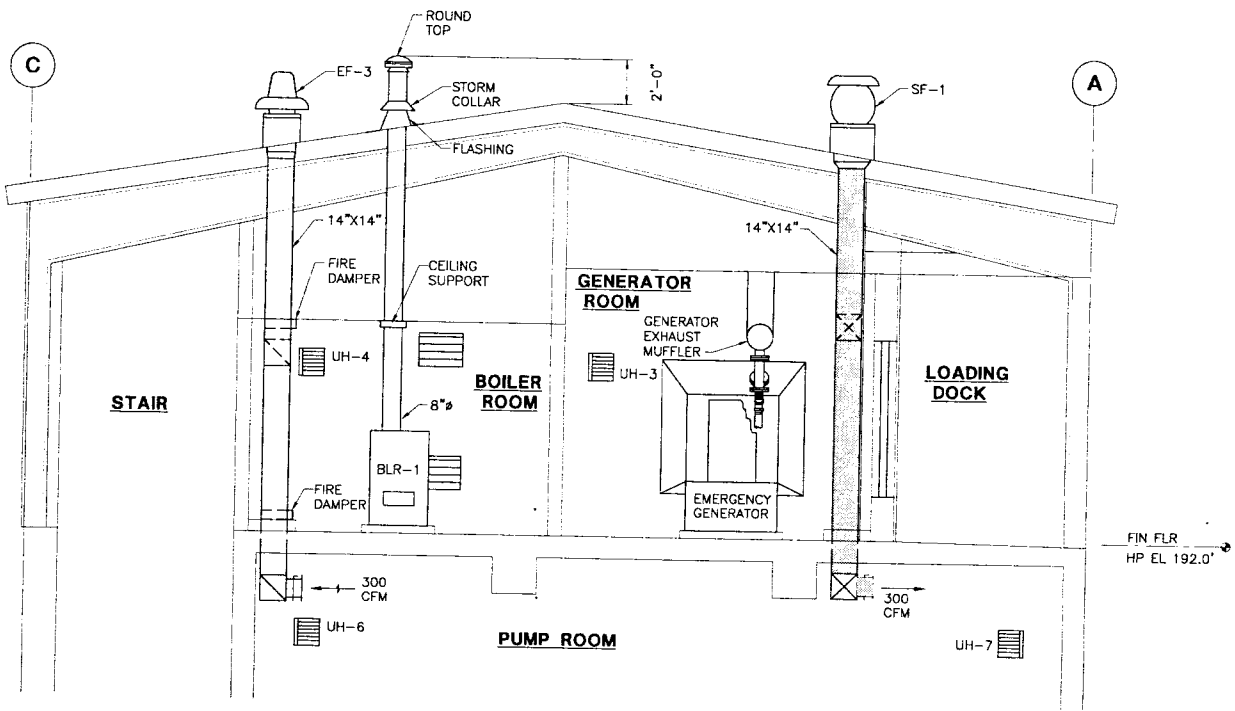

BUILDING SECTION
SCALE: 1/4"=1'-0"

NOTE: HWS & HWR PIPING NOT SHOWN FOR CLARITY

CONSTRUCTION NOTES

1. COORDINATE UNIT HEATER INSTALLATION ELEVATIONS WITH PROCESS PIPING.

THESE RECORD DRAWINGS HAVE BEEN PREPARED IN PART, ON THE BASIS OF THE INFORMATION FURNISHED BY THE TOWN OF EAST LONGMEADOW, MA. THE ENGINEER HAS NOT CONDUCTED A VISUAL SURVEY OF THE PROJECT AND HAS NOT BEEN ADVISED OF ANY CHANGES OR OMISSIONS WHICH HAVE BEEN INCORPORATED INTO THIS DOCUMENT AS A RESULT.

DEPARTMENT OF PUBLIC WORKS
TOWN OF EAST LONGMEADOW, MA
VINELAND AVENUE PUMP STATION
CONTRACTS NO. 1 AND NO. 2

SECTION

DWG M-3

36 OF 49

Wright-Pierce
80 Main Street
Topsfield, Maine USA 04098
TEL (207) 725-8731 FAX (207) 729-9414

REVISIONS		NO.	DESCRIPTION	DATE	BY
RECORD DRAWINGS		1	12/04		
CHECKED FOR REVIEW		2	12-02		
ISSUED FOR BIDDING		3	2-03		
LAST WORK ON		4			
PROJECT NO.		5	7051K		
SCALE		6	AS NOTED		