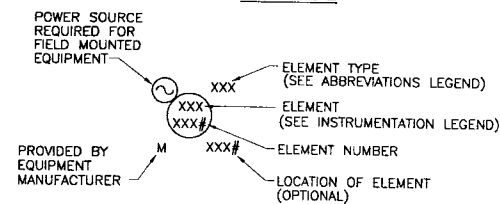



INSTRUMENTATION SYMBOL LEGEND

| PROPOSED | DESCRIPTION | EXISTING | DESCRIPTION |
|----------|---|----------|---|
| | PROCESS FLOW | | ELECTRICAL POWER OR PROCESS CONNECTION |
| | ELECTRICAL SIGNAL | | ELECTRICAL SIGNAL |
| | DATA LINK | | DATA LINK |
| | PLC INPUT/OUTPUT | | PLC INPUT/OUTPUT |
| | PNEUMATIC SIGNAL | | PNEUMATIC SIGNAL |
| | HYDRAULIC SIGNAL | | HYDRAULIC SIGNAL |
| | DISCRETE OUTPUT SIGNAL | | DISCRETE OUTPUT SIGNAL |
| | ANALOG OUTPUT SIGNAL | | ANALOG OUTPUT SIGNAL |
| | DISCRETE INPUT SIGNAL | | DISCRETE INPUT SIGNAL |
| | ANALOG INPUT SIGNAL | | ANALOG INPUT SIGNAL |
| | INTERLOCK | | INTERLOCK |
| | INTERLOCK I.D. NUMBER | | INTERLOCK I.D. NUMBER |
| | PROGRAMMABLE LOGIC CONTROLLER | | PROGRAMMABLE LOGIC CONTROLLER |
| | OPERATOR TERMINAL INTERFACE | | OPERATOR TERMINAL INTERFACE |
| | CONTROLLER | | CONTROLLER |
| | LOCAL(FIELD MOUNTED) | | LOCAL(FIELD MOUNTED) |
| | FRONT PANEL MOUNTED | | FRONT PANEL MOUNTED |
| | REAR PANEL MOUNTED | | REAR PANEL MOUNTED |
| | INTEGRAL EQUIPMENT | | INTEGRAL EQUIPMENT |
| | SIGNAL SPLITTER CONVERTER/BOOSTER (SEE BELOW) | | SIGNAL SPLITTER CONVERTER/BOOSTER (SEE BELOW) |
| | MOTOR | | MOTOR |
| | ALARM/ STATUS LIGHT | | ALARM/ STATUS LIGHT |

TYPICAL INSTRUMENTATION SYMBOL**INSTRUMENTATION LEGEND**

| FIRST LETTER | SUCCEEDING LETTER | |
|--------------|----------------------------|----------------------------|
| 1 | 2 | 3 |
| A | ANALYSIS | ALARM |
| B | CONTROL | CONTROL |
| C | DIFFERENTIAL* | CONTROL |
| D | DETECT | CONTROL |
| E | ELEMENT | CONTROL |
| F | FLOW | CONTROL |
| G | GAS | GLASS |
| H | HAND (MANUAL) | GLASS** |
| I | CURRENT | INDICATE |
| J | POWER | INDICATE |
| K | TIME* | INDICATE |
| L | LEVEL | LOW** |
| M | MOTOR | INTERMEDIATE |
| P | PRESSURE | INTERMEDIATE |
| Q | QUANTITY OR TOTALIZE* | INTERMEDIATE |
| R | RADIATION | RECORD |
| S | SPEED OR FREQUENCY | SIGNAL |
| T | TEMPERATURE | TRANSMIT |
| V | VACUUM | VALVE |
| W | TORQUE, WEIGHT, FORCE | VALVE |
| X | STATUS | RELAY, COMPUTE, OR CONVERT |
| Y | RELAY, COMPUTE, OR CONVERT | RELAY, COMPUTE, OR CONVERT |
| Z | POSITION | RELAY, COMPUTE, OR CONVERT |

* ALSO USED AS A MODIFIER AFTER FIRST LETTER (i.e. PDI: PRESSURE DIFFERENTIAL INDICATING TRANSMITTER)
 ** ALSO USED AS A MODIFIER AFTER LAST LETTER (i.e. LSHH: LEVEL SWITCH HIGH HIGH)

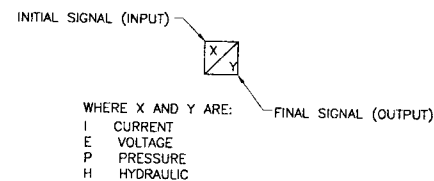TYPICAL SIGNAL CONVERTER SYMBOL

WHERE X AND Y ARE:
 I CURRENT
 E VOLTAGE
 P PRESSURE
 H HYDRAULIC

ABBREVIATIONS LEGEND

| | | | |
|-------|-------------------------------|-------|-------------------------------|
| ADM | ADMITTANCE | ADM | ADMITTANCE |
| CAP | CAPACITANCE | CL | CHLORINE |
| CL | CHLORINE | CP | CONTROL PANEL |
| CP | CONTROL PANEL | DO | DISSOLVED OXYGEN |
| DO | DISSOLVED OXYGEN | ESTOP | EMERGENCY STOP |
| EF | EXHAUST FAN | FOR | FORWARD-OFF-REVERSE |
| FSR | FORWARD-OFF-REVERSE | FRSA | FORWARD-STOP-REVERSE-AUTO |
| FRSA | FORWARD-STOP-REVERSE-AUTO | HIM | HAND INTERFACE MODULE (VFD) |
| HIM | HAND INTERFACE MODULE (VFD) | HQA | HAND-OFF-AUTO |
| HQA | HAND-OFF-AUTO | HS | HAND SWITCH |
| HS | HAND SWITCH | INF | INFLUENT |
| INF | INFLUENT | LCS | LOCAL CONTROL STATION |
| LCS | LOCAL CONTROL STATION | LOE | LOSS OF ECHO |
| LOE | LOSS OF ECHO | LOR | LOCAL-OFF-REMOTE |
| LOR | LOCAL-OFF-REMOTE | MCC | MOTOR CONTROL CENTER |
| MCC | MOTOR CONTROL CENTER | MS | MOTOR STARTER |
| MS | MOTOR STARTER | MTP | MASTER TELEMETRY PANEL |
| MTP | MASTER TELEMETRY PANEL | NOT | NORMAL-OFF-TEST |
| NOT | NORMAL-OFF-TEST | OCR | OPEN-CLOSE-REMOTE |
| OCR | OPEN-CLOSE-REMOTE | OCS | OPEN-CLOSE-STOP |
| OCS | OPEN-CLOSE-STOP | OPT | OPERATOR TERMINAL |
| OPT | OPERATOR TERMINAL | PCP | PUMP CONTROL PANEL |
| PCP | PUMP CONTROL PANEL | PLC | PROGRAMMABLE LOGIC CONTROLLER |
| PLC | PROGRAMMABLE LOGIC CONTROLLER | RESET | ALARM RESET |
| RESET | ALARM RESET | ROL | RAISE OFF LOWER |
| ROL | RAISE OFF LOWER | ROR | RUN-OFF-REMOTE |
| ROR | RUN-OFF-REMOTE | SCR | SPEED CONTROL RECTIFIER |
| SCR | SPEED CONTROL RECTIFIER | TURB | TURBIDITY |
| TURB | TURBIDITY | ULT | ULTRASONIC |
| ULT | ULTRASONIC | VFD | VARIABLE FREQUENCY DRIVE |
| VFD | VARIABLE FREQUENCY DRIVE | | |

EQUIPMENT SYMBOL LEGEND

| PROPOSED | DESCRIPTION |
|----------|------------------------------|
| | PUMP |
| | SUBMERSIBLE LEVEL TRANSDUCER |
| | MAGNETIC FLOW METER |
| | FLOAT SWITCH |
| | ULTRASONIC TRANSDUCER |
| | CHECK VALVE |
| | HORN |

CONTROL LOOPS

| LOOP NO. | DESCRIPTION |
|----------|---------------------------------------|
| 10 | HIGH HEADWORKS CHANNEL LEVEL |
| 30 | WET WELL NO. 1 LEVEL CONTROL |
| 31 | PUMP NO. 1 CONTROL |
| 32 | PUMP NO. 2 CONTROL |
| 33 | WET WELL NO. 2 LEVEL CONTROL |
| 34 | PUMP NO. 3 CONTROL |
| 35 | PUMP NO. 4 CONTROL |
| 36 | STATION MONITORING |
| 40 | EFFLUENT FLOW WET WELL PUMP DISCHARGE |
| 55 | LOW SEAL WATER PRESSURE |

NOTES:

- REFER TO ELECTRICAL DRAWINGS FOR ADDITIONAL INFORMATION.
- PROVIDE SIGNAL REPEATERS/CONVERTERS/BOOSTERS AS REQUIRED BASED UPON EQUIPMENT SELECTED BY INSTRUMENTATION SUPPLIER, DISTANCE AND LOCATION.
- PROVIDE DRIP SHIELDS TO PROTECT ALL PANELS LOCATED UNDERNEATH PIPES OR OTHER LIQUID-CONTAINING STRUCTURES.
- REFERENCE PROCESS AND ELECTRICAL DRAWINGS FOR LOCATION OF PANELS AND FIELD INSTRUMENTATION.
- REFER TO SPECIFICATION SECTION 13440 AND 13442 FOR ADDITIONAL INFORMATION REGARDING INSTRUMENTATION.
- THE ELECTRICAL CONTRACTOR WILL PROVIDE AND INSTALL 10% SPARE INSTRUMENTATION WIRES WITH A LIMIT OF TWO SPARES PER CONDUIT UP TO THE LIMIT OF CONDUIT FILL AS SPECIFIED BY NEC.
- INSTRUMENTATION CONTRACTOR TO COORDINATE NEEDED VOLTAGE BASED UPON EQUIPMENT SUPPLIED.
- ALL FLOOR MOUNTED CONTROL PANELS SHALL BE INSTALLED ON 4" HIGH CONCRETE EQUIPMENT PADS.
- WHERE INPUT AND OUTPUT SIGNALS TO A PLC IS REQUIRED, PROVIDE PROPER TYPE AND QUANTITY OF INPUT/OUTPUT MODULES (I/O).
- INSTRUMENTATION CONTRACTOR SHALL COORDINATE THE TYPE OF ANALOG SIGNAL PROVIDED BY THE EQUIPMENT OR FIELD DEVICES WITH THE PROPER TYPE PLC I/O.
- ALL ANALOG SIGNALS WILL BE 4-20mA, UNLESS OTHERWISE INDICATED OR REQUIRED.
- FOR CONTROL PANEL REQUIREMENTS, INCLUDING SIZING PROVISIONS AND MINIMUM AND MAXIMUM HEIGHT CONSTRAINTS ON CONTROL DEVICES, REFER TO SPECIFICATIONS 13440 AND 16160.
- INSTRUMENTATION SUPPLIER SHALL RECEIVE TERMINAL CONNECTION DIAGRAMS FROM ELECTRICAL SUBCONTRACTOR PERTAINING TO TERMINATIONS IN MCC, LOCAL CONTROL STATIONS AND ALL EQUIPMENT SUPPLIED BY ELECTRICAL SUBCONTRACTOR.
- INSTRUMENTATION SUPPLIER SHALL PROVIDE POINT TO POINT WIRING SCHEMATICS TO ELECTRICAL SUBCONTRACTOR TO ALLOW COMPLETION OF ALL CONTROL WIRING BETWEEN DEVICES, CONTROL PANELS AND ALL EQUIPMENT PROVIDED BY INSTRUMENTATION SUPPLIER AND EQUIPMENT PROVIDED BY ELECTRICAL SUBCONTRACTOR.

THESE RECORD DRAWINGS HAVE BEEN PREPARED IN PART ON THE BASIS OF THE INFORMATION PROVIDED BY THE INSTRUMENTATION SUPPLIER. THE INSTRUMENTATION SUPPLIER IS RESPONSIBLE FOR THE ACCURACY OF THE INFORMATION PROVIDED AND FOR THE COMPLETION OF THE INSTRUMENTATION. THE INSTRUMENTATION SUPPLIER IS RESPONSIBLE FOR THE COMPLETION OF THE INSTRUMENTATION. THE INSTRUMENTATION SUPPLIER IS RESPONSIBLE FOR THE COMPLETION OF THE INSTRUMENTATION.

DEPARTMENT OF PUBLIC WORKS
 TOWN OF EAST LONGMEADOW, MA
 VINLAND AVENUE PUMP STATION
 CONTRACTS NO. 1 AND NO. 2
 INSTRUMENTATION
 NOTES, ABBREVIATIONS AND LEGEND

DWG I-1

41 OF 49

Wright-Pierce
 169 Main Street 700 Plaza Middlesex
 Middletown, Connecticut USA 06457
 TEL (860) 346-3287 FAX (860) 346-9504

| | | | |
|-------------|-------------------|-------|----------|
| DESIGNED BY | SM | DATE | 12/04 |
| CHECKED BY | SM | DATE | 12/04 |
| APPROVED BY | SM | DATE | 12/04 |
| BOOK NO. | 7051K | SCALE | AS NOTED |
| PROJECT NO. | 7051K | | |
| REVISIONS | | | |
| NO. | DESCRIPTION | DATE | |
| 1 | RECORD DRAWINGS | 12/04 | |
| 2 | USED FOR REVIEW | 12/04 | |
| 3 | USED FOR BUILDING | 2/05 | |
| 4 | LAST WIRING ON | | |
| 5 | FILED | | |