
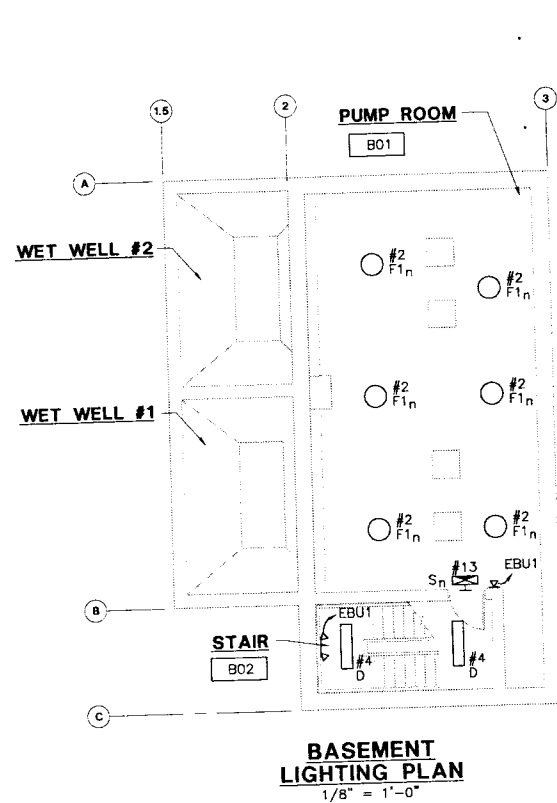


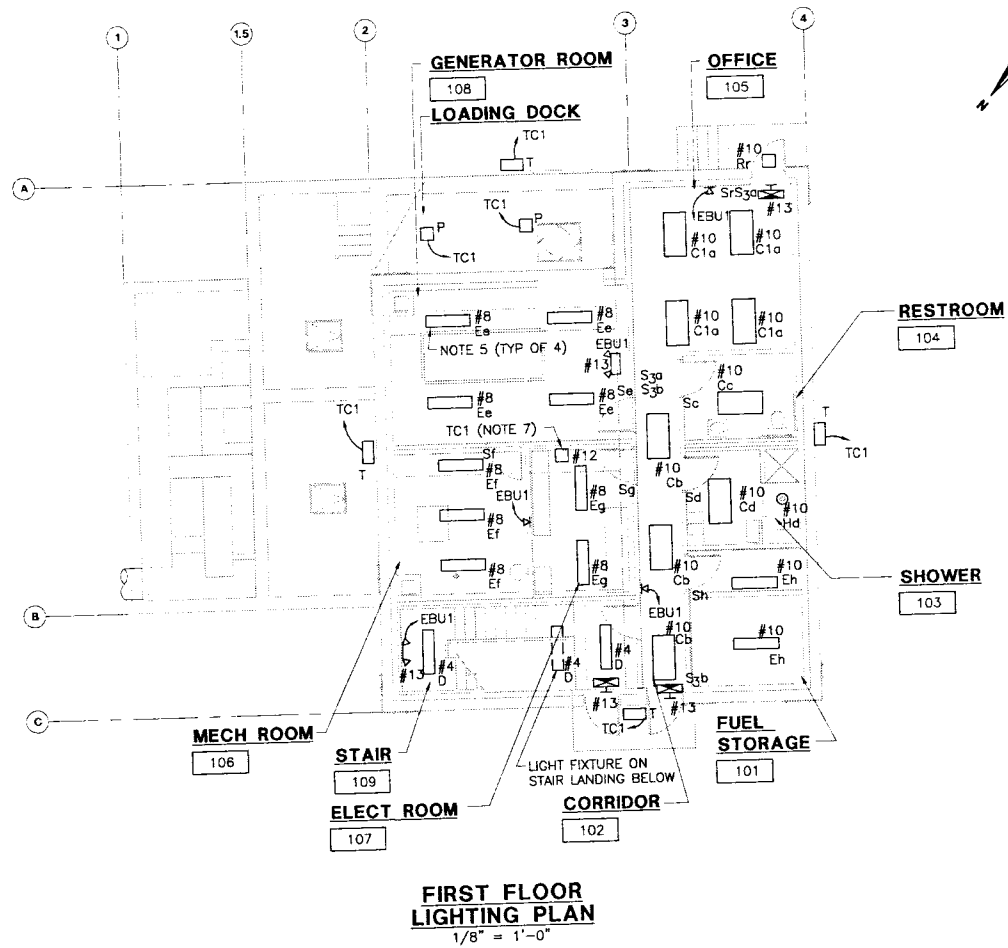

LIGHTING FIXTURE SCHEDULE:						
CODE	LIGHT SOURCE	LAMPING	MOUNTING	MANUFACTURER	CATALOG NO.	VOLTS
	TYPE					
C	FLUORESCENT	(2)F32T8	CEILING RECESSED	COOPER-METALUX	2GS-232A-120-EB81	120
C1	FLUORESCENT	(3)F32T8	CEILING RECESSED	COOPER-METALUX	2GS-332A-120-EB81	120
D	FLUORESCENT	(2)F32T8	CEILING SURFACE	COOPER-METALUX	VT2-232DR-120-EB81-WL	120
E	FLUORESCENT	(2)F32T8	PENDANT, 8FT. AFF OR AS NOTED ON DRAWINGS	COOPER-METALUX	DIM-232-120-EB81	120
F1	METAL HALIDE	175W MH	PENDANT, 14FT. AFF	COOPER-LUMARK	MHBE-5A-175-120-F1-WLB-EM	120
H	INCAND.	40W A19	CEILING RECESSED	COOPER-HALO	H51CAT-5050-PS	120
P	METAL HALIDE	175W MH	CEILING SURFACE	COOPER-LUMARK	MHPR-175W-120V-F1	120
R	METAL HALIDE	50W MH	WALL *	COOPER-LUMARK	MHMN-50-120-LL-F1-PE	120
T	METAL HALIDE	175W MH	WALL *	COOPER-LUMARK	MHWL-175-120-F1-VS/WL	120
⏏	INCAND.	(2) 9W, 12V	WALL, 7'AFF	COOPER-SURE-LITES	XR-21-SD	120
▽	INCAND.	8W, 12V	WALL, 7'AFF	COOPER-SURE-LITES	12X-8-WHU	12VDC
▽▽	INCAND.	(2) 8W, 12V	WALL, 7'AFF	COOPER-SURE-LITES	12X-8-WHU	12VDC
⏏	LED		WALL, 7'AFF	COOPER-SURE-LITES	CCX-7070-RWH	120
* REFER TO ARCHITECTURAL BUILDING ELEVATIONS FOR FIXTURE MOUNTING HEIGHTS						
DESCRIPTION						
2x 4 FLUOR. STATIC TROFFER, ACRYLIC LENS, ELECTRONIC BALLAST						
SAME AS TYPE C, EXCEPT 3 LAMP						
4 FT. ENCL. & GASKETED FLUOR., WET LOCATION, ELECTRONIC BALLAST						
4 FT. FLUOR., INDUSTRIAL REFLECTOR, 20% UPLIGHT, ELECTRONIC BALLAST						
METAL HALIDE LOW-BAY INDUSTRIAL, UL WET LOCATION, SINGLE FUSING, WITH QUARTZ RESTRIKE WITH DELAY RELAY						
UL WET LOCATION SHOWER LIGHT, IC HOUSING						
METAL HALIDE LOADING DOCK FIXTURE, UL WET LOCATION, SINGLE FUSING						
METAL HALIDE COMPACT WALLPACK, UL WET LOCATION, SHARP CUT-OFF, LAMP INCLUDED, SINGLE FUSING, WITH PHOTOCONTROL						
METAL HALIDE WALLPACK, UL WET LOCATION, WITH BOROSILICATE GLASS REFRACTOR, SINGLE FUSING, AND VISOR CUT-OFF SHIELD						
EMERG. BATTERY UNIT W/2 LAMPS, NI-CAD BATTERY						
SINGLE REMOTE EMERG. LIGHT						
DOUBLE REMOTE EMERG. LIGHT						
SELF-POWERED EXIT, NI-CAD BATTERY						

- NOTES:**
- FOR LEGEND AND GENERAL NOTES, REFER TO DRAWING E-1.
 - CIRCUIT NUMBERS ON THIS DRAWING REFER TO PANELBOARD LP-1, UNLESS OTHERWISE NOTED.
 - FOR PANELBOARD SCHEDULE, REFER TO DRAWING E-3.
 - 120 VOLT CIRCUITS EXCEEDING 100 FEET IN LENGTH SHALL BE NO. 10 AWG WIRING.
 - LIGHT FIXTURES IN GENERATOR ROOM SHALL BE PENDANT MOUNTED 10 FEET ABOVE FINISHED FLOOR.
 - STAIRWELL LIGHT FIXTURES SHALL BE CONNECTED TO DESIGNATED CIRCUIT WITHOUT SWITCHING, TO BE IN CONTINUOUS OPERATION.
 - EXTERIOR WALLPACK AND LOADING DOCK LIGHT FIXTURES SHALL BE CIRCUITED TO, AND CONTROLLED BY, TIME CLOCK TC1.

THESE RECORD DRAWINGS HAVE BEEN PREPARED IN PART ON THE BASIS OF THE INFORMATION FURNISHED BY OTHERS. THE ENGINEER WILL NOT BE RESPONSIBLE FOR ANY ERRORS OR OMISSIONS WHICH HAVE BEEN INCORPORATED INTO THIS DOCUMENT AS A RESULT.

DEPARTMENT OF PUBLIC WORKS
TOWN OF EAST LONGMEADOW, MA
VINELAND AVENUE PUMP STATION
CONTRACTS NO. 1 AND NO. 2

DWG E-4
46 OF 49

Wright-Pierce
169 Main Street, 700 Plaza Middlesex
Middletown, Connecticut USA 06457
TEL (860) 343-8297 FAX (860) 343-9504

NO.	REVISIONS	DATE	BY	REASON
1	ISSUED FOR REVIEW	12-02		
2	ISSUED FOR BIDDING	2-03		
3	AS NOTED			
4	AS NOTED			
