


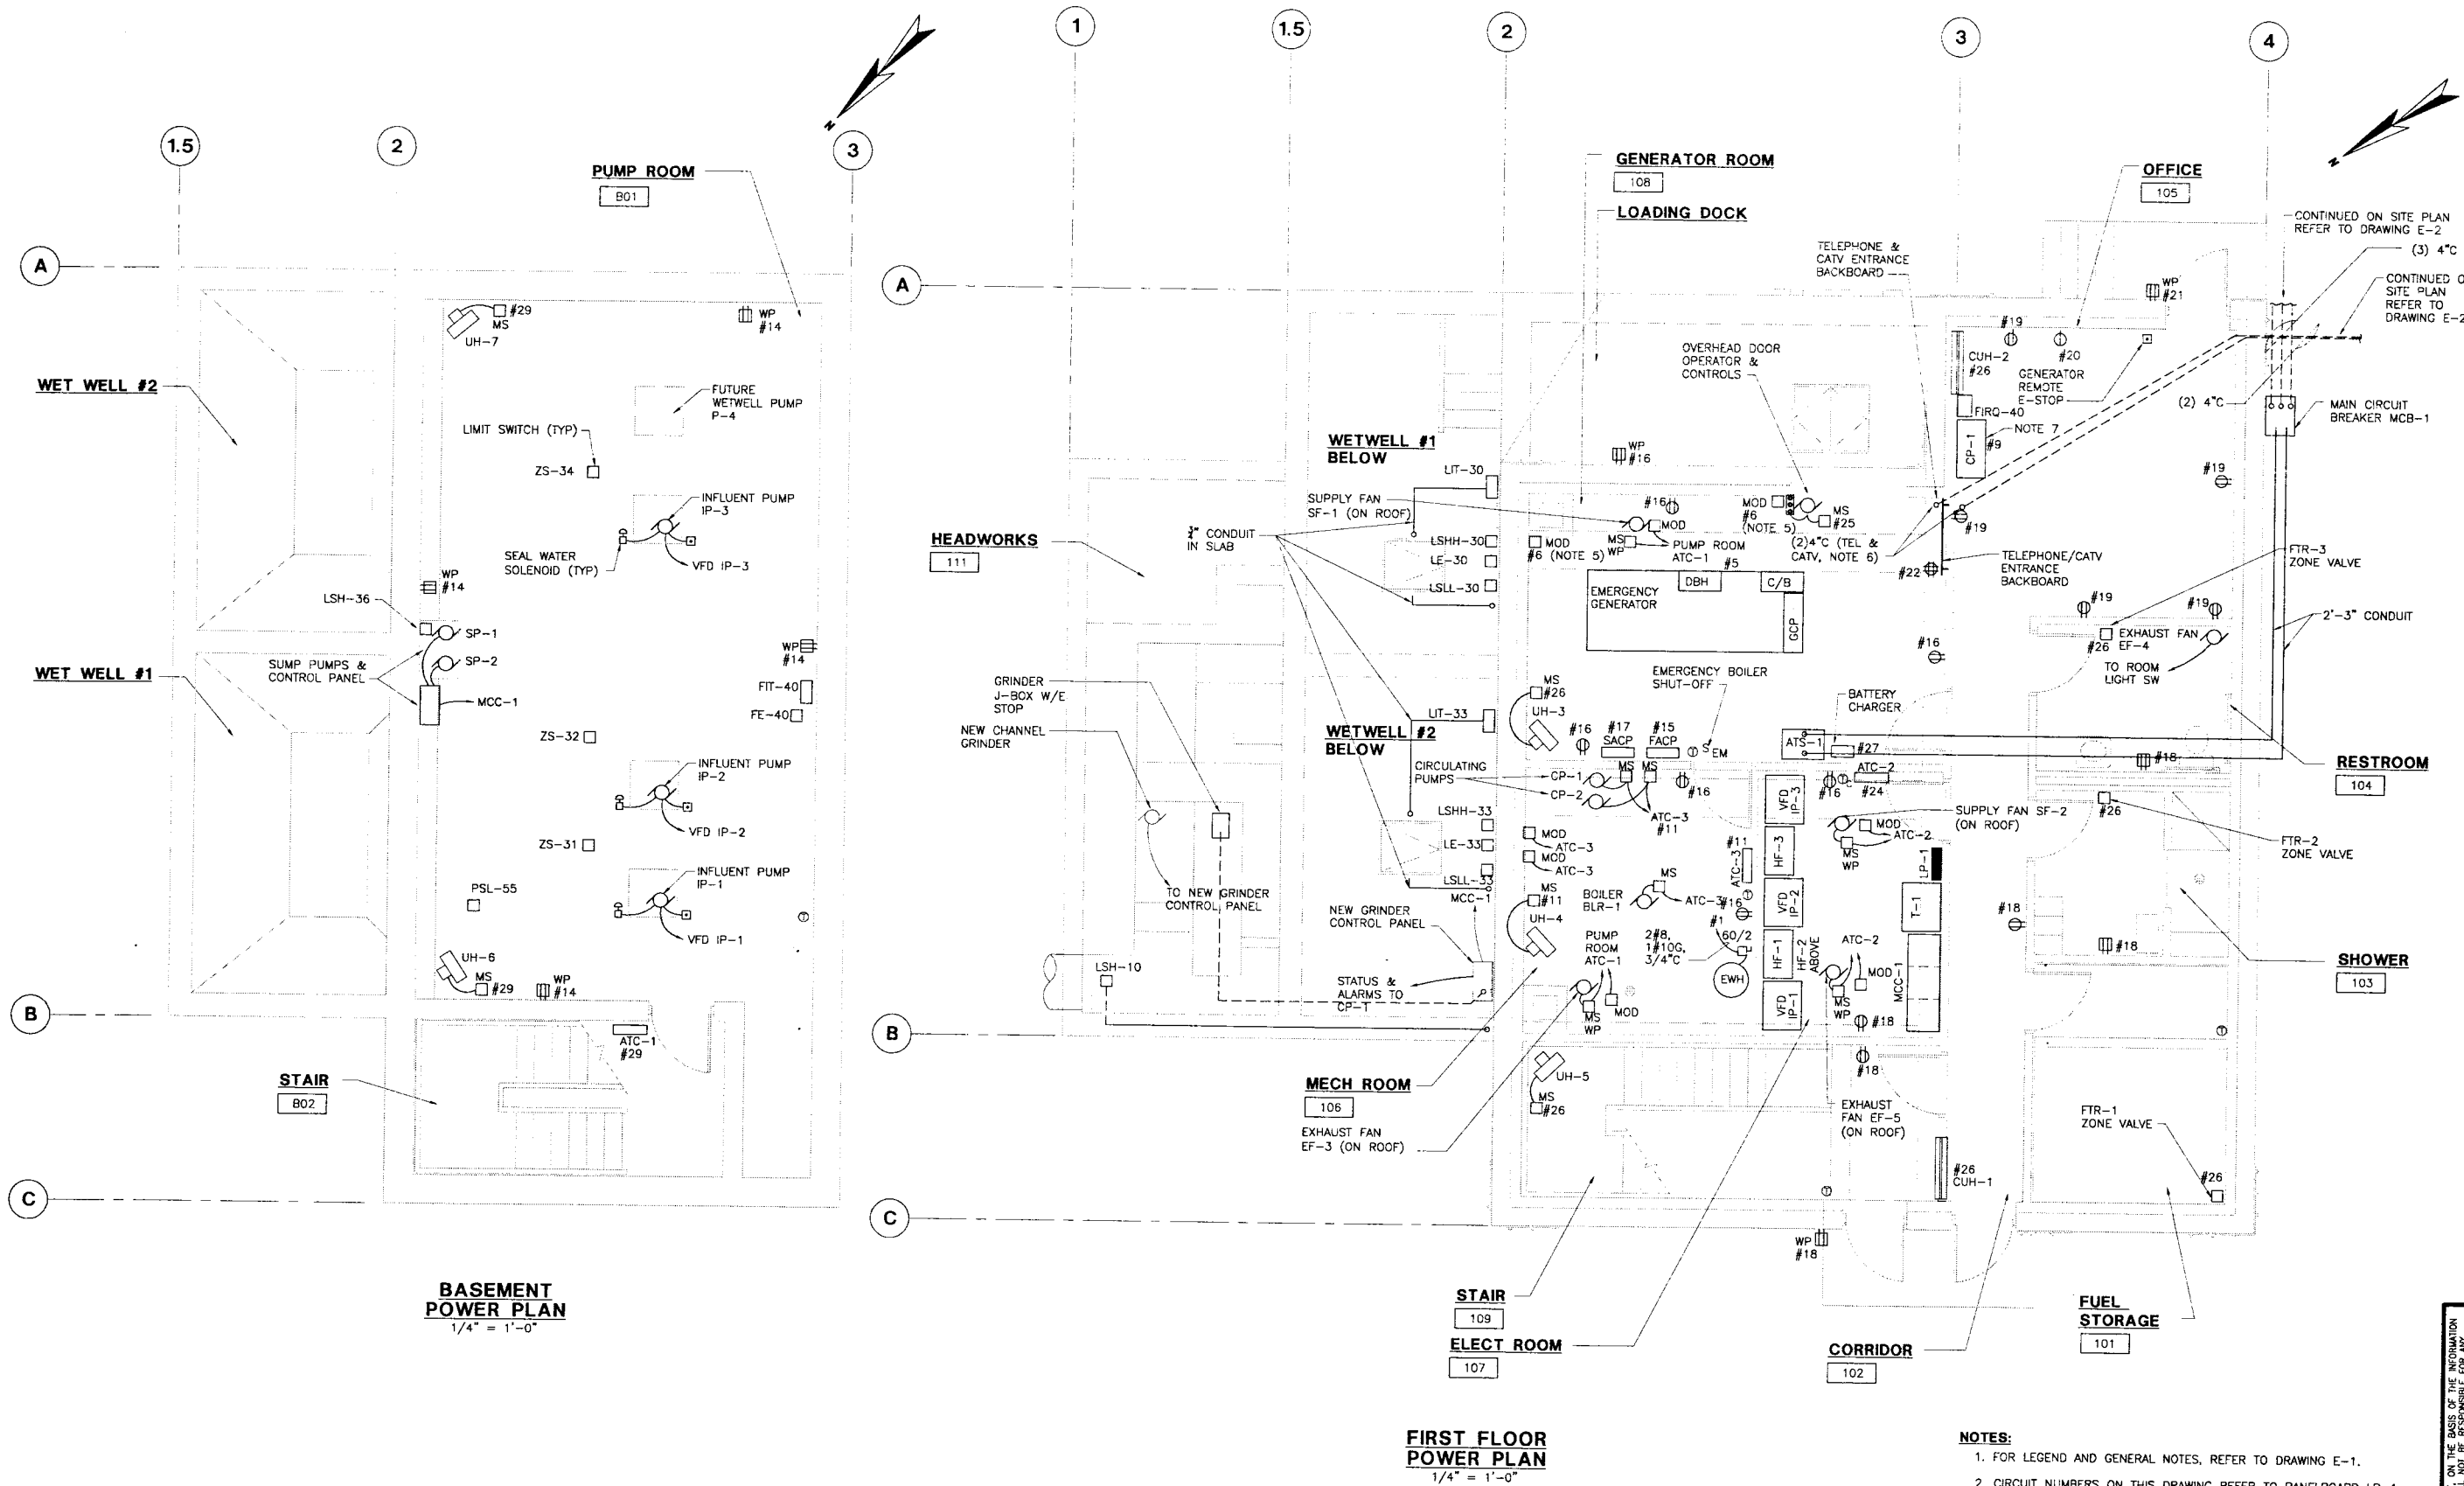

**BASEMENT
POWER PLAN**
1/4" = 1'-0"

**FIRST FLOOR
POWER PLAN**
1/4" = 1'-0"

NOTES:

1. FOR LEGEND AND GENERAL NOTES, REFER TO DRAWING E-1.
2. CIRCUIT NUMBERS ON THIS DRAWING REFER TO PANELBOARD LP-1, UNLESS OTHERWISE NOTED.
3. FOR PANELBOARD SCHEDULE, REFER TO DRAWING E-3.
4. 120 VOLT CIRCUITS EXCEEDING 100 FEET IN LENGTH SHALL BE NO. 10 AWG WIRING.
5. INTERLOCK MOTOR OPERATED INTAKE AND DISCHARGE DAMPERS WITH GENERATOR TO OPEN WHEN GENERATOR RUNS.
6. PROVIDE TWO (2) 4 INCH CONDUITS, ONE FOR TELEPHONE SERVICE, ONE FOR FUTURE CABLE TV SERVICE.
7. PROVIDE 3/4 INCH CONDUIT WITH PULLCORD FROM MAIN CONTROL PANEL CP-1 TO RADIO TELEMETRY ANTENNA. ANTENNA TO BE LOCATED AT ROOF PEAK ON EAST END OF BUILDING AS SHOWN ON DRAWING A-3. ANTENNA CABLE SHALL BE PROVIDED BY INSTRUMENTATION SUPPLIER.

THESE RECORD DRAWINGS HAVE BEEN PREPARED, IN PART, ON THE BASIS OF THE INFORMATION FURNISHED BY THE CLIENT. THE ENGINEER HAS CONDUCTED VISUAL GENERAL VERIFICATION OF THE INFORMATION AND HAS NOTED ANY DISCREPANCIES OR OMISSIONS WHICH HAVE BEEN INCORPORATED INTO THIS DOCUMENT AS A RESULT.

DEPARTMENT OF PUBLIC WORKS
TOWN OF EAST LONGMEADOW, MA
VINELAND AVENUE PUMP STATION
CONTRACTS NO. 1 AND NO. 2

Wright-Pierce
169 Main Street 700 Plaza Middlesex
Middletown, Connecticut USA 06457
TEL (860) 343-8297 FAX (860) 343-9504

POWER PLANS

NO.	REVISIONS	DATE	BY	CHKD.	APP'D.
1	ISSUED FOR BIDDING	12-02			
2	ISSUED FOR BIDDING	2-03			
3	ISSUED FOR BIDDING	2-03			
NO.	REVISIONS	DATE	BY	CHKD.	APP'D.
1	ISSUED FOR BIDDING	12-04			
2	ISSUED FOR BIDDING	12-04			
3	ISSUED FOR BIDDING	12-04			
NO.	REVISIONS	DATE	BY	CHKD.
-----	-----------	------	----	-------