
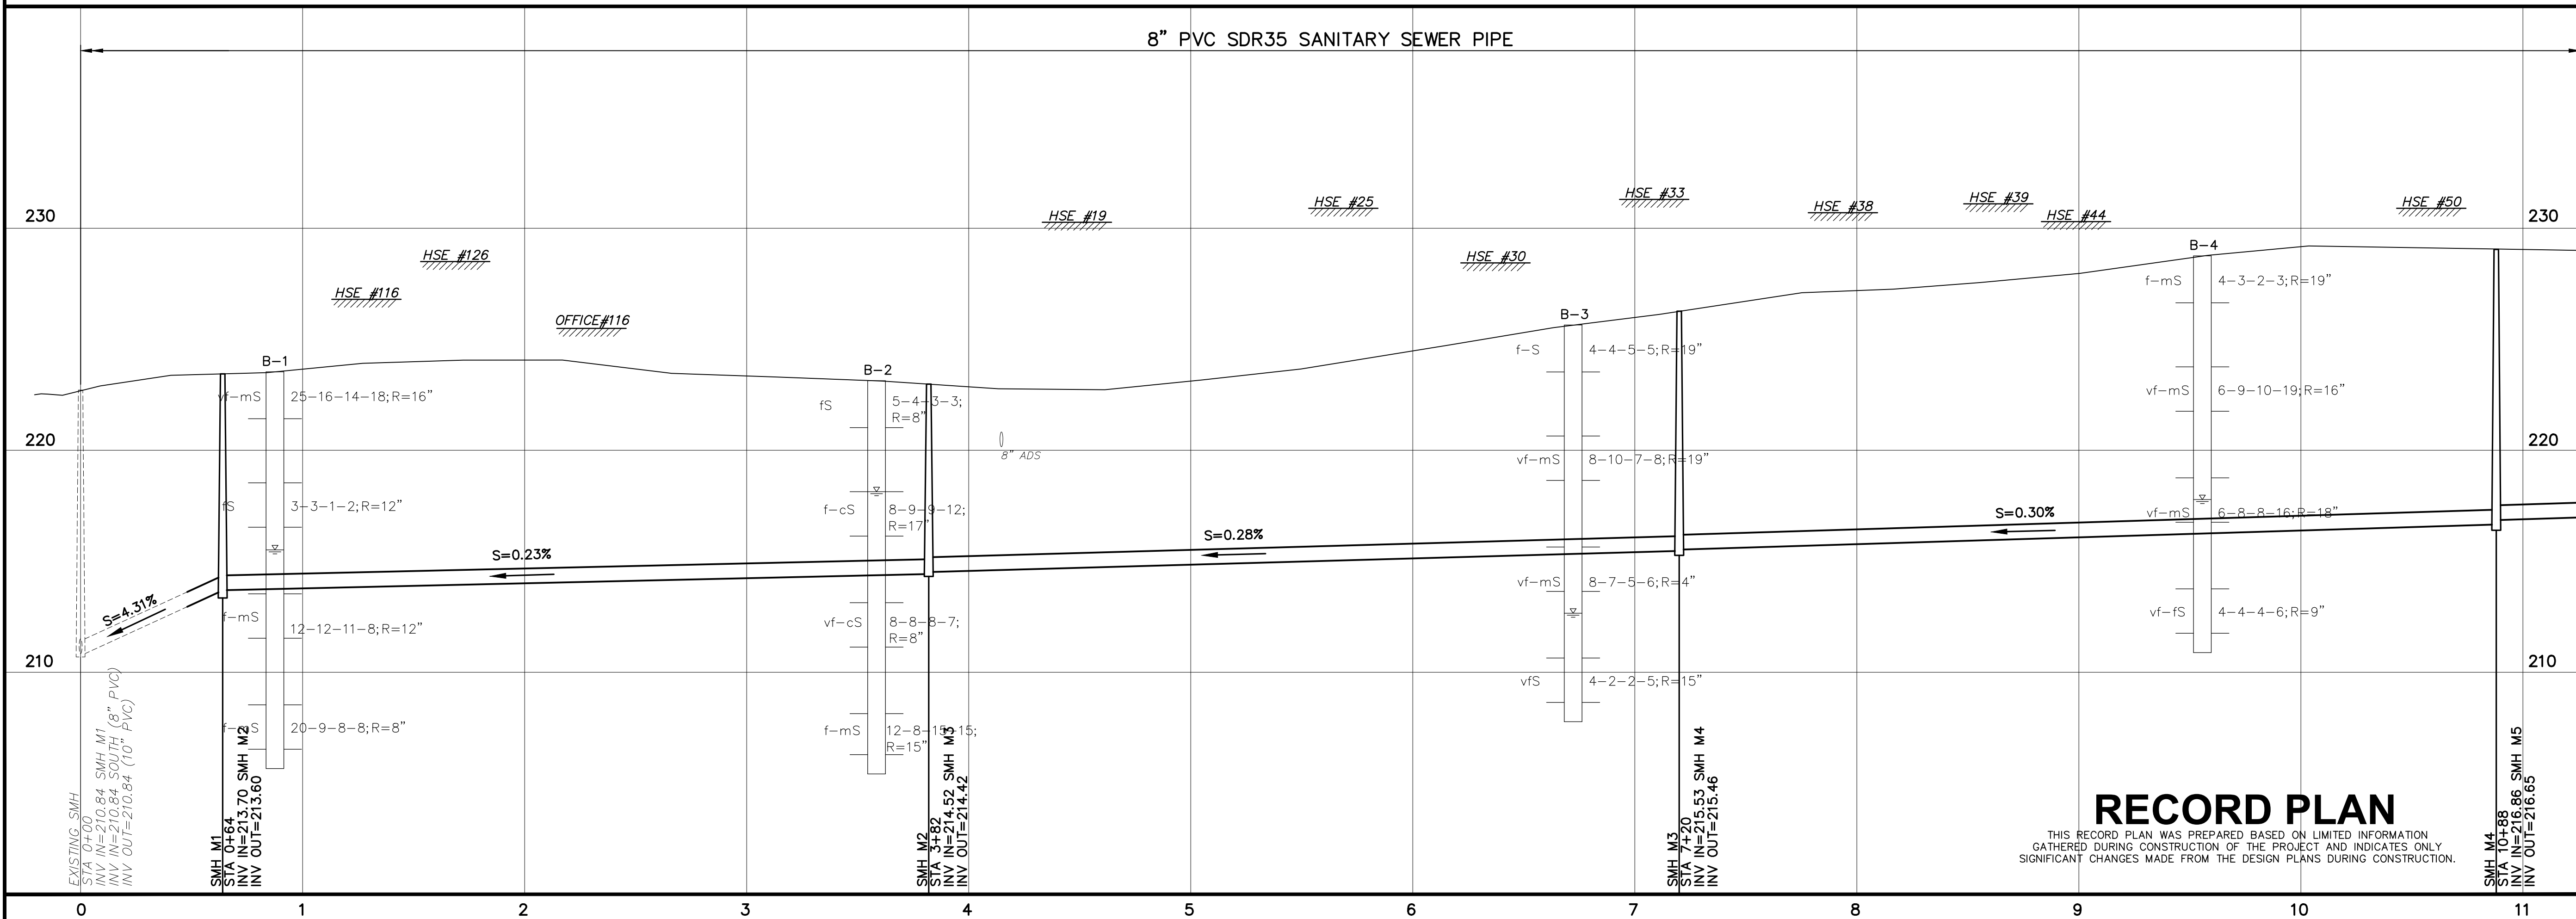


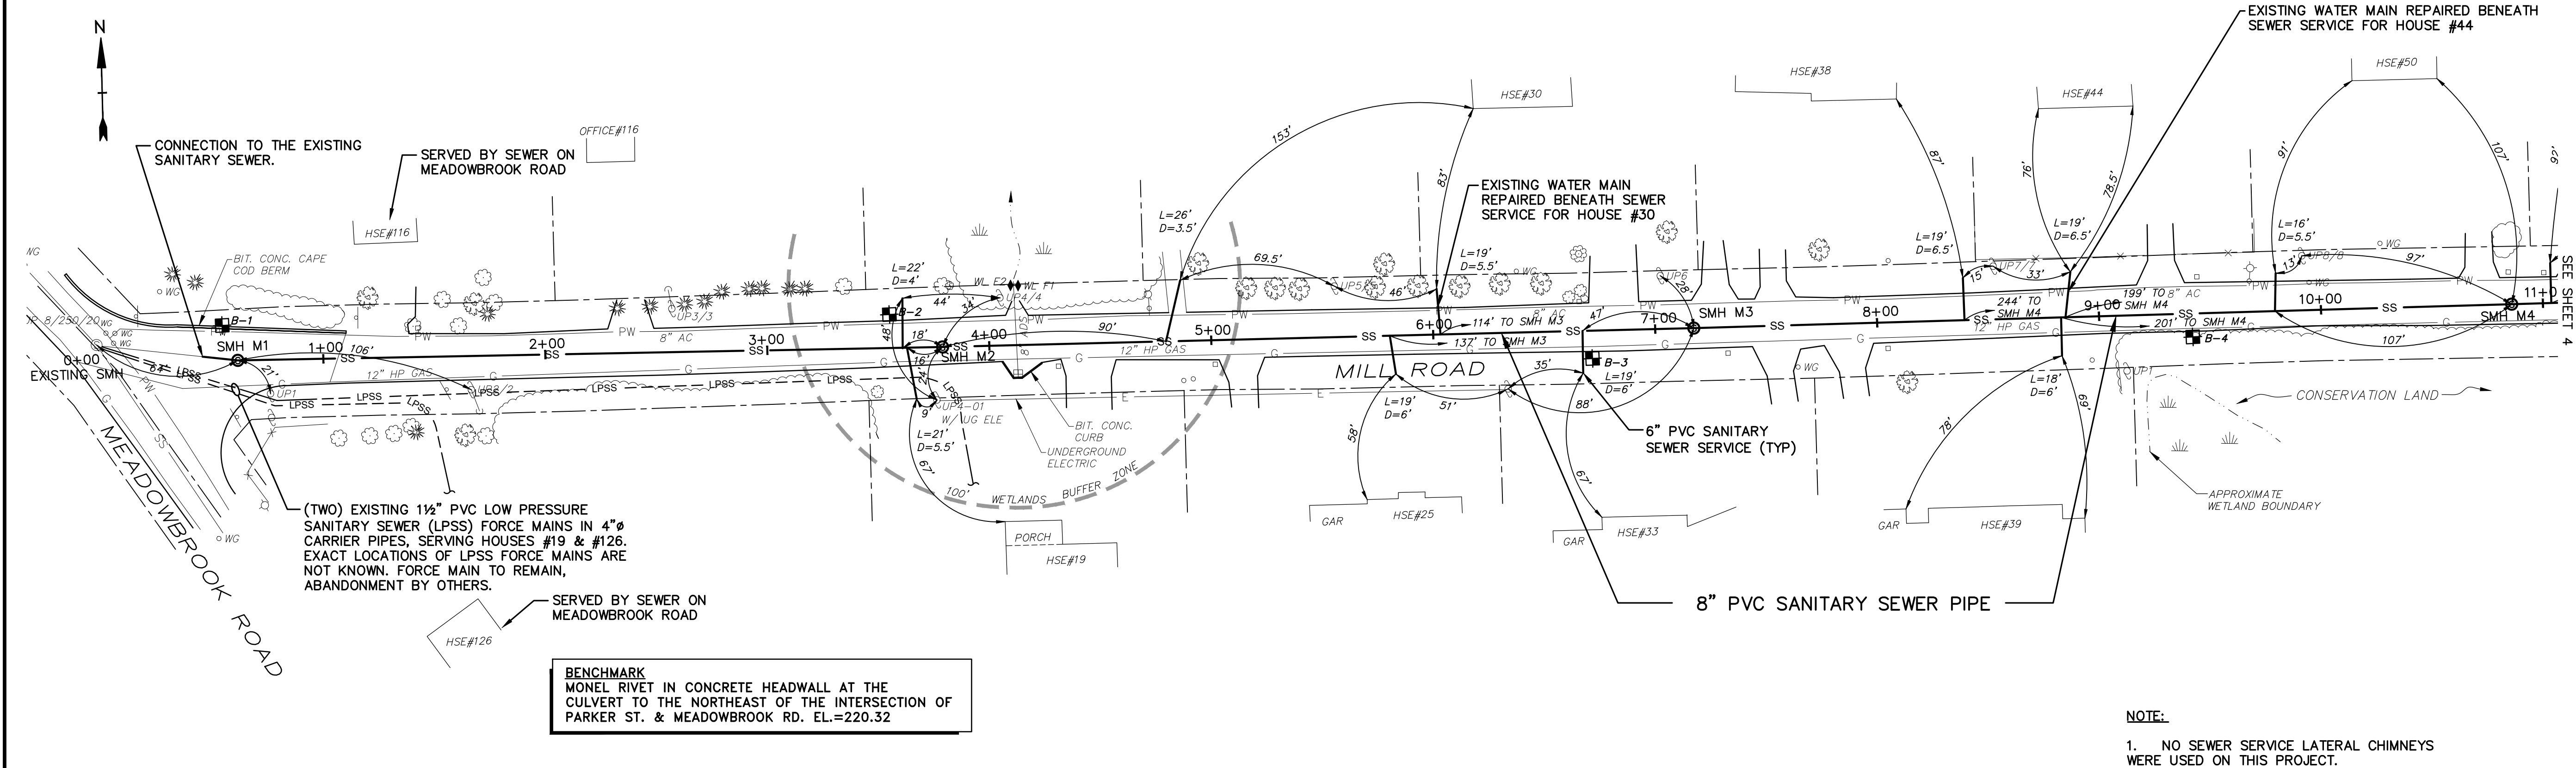

Board of Public Works

Mill Road Sanitary Sewer Project

East Longmeadow, Massachusetts

1	12/15/05	RECORD PLAN
Mark	Date	Description
PROJECT NO:	E0451117	
FILE:	E0451117 Mill Road/PLAN.dwg/SHEET3	
DRAWN BY:	ARG	
CHECKED:	DRP	
APPROVED BY:	RP/MP	
MILL ROAD		
STA 0+00 TO STA 11+00		
SCALE:	1"=40 H; 1"=4" V	