


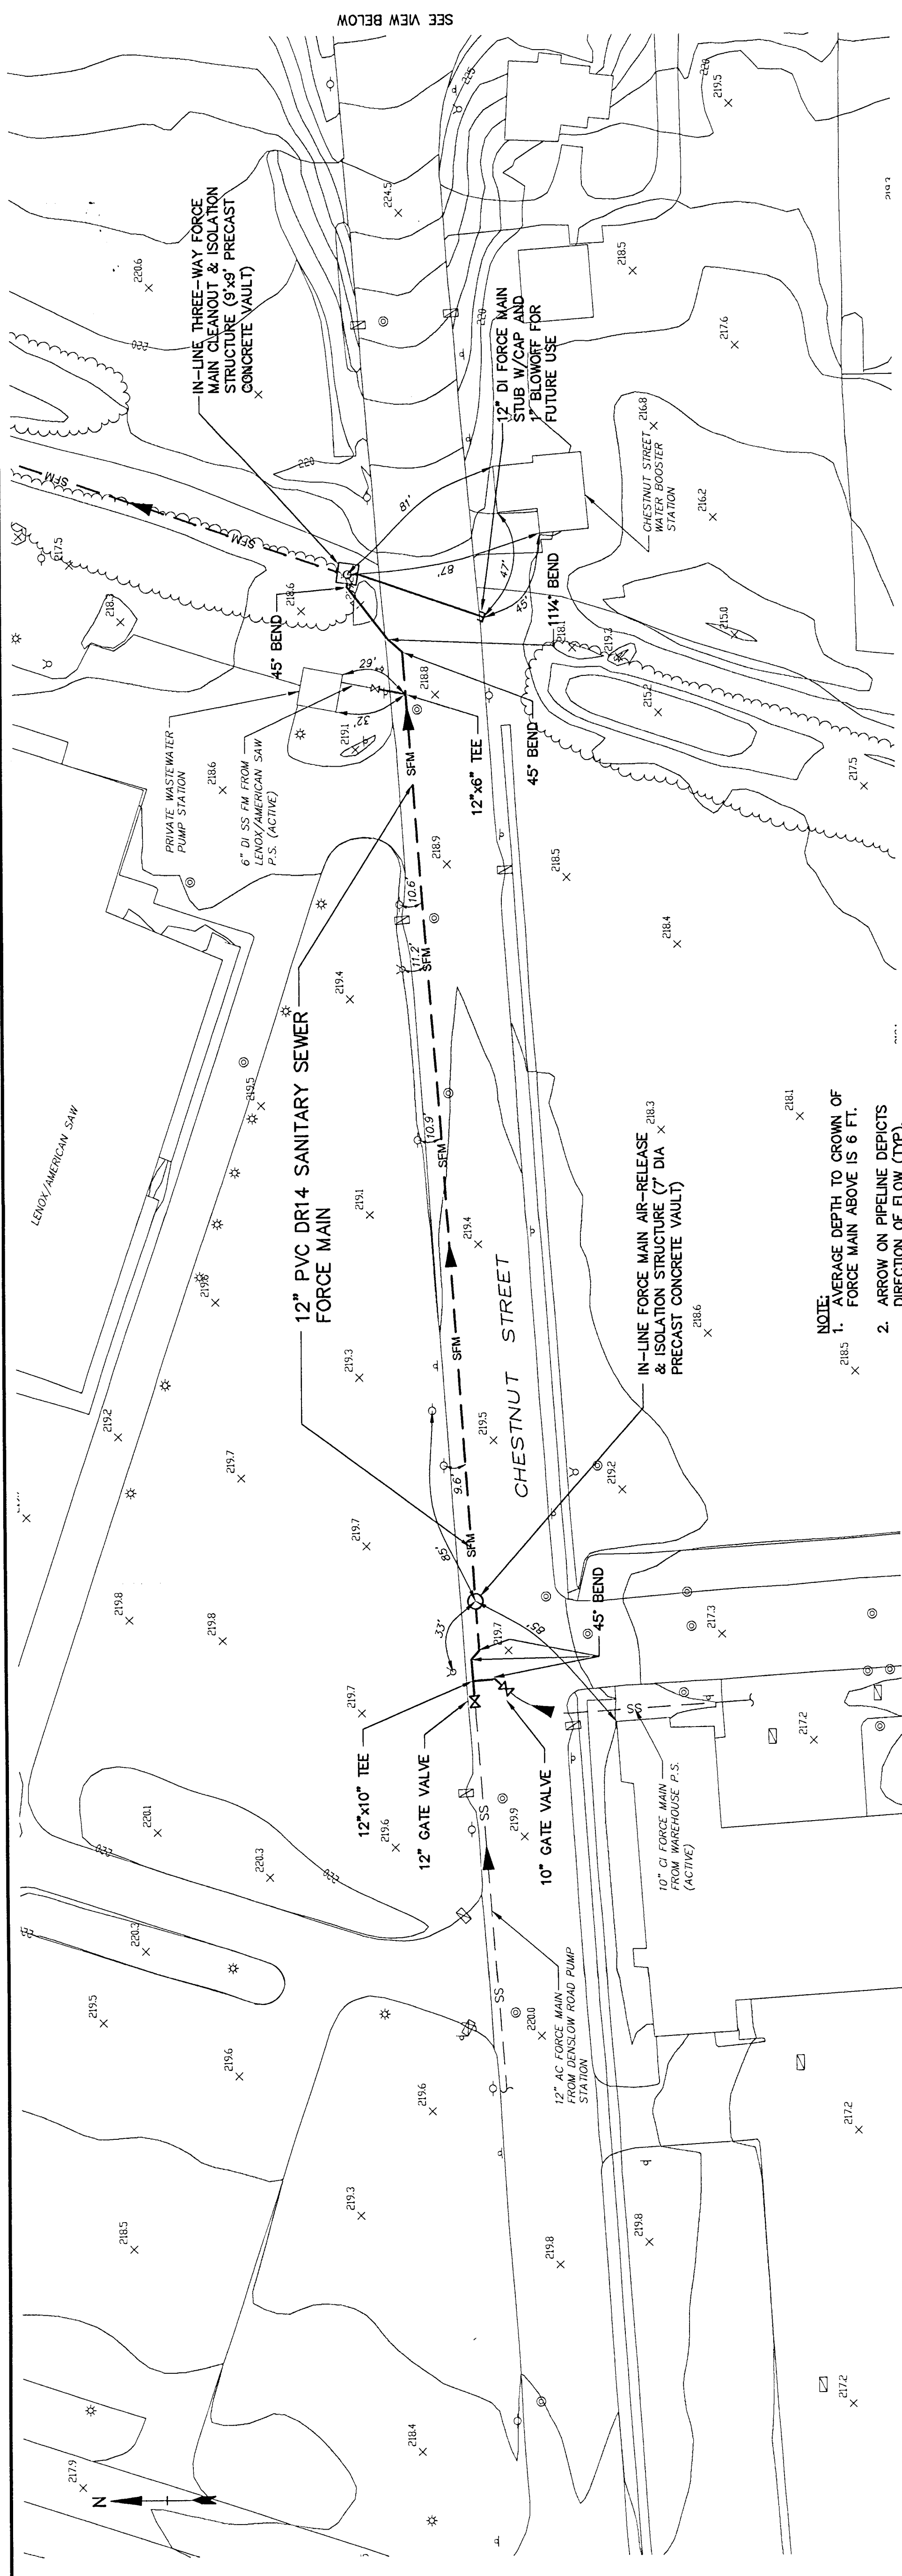


NOTE:

1. AVERAGE DEPTH TO CROWN OF FORCE MAIN ABOVE IS 6 FT.
2. ARROW ON PIPELINE DEPICTS DIRECTION OF FLOW (TYP).

**Board of
Public Works**

Shaker Road
Sewer
Replacement
Contract No. 1

East Longmeadow,
Massachusetts

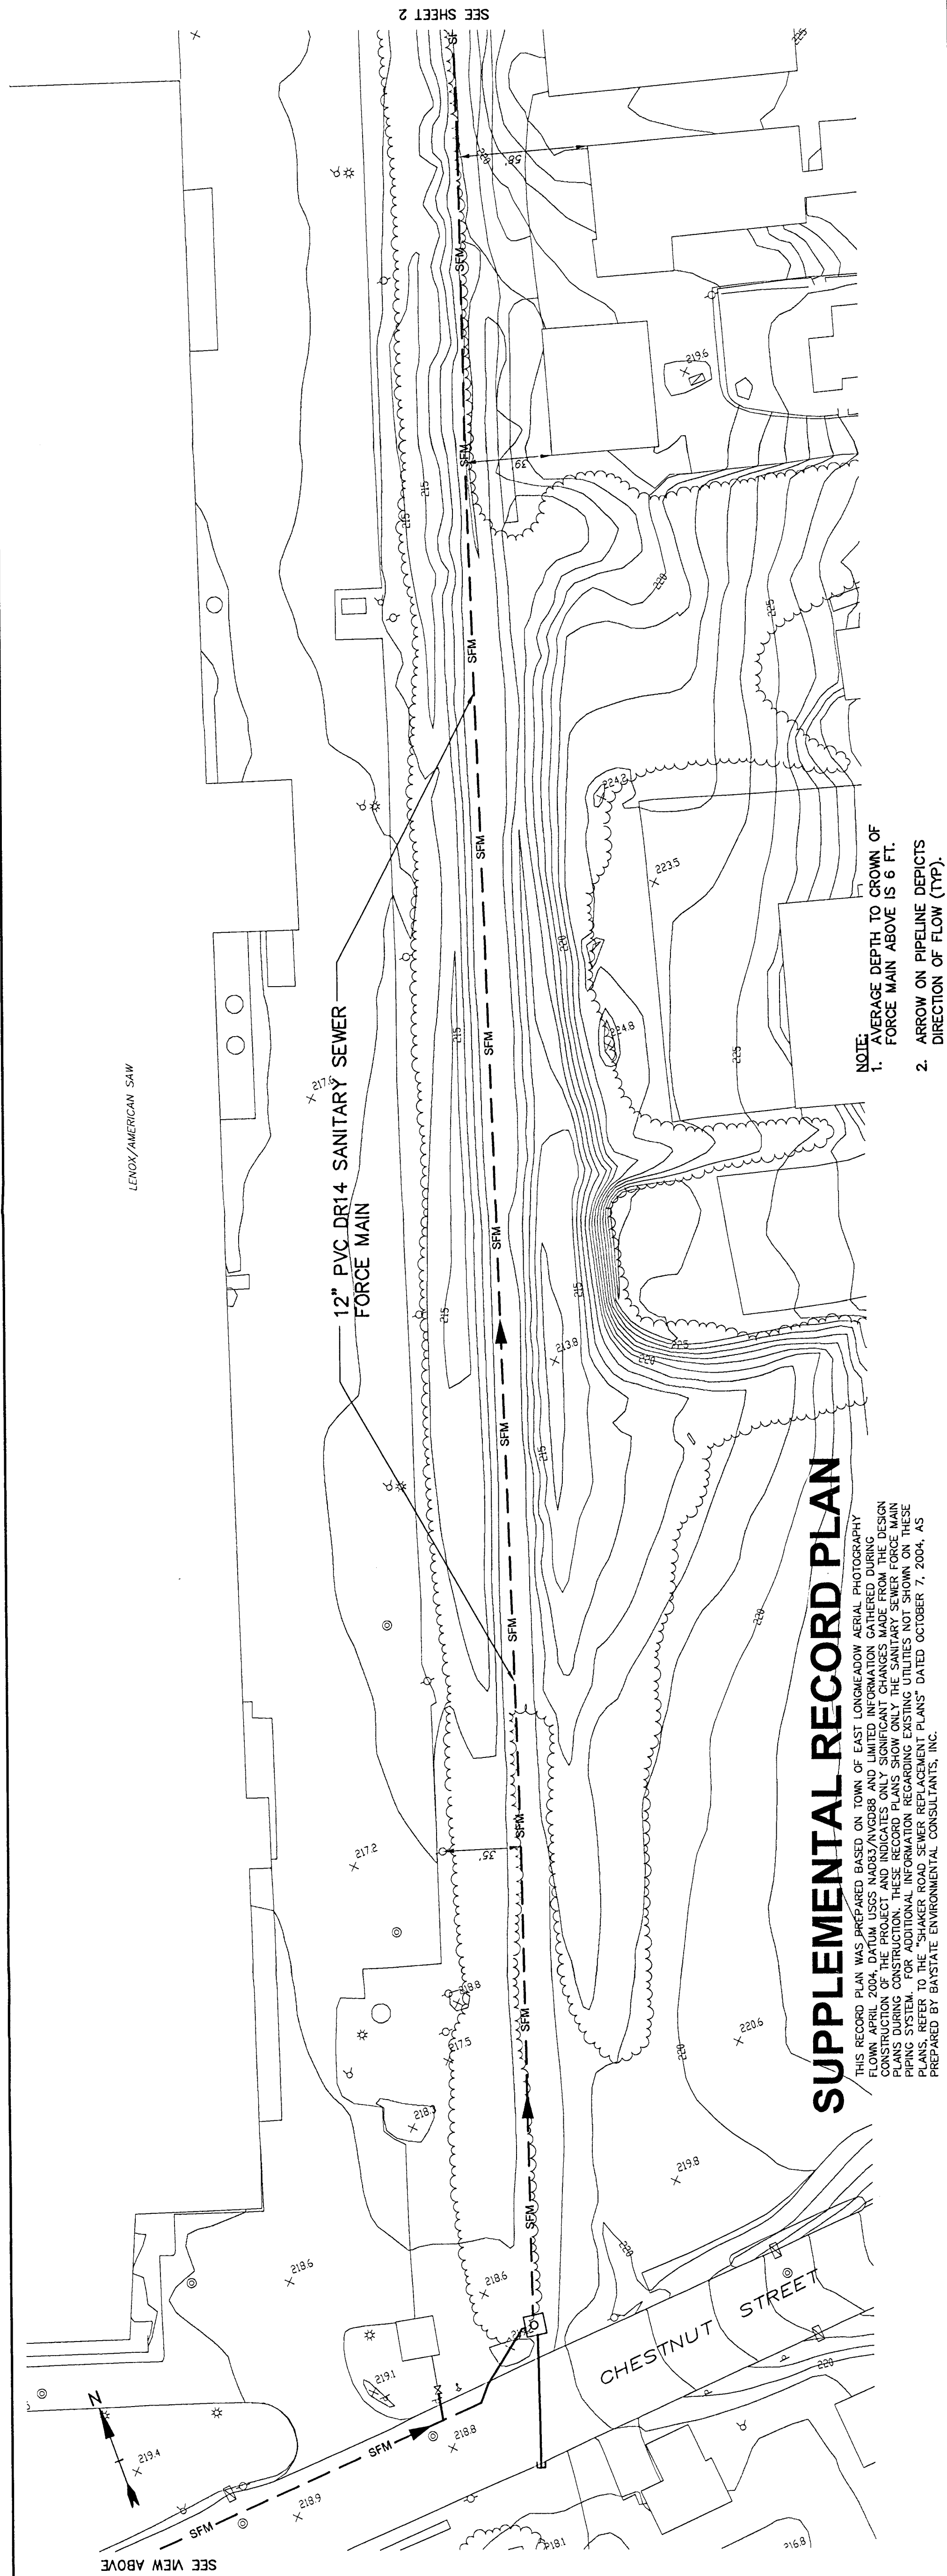[illegible]

NOTE: AVERAGE DEPTH TO CROWN OF FORCE MAIN ABOVE IS 6 FT. ARROW ON PIPELINE DEPICTS DIRECTION OF FLOW (TYP).

SUPPLEMENTAL RECORD PLAN

THIS RECORD PLAN WAS PREPARED BASED ON TOWN OF LONGMEADOW AERIAL PHOTOGRAPHY DATED APRIL 2004, DATUM USGS NAD83/VG088 AND LIMITED INFORMATION GATHERED DURING CONSTRUCTION OF THE PROJECT AND INDICATES ONLY SIGNIFICANT CHANGES MADE TO THE RECORD PLANS DURING CONSTRUCTION. THESE RECORD PLANS SHOW ONLY THE SANITATION SEWER MAIN AND PIPING SYSTEM. ONE ADDITIONAL ROAD SEWER REPLACEMENT PLANS, DATED OCTOBER 7, 2004, AS PREPARED BY BAYSTATE ENVIRONMENTAL CONSULTANTS, INC.