


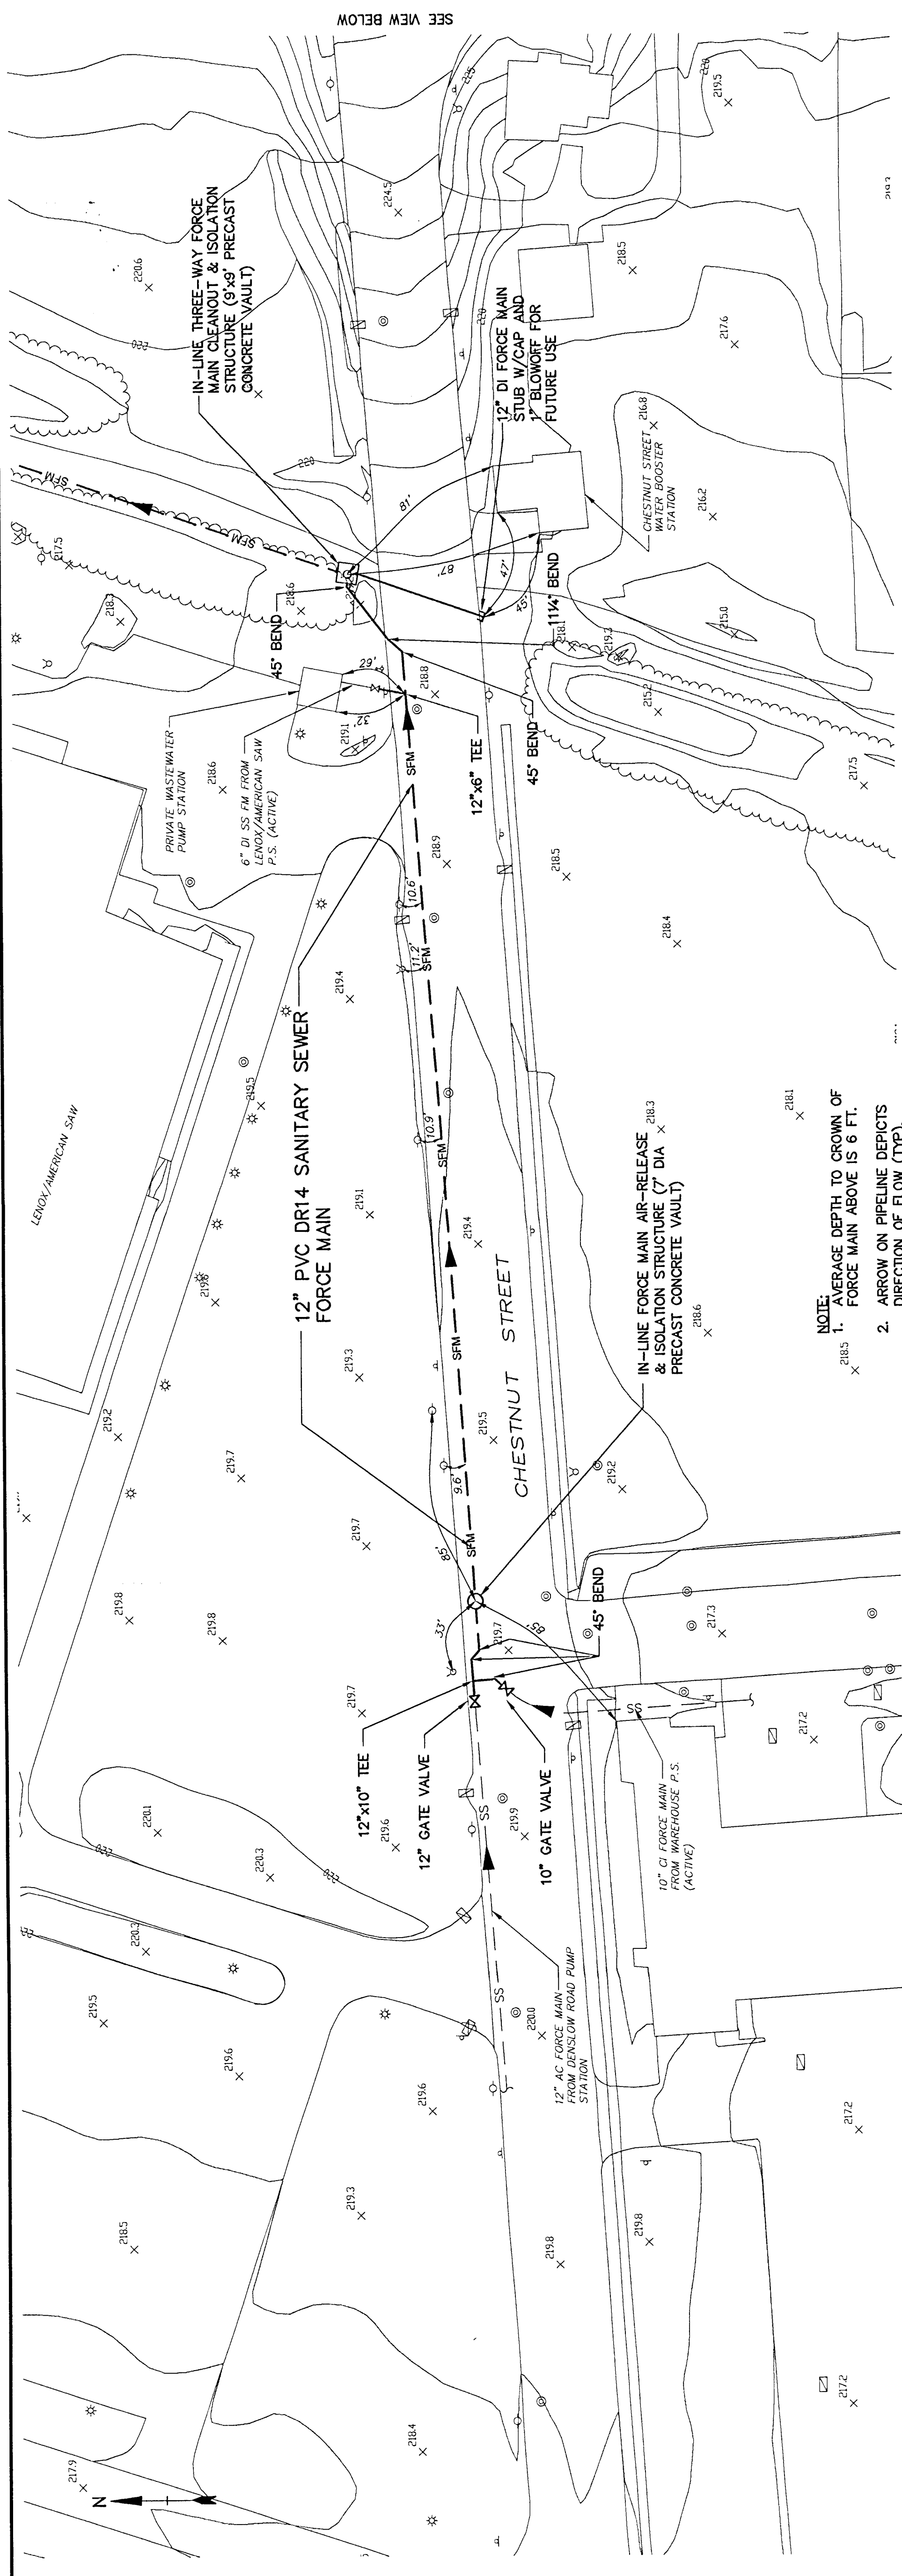


NOTE:
1. AVERAGE DEPTH TO CROWN OF
FORCE MAIN ABOVE IS 6 FT.
2. ARROW ON PIPELINE DEPICTS
DIRECTION OF FLOW (TYP).

**Board of
Public Works**

Shaker Road
Sewer
Replacement
Contract No. 1

East Longmeadow,
Massachusetts

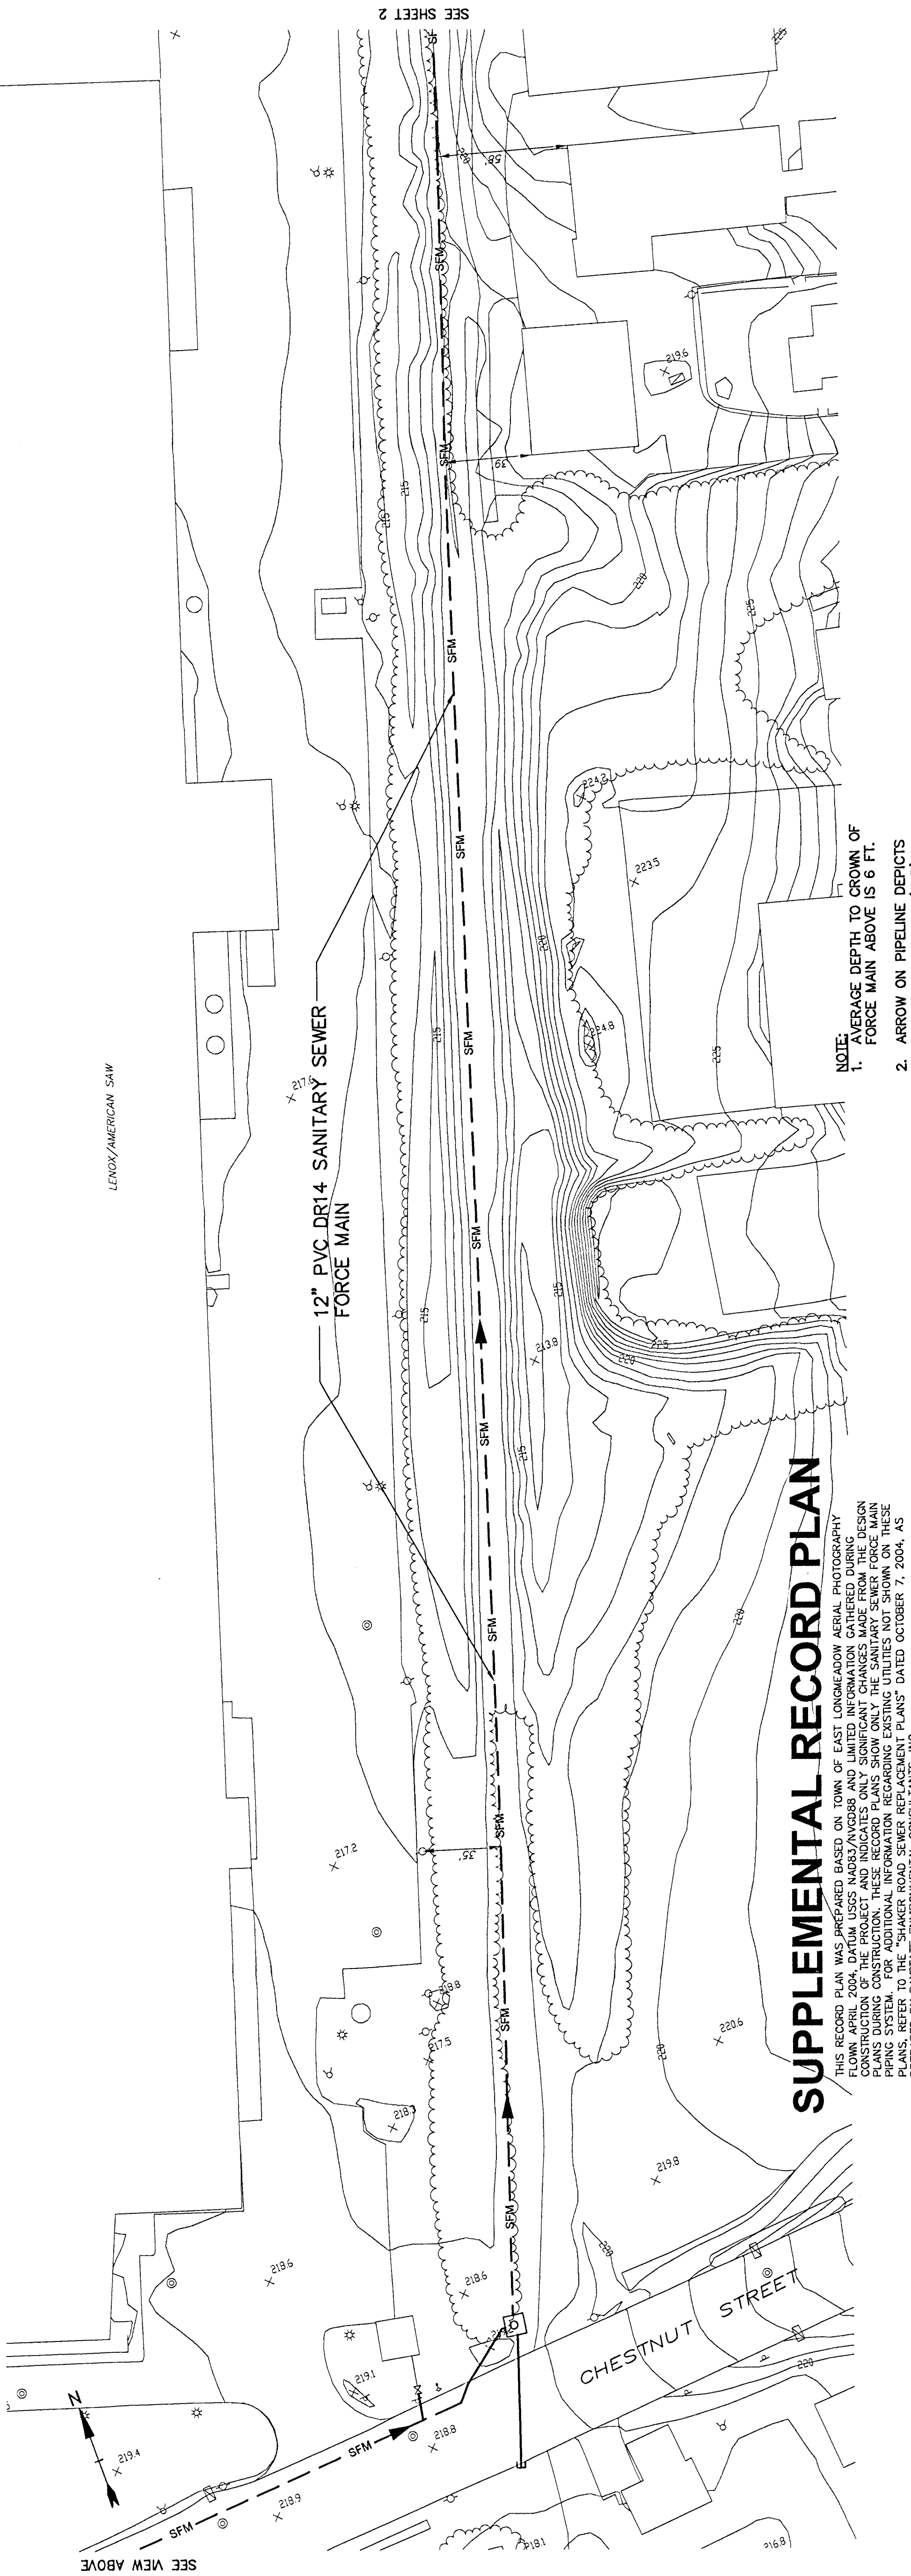[illegible]

NOTE:

1. AVERAGE DEPTH TO CROWN OF FORCE MAIN ABOVE IS 6 FT.
2. ARROW ON PIPELINE DEPICTS DIRECTION OF FLOW (TYP).

SUPPLEMENTAL RECORD PLAN

THIS RECORD PLAN WAS PREPARED BASED ON TOWN OF EAST LONGMEADOW AERIAL PHOTOGRAPHY DATED APRIL 2004, DATUM US NAD83/AVG088 AND LIMITED INFORMATION GATHERED DURING CONSTRUCTION OF THE PROJECT AND INDICATES ONLY SIGNIFICANT CHANGES MADE FROM THE DESIGN PLANS DURING CONSTRUCTION. THESE RECORD PLANS SHOW ONLY THE SANITARY SEWER FORCE MAIN PIPING SYSTEM. FOR ADDITIONAL INFORMATION REGARDING EXISTING UTILITIES NOT SHOWN ON THESE PLANS, REFER TO THE "SHAKER ROAD SEWER REPLACEMENT PLANS" DATED OCTOBER 7, 2004, AS PREPARED BY BAYSTATE ENVIRONMENTAL CONSULTANTS, INC.