
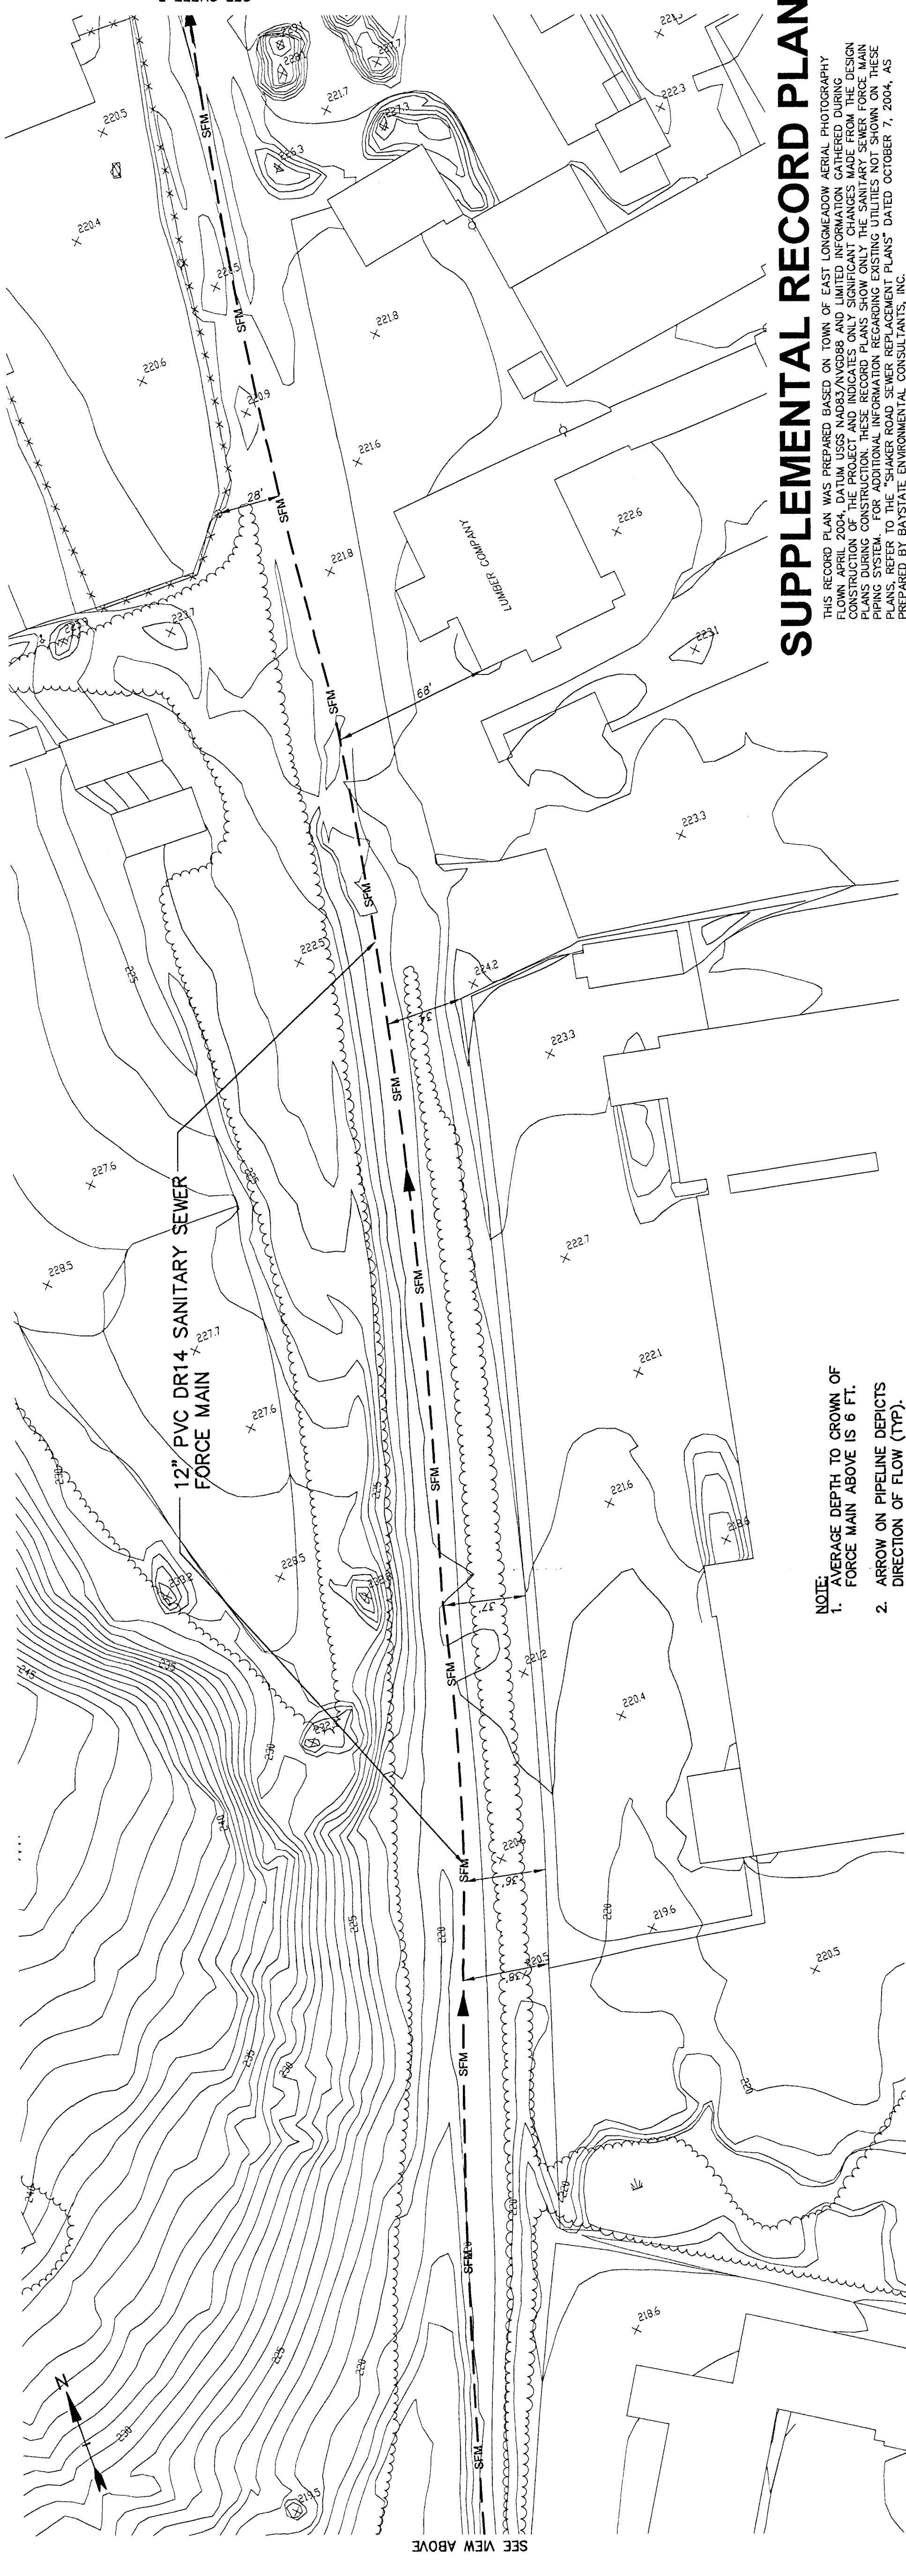


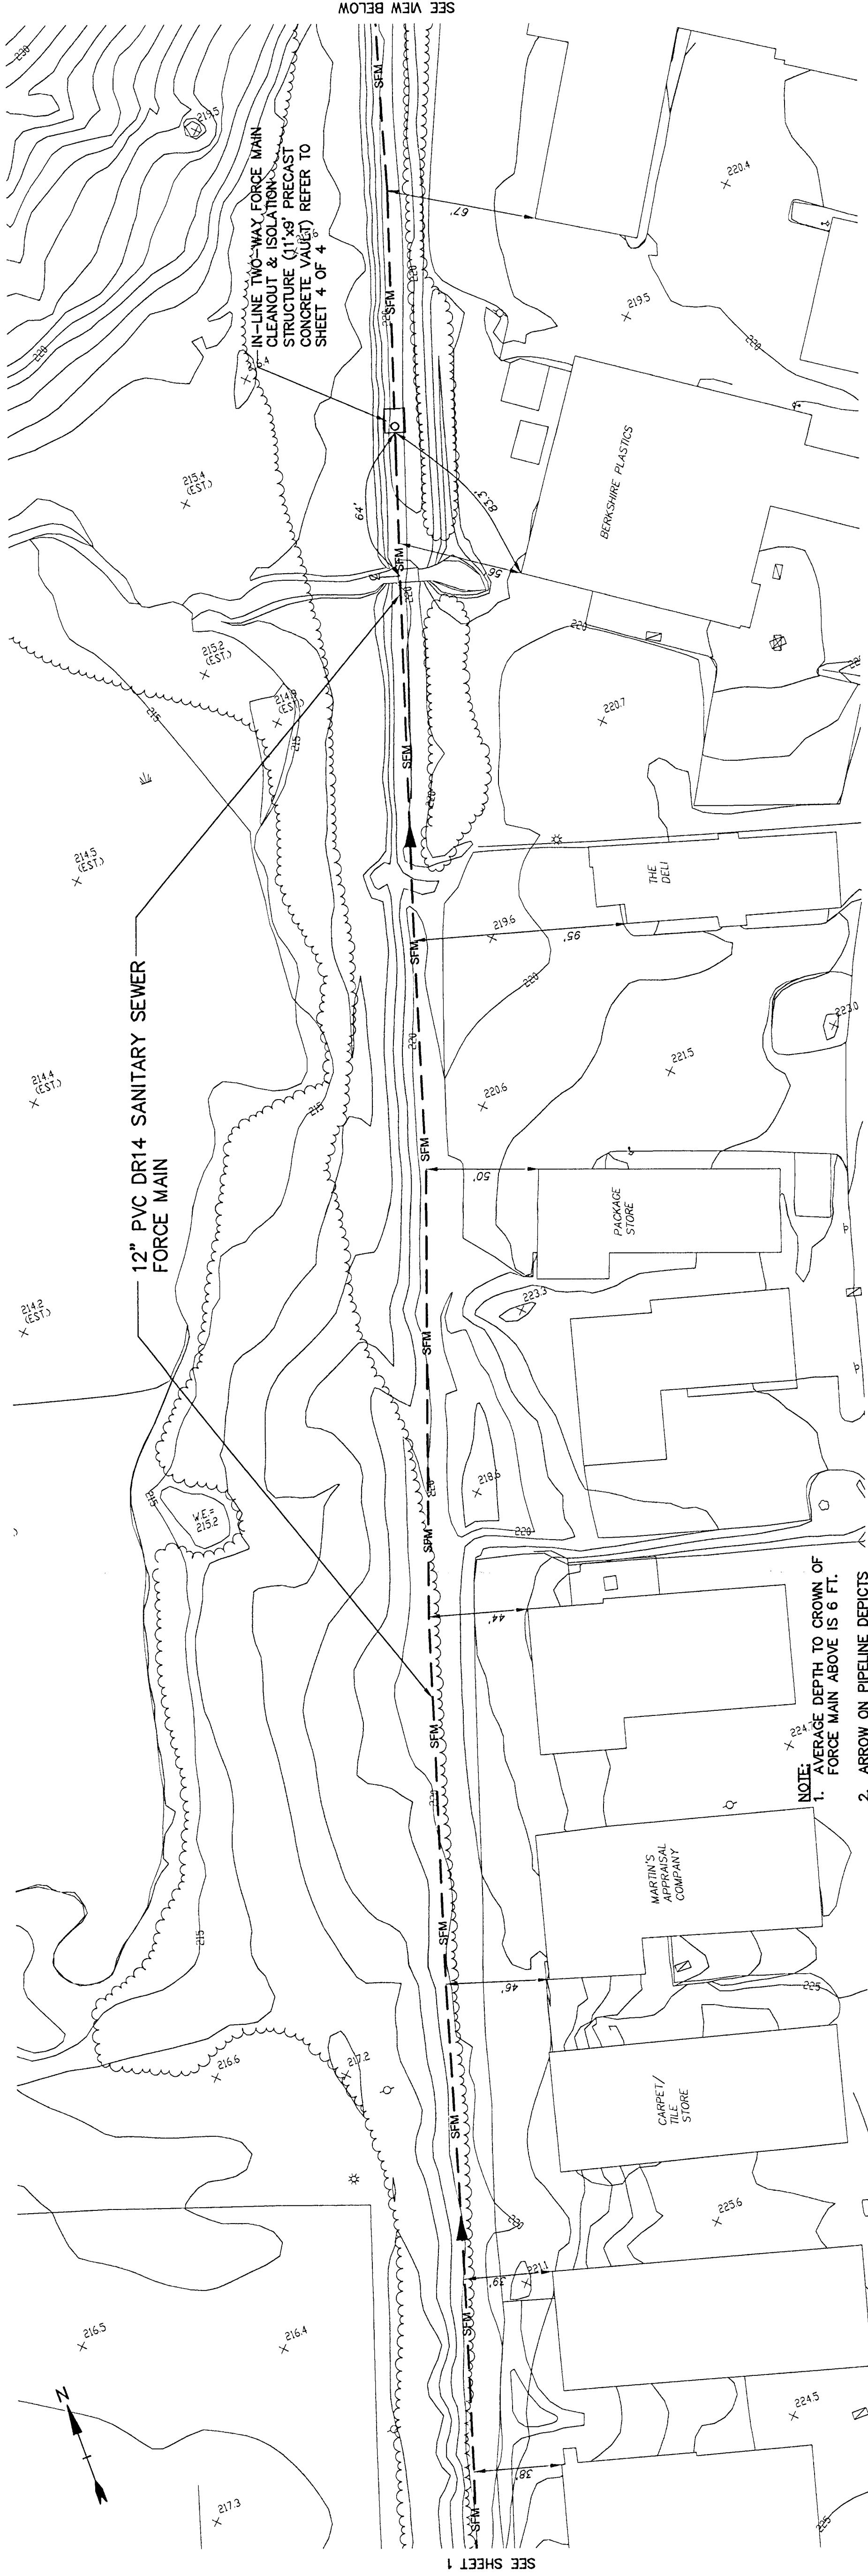

Board of
Public Works

Shaker Road
Sewer
Replacement
Contract No. 1

East Longmeadow,
Massachusetts

[illegible]