



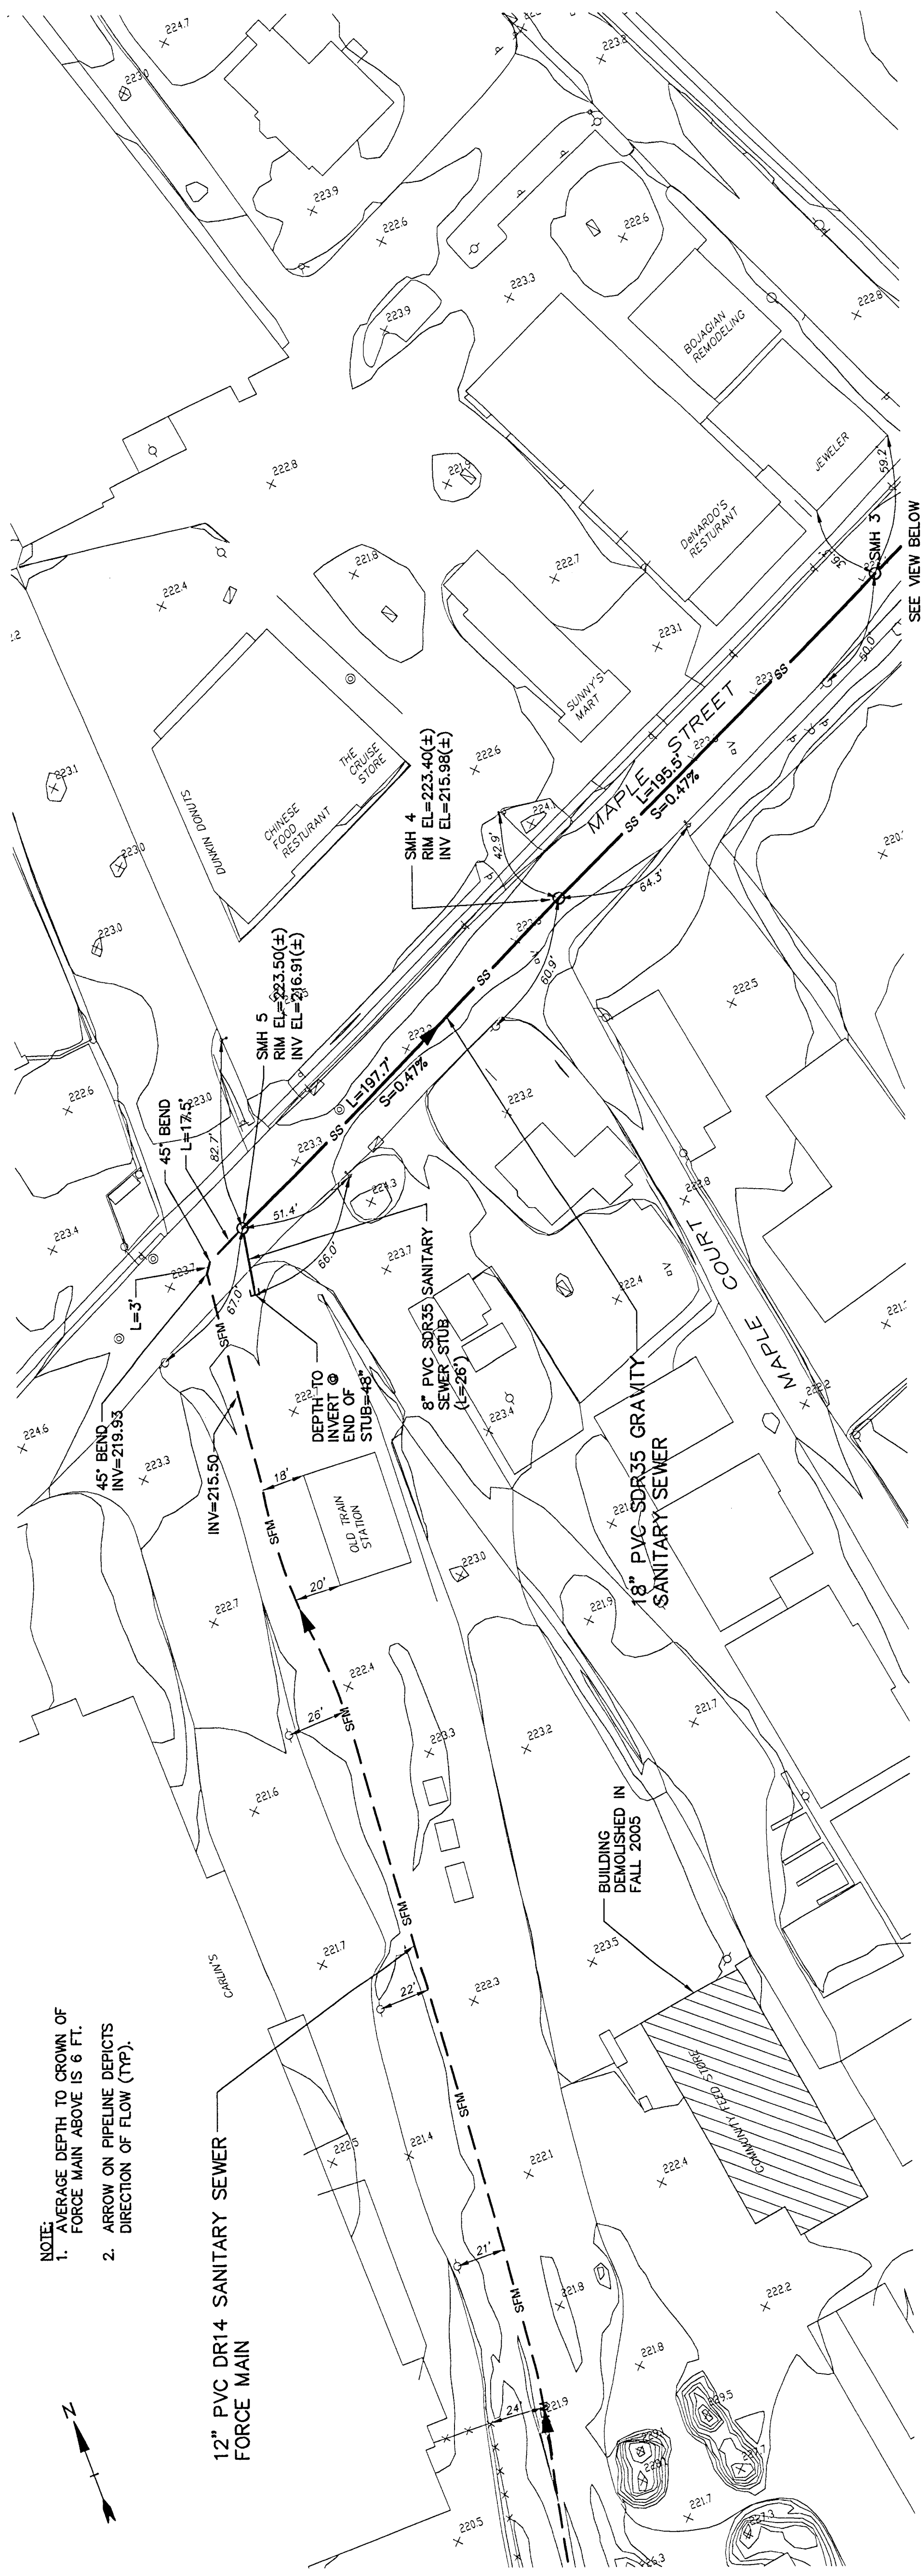

NOTE:

1. AVERAGE DEPTH TO CROWN OF FORCE MAIN ABOVE IS 6 FT.
2. ARROW ON PIPELINE DEPICTS DIRECTION OF FLOW (TYP).
3. TOWN HALL / LIBRARY PARKING HAS BEEN RECONSTRUCTED SINCE THE AERIAL SURVEY USED HEREIN WAS PERFORMED.

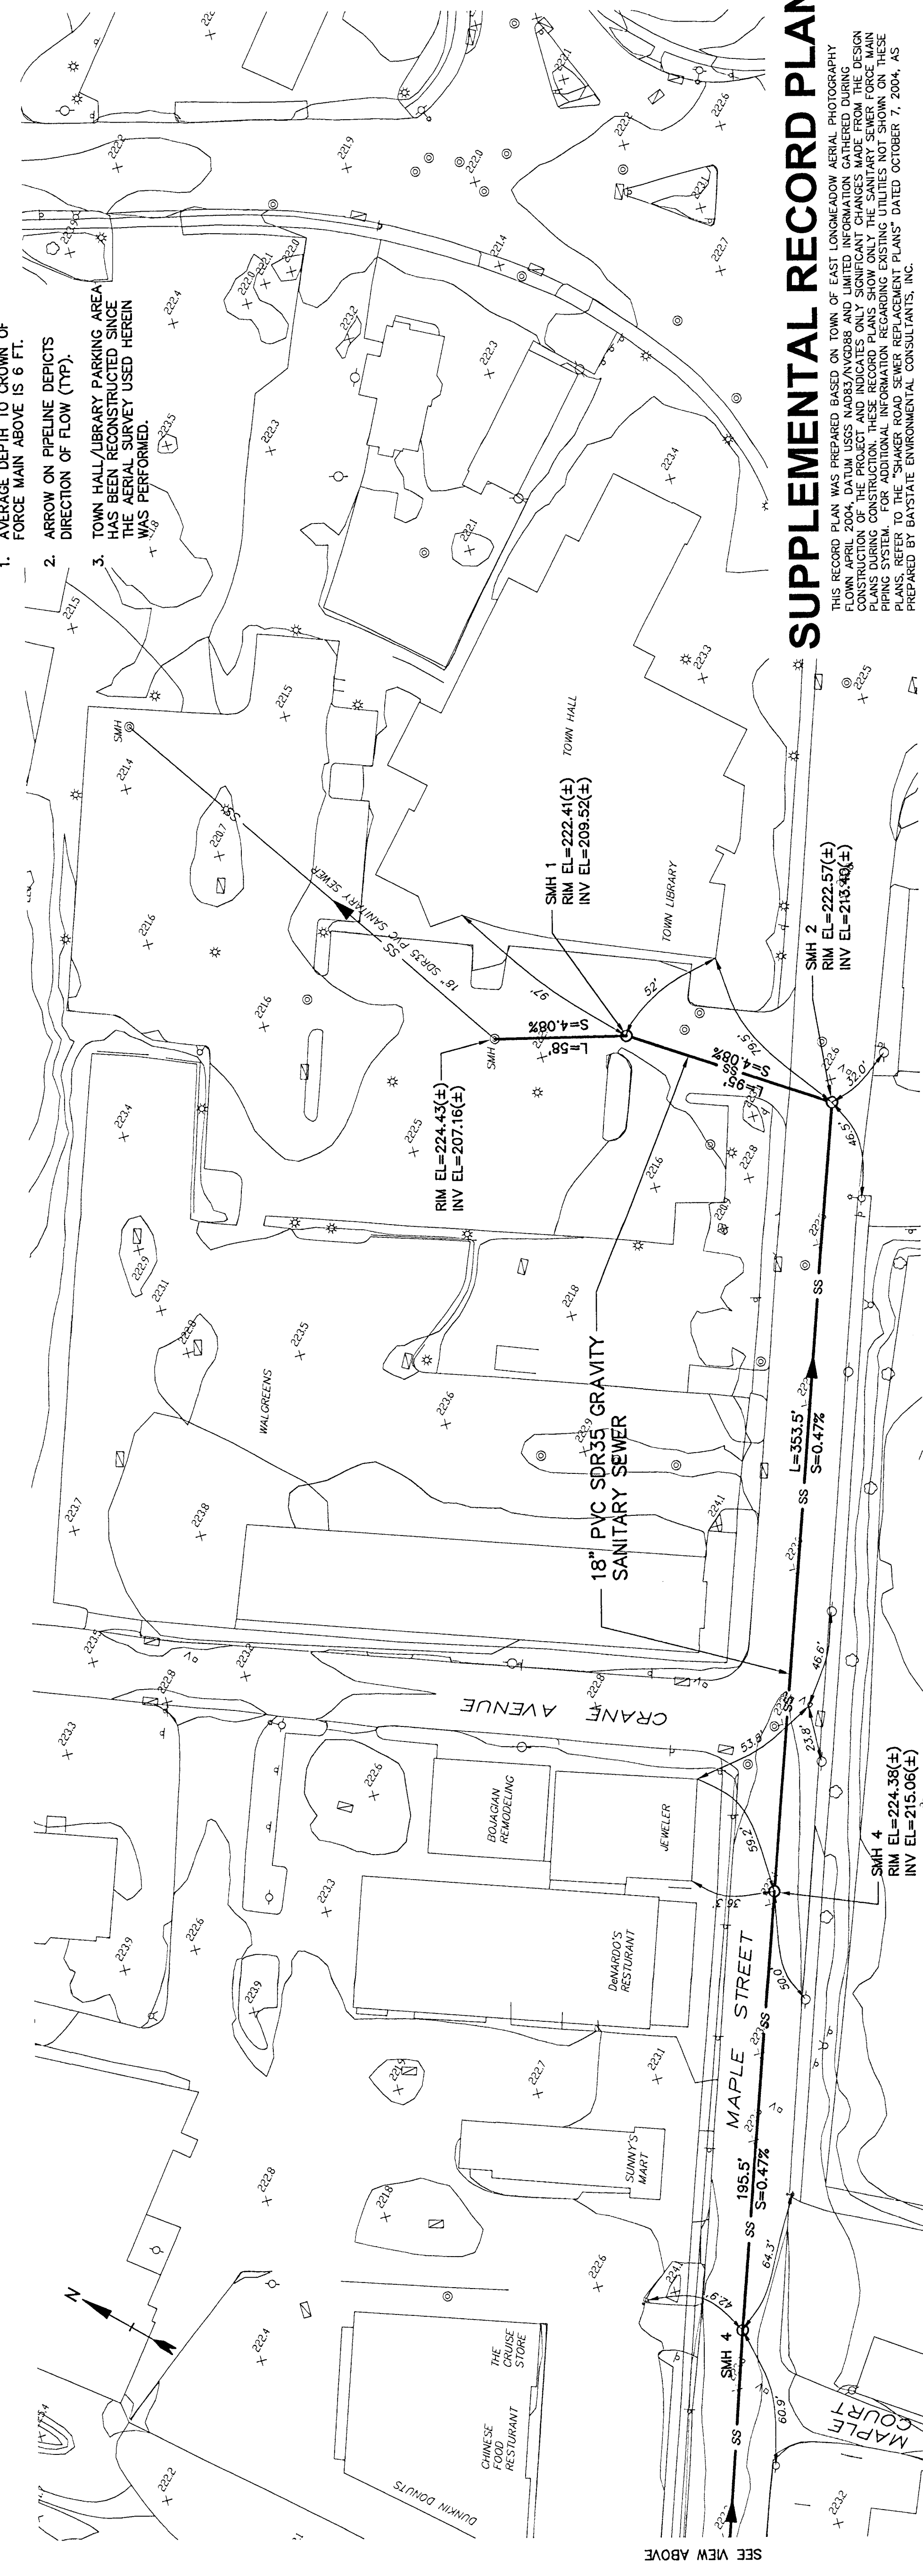

SUPPLEMENTAL RECORD PLAN

THIS RECORD PLAN WAS PREPARED BASED ON TOWN OF EAST LONGMEADOW AERIAL PHOTOGRAPHY DATED APRIL 2004. DATUM USCS NAD83/VNGBR AND LIMITED INFORMATION GATHERED DURING CONSTRUCTION OF THE PROJECT AND INDICATES ONLY SIGNIFICANT CHANGES MADE FROM THE DESIGN PLANS DURING CONSTRUCTION. THESE RECORD PLANS SHOW ONLY THE SANITARY SEWER FORCE MAIN PIPING SYSTEM. FOR ADDITIONAL INFORMATION REGARDING UTILITIES NOT SHOWN ON THESE PLANS, REFERENCE TO THE RECORD PLANS FOR WATER SUPPLY AND GAS SERVICE ARE REQUIRED. THESE PLANS WERE DESIGNED BY CONSULTANTS INC. IN JANUARY 2004, AS PART OF THE ENVIRONMENTAL CONSULTANTS' INC.

1	106	Supplemental Record Plans
Mark	Date	Description
		PROJECT NO. E-9507
		FILE SHAKER, ROAD P&P dwg/SHT3
		DRAWN BY: CRY
		CHECKED: DRP
		APPROVED BY: RP
SANITARY SEWER FORCE MAIN & GRAVITY SEWER EXTENSION		
SCALE:		1"=40'
SHEET 3 OF 4		

**Board of
Public Works**

**Shaker Road
Sewer
Replacement
Contract No. 1**

East Longmeadow,
Massachusetts