

BOARD OF PUBLIC WORKS WATCHAUG FORCE MAIN REPLACEMENT CONTRACT 1 EAST LONGMEADOW, MASSACHUSETTS AUGUST 2005





PROJECT LOCUS
SCALE: 1" = 2000'

BOARD OF PUBLIC WORKS

MICHAEL A. PERKINS, CHAIRMAN
JOHN F. MAYBURY
DANIEL S. BURACK

TOWN ENGINEER / DPW SUPT.

DAVID J. GROMASKI, P.E.

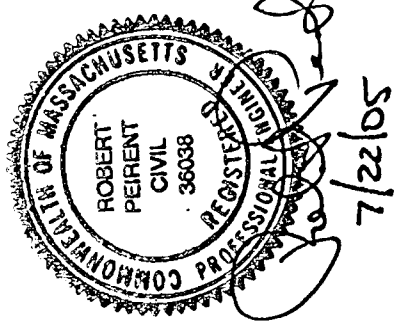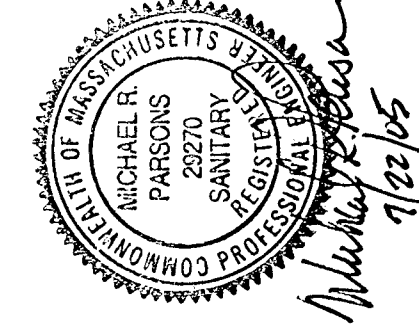

Tighe&Bond
Consulting Engineers

COMPLETE SET 11 SHEETS

RECORD PLAN

THIS RECORD PLAN WAS PREPARED BASED ON LIMITED INFORMATION GATHERED DURING CONSTRUCTION OF THE PROJECT AND INDICATES ONLY SIGNIFICANT CHANGES MADE FROM THE DESIGN PLANS DURING CONSTRUCTION.