

7/22/05



07/22/05

East
Longmeadow
Board of Public
Works

Watchaug Force
Main Replacement
Contract No. 1


East Longmeadow,
Massachusetts

2	1006	Record Plan	
1	08/10/05	Revised for Bidding	
0	07/25/05	Issued for Permit Approval	
Mark	Date	Description	
PROJECT NO.	E-0507		
FILE\CONTRACT-1\KEY PLAN			
DRAWN BY:	ARG		
CHECKED:	DRP		
APPROVED BY:	RP, MRP		

KEY PLAN

SCALE: 1"=300'

SHEET 3

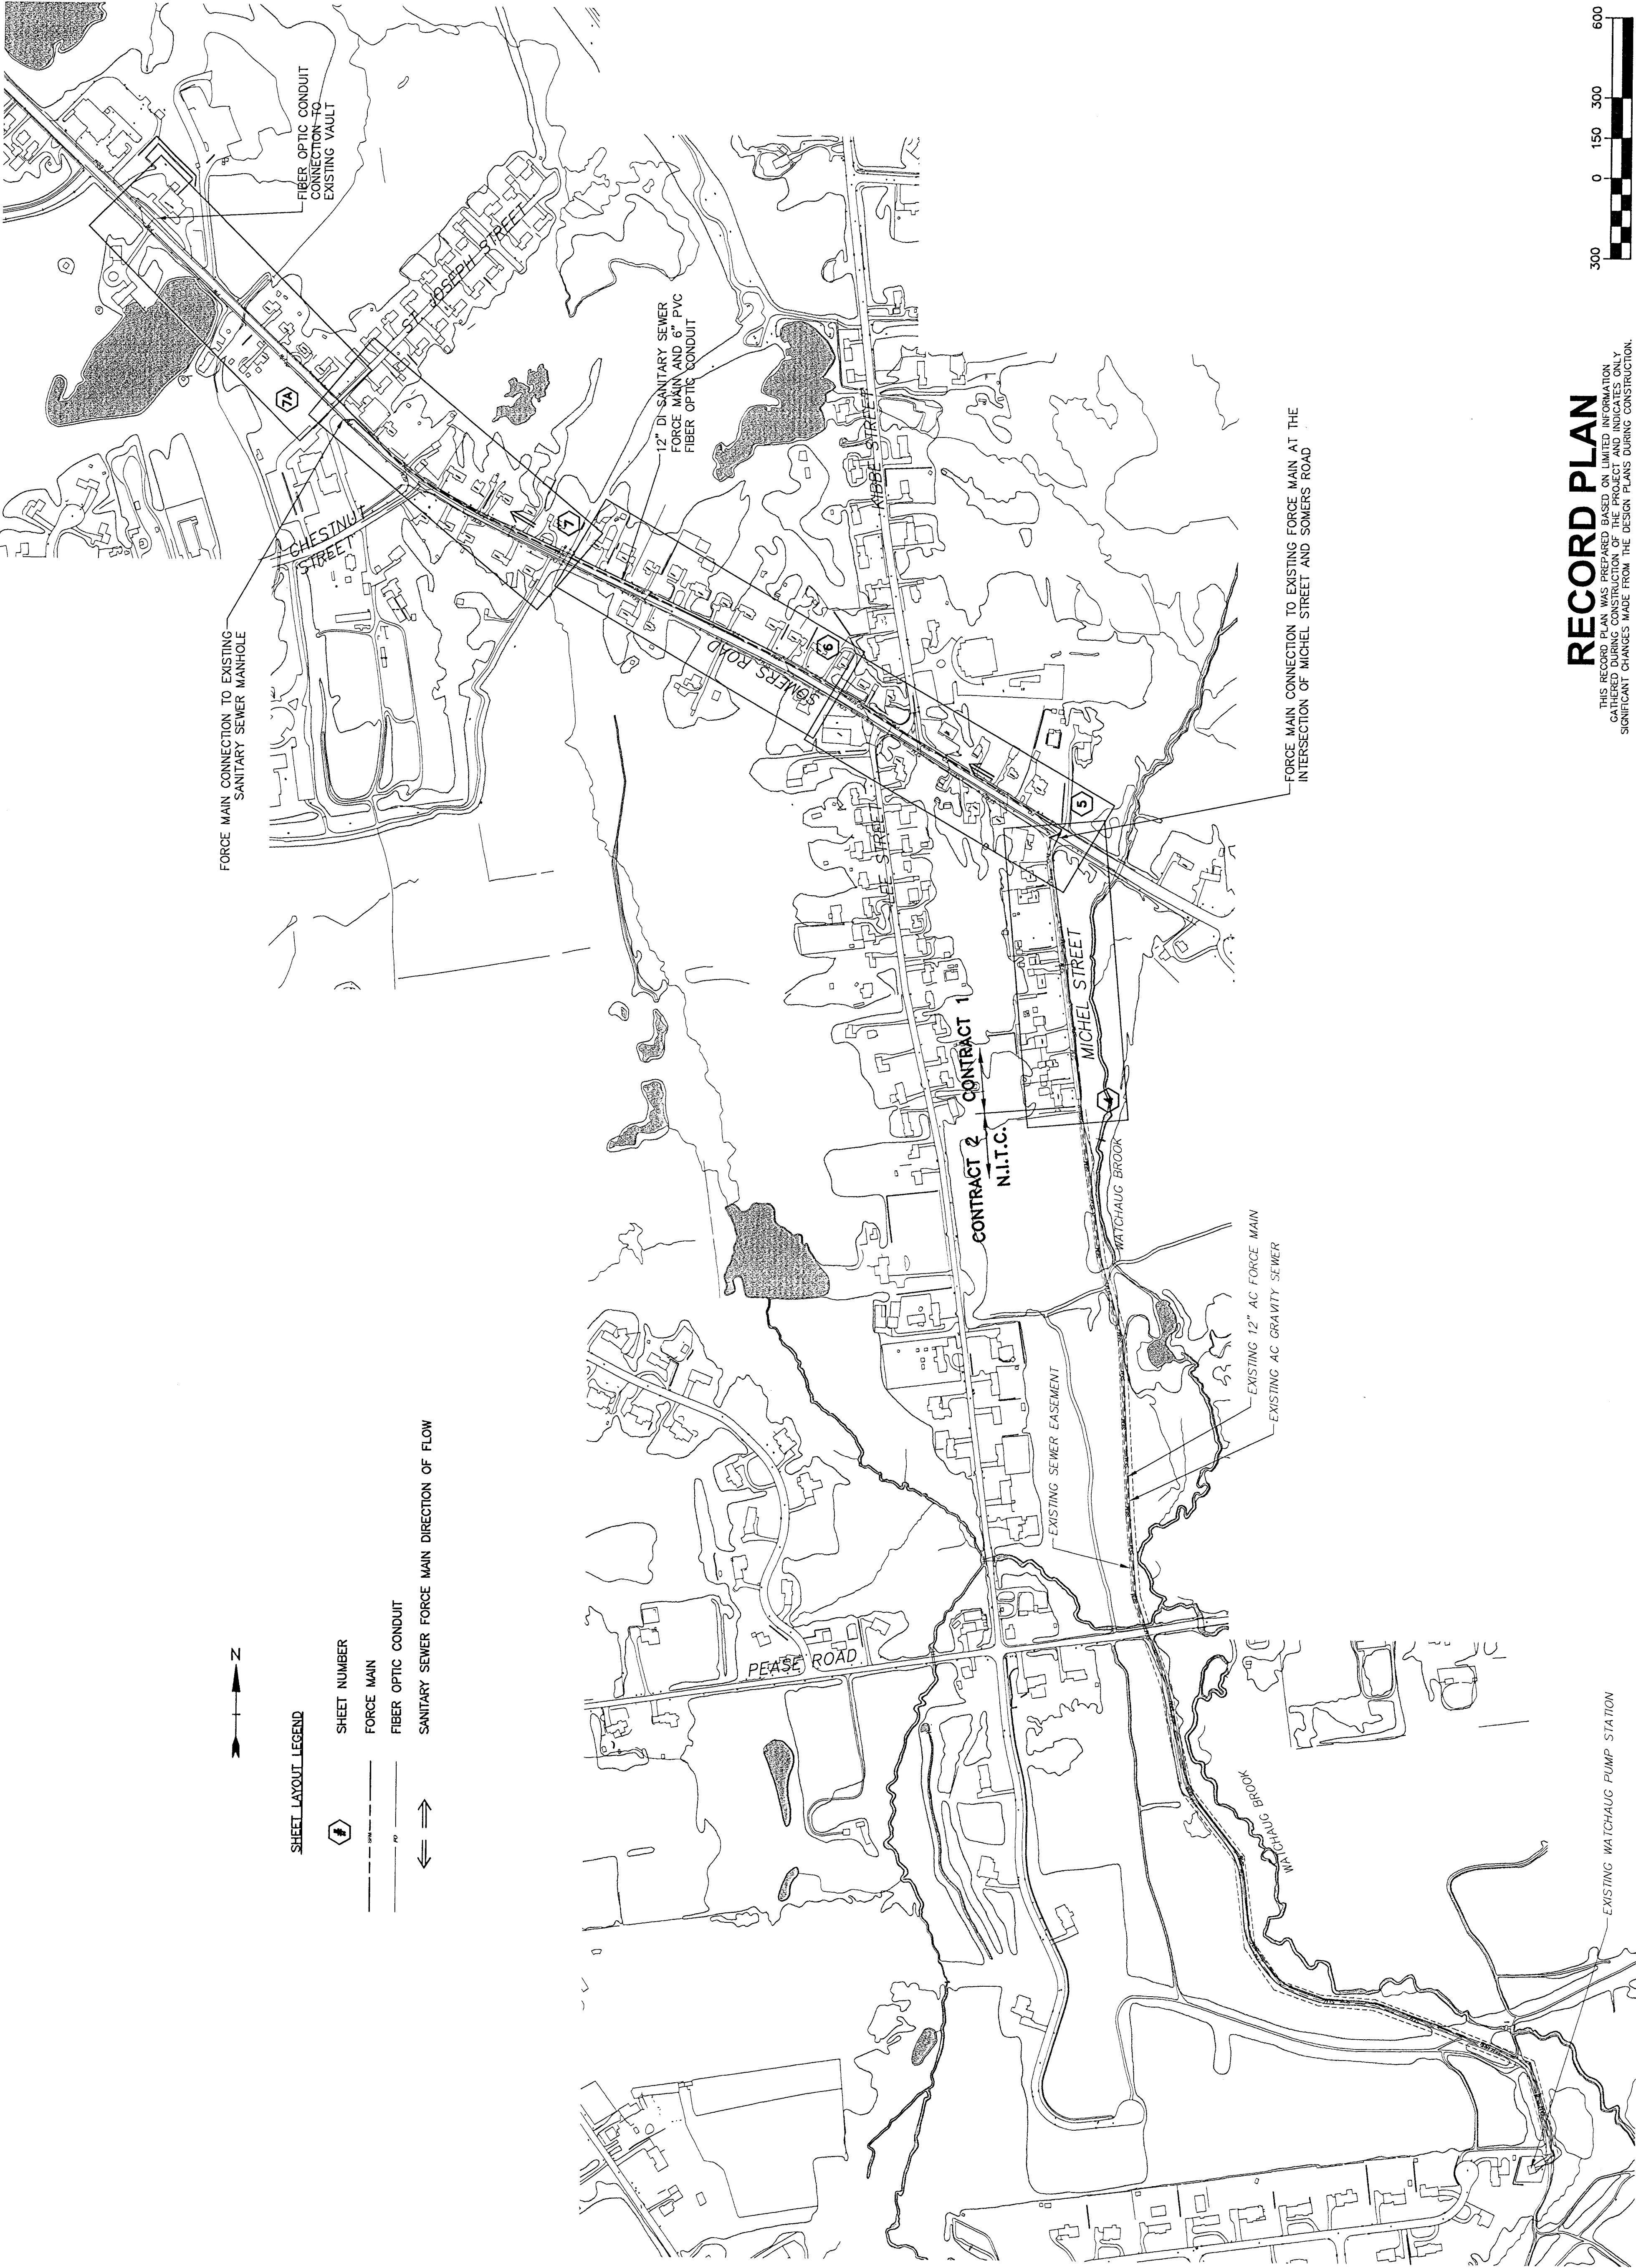

SHEET LAYOUT LEGEND

- SHEET NUMBER
FORCE MAIN
FIBER OPTIC CONDUIT
SANITARY SEWER FORCE MAIN DIRECTION OF FLOW

RECORD PLAN

THIS RECORD PLAN WAS PREPARED BASED ON LIMITED INFORMATION GATHERED DURING CONSTRUCTION OF THE PROJECT. ANY UNUSUALLY SIGNIFICANT CHANGES MADE FROM THE DESIGN PLANS DURING CONSTRUCTION.

