
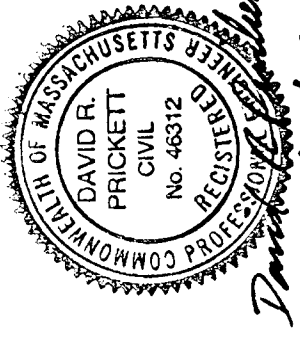
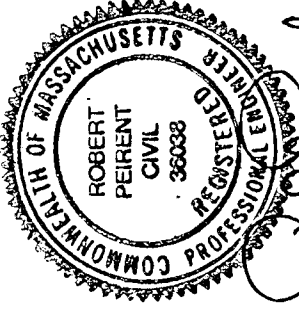


- NOTES:
1.

CONTRACTOR TO PERFORM HYDROSTATIC TEST ON EXISTING FORCE MAIN IN MICHEL STREET FROM STA 49+00 (EXISTING BURIED GATE VALVE) TO STA 59+00 PRIOR TO CONNECTION TO PROPOSED FORCE MAIN IN SOMERS ROAD. CONTRACTOR TO PROVIDE ANY AND ALL NECESSARY TEST CONNECTIONS PER SECTION 02503 FO THE SPECIFICATIONS. IF THE FORCE MAIN DOES NOT PASS THE HYDROSTATIC TEST, THE CONTRACTOR WILL BE REQUIRED TO REPAIR ANY DEFICIENCIES ON A TIME AND EXPENSE BASIS TO BE NEGOTIATED WITH OWNER.
2.

THE EXISTING 12" AC FORCE MAIN (FROM STA 49+00 TO STA 90+00) IS NOT BEING ABANDONED AS PART OF THIS CONTRACT. THE EXISTING 12" FORCEMAIN WILL BE ABANDONED AT A FUTURE DATE AS PART OF CONTRACT NO. 2, AND SHALL REMAIN FULLY OPERATIONAL AT ALL TIMES.

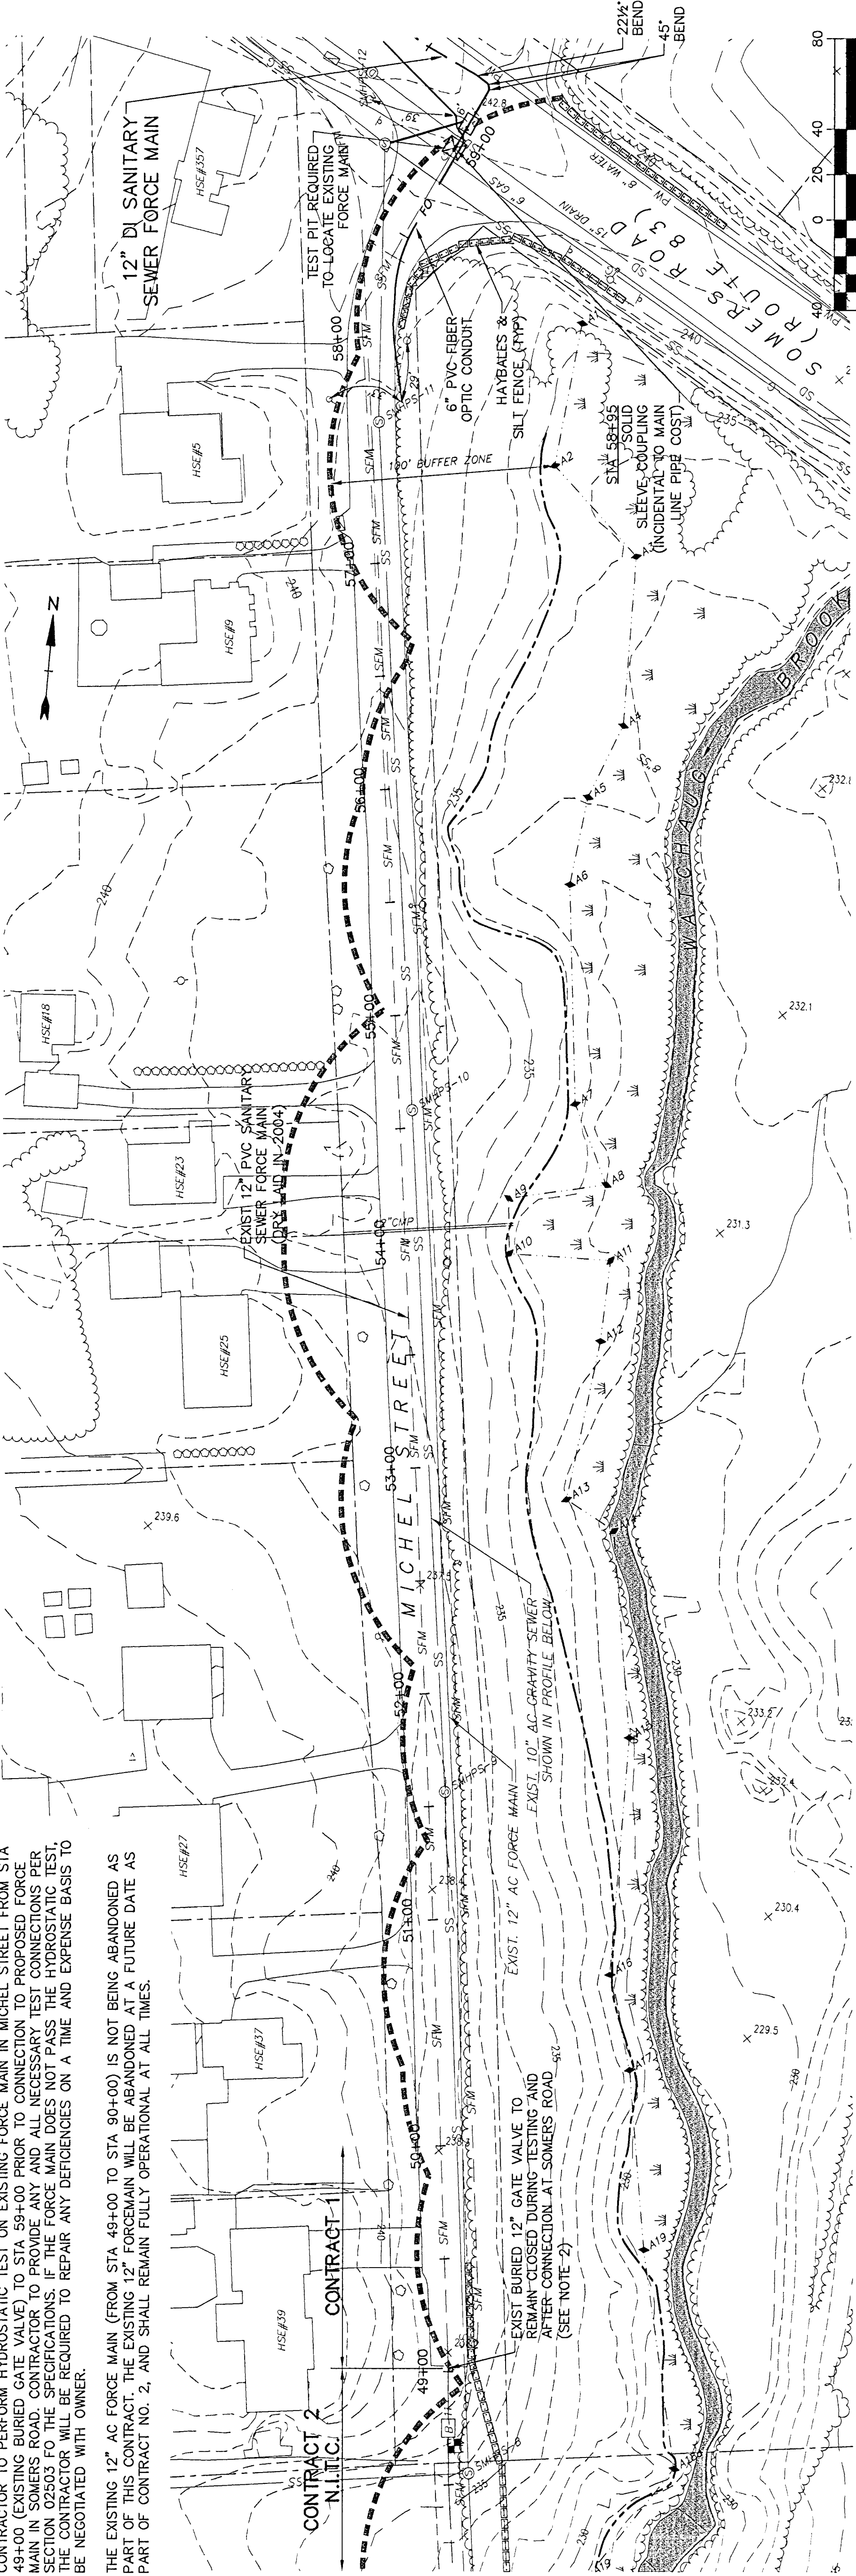

Tighe&Bond

Consulting Engineers

53 Southampton Road

Westfield, Massachusetts

(413) 562-1600

www.tighebond.com

East Longmeadow Board of Public Works

Watchaug Force Main Replacement Contract No. 1

East Longmeadow, Massachusetts

2	1/05	Record Plan
1	12/005	Revised for Bidding
0	1/12/06	Issued for Permit Approval
Mark	Date	Description
PROJECT NO.	E-0507	
FILE\CONTRACT\11 P&P dwg\Layout6		
DRAWN BY:	ARG	
CHECKED:	DRP	
APPROVED BY:	RP, MRP	
PLAN & PROFILE		
STA 48+00 TO STA 59+00		
SCALE:	1"=40'H, 1"=4'V	