
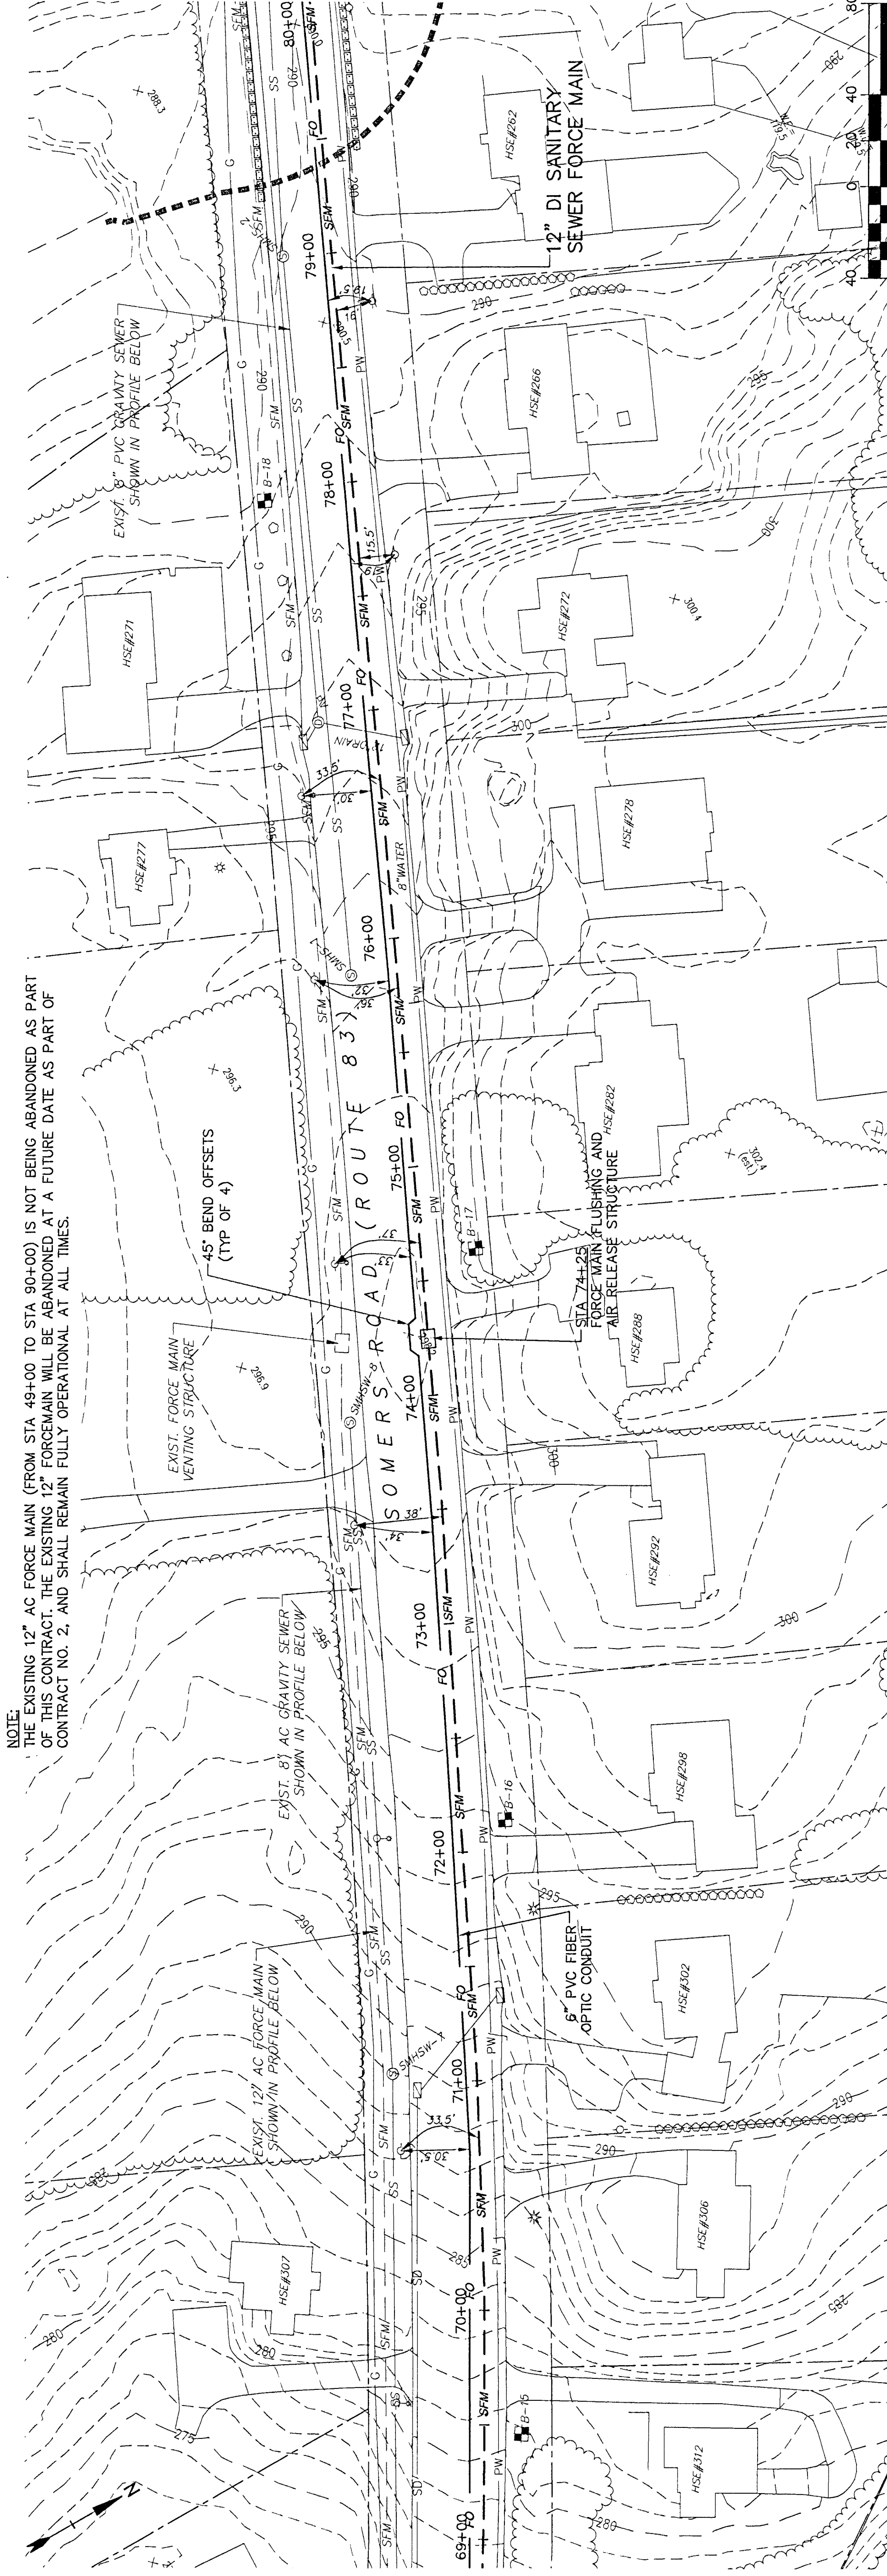
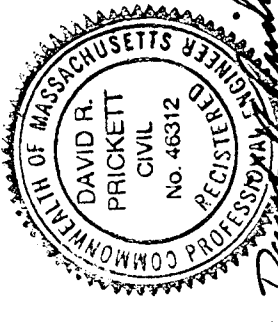


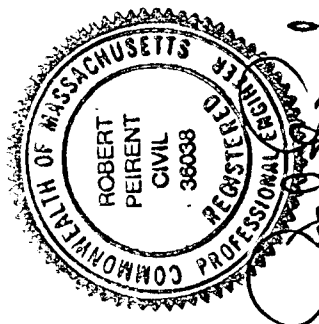


NOTE:
THE EXISTING 12" AC FORCE MAIN (FROM STA 49+00 TO STA 90+00) IS NOT BEING ABANDONED AS PART OF THIS CONTRACT. THE EXISTING 12" FORCEMAIN WILL BE ABANDONED AT A FUTURE DATE AS PART OF CONTRACT NO. 2, AND SHALL REMAIN FULLY OPERATIONAL AT ALL TIMES.

12" DI PR CL350 SANITARY SEWER FORCE MAIN

East
Longmeadow
Board of Public
Works

Watchaug Force
Main Replacement
Contract No. 1

East Longmeadow,
Massachusetts

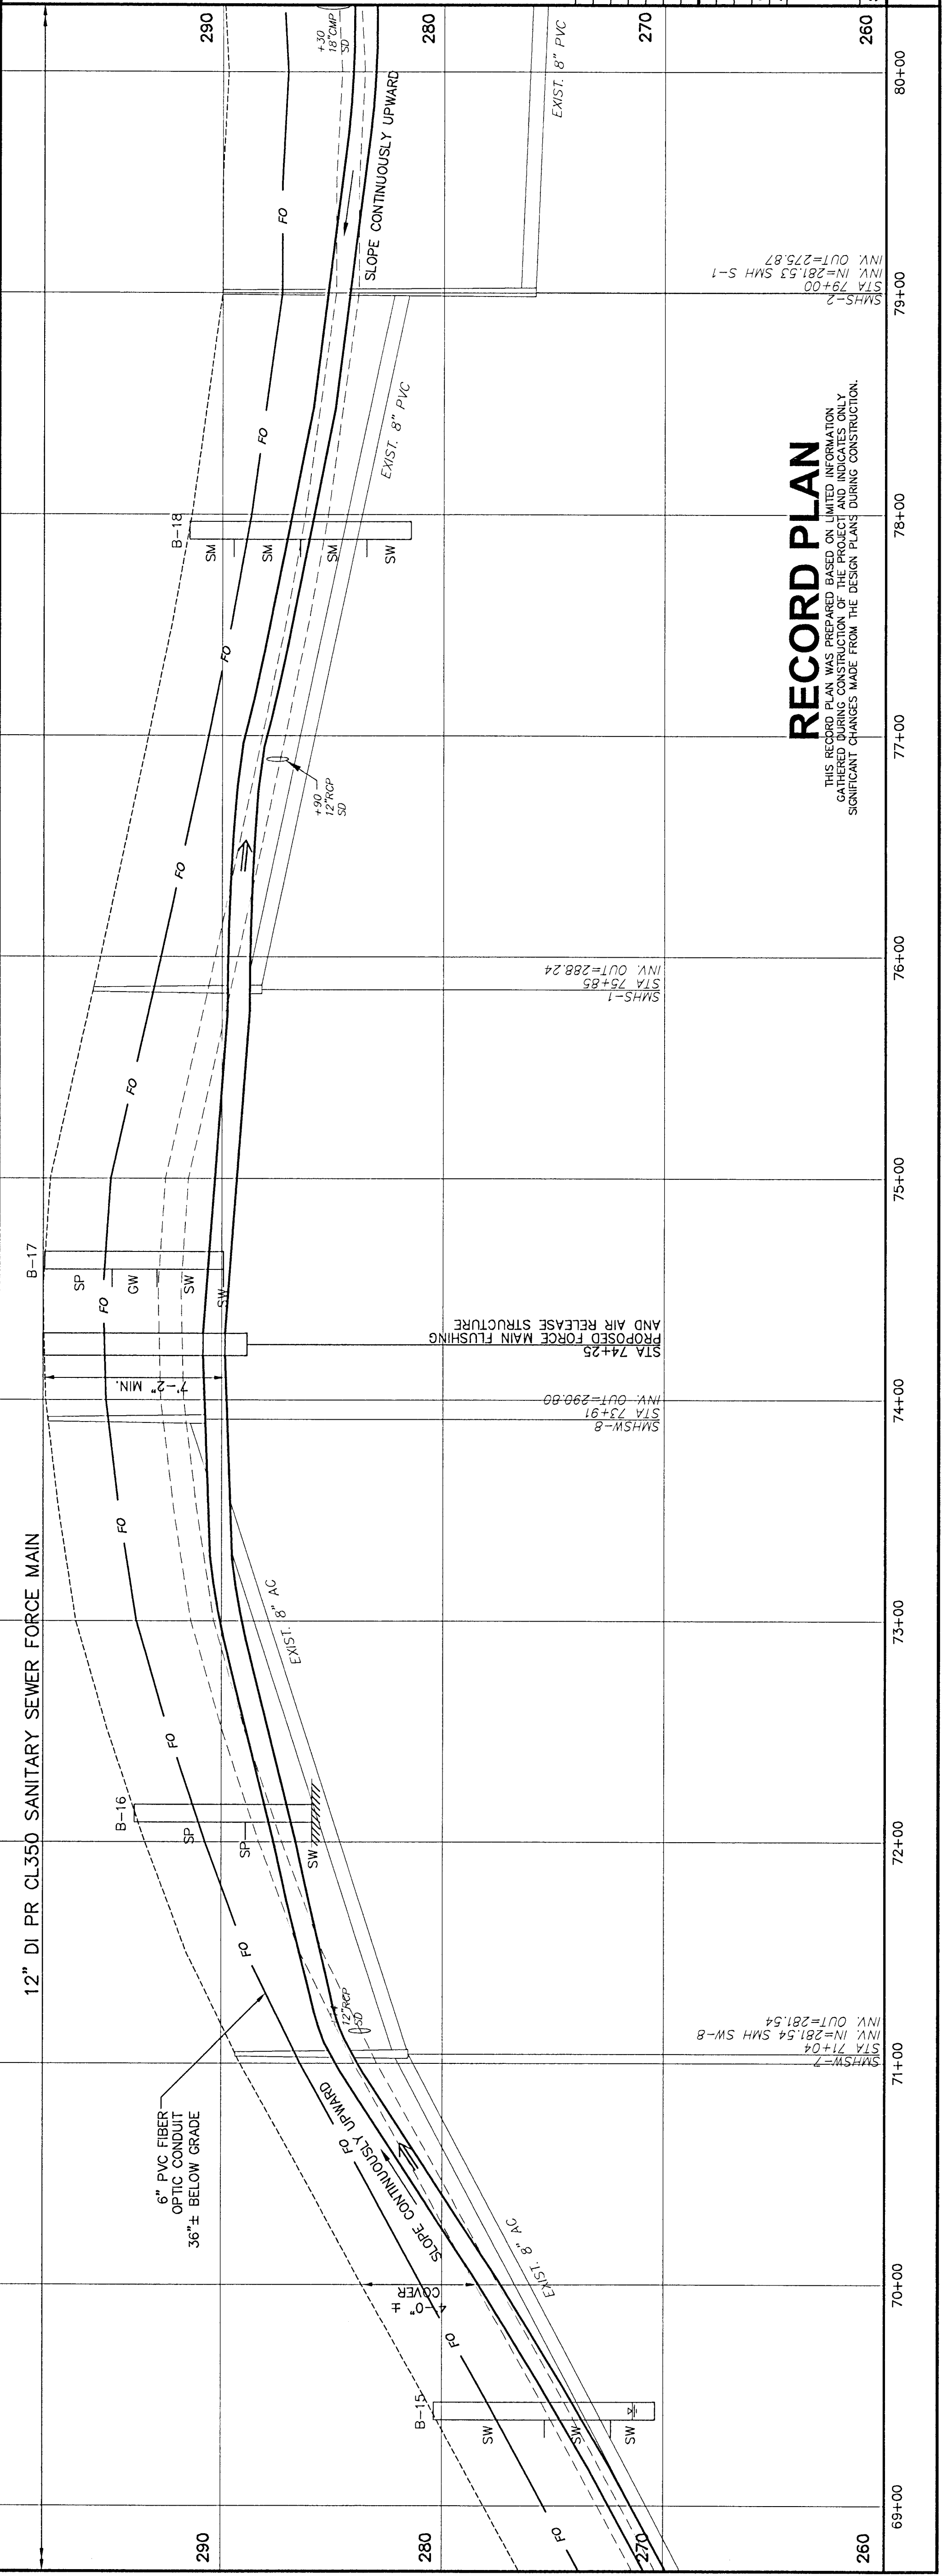

RECORD PLAN

THIS RECORD PLAN WAS PREPARED BASED ON LIMITED INFORMATION GATHERED DURING CONSTRUCTION OF THE PROJECT AND INDICATES ONLY SIGNIFICANT CHANGES MADE FROM THE DESIGN PLANS DURING CONSTRUCTION.

--	--	