
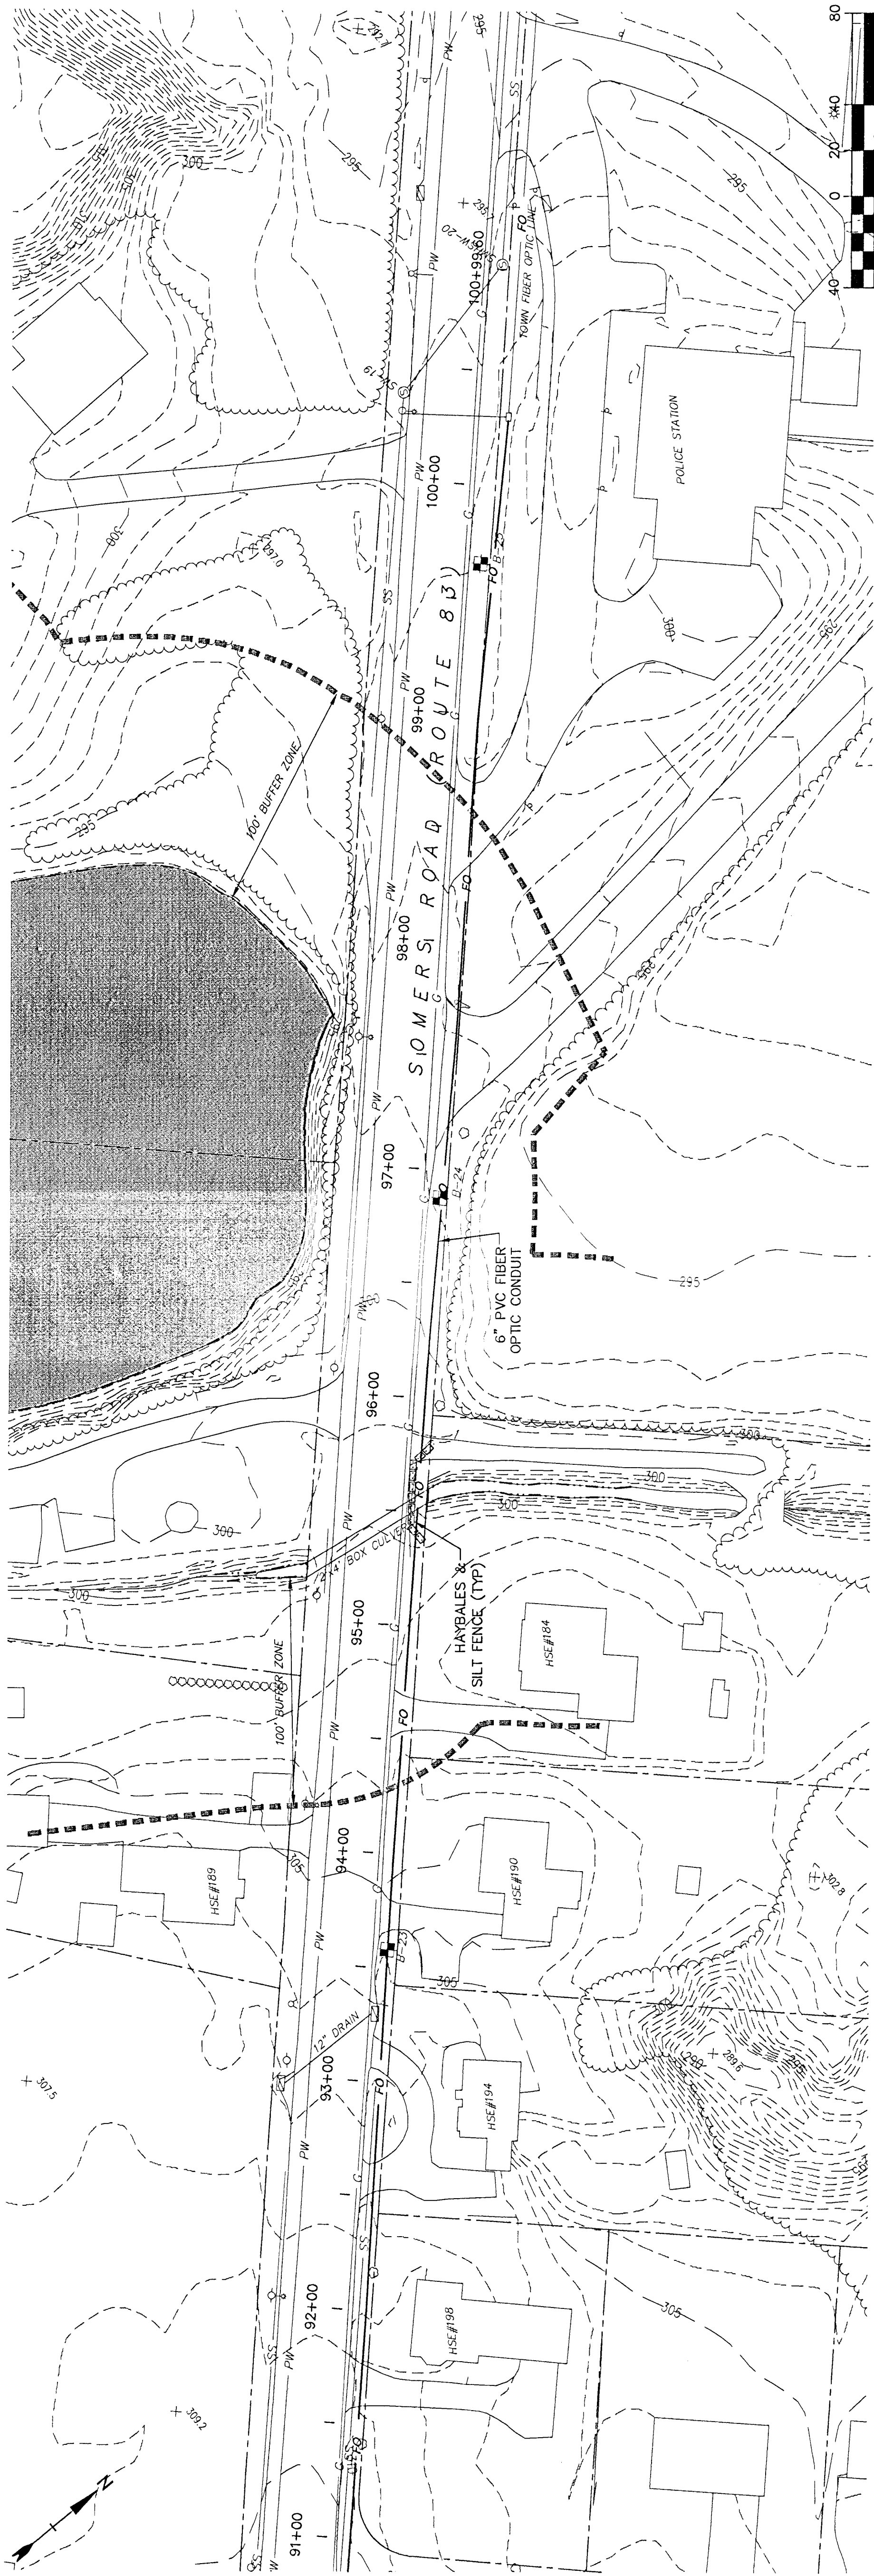
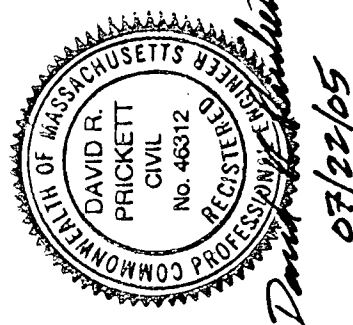


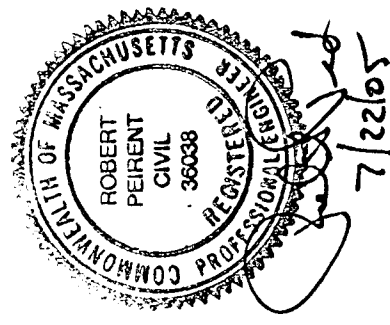

**East
Longmeadow
Board of Public
Works**

**Watchaug Force
Main Replacement
Contract No. 1**

East Longmeadow,
Massachusetts

2	1005	Record Plan
1	07/10/05	Revised for Bidding
0	07/25/05	Issued for Permit Approval
Mark	Date	Description
PROJECT NO: E-0507		
FILE: \CONTRACT-1 P&P dwg\Layout10		
DRAWN BY: ARG		
CHECKED: DRP		
APPROVED BY: RP MRP		

PLAN & PROFILE

SCALE: 1"=40'H; 1"=4'V

SHEET 7A

RECORD PLAN

THIS RECORD PLAN WAS PREPARED BASED ON LIMITED INFORMATION GATHERED DURING CONSTRUCTION OF THE PROJECT AND INDICATES ONLY SIGNIFICANT CHANGES MADE FROM THE DESIGN PLANS DURING CONSTRUCTION.

