
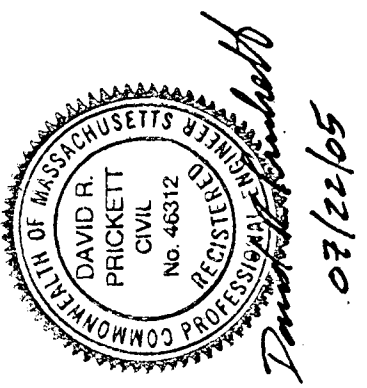


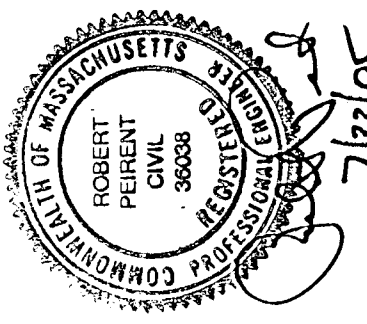


**East
Longmeadow
Board of Public
Works**

**Watchaug Force
Main Replacement
Contract No. 1**


East Longmeadow,
Massachusetts

2	1/06	Record Plan
1	08/10/05	Revised for Bidding
0	07/25/05	Issued for Permit Approval
Mark	Date	Description
PROJECT NO: E-0507		
FILE/CONTRACT-11 DETAILS		
DRAWN BY:	ARG	
CHECKED:	DRP	
APPROVED BY:	RP, MRP	


FORCE MAIN VAULT DETAILS	
SCALE:	AS NOTED
SHEET 8	

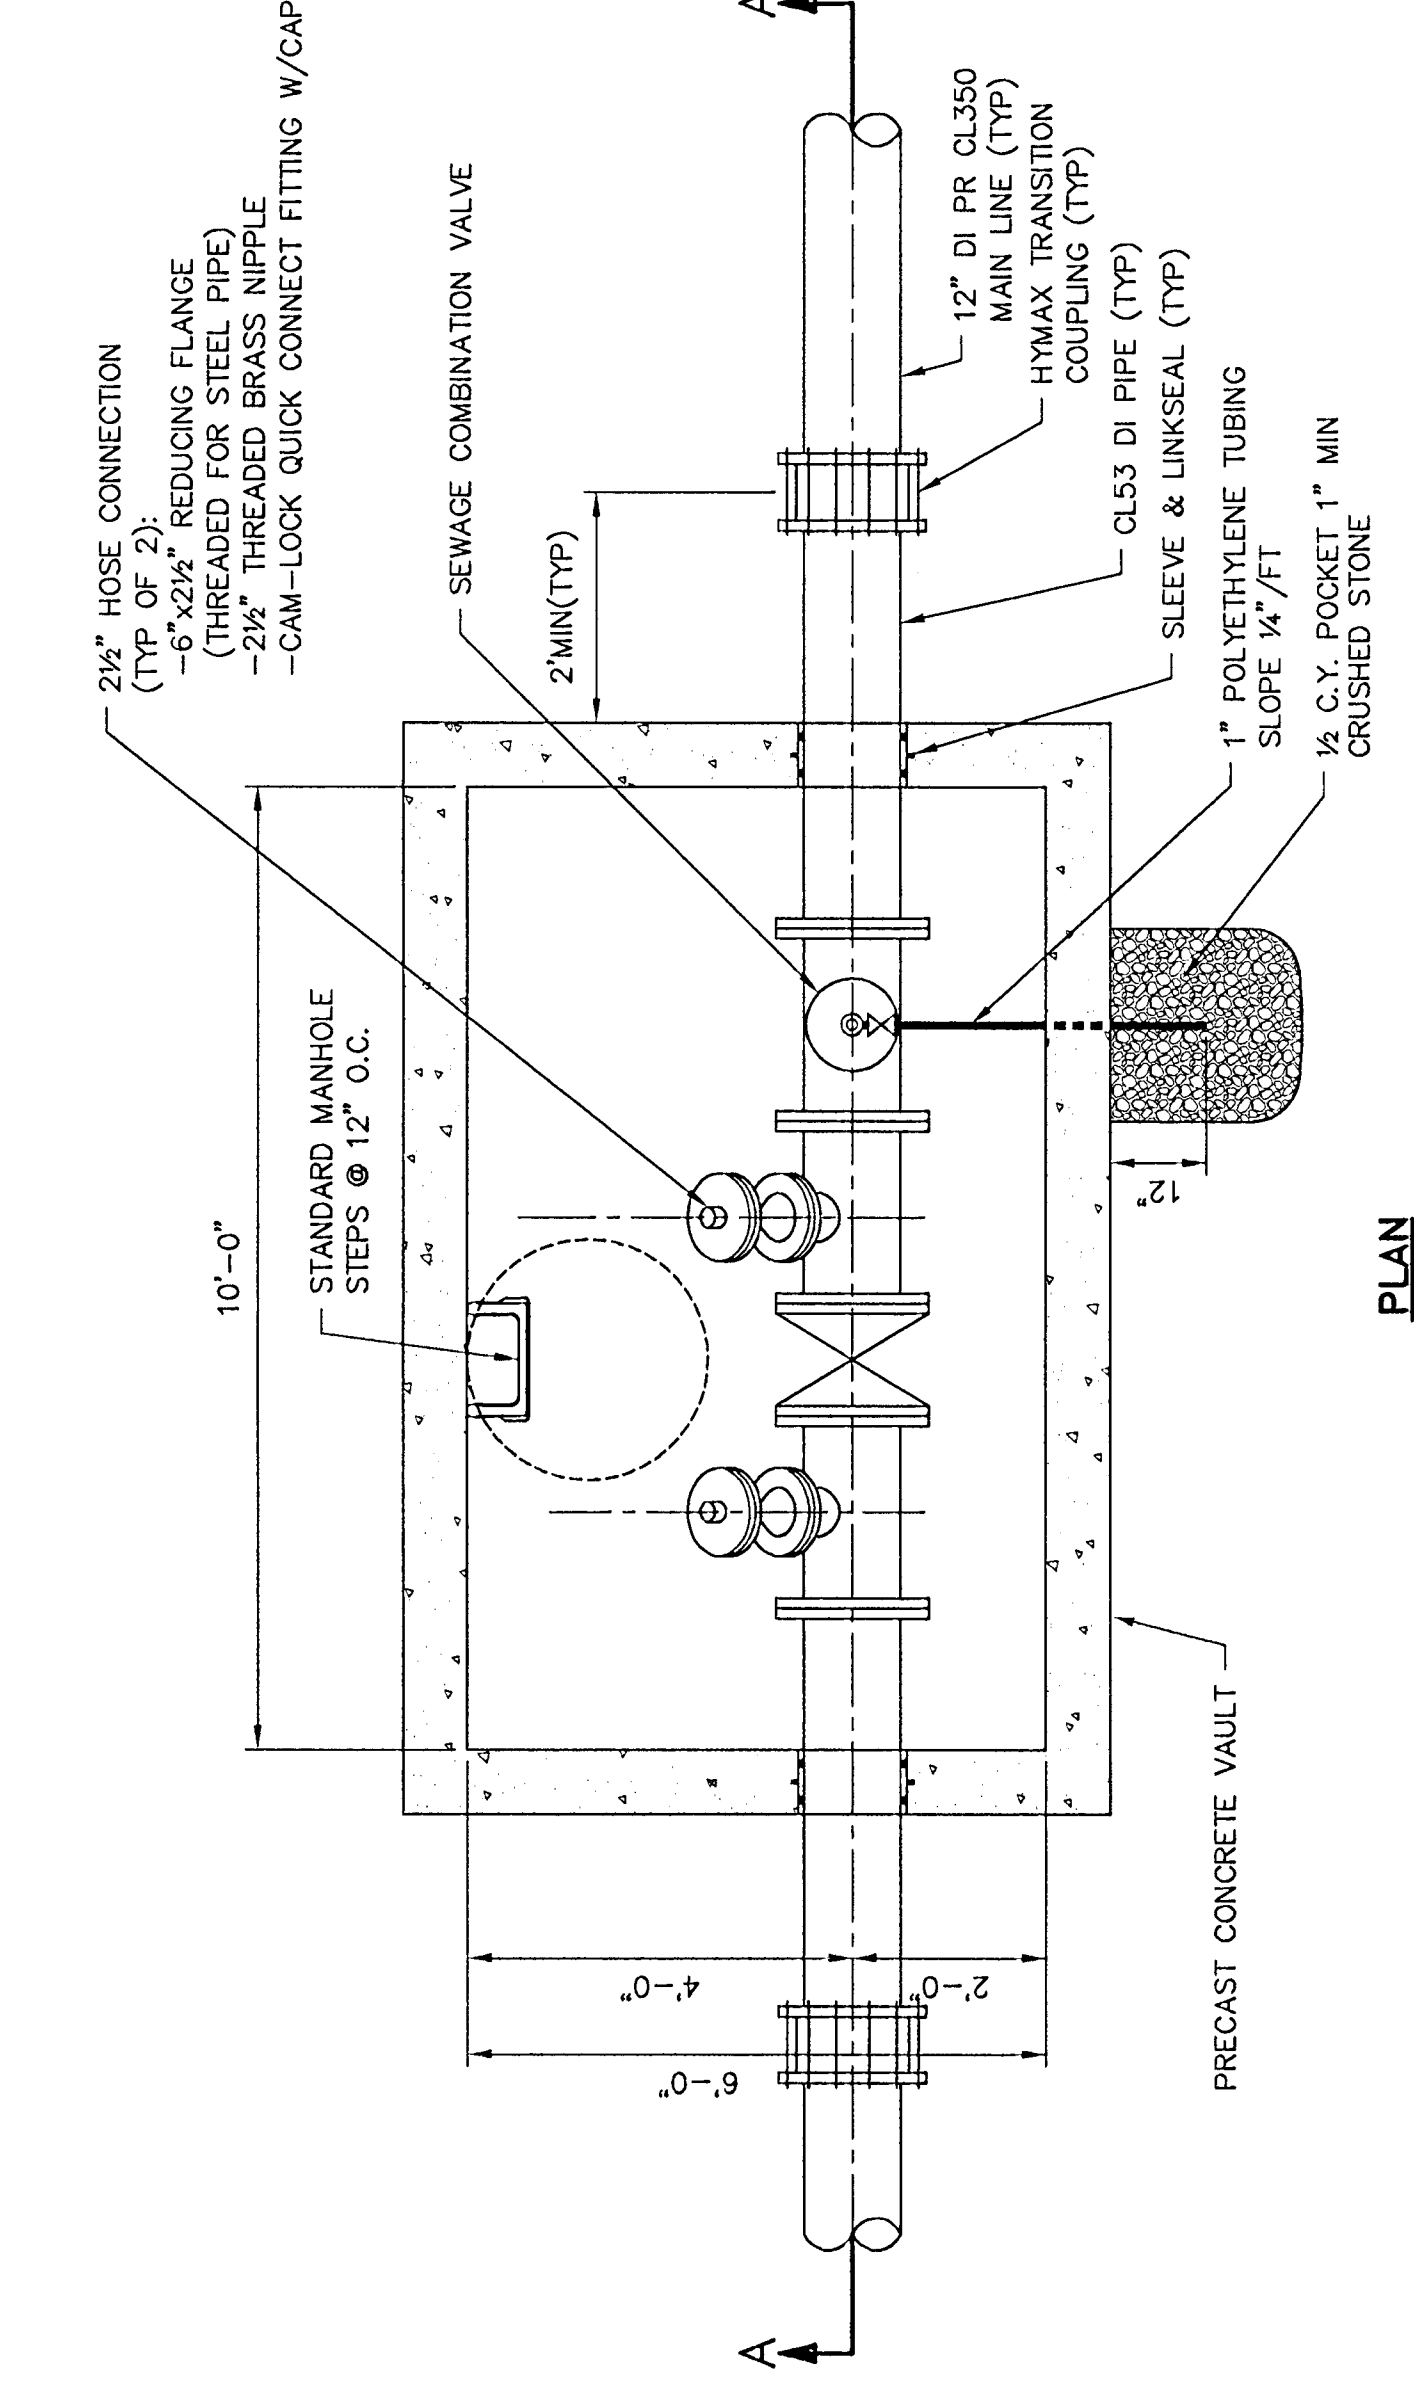


PLAN

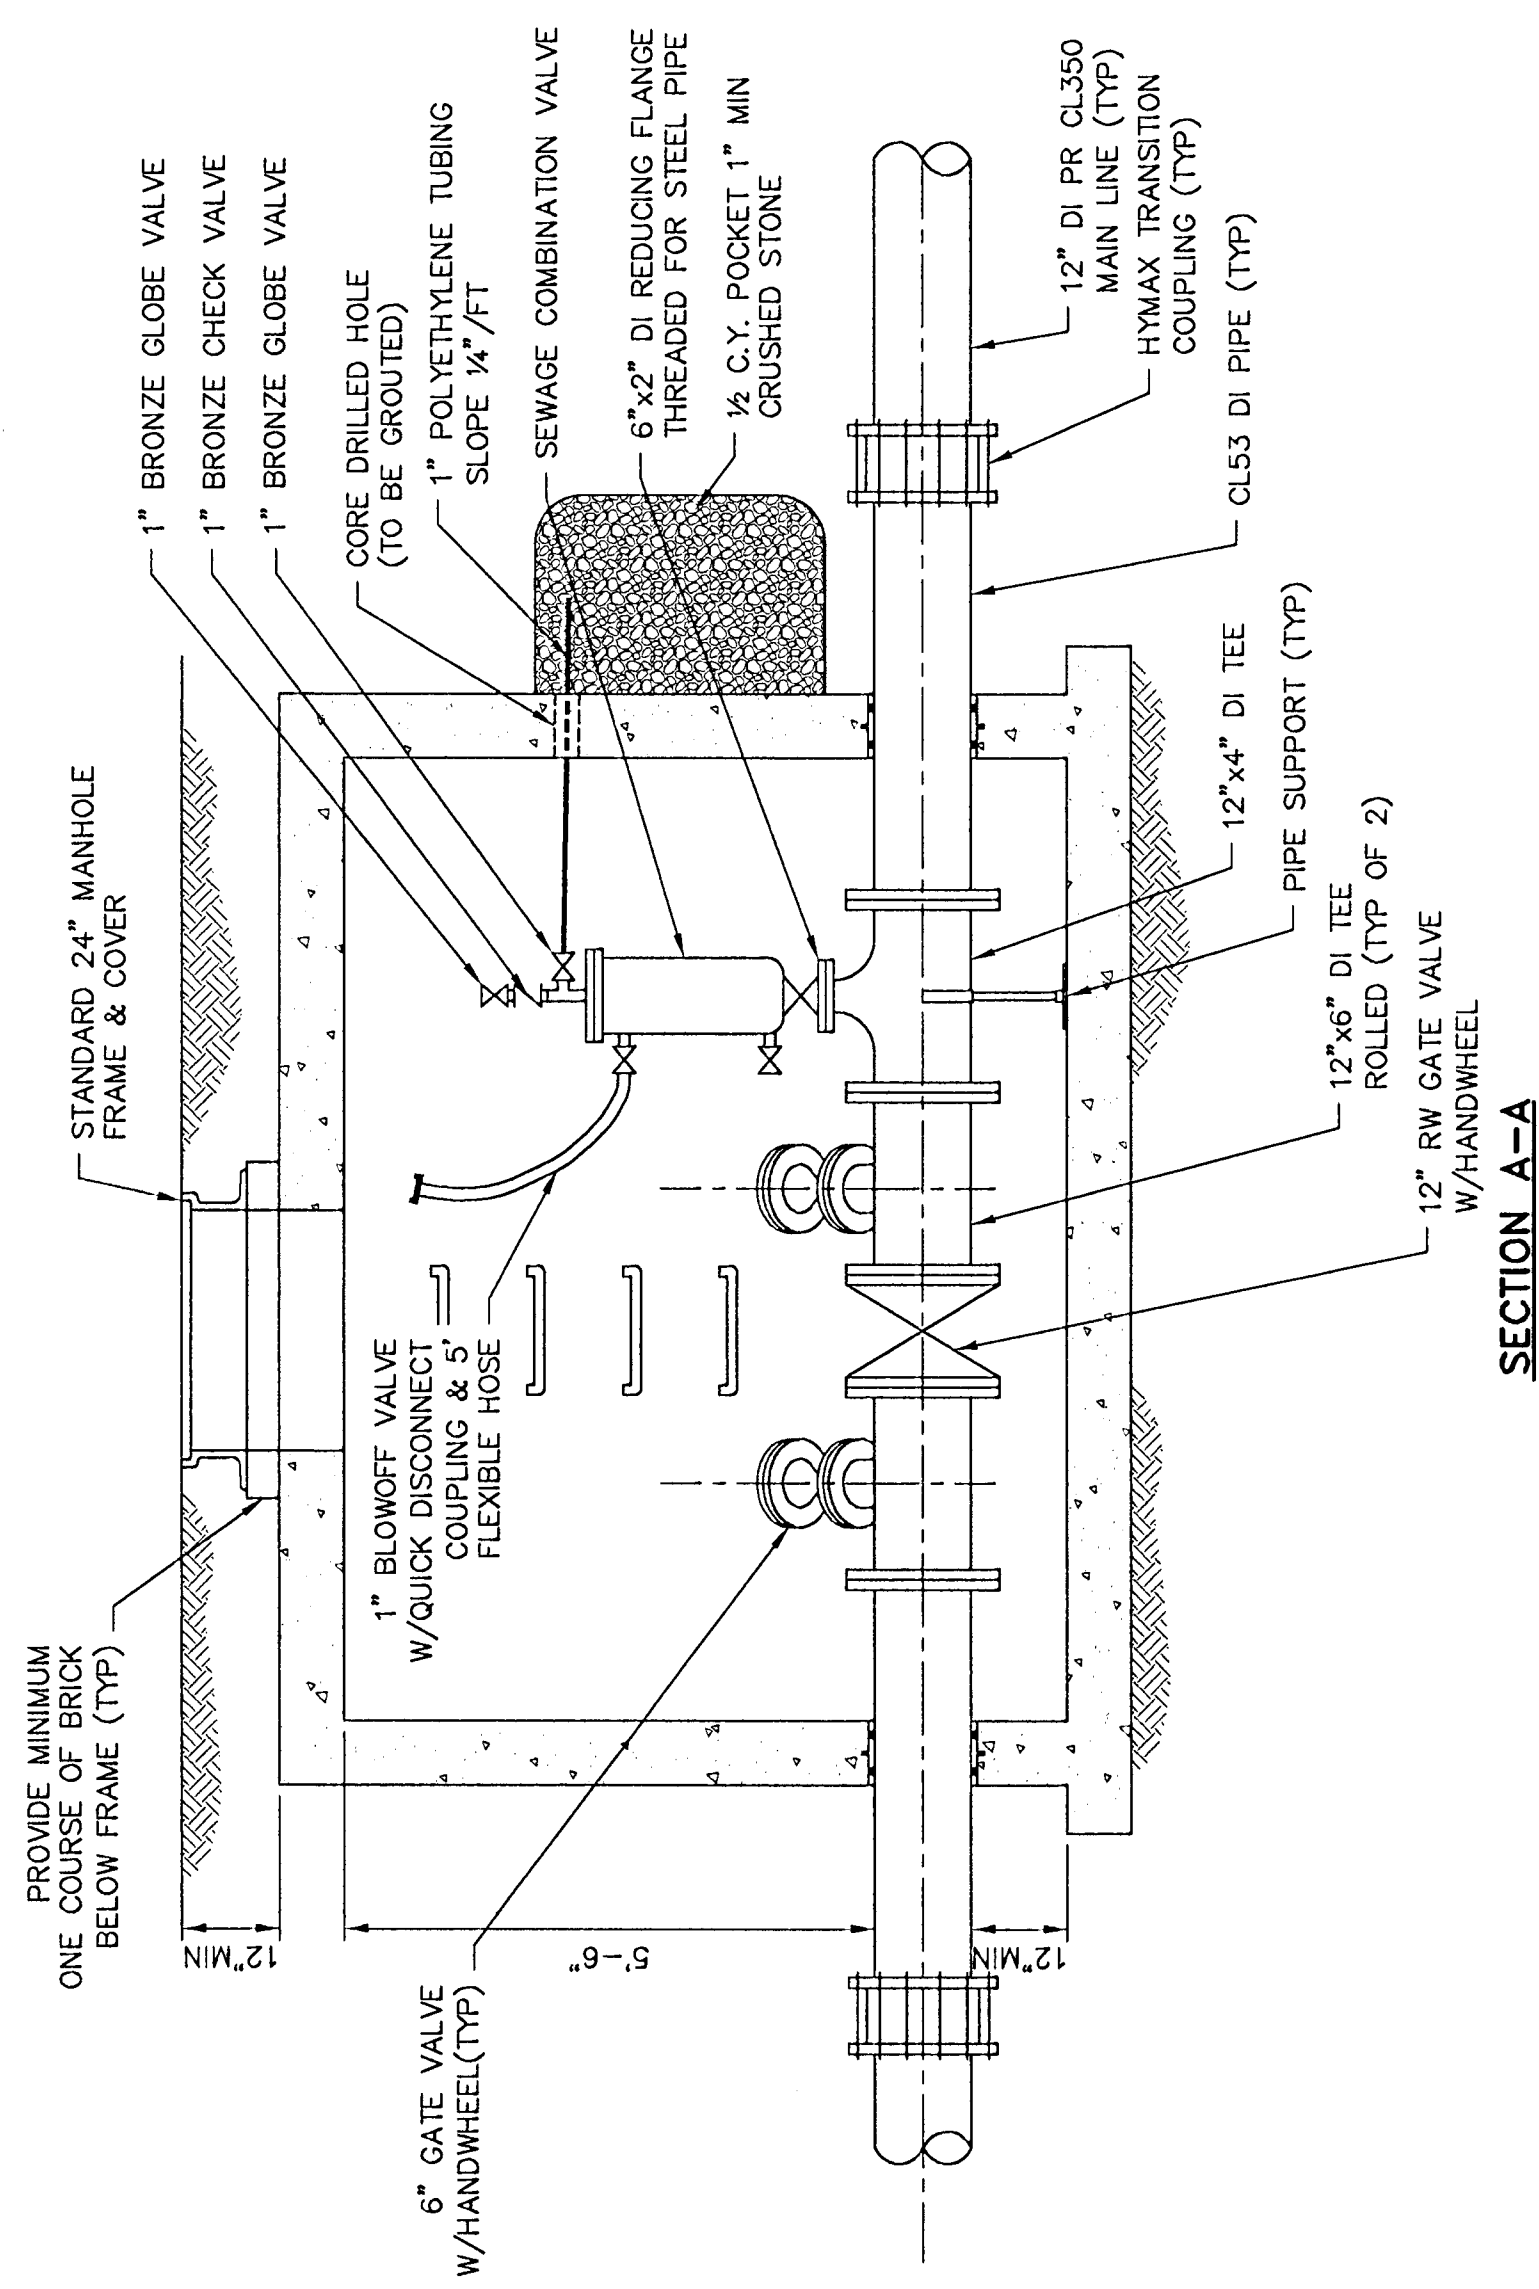

SECTION A-A

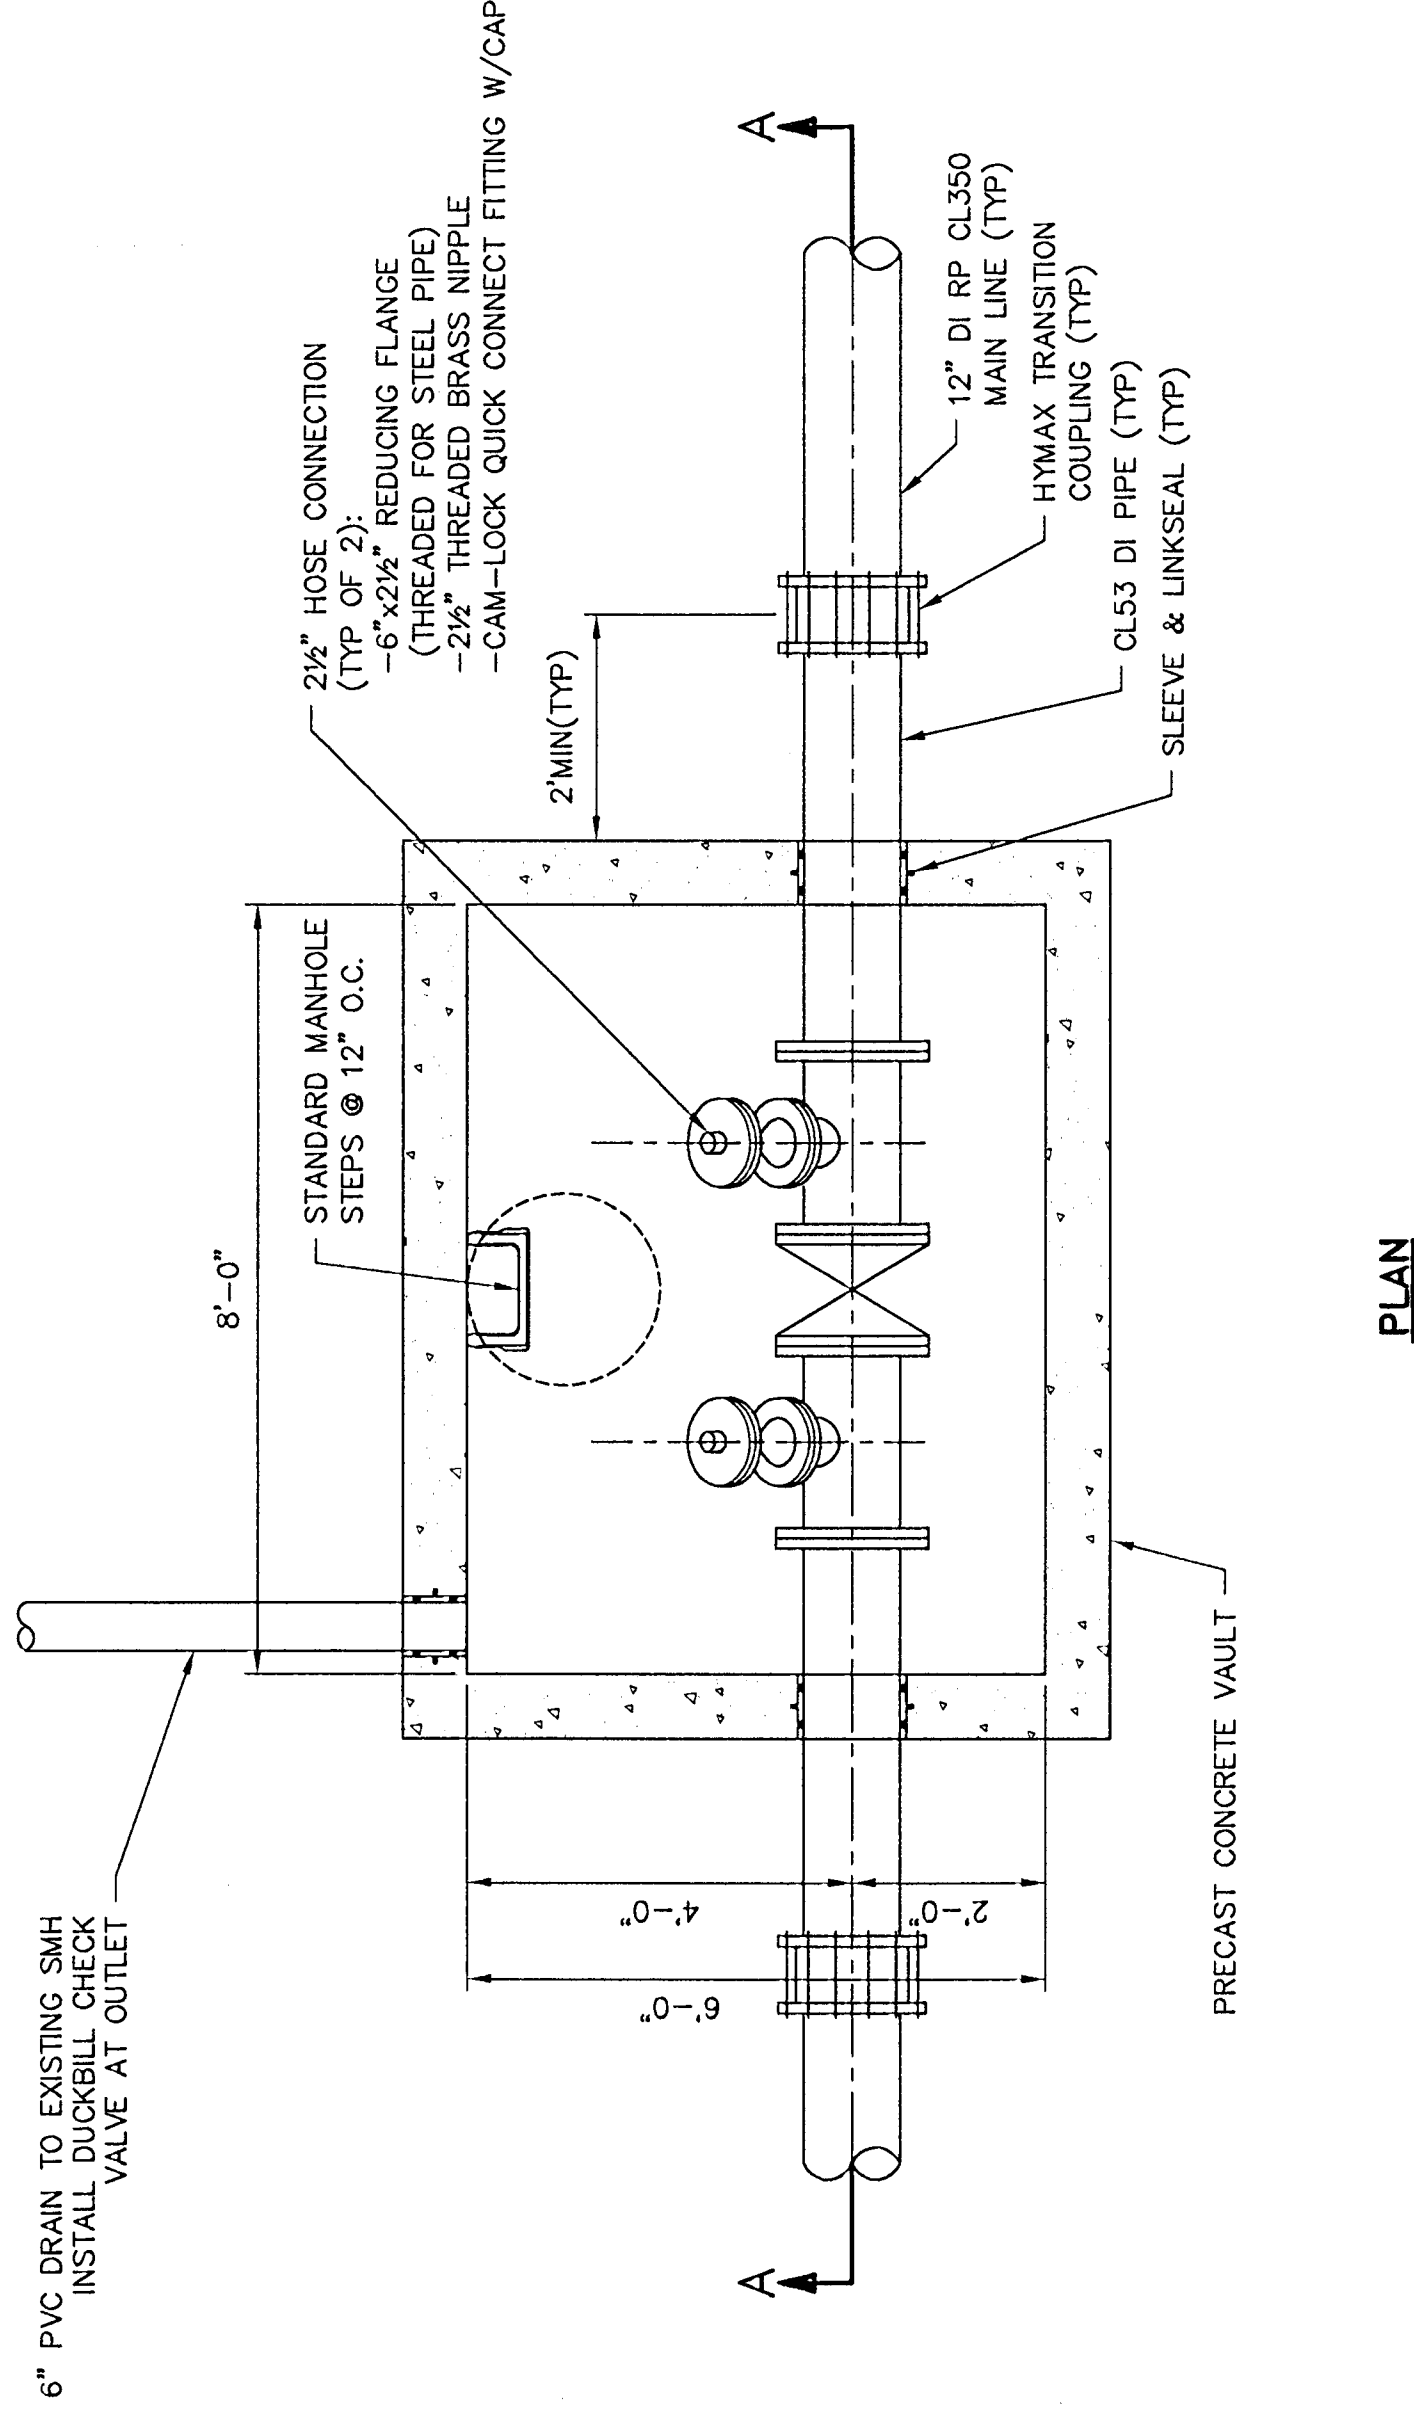

PLAN

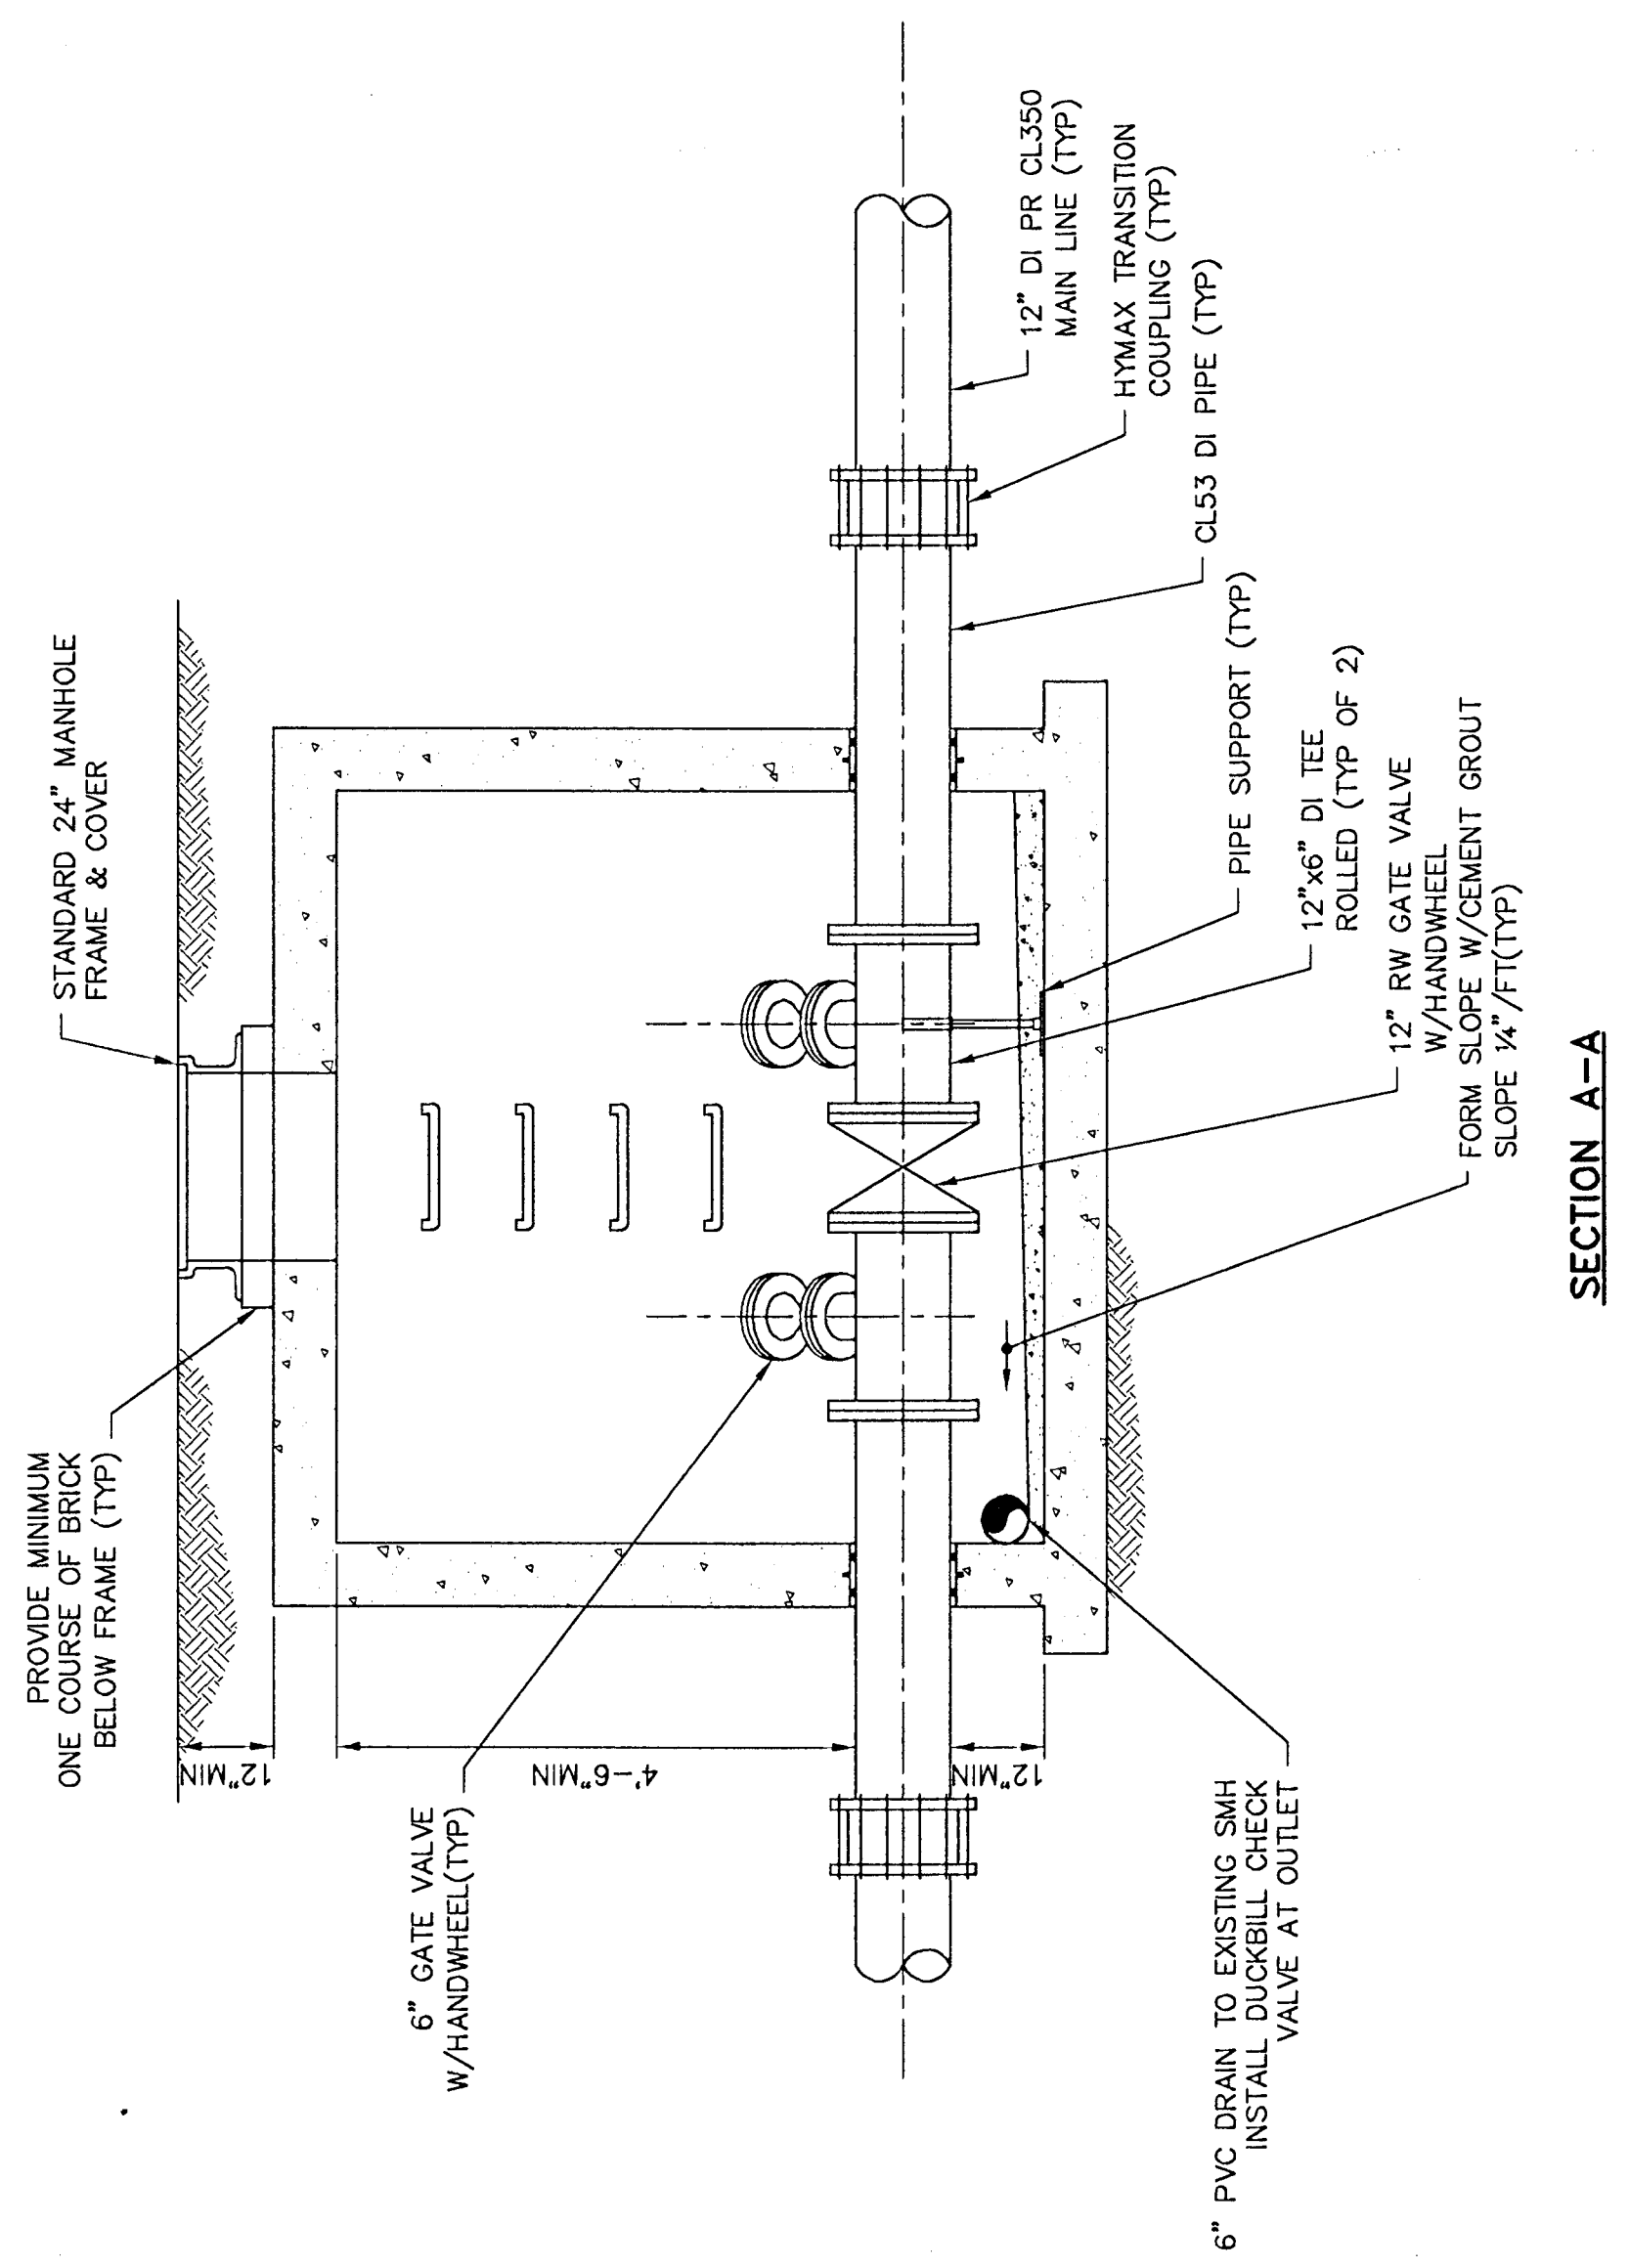

SECTION A-A

**FORCE MAIN
FLUSHING STRUCTURE**
NO SCALE

**FORCE MAIN
FLUSHING & AIR RELEASE STRUCTURE**
NO SCALE

RECORD PLAN

THIS RECORD PLAN WAS PREPARED BASED ON LIMITED INFORMATION GATHERED DURING CONSTRUCTION OF THE PROJECT AND INDICATES ONLY SIGNIFICANT CHANGES MADE FROM THE DESIGN PLANS DURING CONSTRUCTION.