
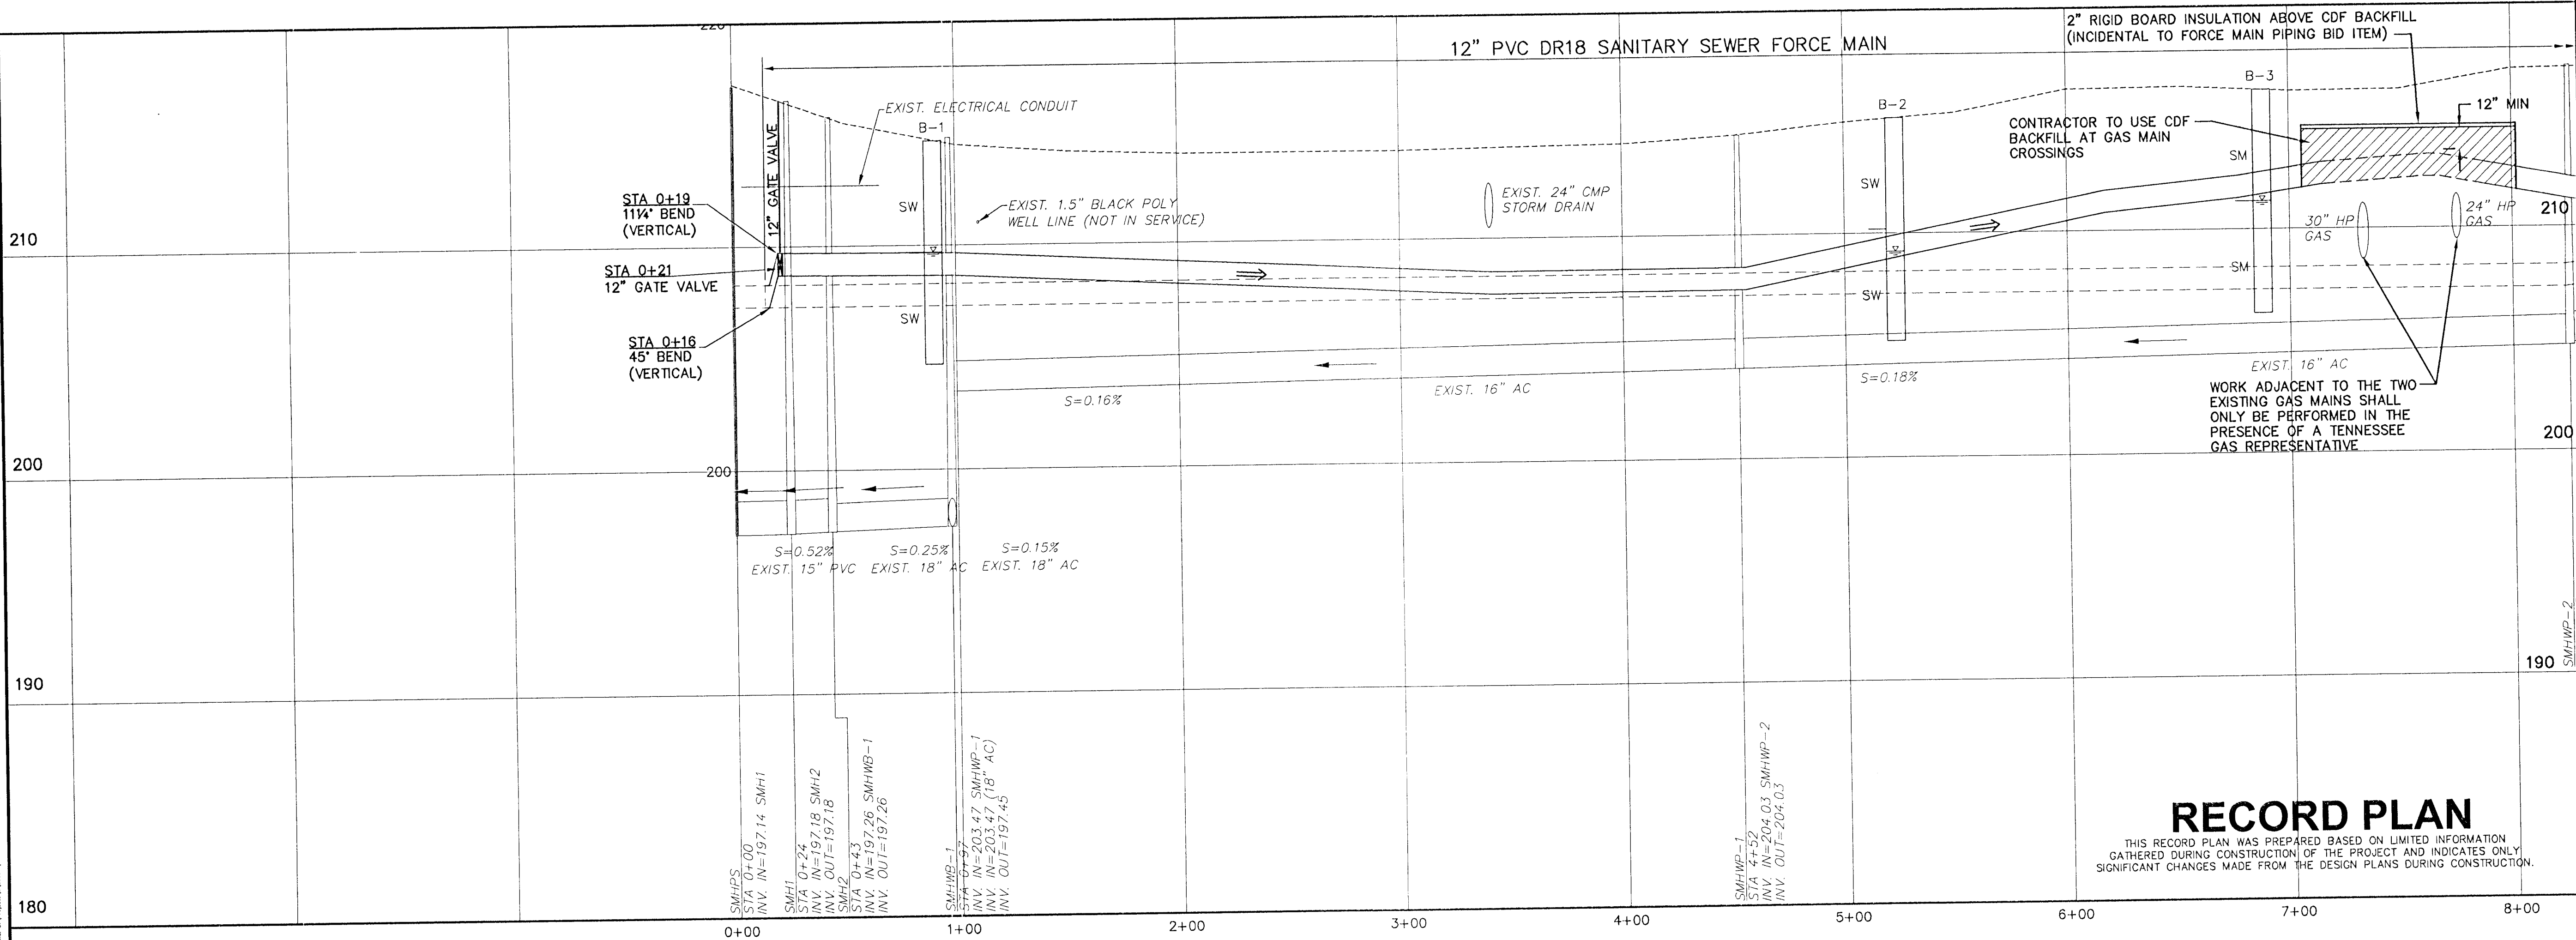


NOTE:

1. CONTRACTOR TO CLEAR, GRUB, AND RESTORE EXISTING EASEMENT FROM STA. 0+00 TO STA 29+00 IN ACCORDANCE WITH BID ITEM #9.


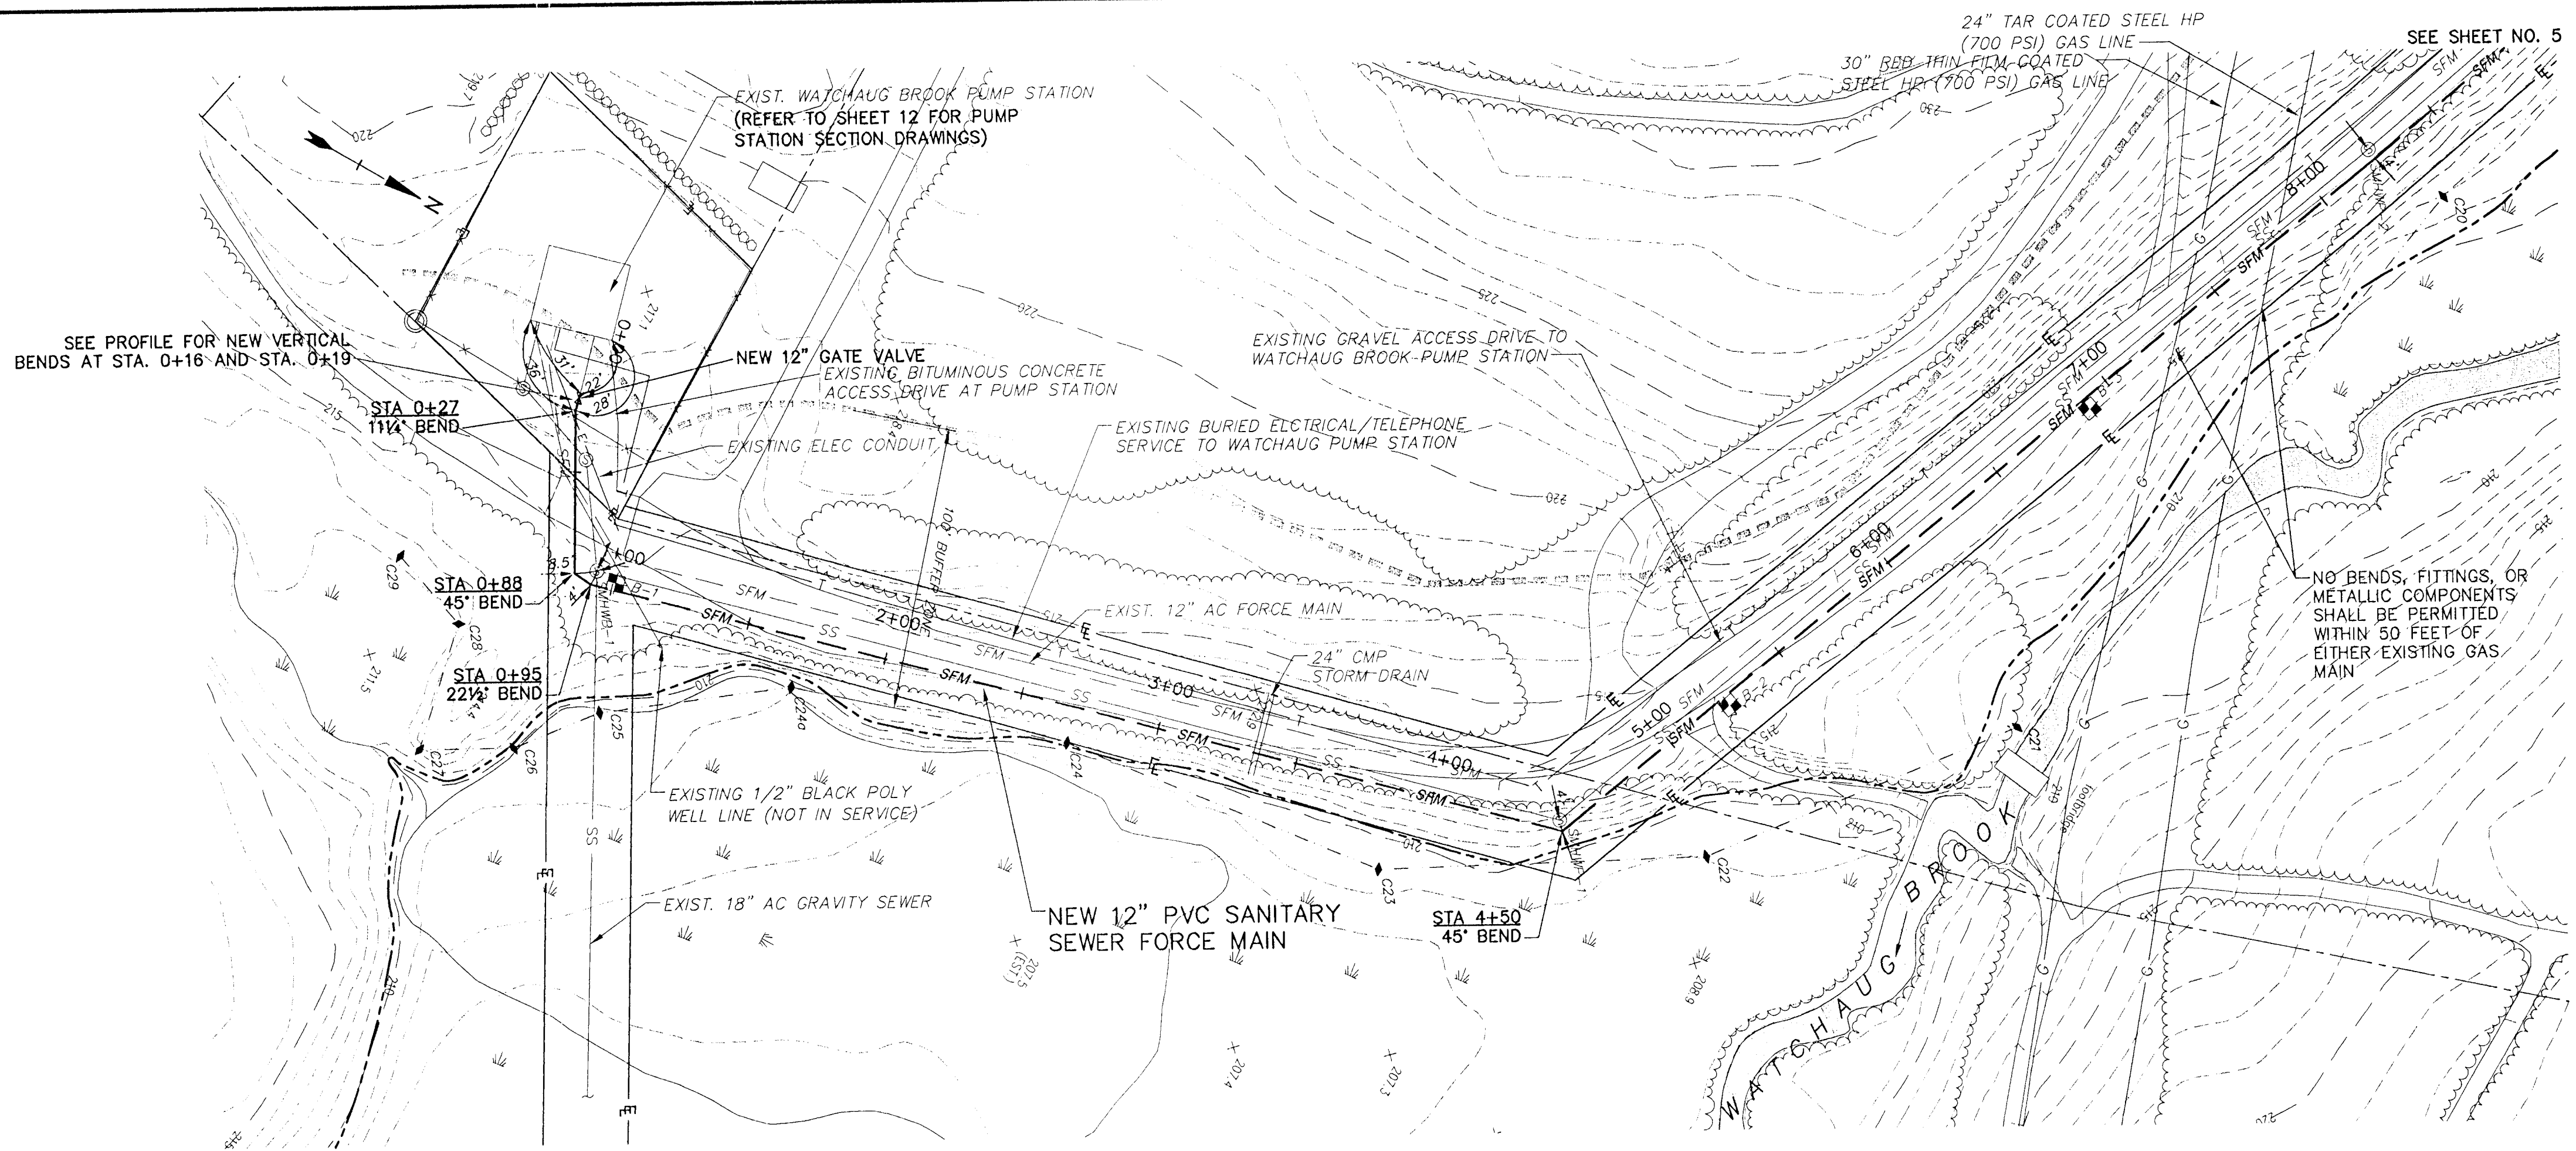


RECORD PLAN

THIS RECORD PLAN WAS PREPARED BASED ON LIMITED INFORMATION GATHERED DURING CONSTRUCTION OF THE PROJECT AND INDICATES ONLY SIGNIFICANT CHANGES MADE FROM THE DESIGN PLANS DURING CONSTRUCTION.

Tighe & Bond

Consulting Engineers
53 Southampton Road
Westfield, Massachusetts
(413) 562-1600
www.tighebond.com

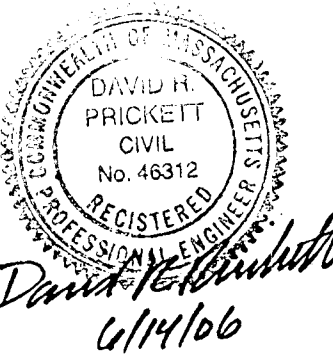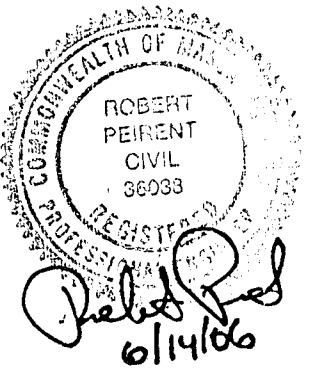

East Longmeadow
Department of
Public Works

Watchaug Force
Main Replacement
Contract No. 2

East Longmeadow,
Massachusetts

Mark	Date	Description
3	10/06	Record Plan
2	7/06	Update Gas Main Information
1	6/06	Issued for Bidding
0	07/25/05	Issued for Permit Approval

PROJECT NO: E-0507
FILE: WATCHAUG_FM CONTRACT 2 P&P
DRAWN BY: ARG, TMF
CHECKED: DRP, NBT
APPROVED BY: DRP, RP

PLAN & PROFILE
STA 0+00 TO STA 8+00

SCALE: 1"=40'H; 1"=4'V