

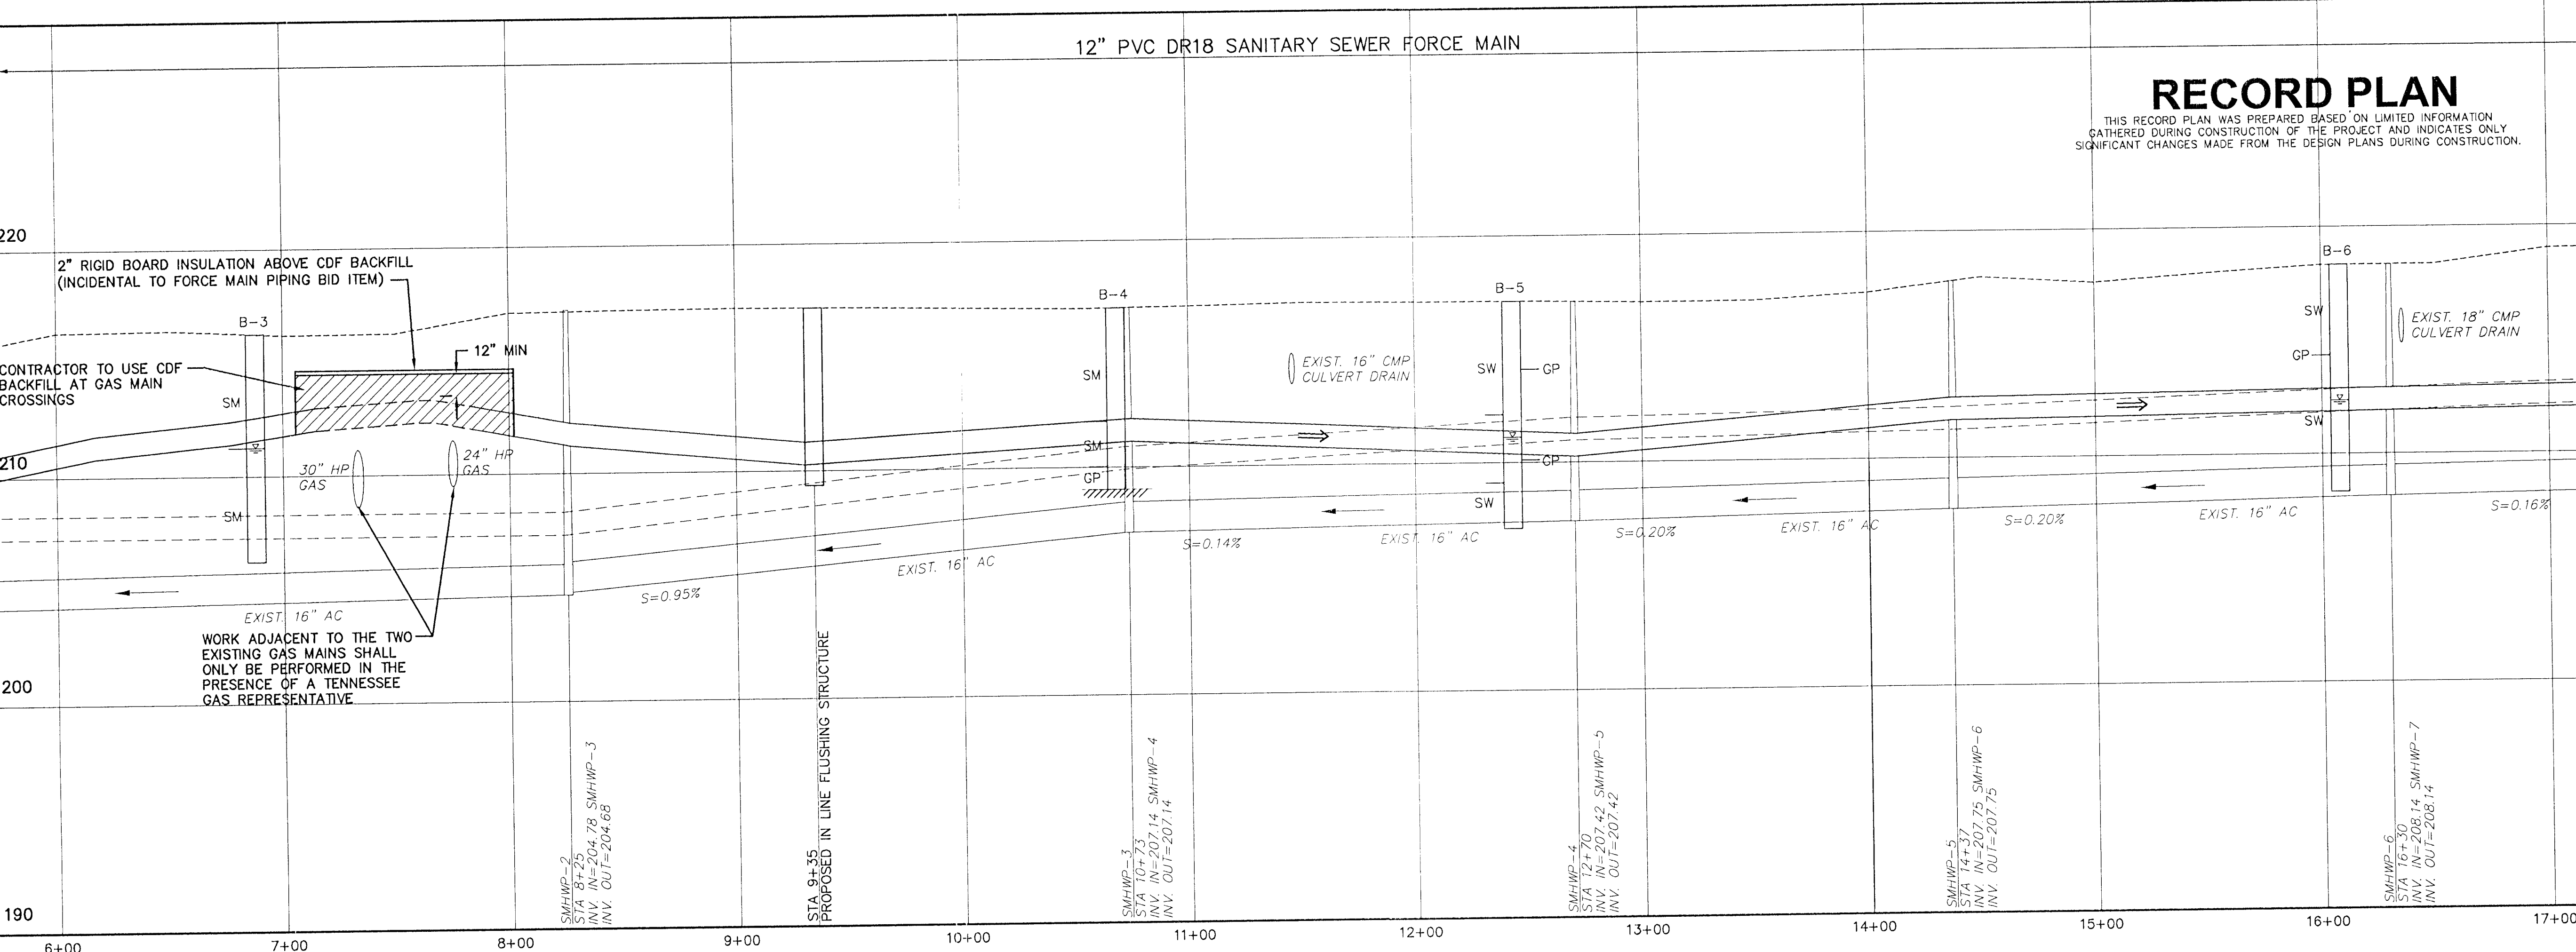
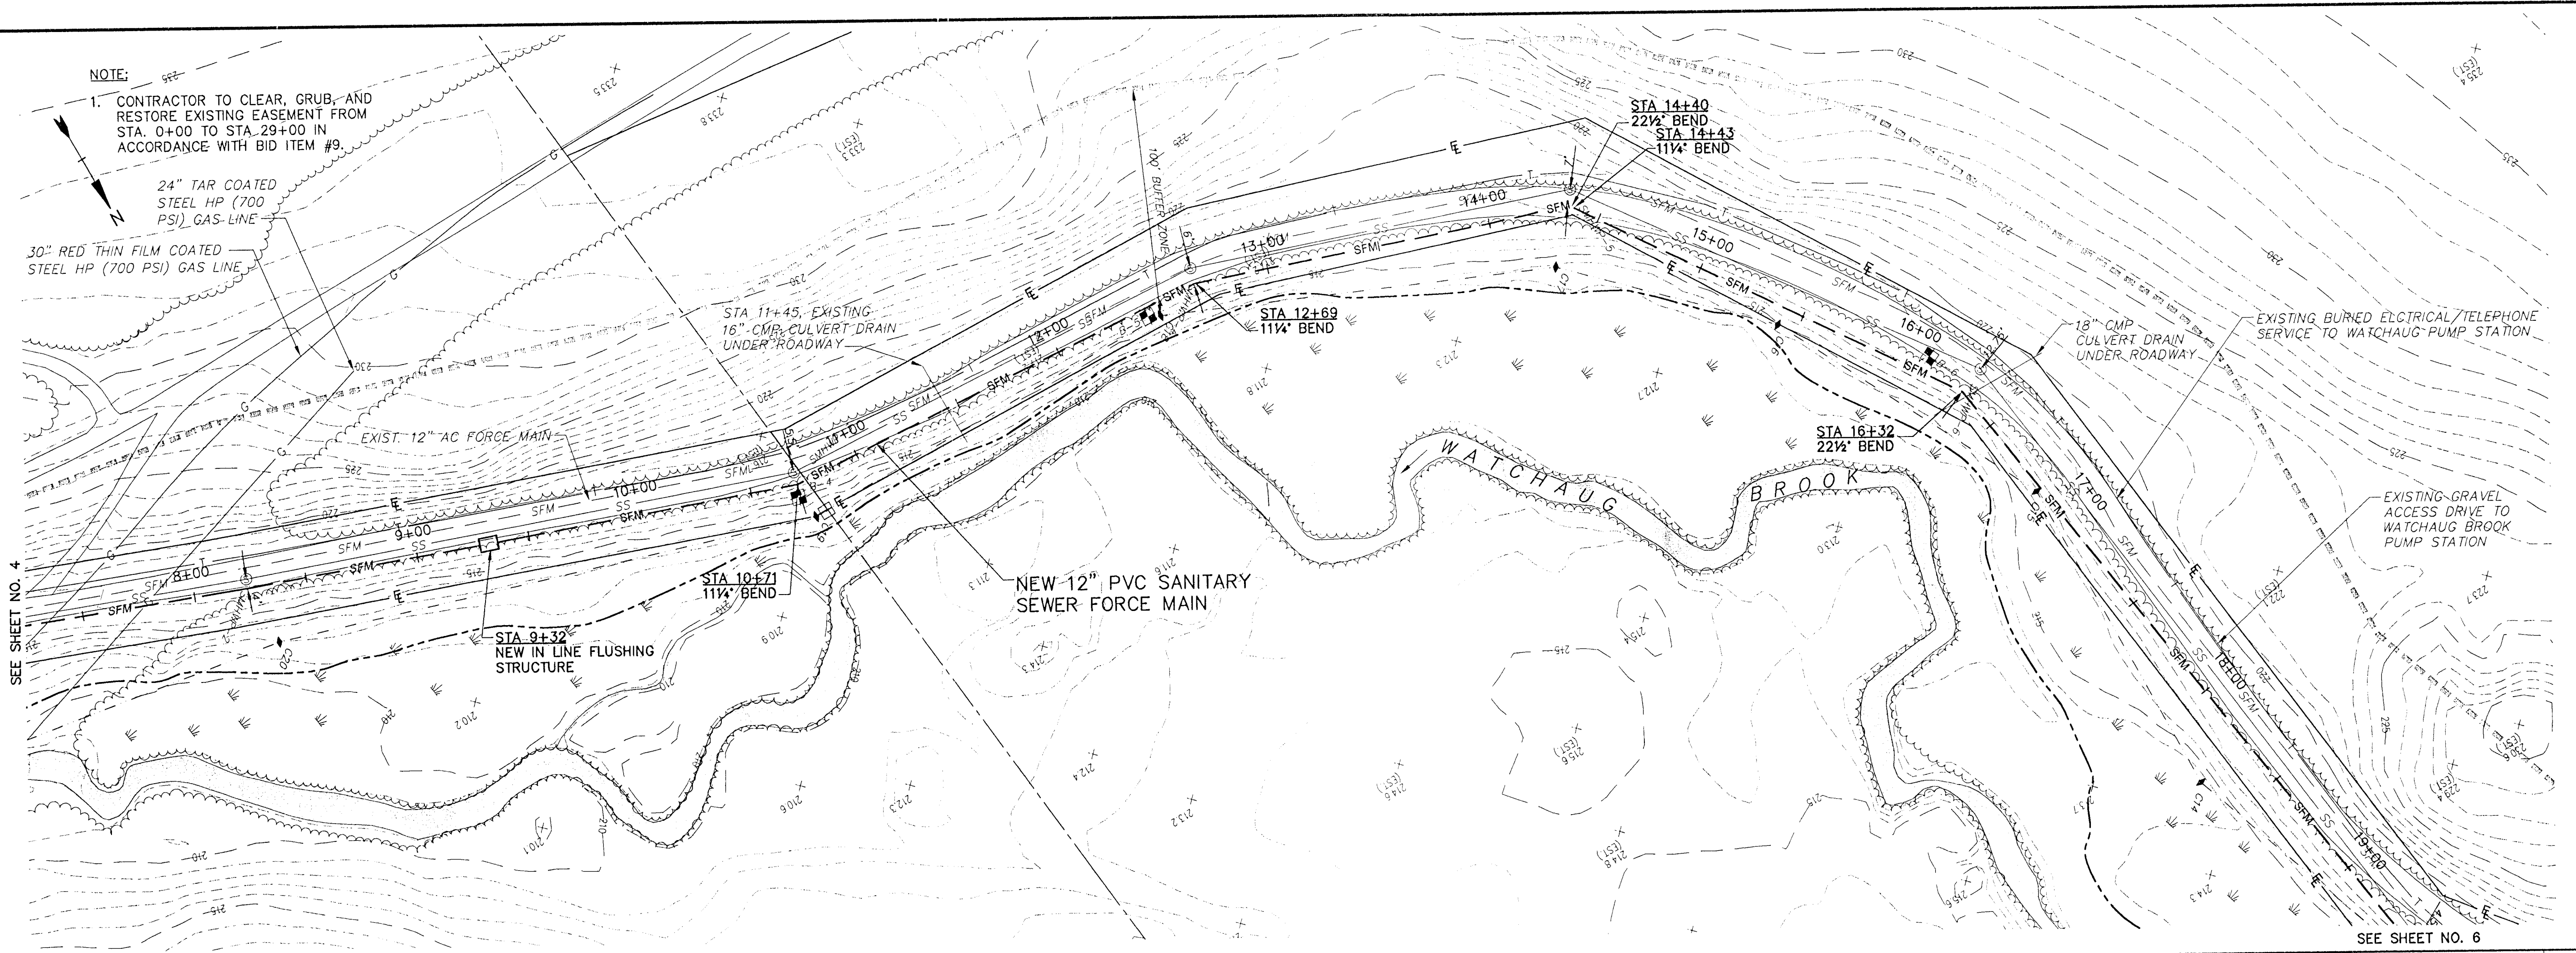


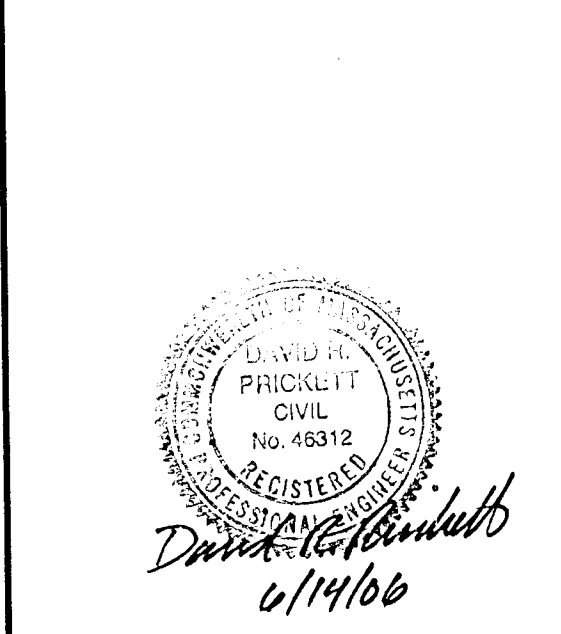

Tighe&Bond
Consulting Engineers
53 Southampton Road
Westfield, Massachusetts
(413) 562-1600
www.tighebond.com

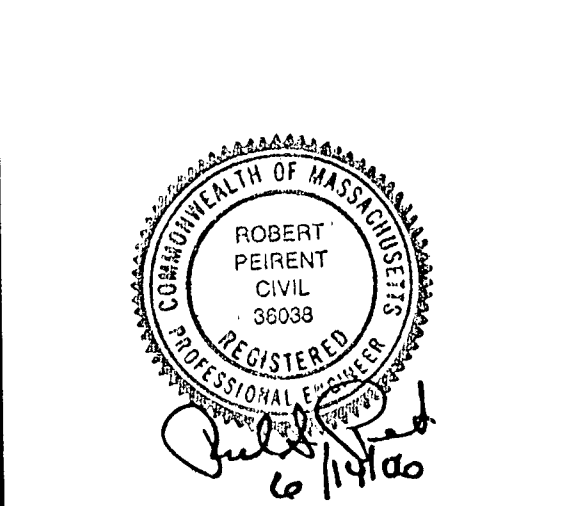

East Longmeadow
Department of Public Works
Watchaug Force Main Replacement
Contract No. 2
East Longmeadow, Massachusetts

Massachusetts

3	10/06	Record Plan	
2	7/06	Update Gas Main Information	
1	6/06	Issued for Bidding	
0	07/25/05	Issued for Permit Approval	
Mark	Date	Description	
PROJECT NO:		E-0507	
FILE:WATCHAUG_FM\CONTRACT2\2.P&P			
DRAWN BY:		ARG	
CHECKED:		DRP,NBT	
APPROVED BY:		DRP,RP	
PLAN & PROFILE			
STA 8+00 TO STA 17+00			
SCALE:		1"=40'H;1"=4'V	

SHEET 5 OF 12