

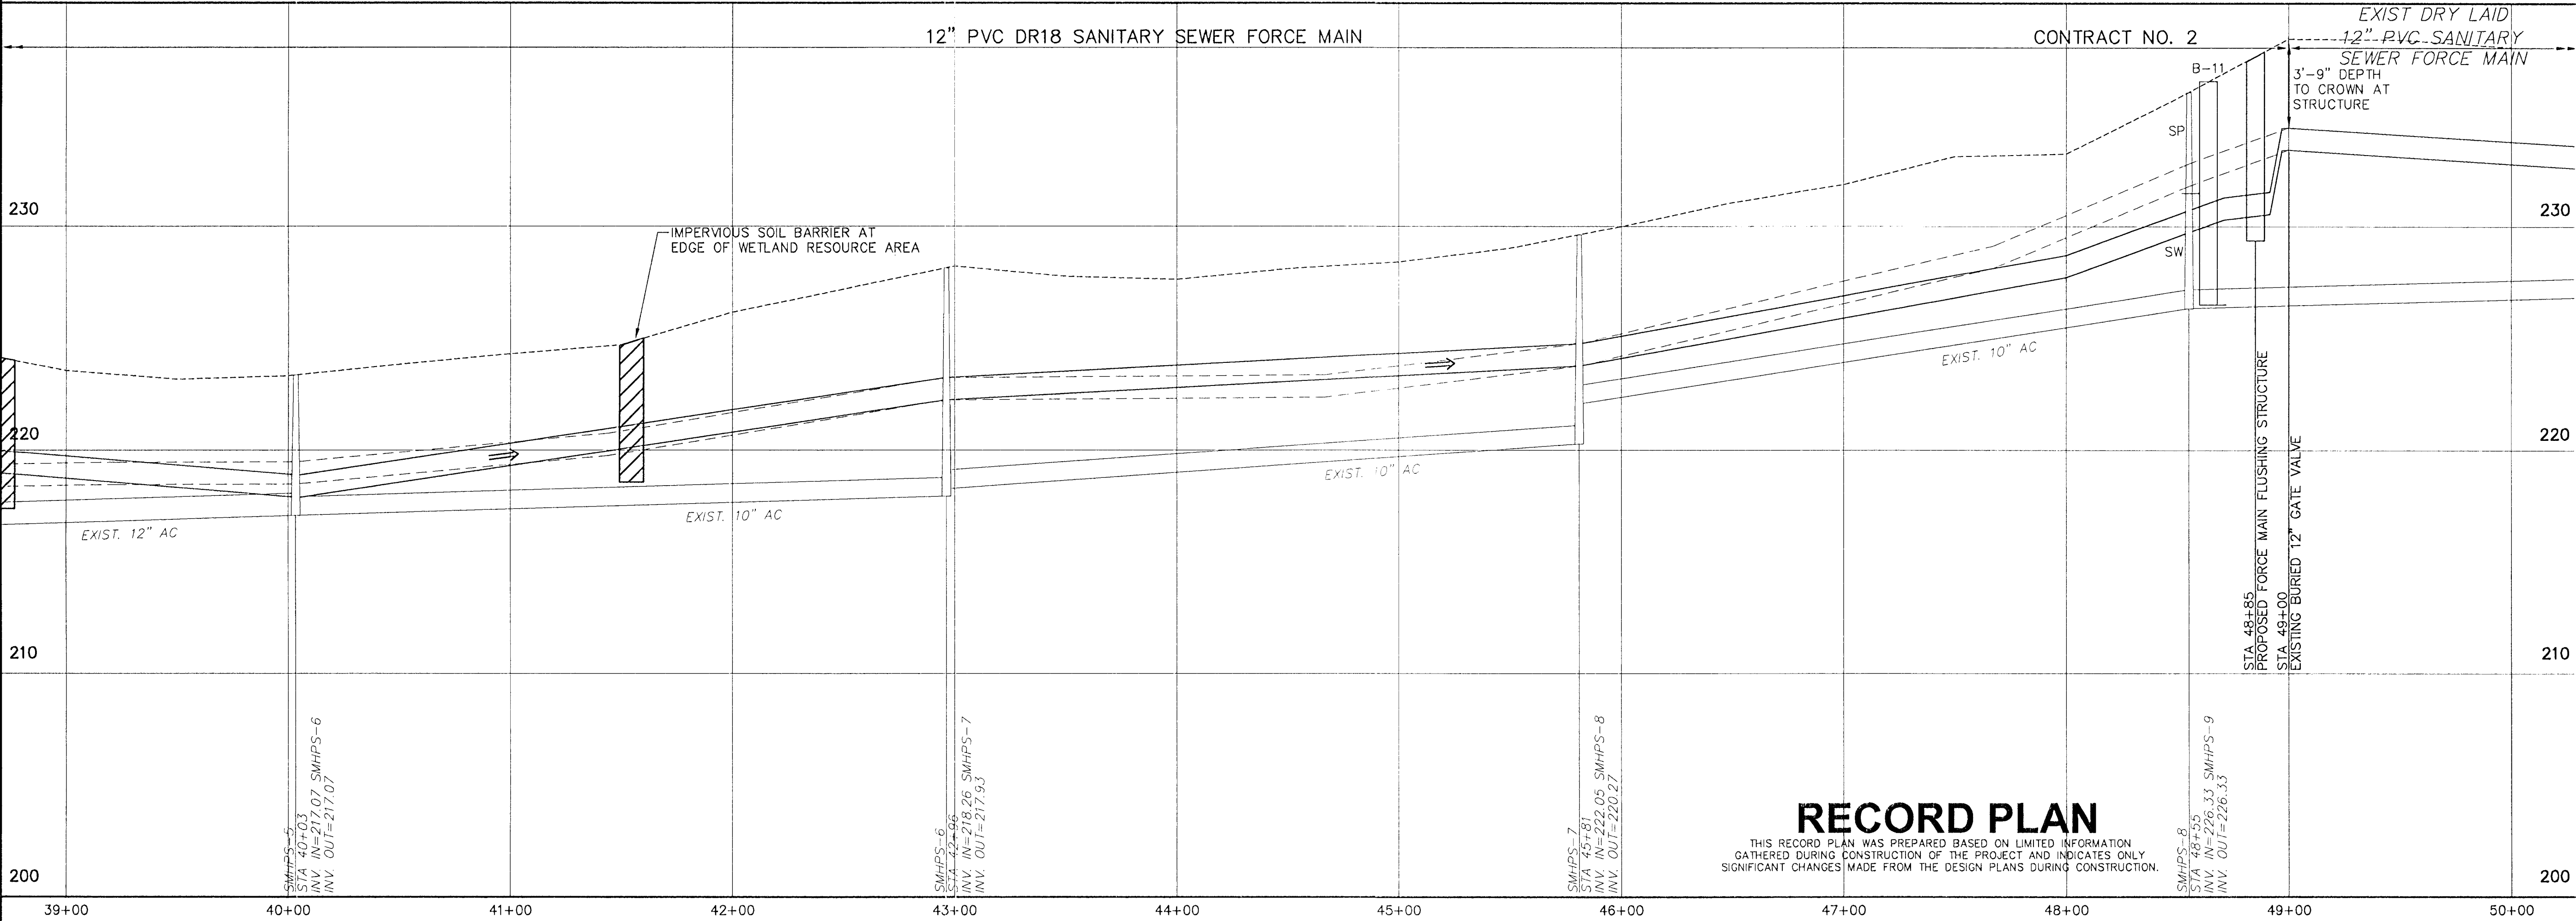
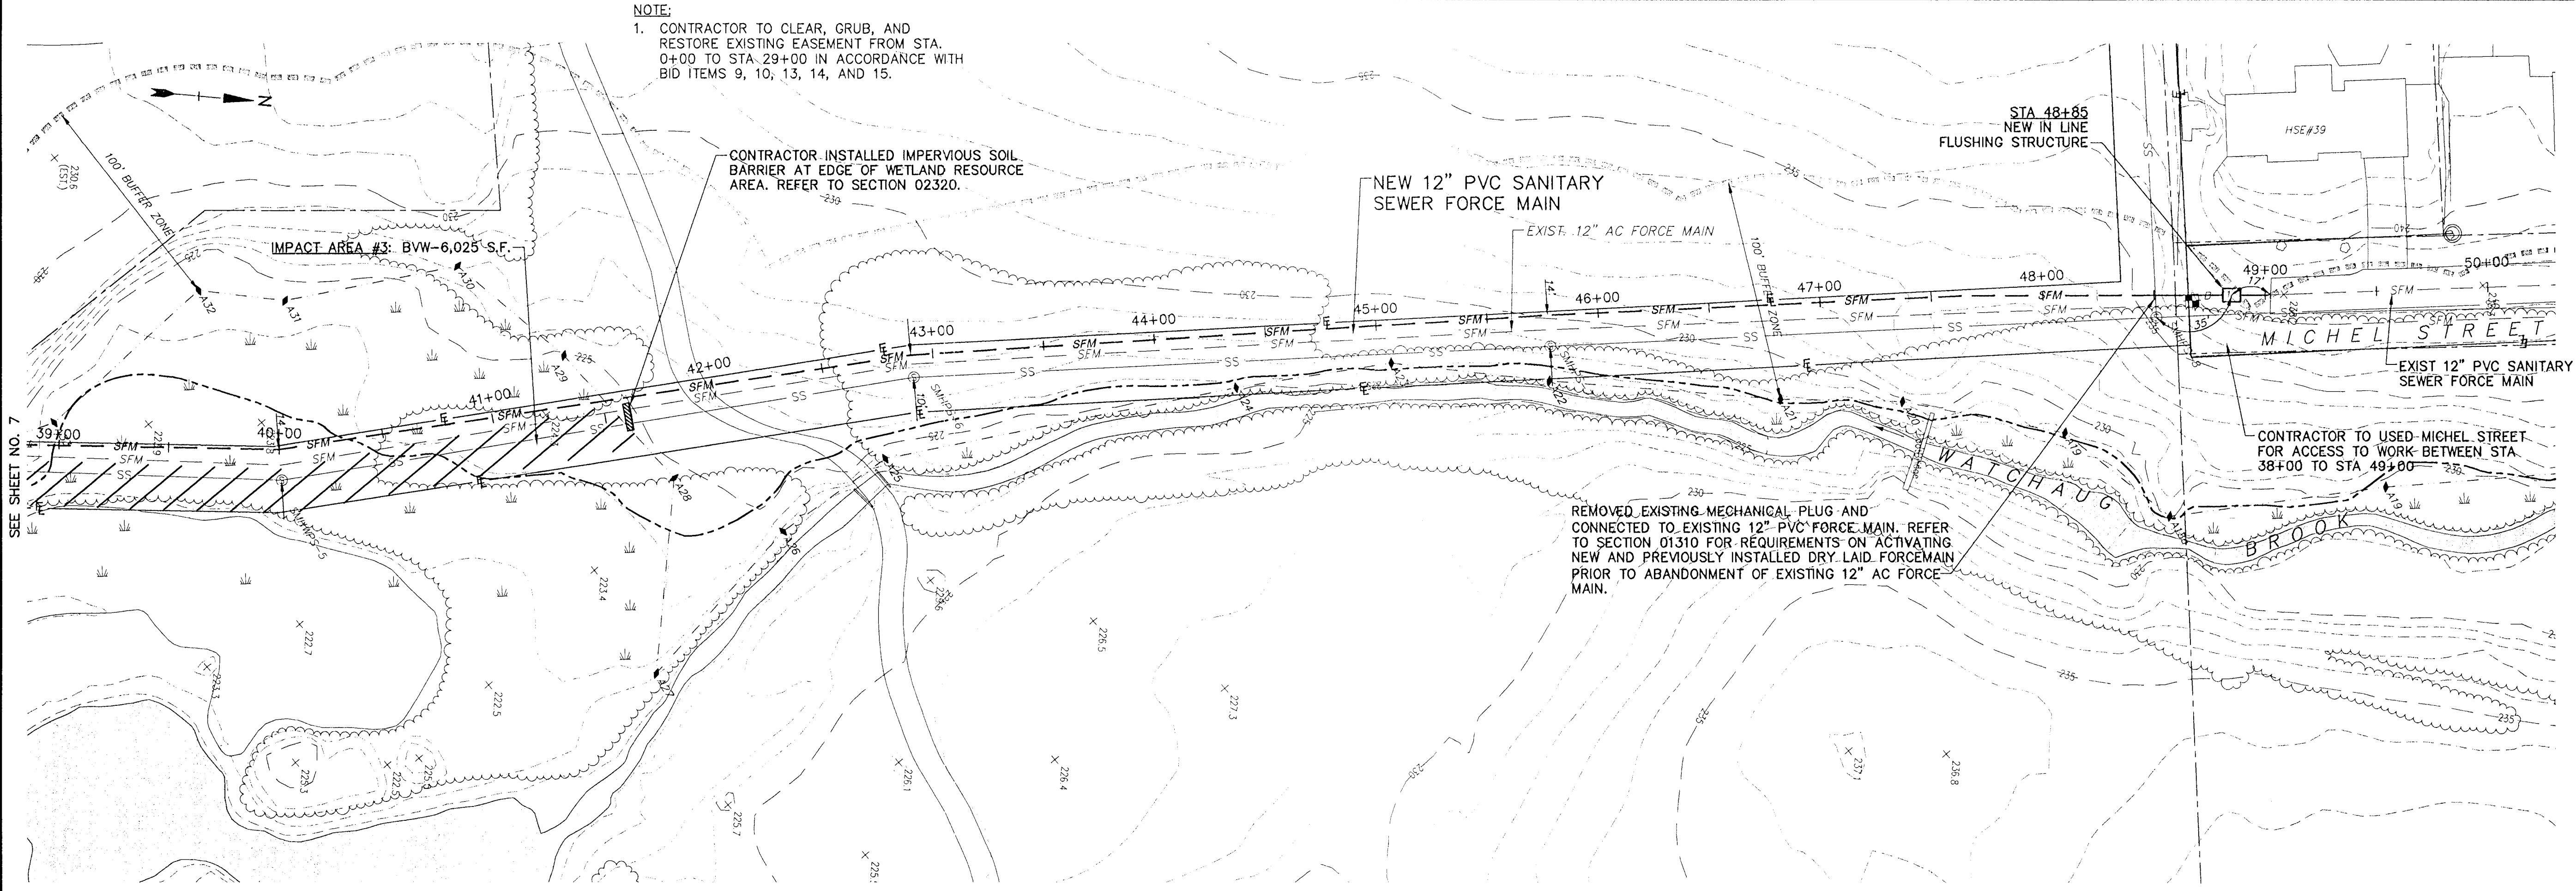


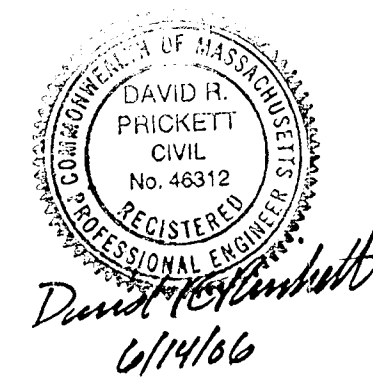

RECORD PLAN

THIS RECORD PLAN WAS PREPARED BASED ON LIMITED INFORMATION GATHERED DURING CONSTRUCTION OF THE PROJECT AND INDICATES ONLY SIGNIFICANT CHANGES MADE FROM THE DESIGN PLANS DURING CONSTRUCTION.

Tighe & Bond
Consulting Engineers
53 Southampton Road
Westfield, Massachusetts
(413) 562-1600
www.tighebond.com

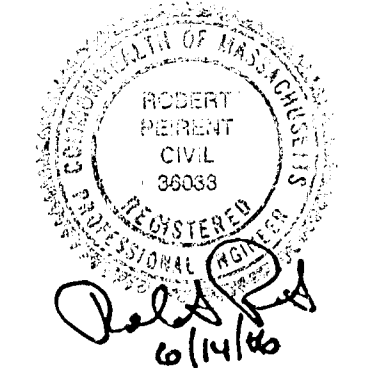

East Longmeadow Department of Public Works
Watchaug Force Main Replacement Contract No. 2

East Longmeadow, Massachusetts

2	10/06	Record Plan
1	6/06	Issued for Bidding
0	07/25/05	Issued for Permit Approval
Mark	Date	Description
PROJECT NO: E-0507		
FILE:WATCHAUG_FM\CONTRACT2\ P&P		
DRAWN BY: ARG, TMF		
CHECKED: DRP, NBT		
APPROVED BY: DRP, RP		

PLAN & PROFILE
STA 39+00 TO STA 50+00

SCALE: 1"=40'H; 1"=4'V