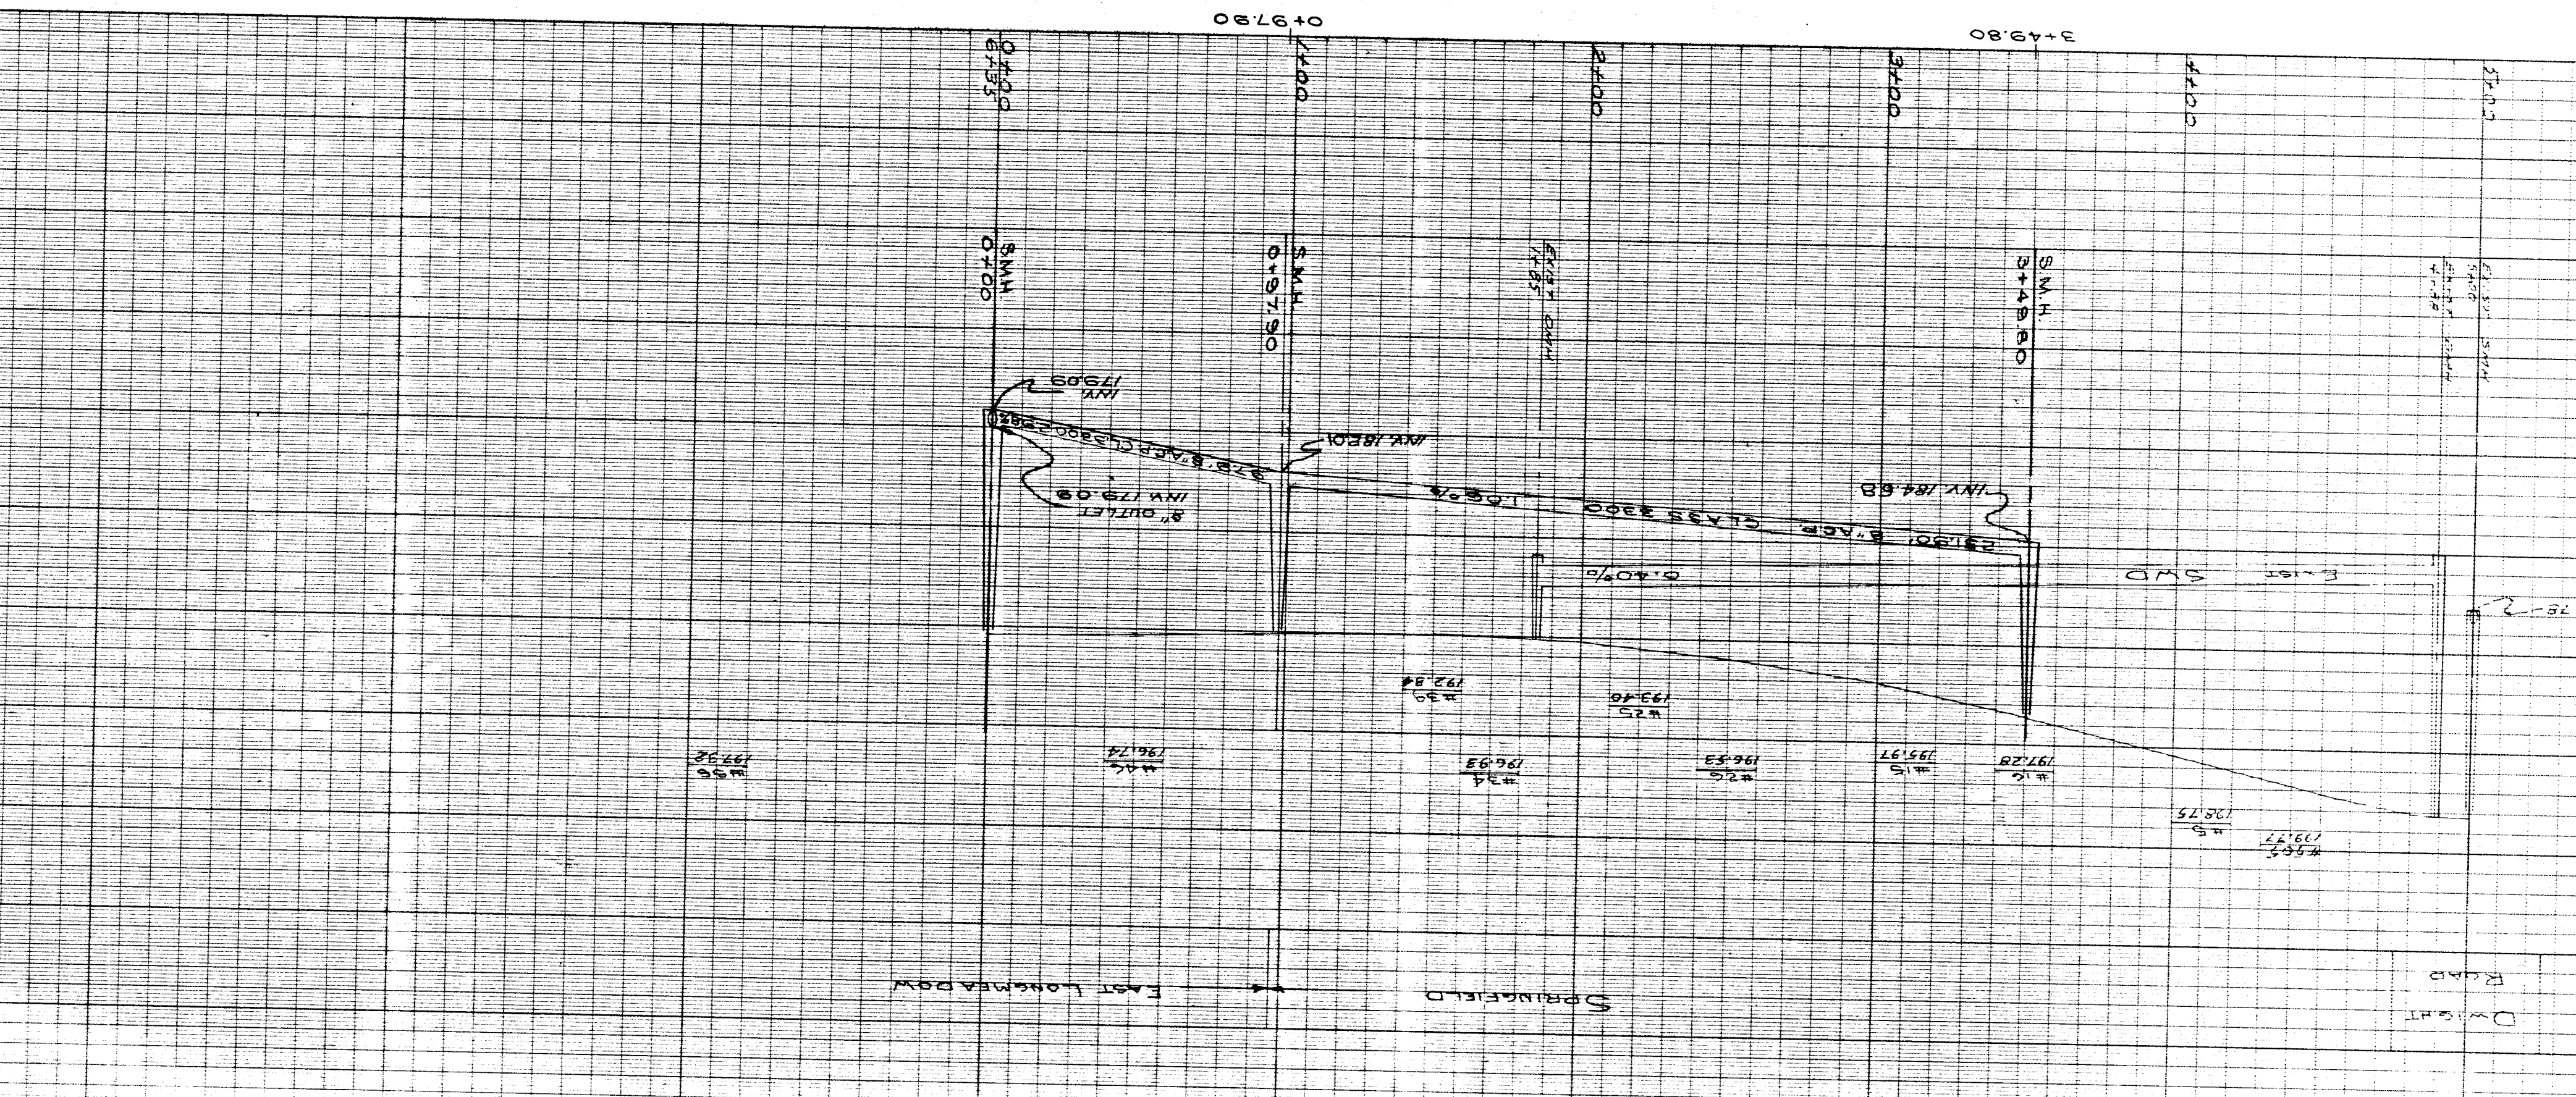



BENCHES: LETTER "C" HYD. # FIRST ON F.
GREEN SINGLE. PUTTING GREEN SINGLE. WLY CORNER BOTTOM STEP #1.