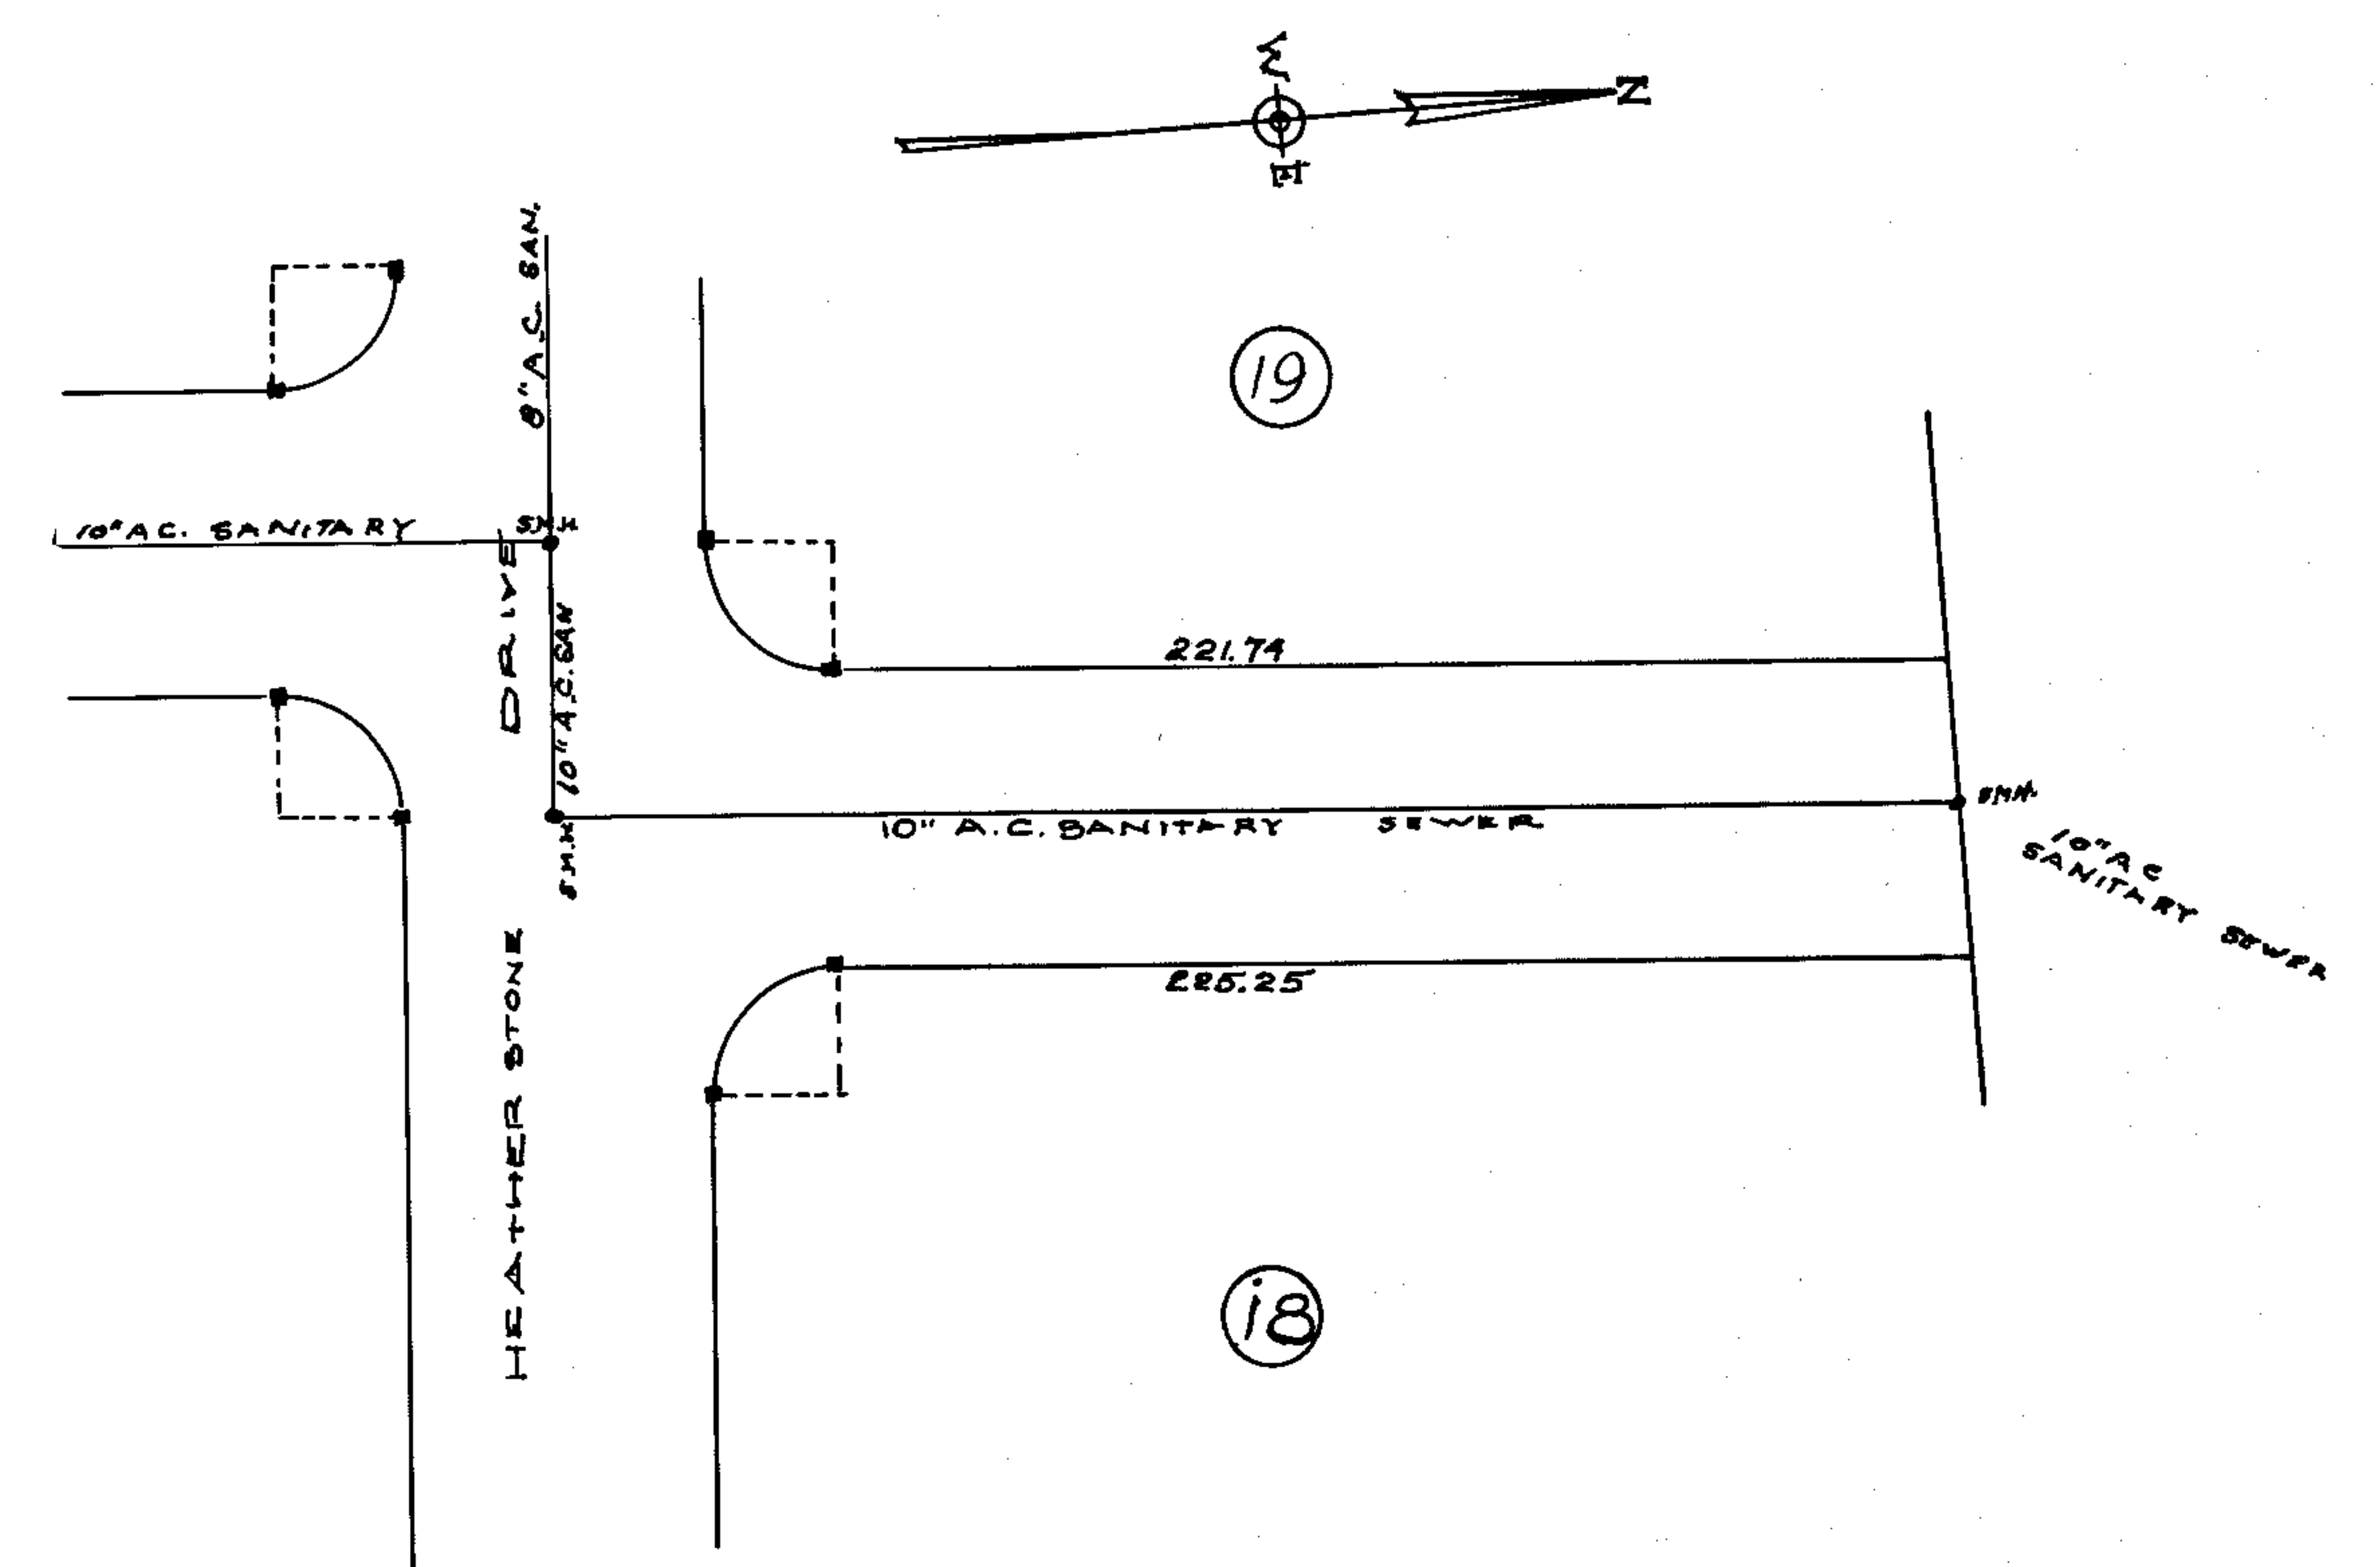
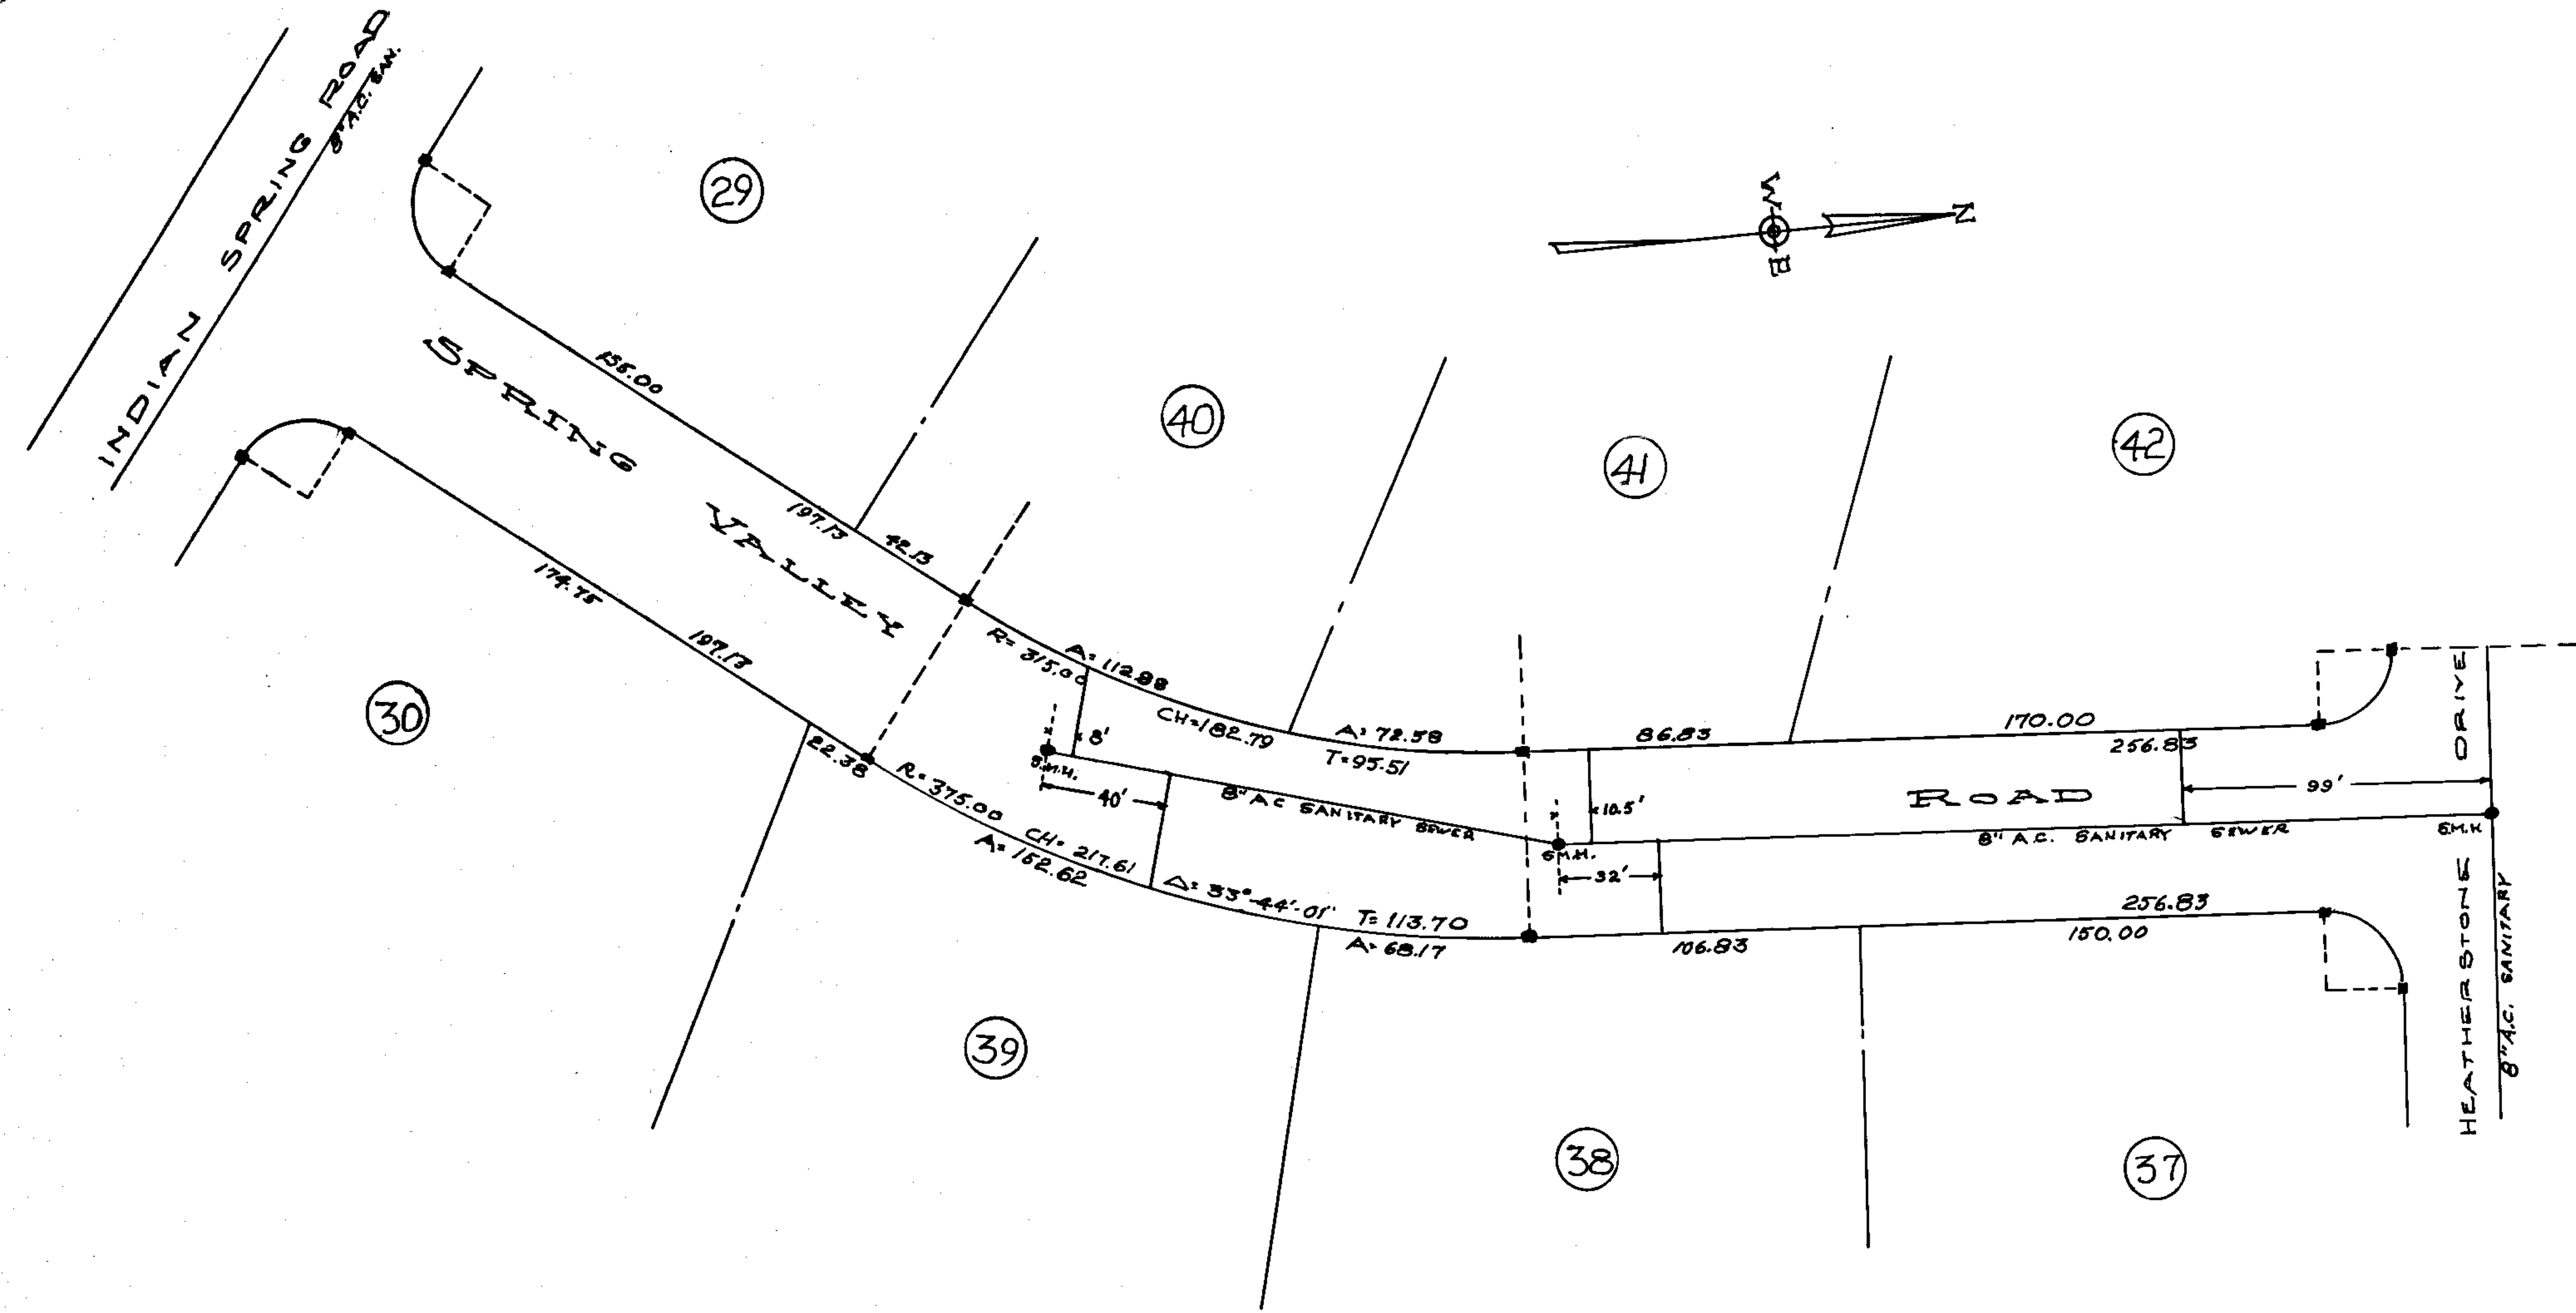


PLAN SHOWING SANITARY SEWER
 SPRING VALLEY ROAD
 DEPT. PUBLIC WORKS A.A. MELIEN
 TOWN OF EAST LONGMEADOW,
 MASS.
 SCALE: 1"=40' HOR.
 1"=4' VER.