


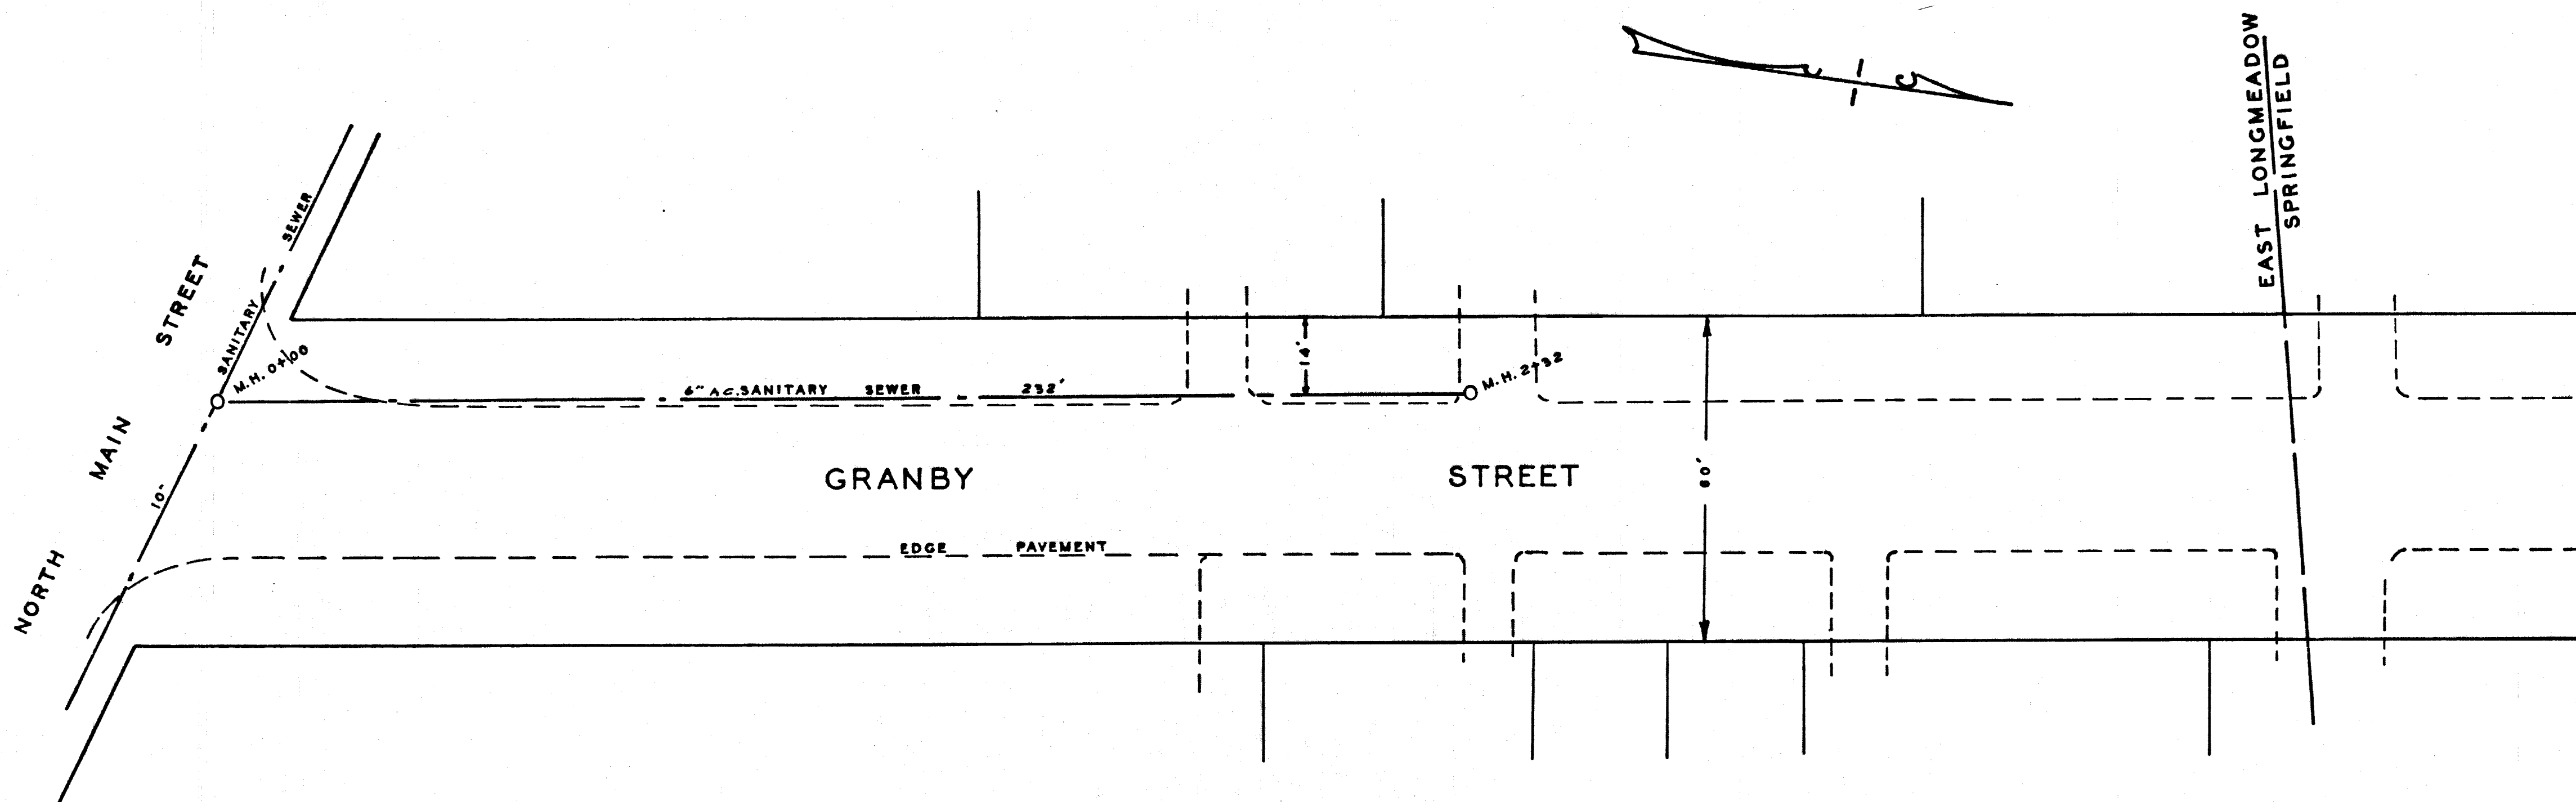

PLAN & PROFILE OF
SANITARY SEWER
GRANBY STREET
EAST LONGMEADOW MASS.
SCALE: 1" = 20' HOR. FEB. 1972
A.A. MELIEN TOWN ENGR.

