



CLARESIDE DRIVE

TERRY LANE

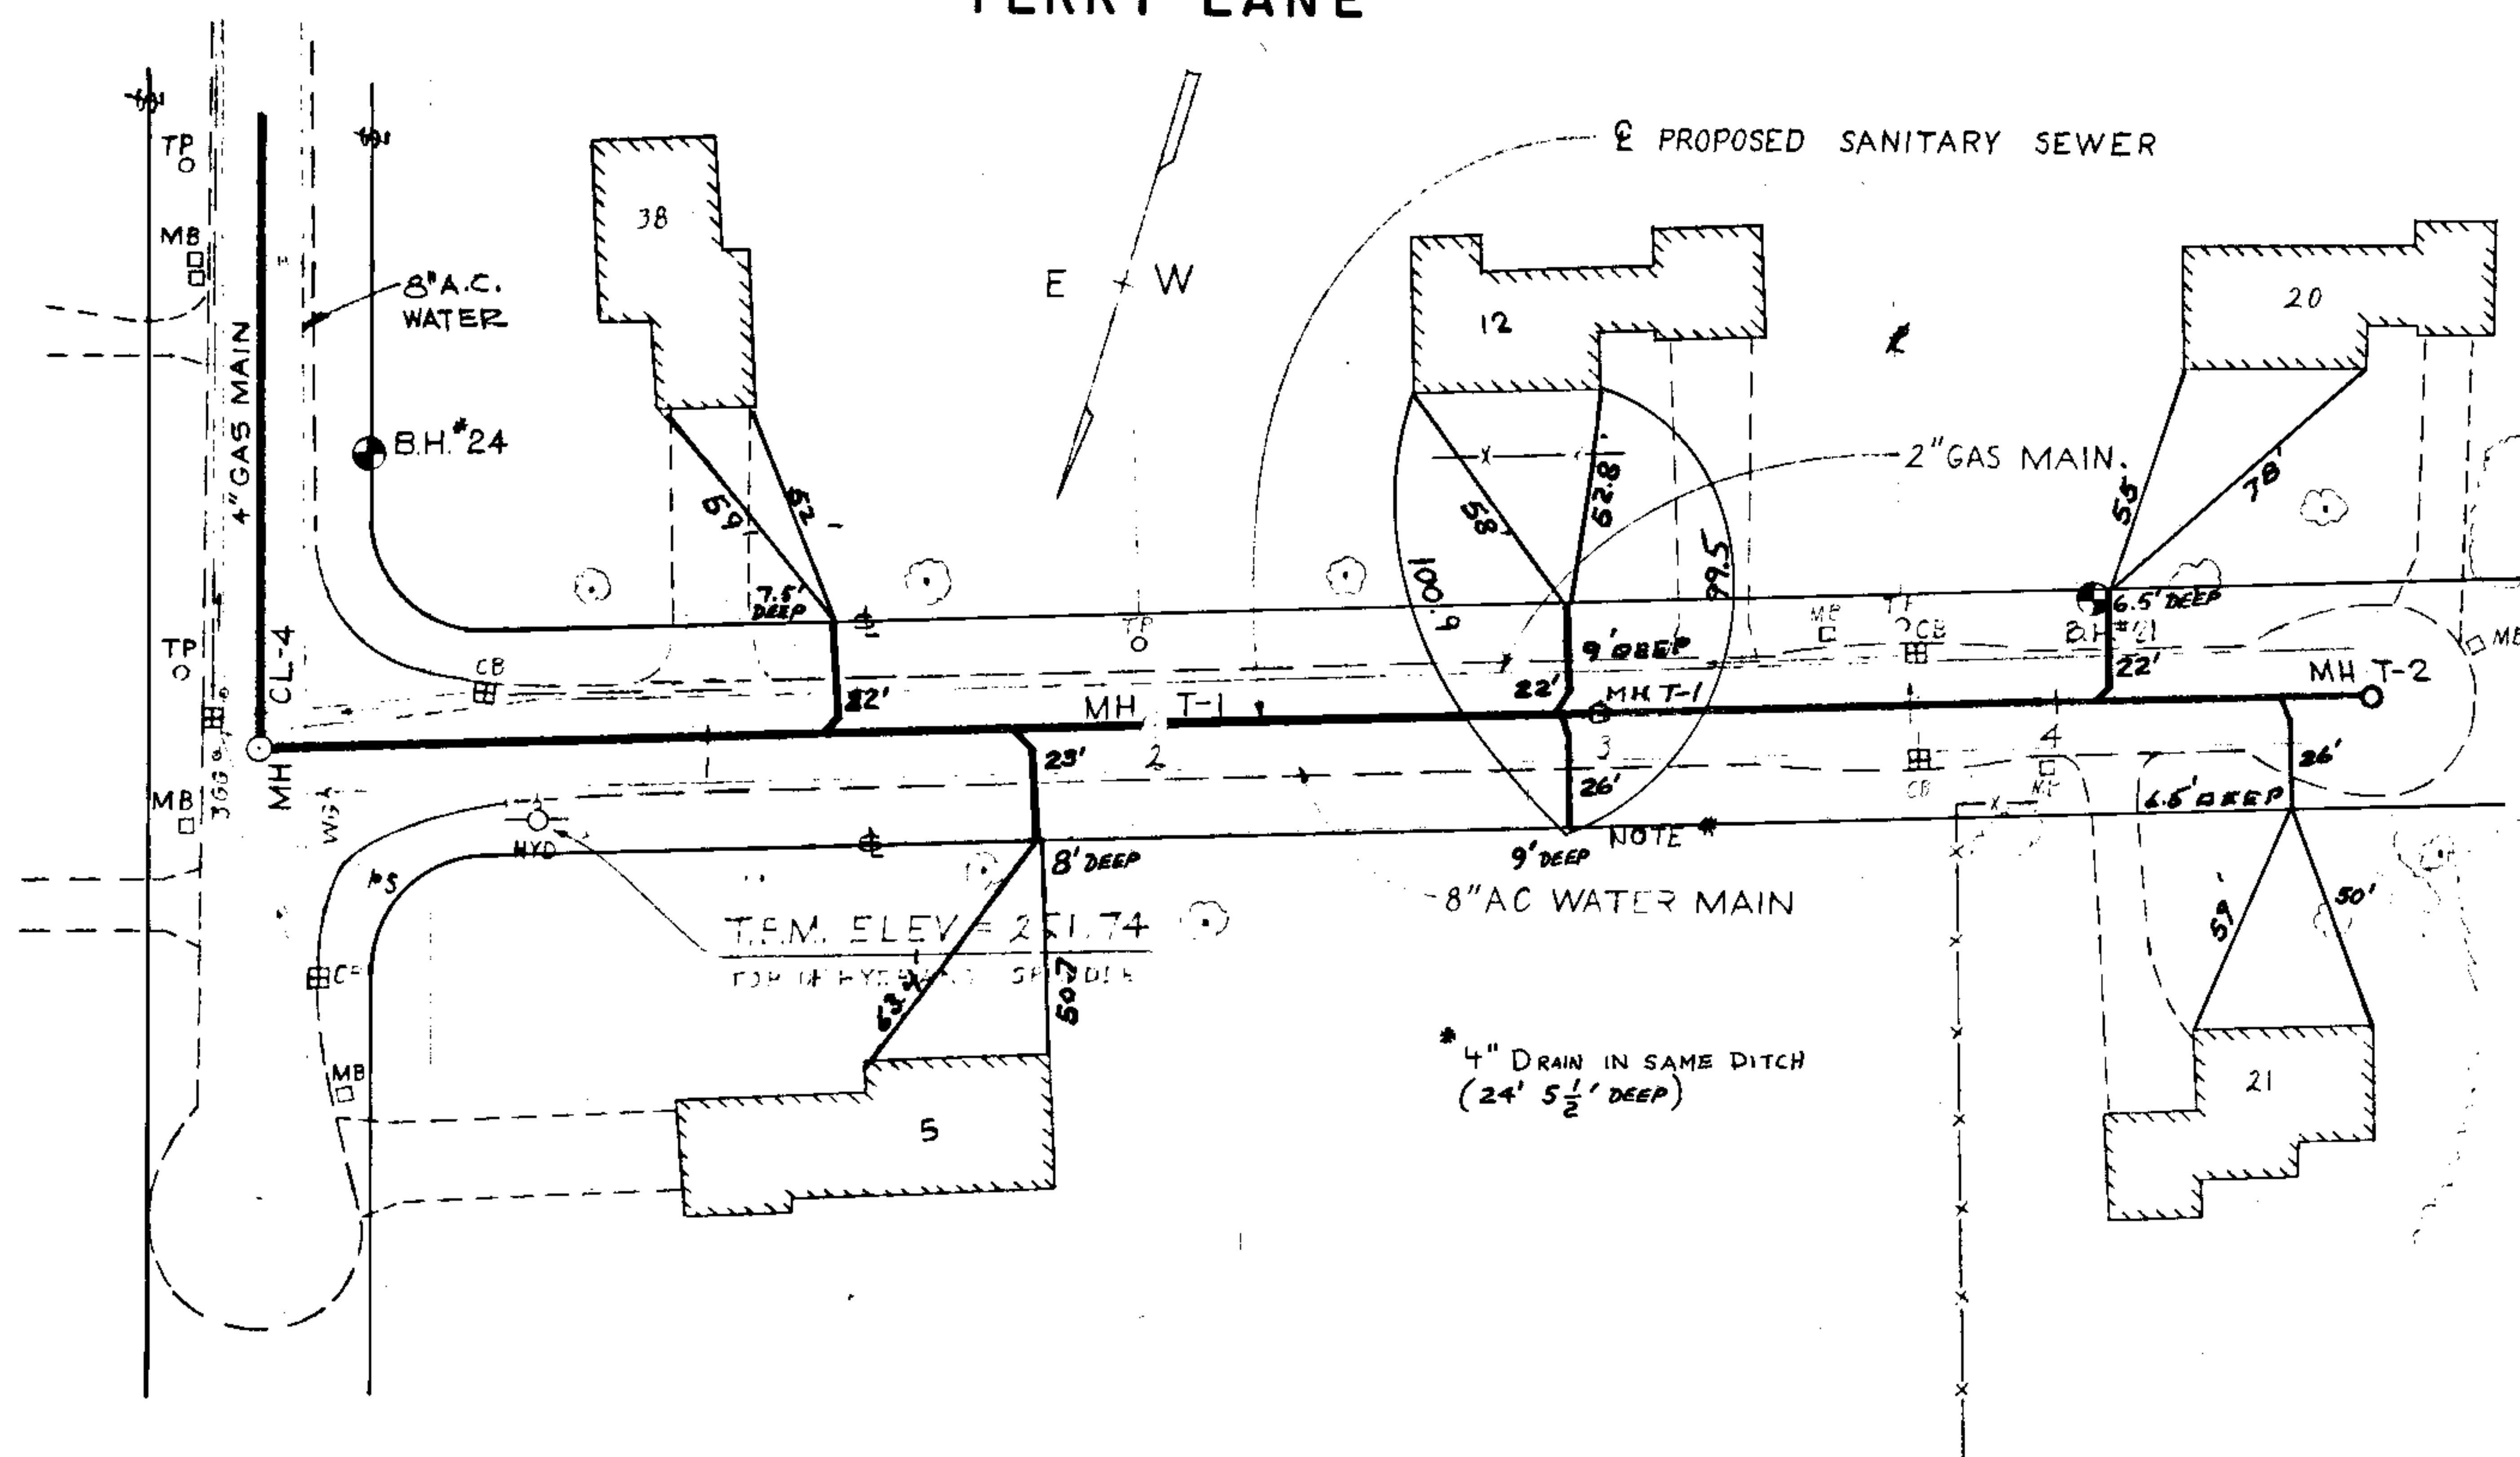


CLARESIDE DRIVE

EDWILL ROAD

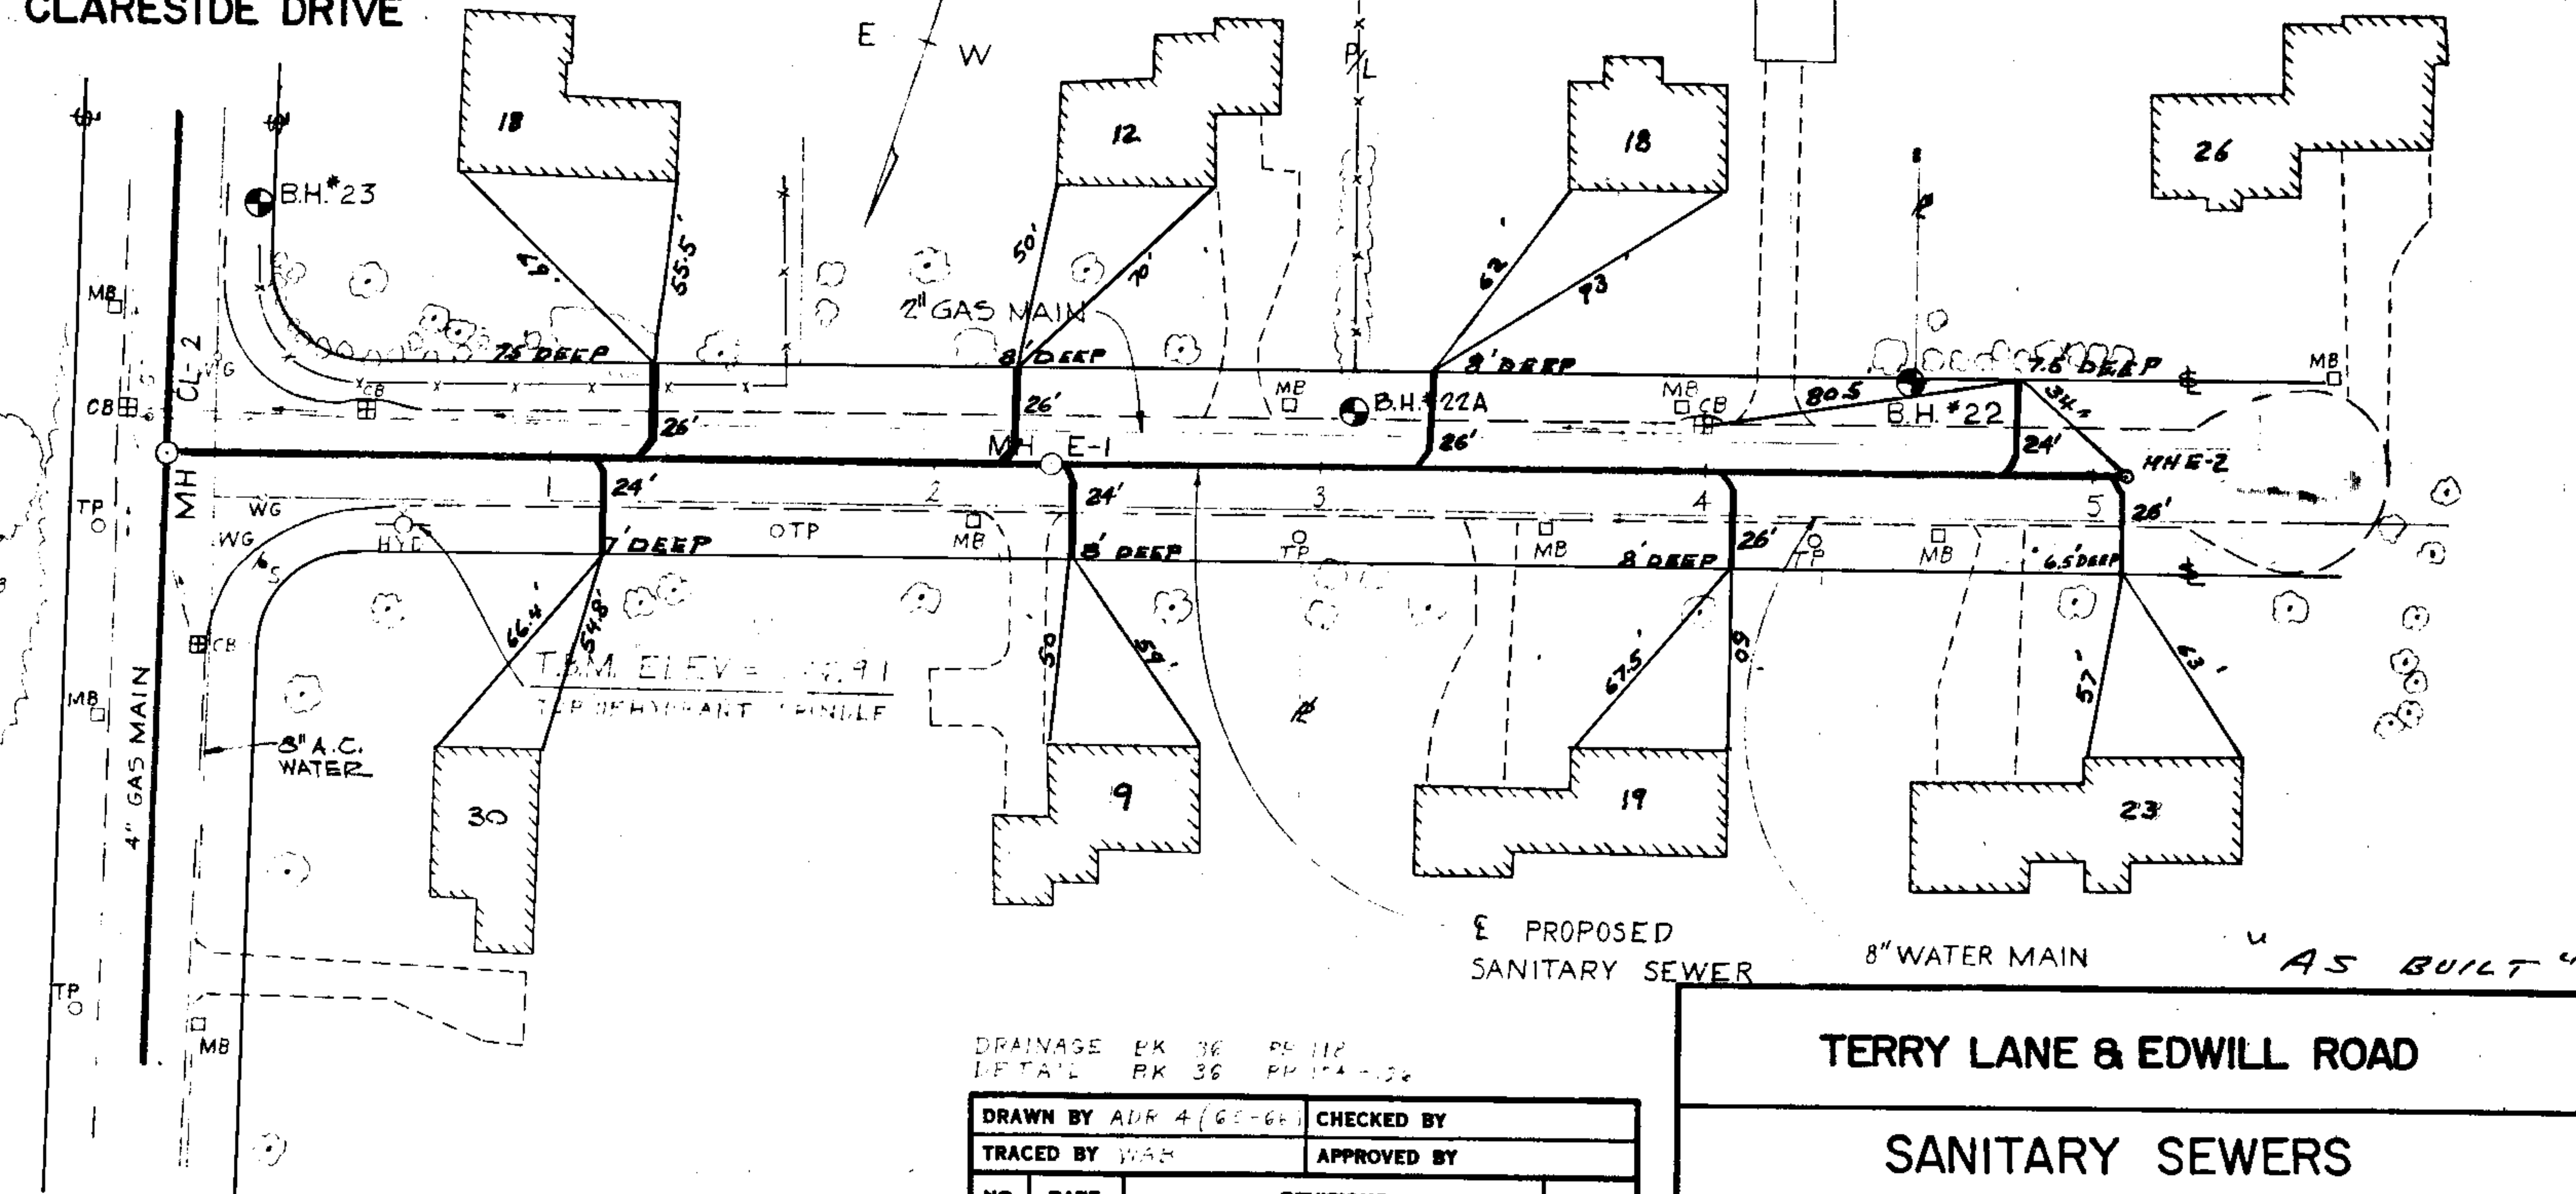DRAINAGE PK 36 PK 36
T.P. 112 PK 36 PK 36

DRAWN BY AUR 4/60-61		CHECKED BY	
TRACED BY WAK		APPROVED BY	
NO.	DATE	REVISIONS	BY
1	5/21/81	LOC. NO. CORR. - RELOC. MH	RJB
2	5/29/81	ADDED R & S SYMBOLS	RJB


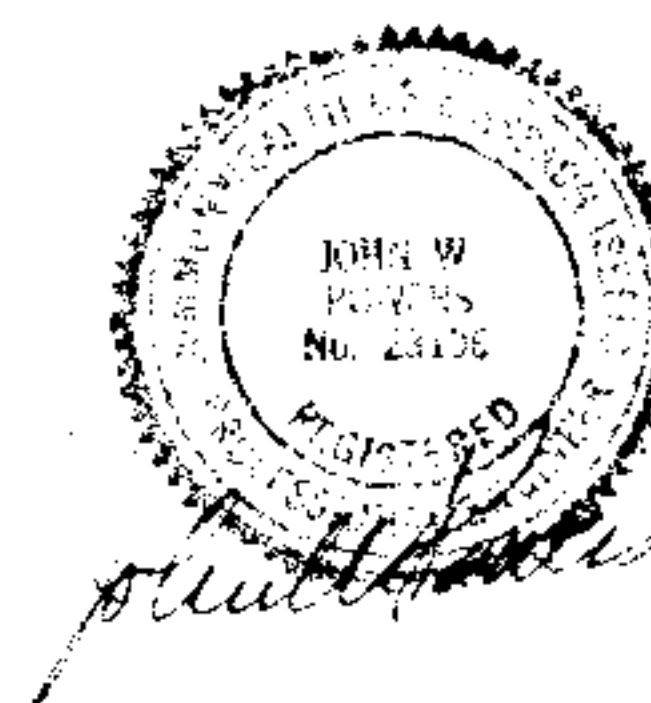


TERRY LANE & EDWILL ROAD

SANITARY SEWERS
BOARD OF PUBLIC WORKS
EAST LONGMEADOW, MASS.

TIGHE & BOND, CONSULTING ENGINEERS
HOLYOKE, MASS.

SCALE: HORIZ. 1"=40'
DATE: JULY, 1977

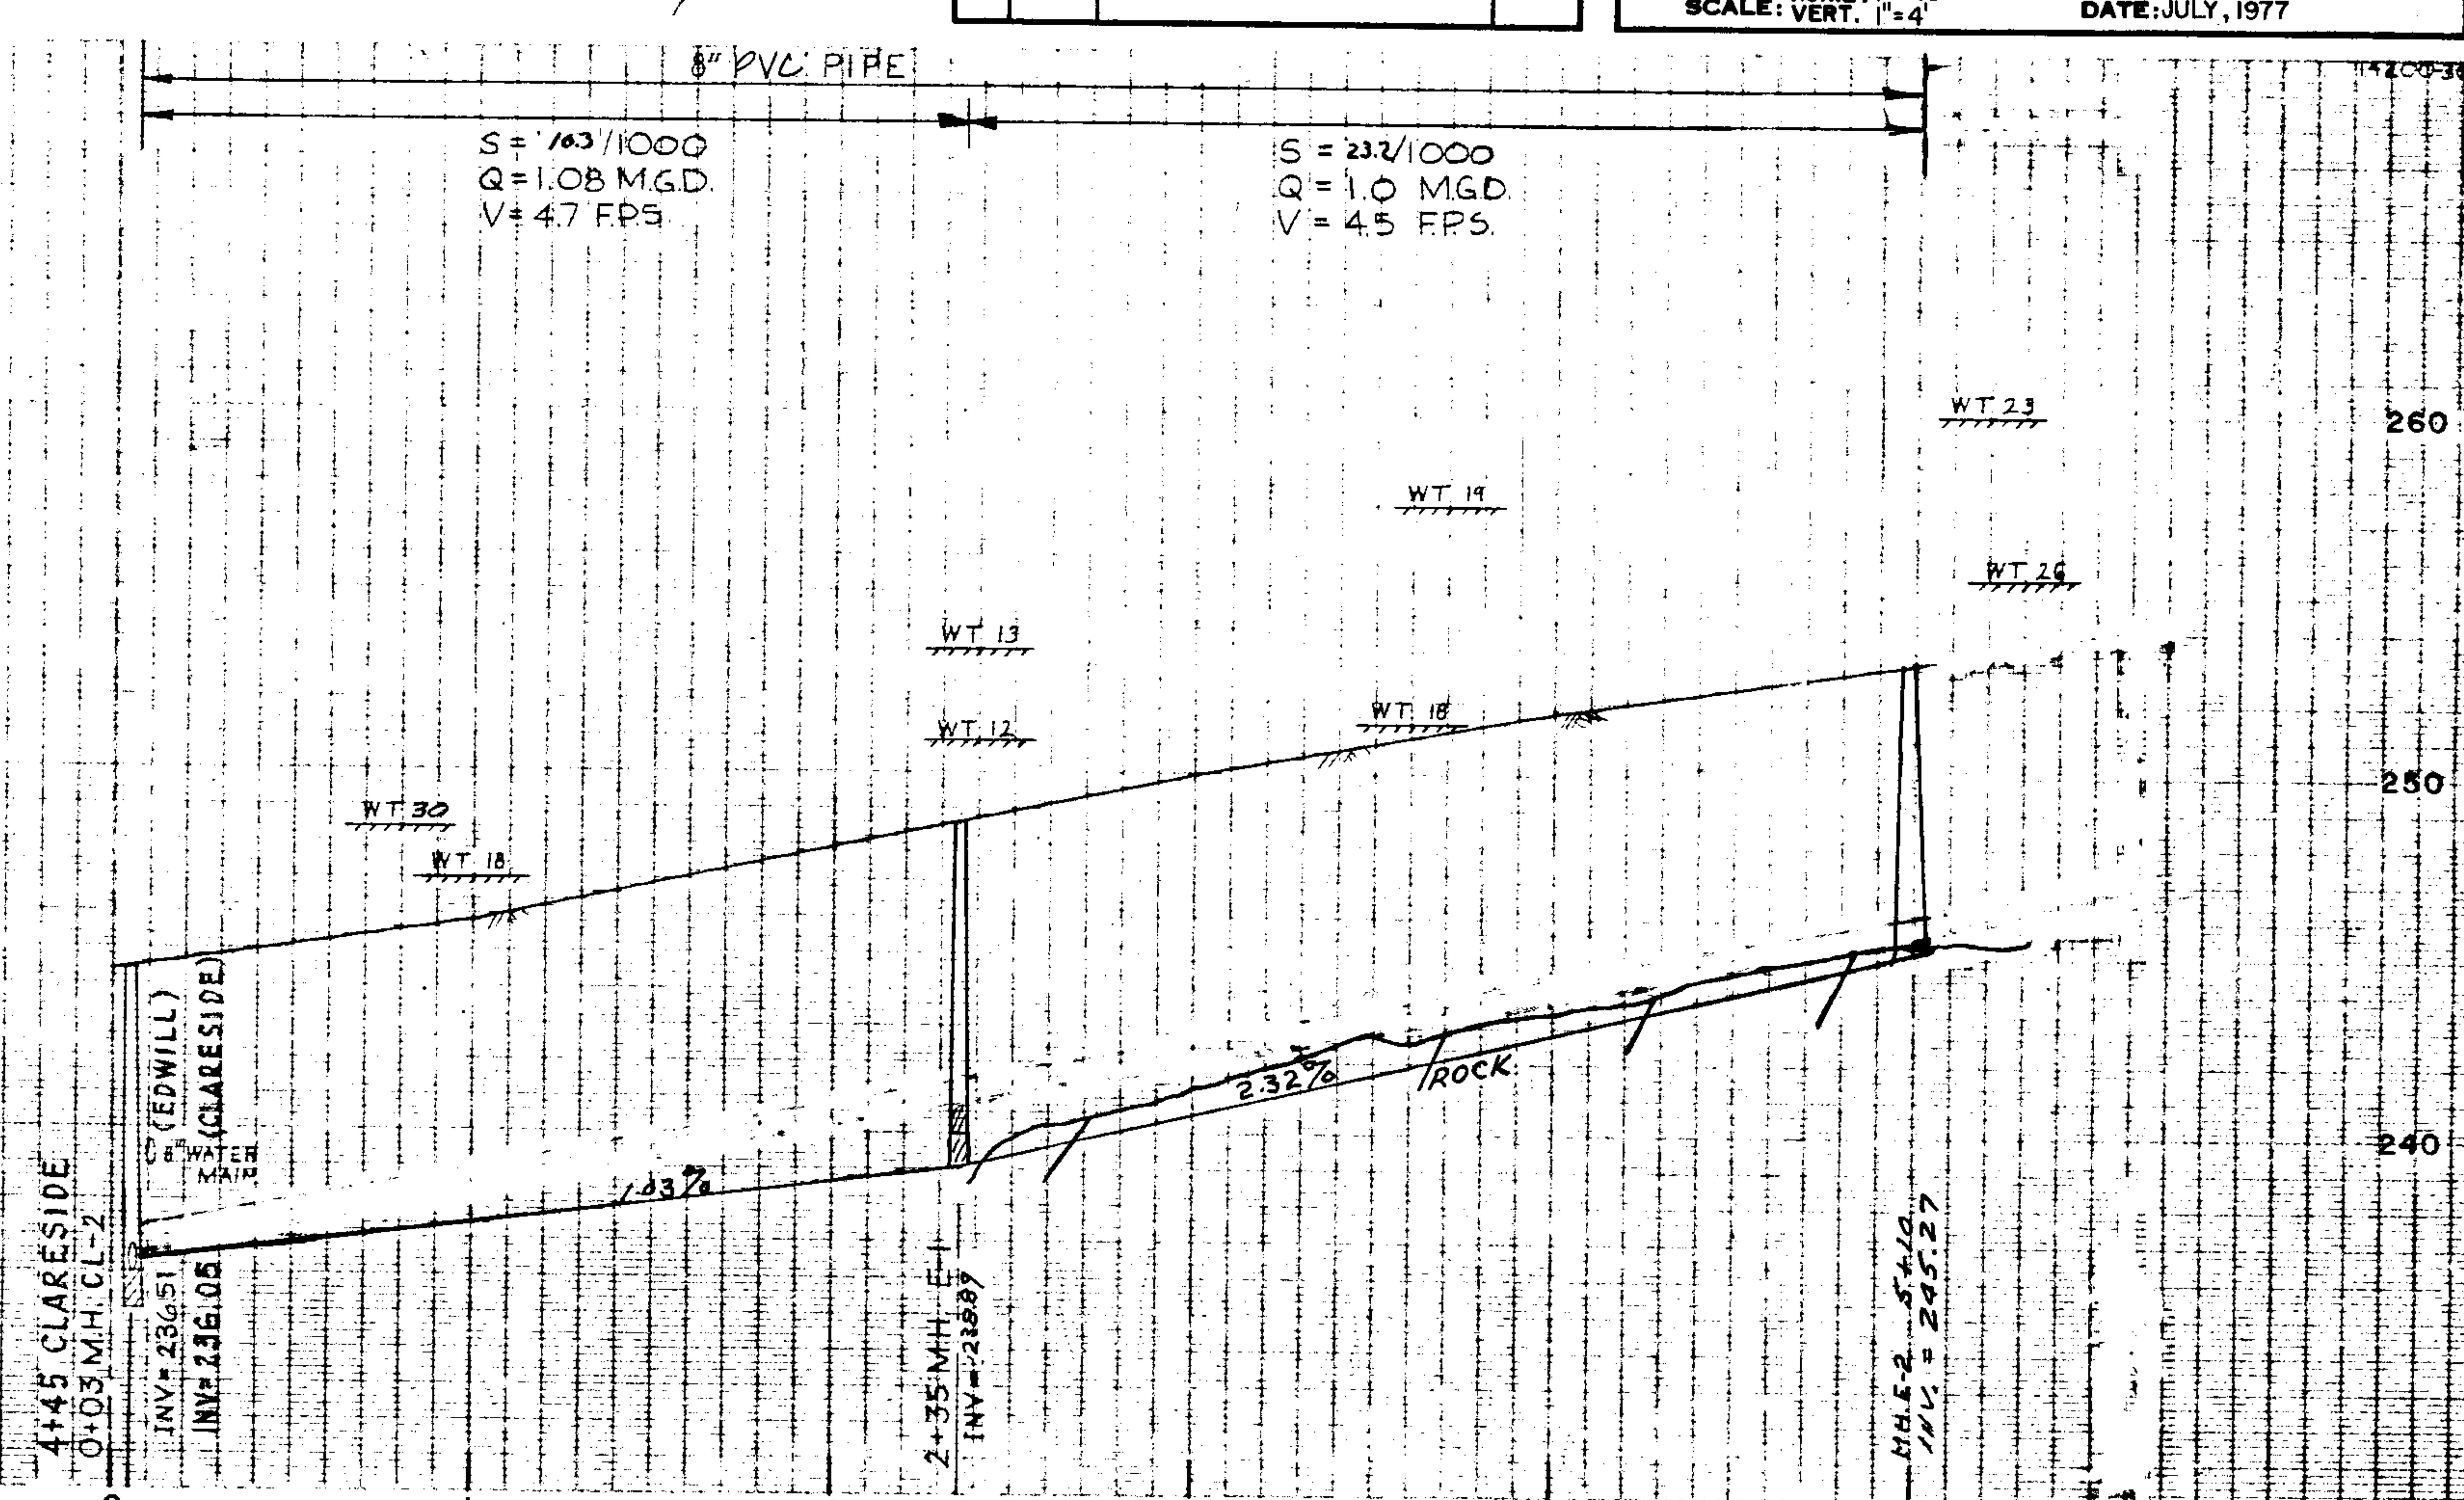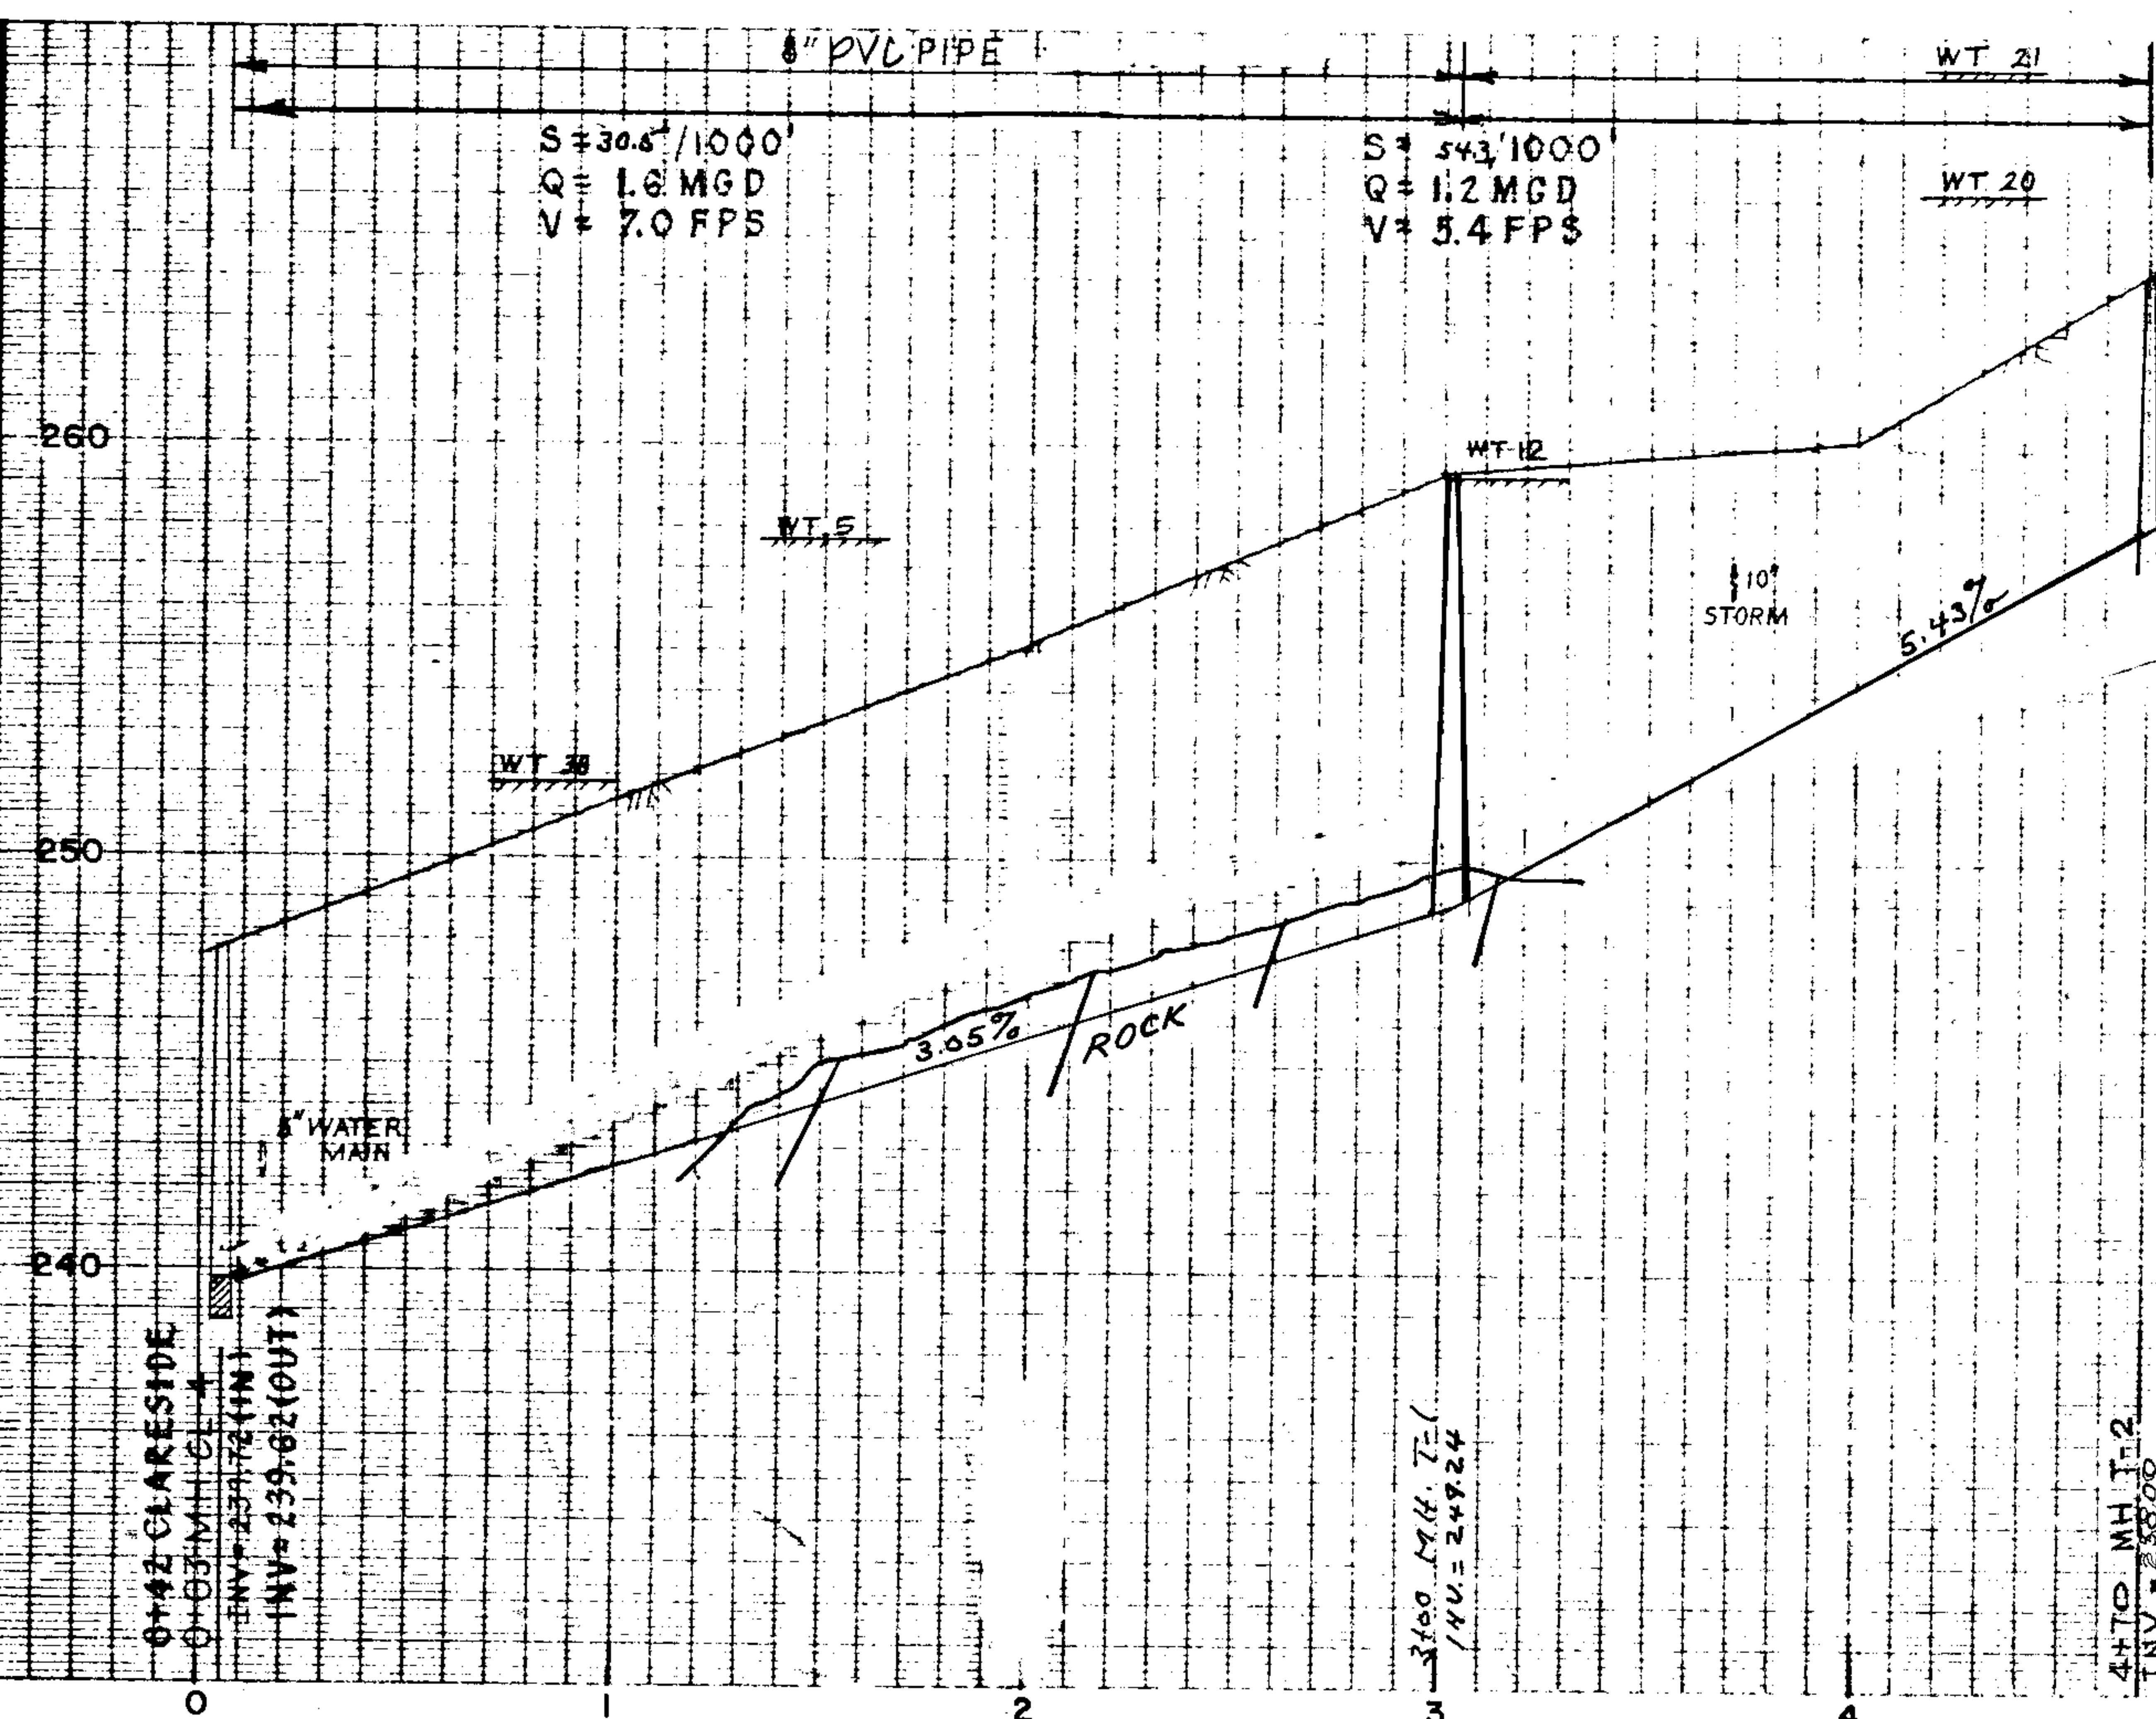

SS-382 (TEI)