

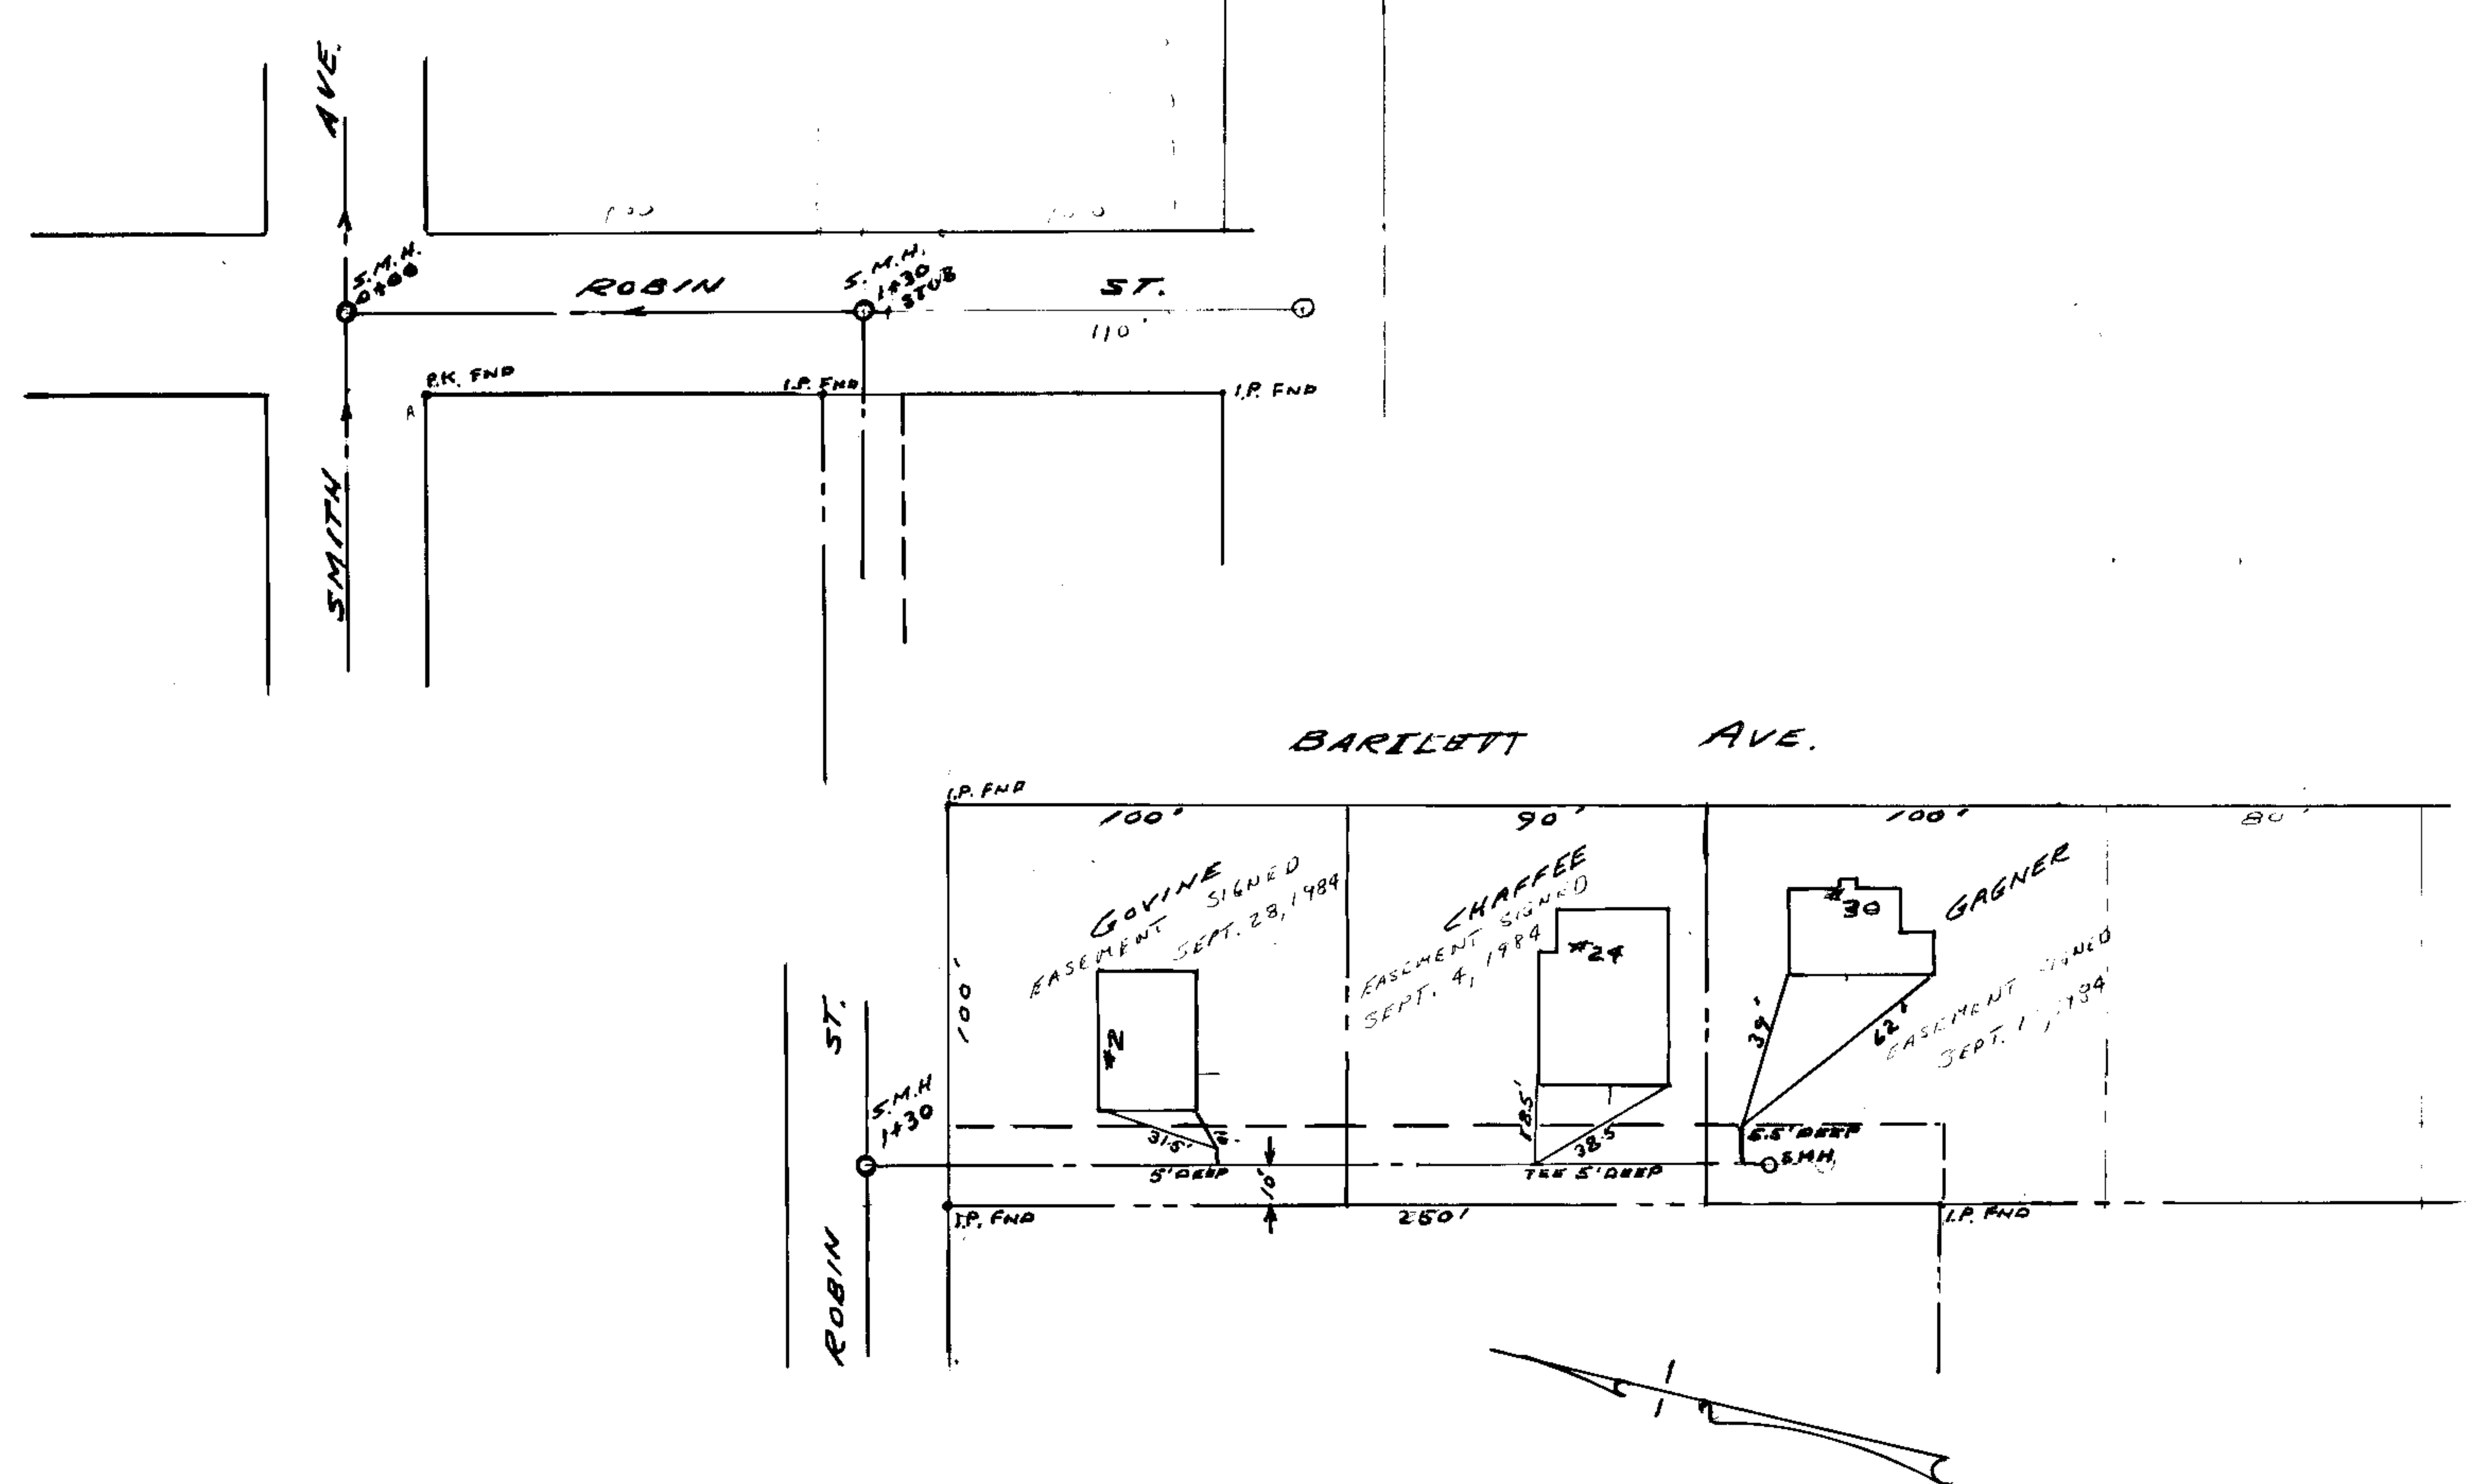


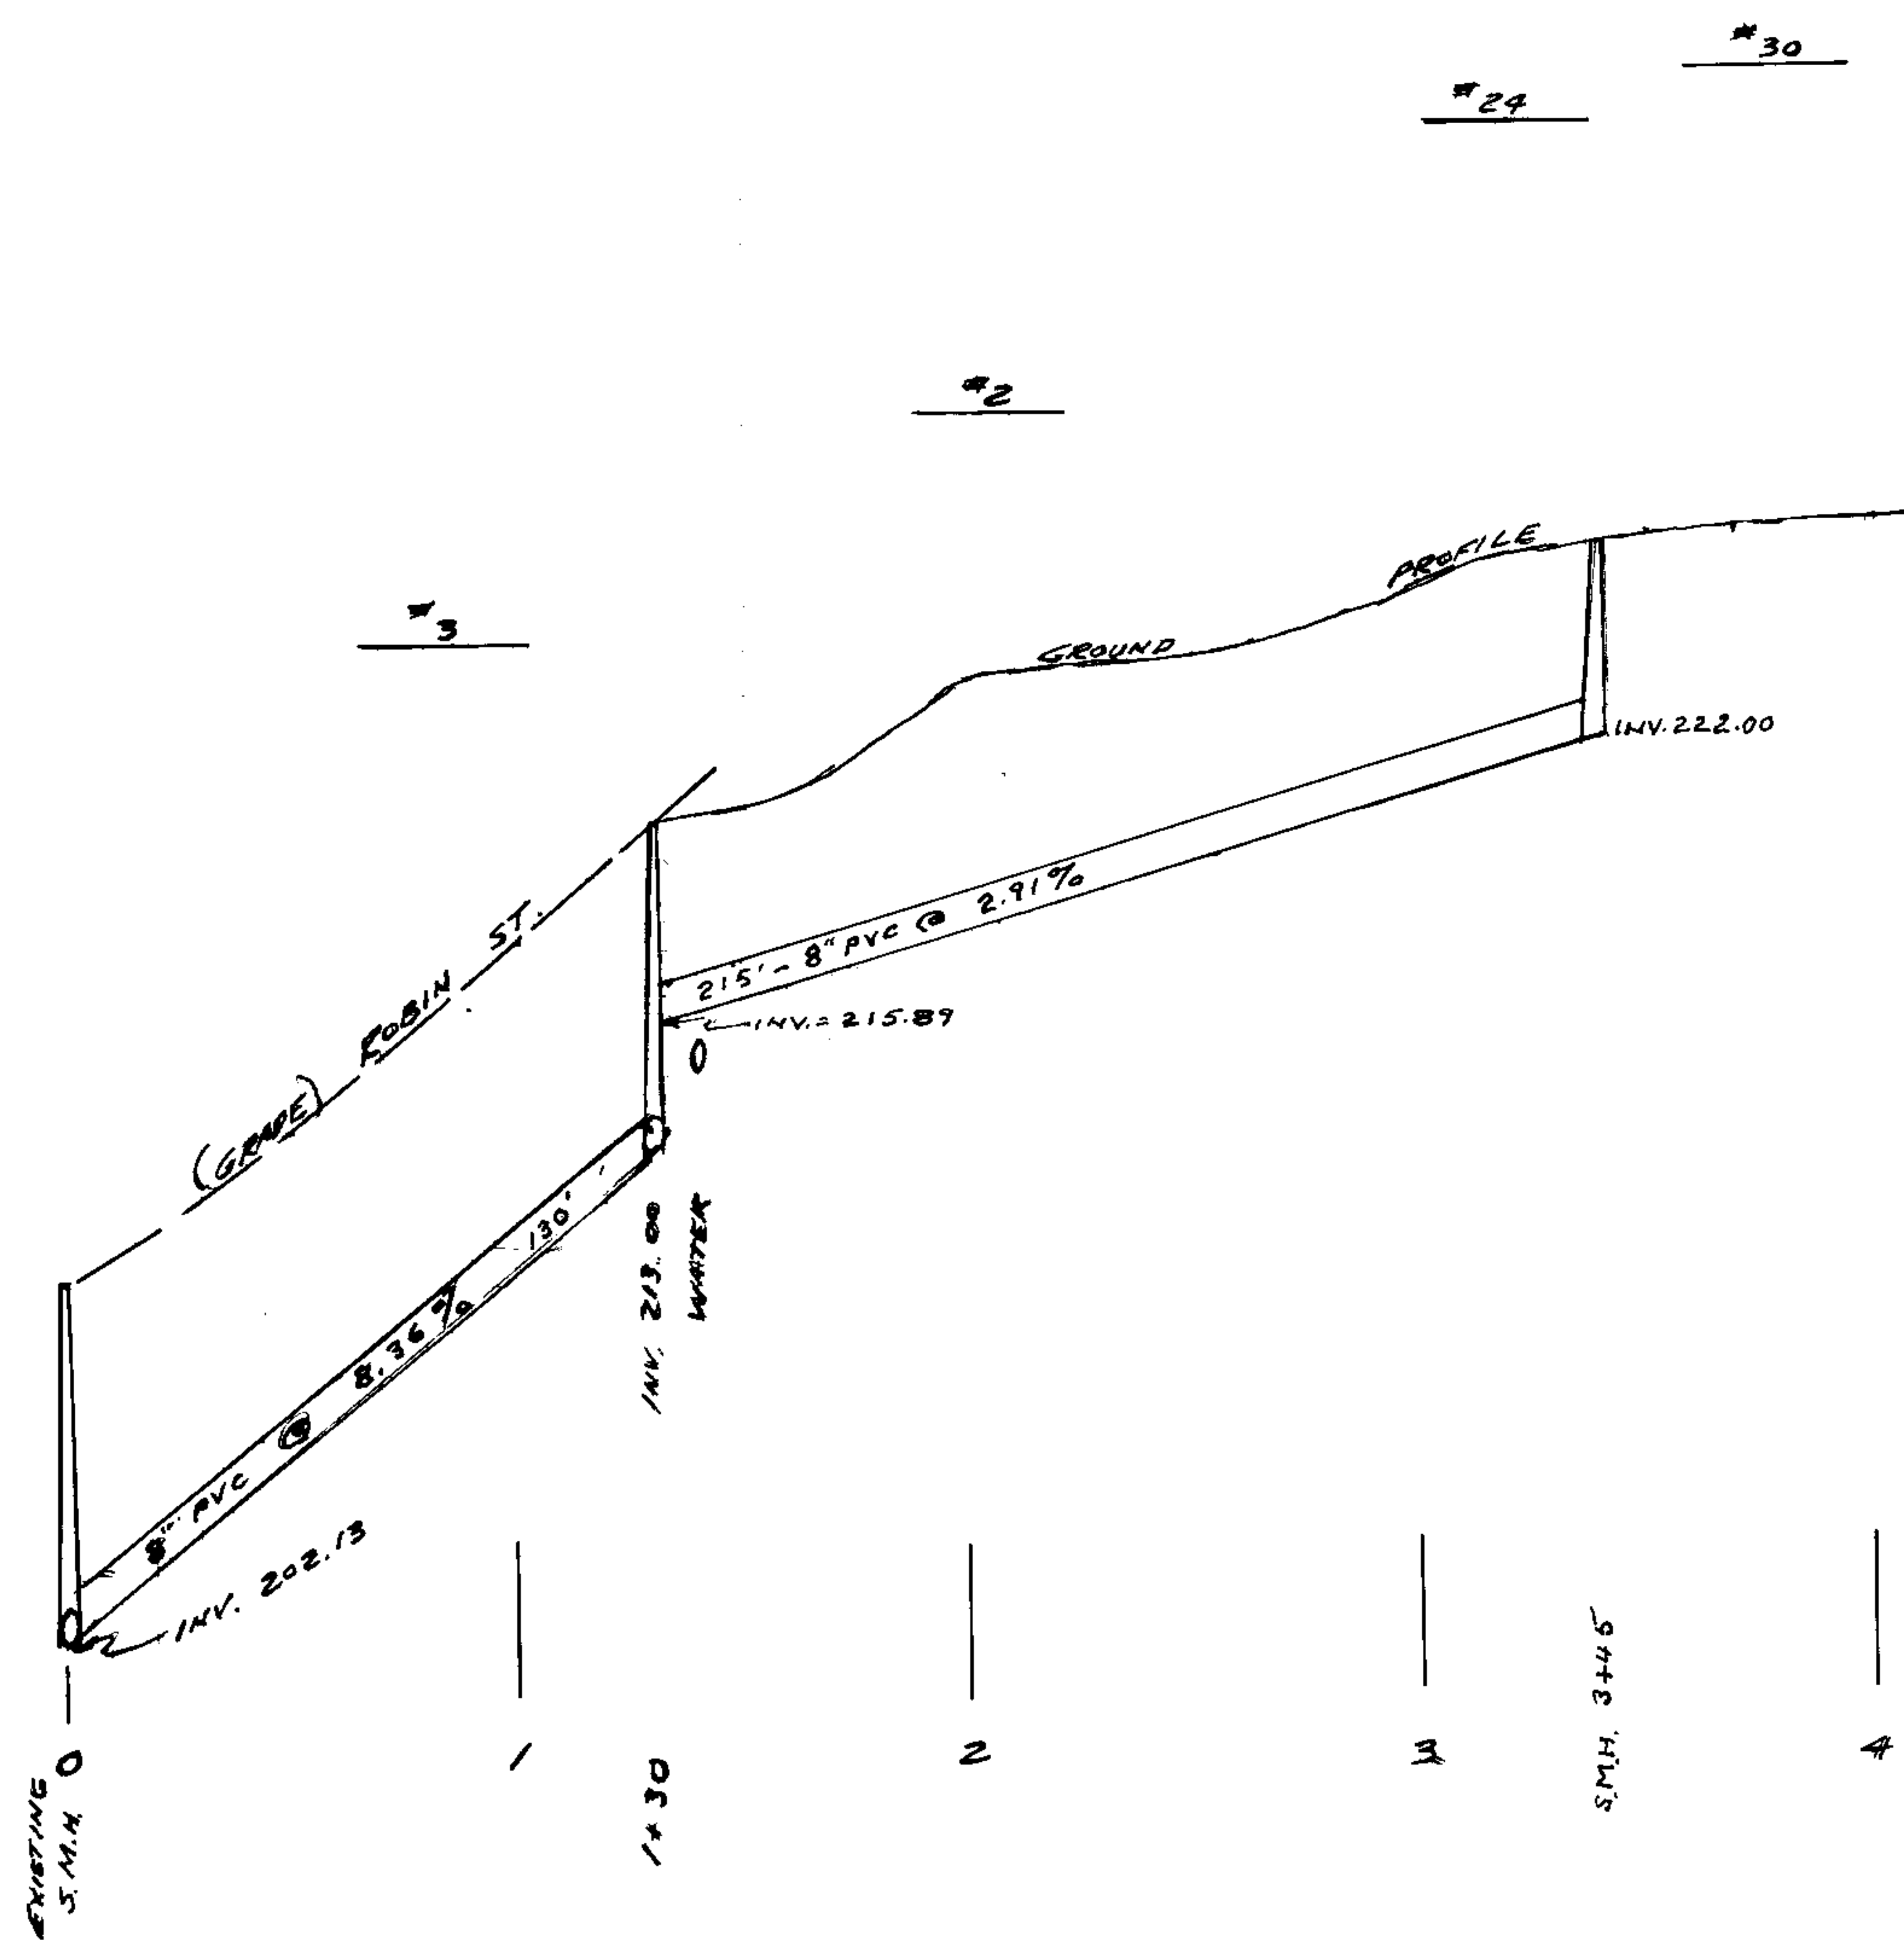

PLAN & PROFILE  
SANITARY SEWER  
ROBIN & BARTLETT AVE.  
EAST LONGMEADOW, MASS.  
SCALE: 1" = 40' HOR. JULY 1984  
A. A. MELIEN TOWN ENGR.

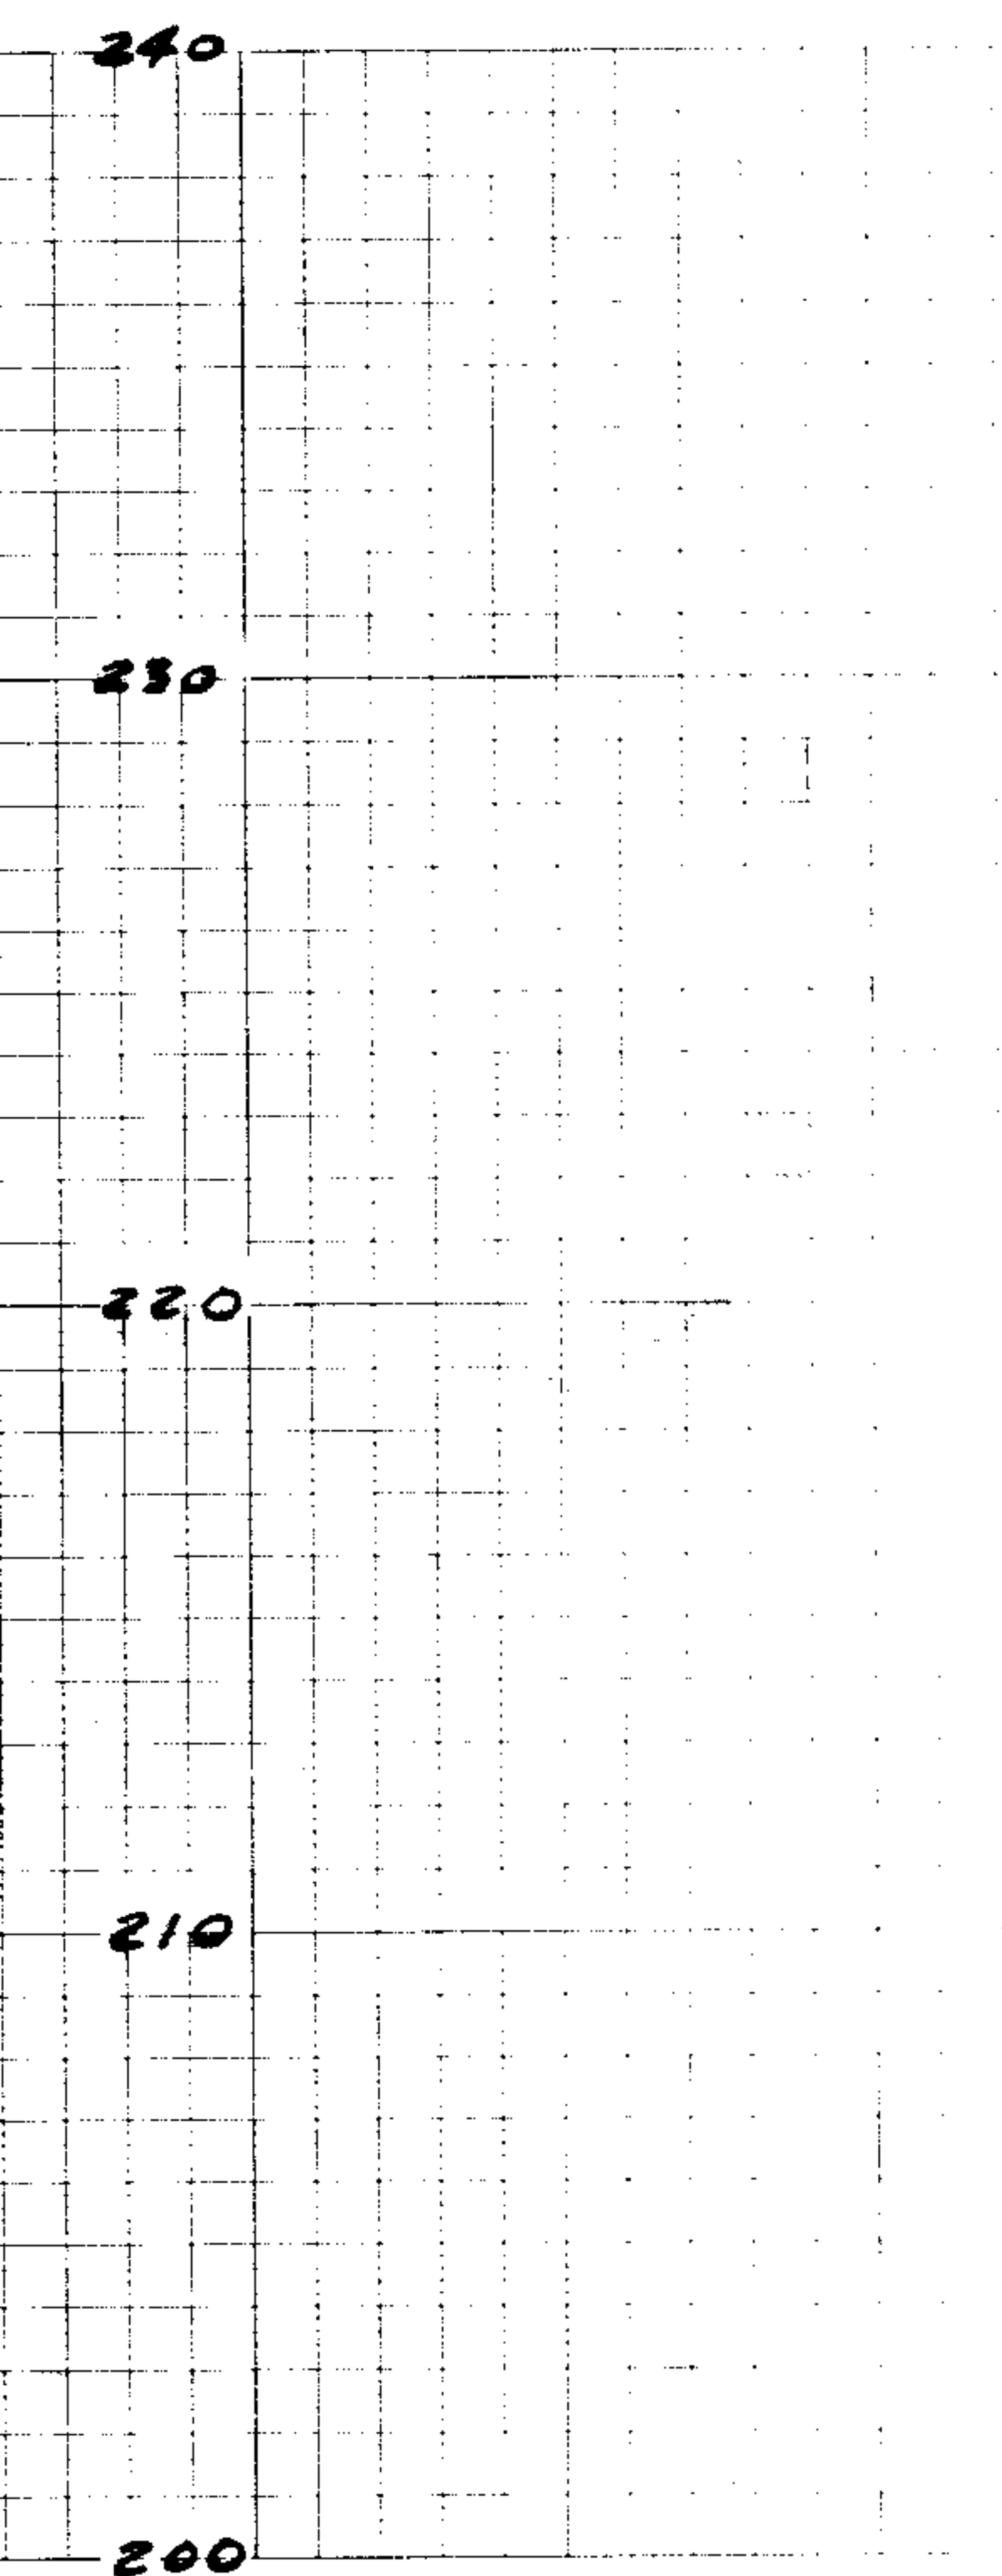

SS-383