


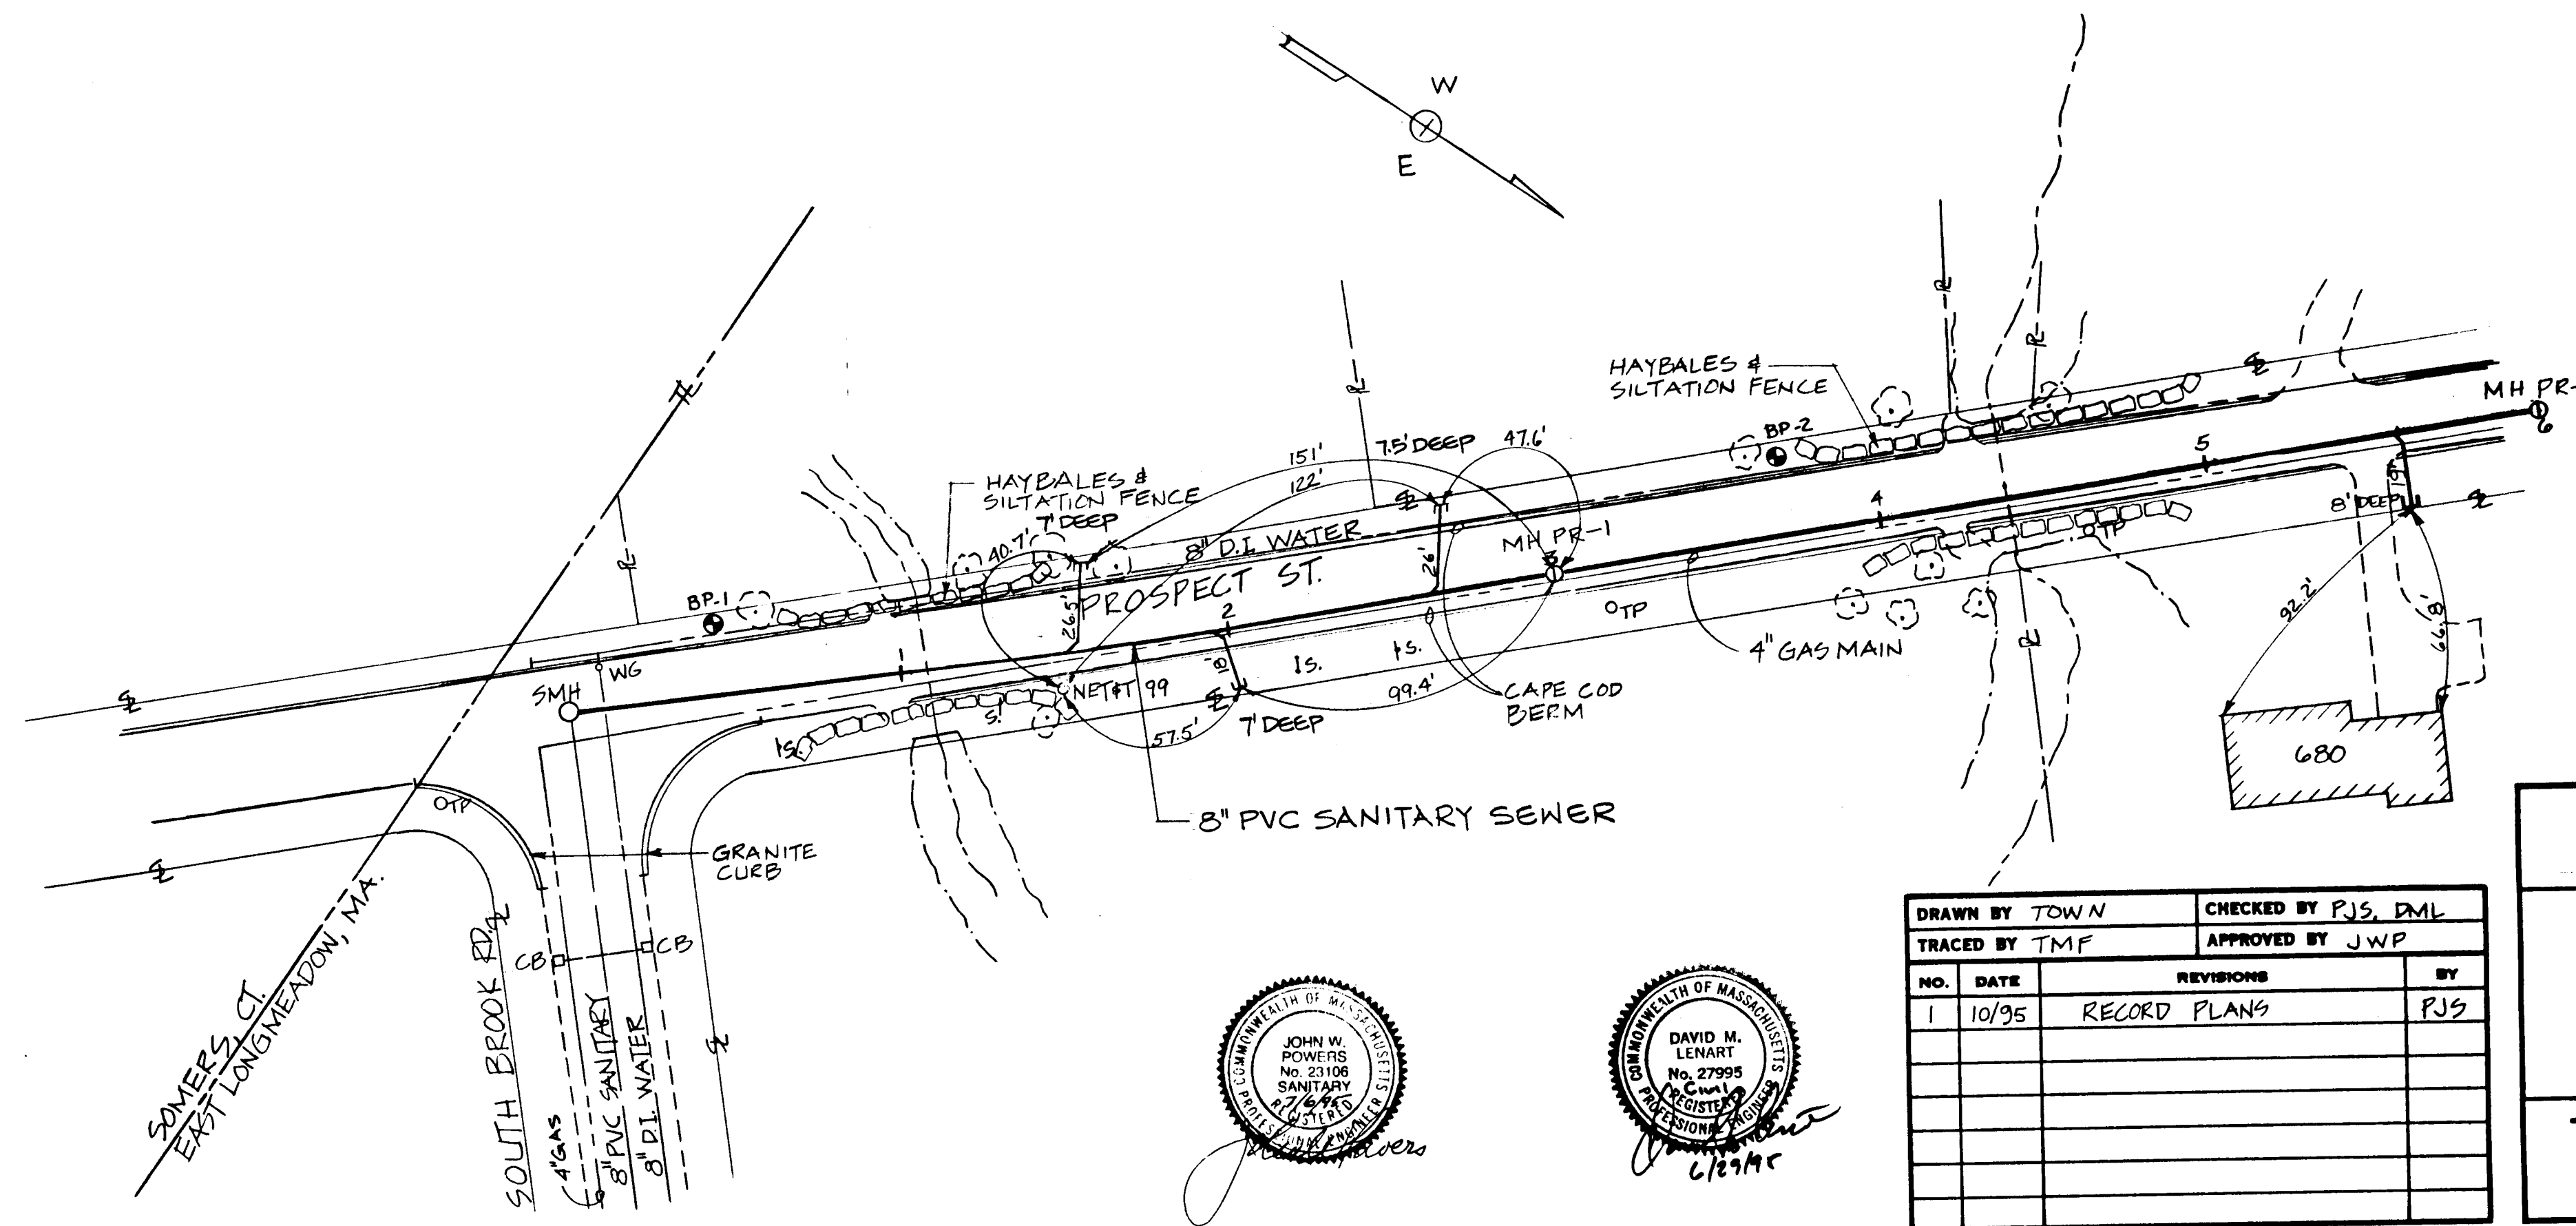

SEE SHEET PR-2


RECORD PLAN

PROSPECT STREET
STA. 0+00 TO STA. 6+00

SANITARY SEWERS
BOARD OF PUBLIC WORKS
EAST LONGMEADOW, MASS.

TIGHE & BORD, CONSULTING ENGINEERS
WESTFIELD, MASS.
SCALE: HORIZ. 1" = 40'
VERT. 1" = 4'
DATE: JUNE 1995

DRAWN BY TOWN		CHECKED BY PJS, DML	
TRACED BY TMF		APPROVED BY JWP	
NO.	DATE	REVISIONS	BY
1	10/95	RECORD PLANS	PJS

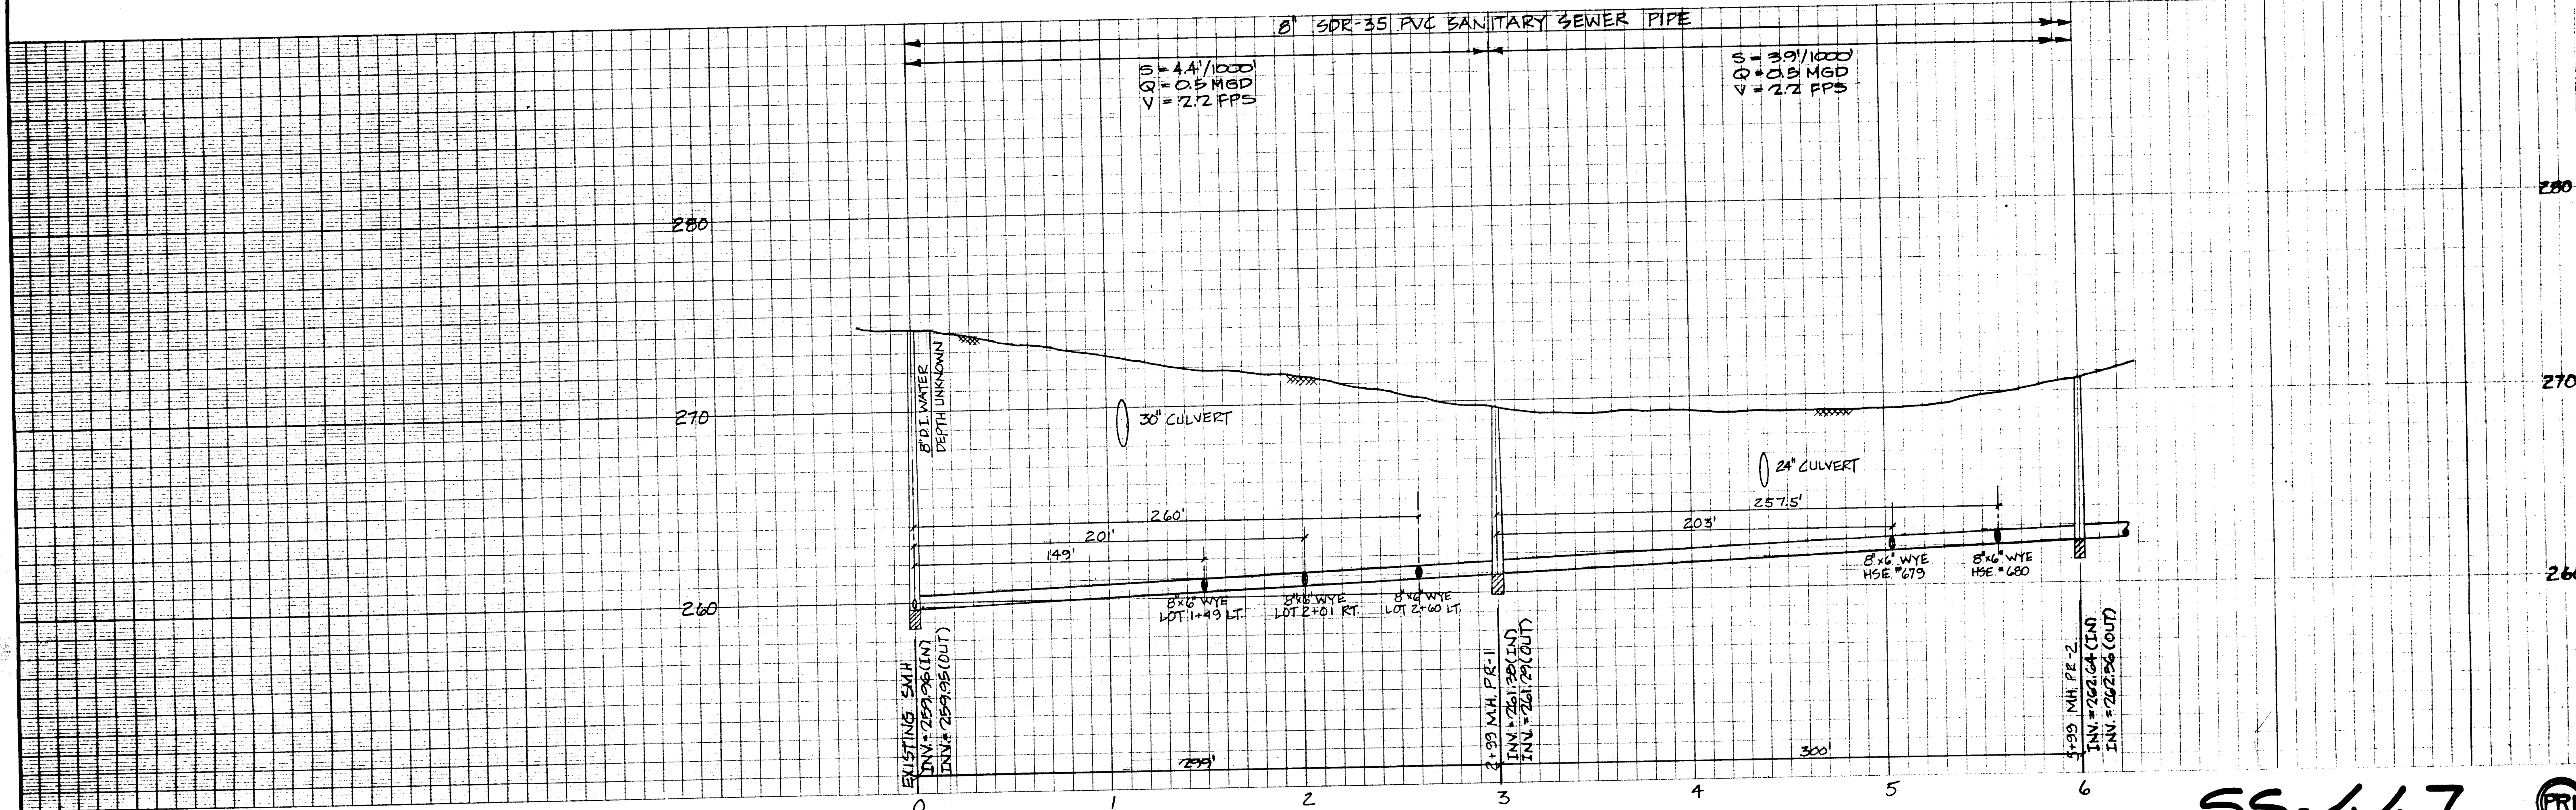

SS-447

