


SEE SHEET NO. PR-3

PROSPECT STREET

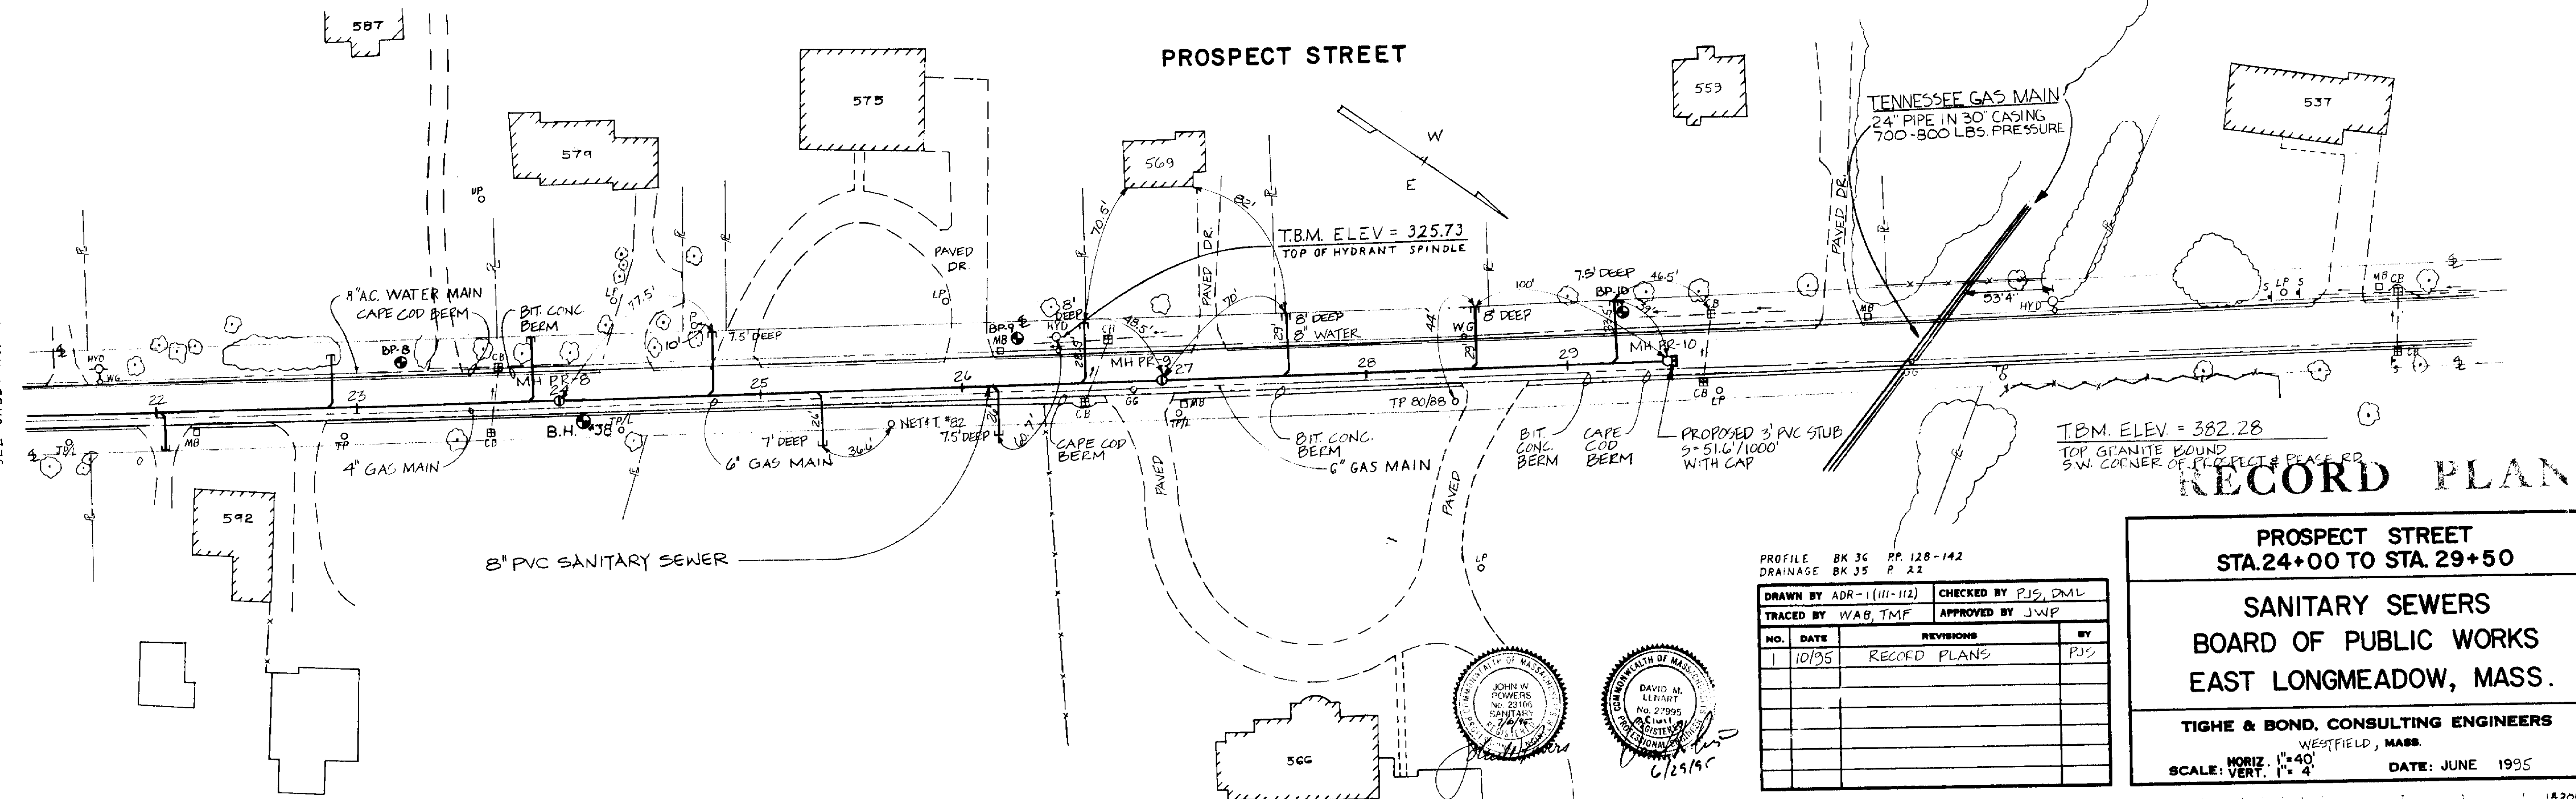

PROFILE BK 36 PP. 128-142
DRAINAGE BK 35 P. 22

DRAWN BY ADR-1 (111-112)		CHECKED BY PJS, DML	
TRACED BY WAB, TMF		APPROVED BY JWP	
NO.	DATE	REVISIONS	BY
1	10/95	RECORD PLANS	PJS


PROSPECT STREET
STA. 24+00 TO STA. 29+50

SANITARY SEWERS
BOARD OF PUBLIC WORKS
EAST LONGMEADOW, MASS.

TIGHE & BOND, CONSULTING ENGINEERS
WESTFIELD, MASS.

HORIZ. 1"=40'
SCALE: VERT. 1"=4'
DATE: JUNE 1995

8" SDR-35 PVC SANITARY SEWER PIPE

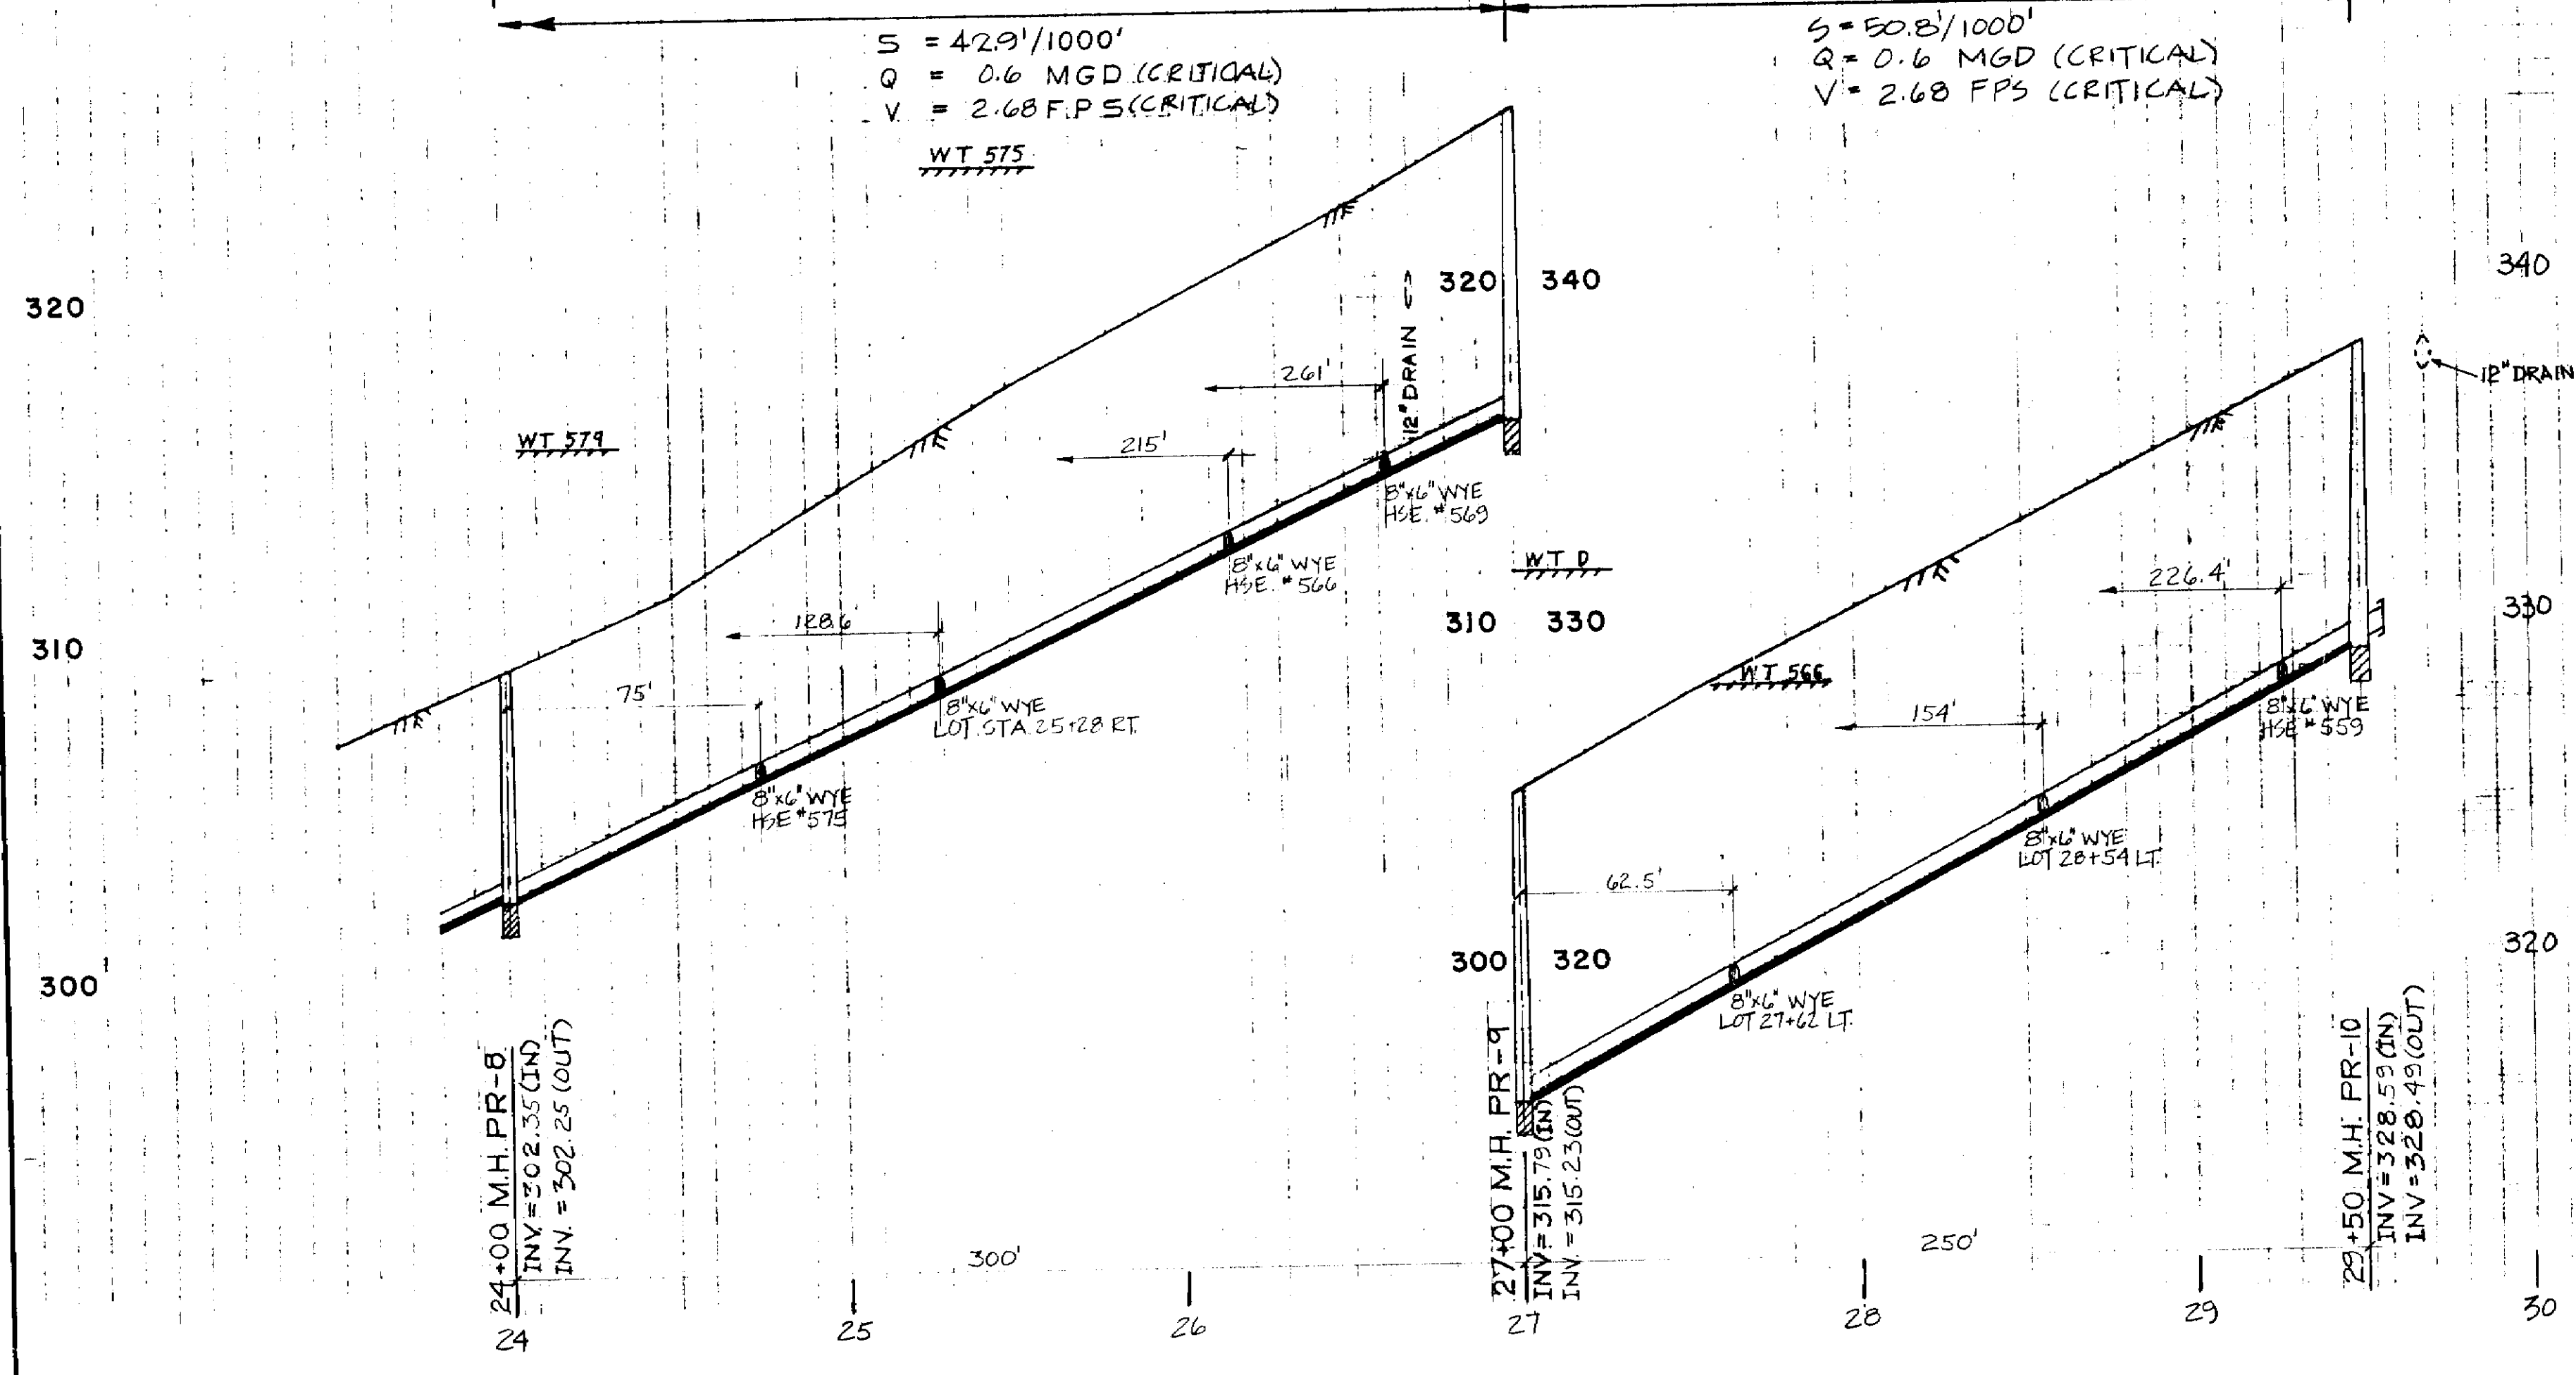

14200-36

