




ECOTEC ENVIRONMENTAL ASSOCIATES INC.
180 DENLOW ROAD
P.O. BOX 168
EAST LONGMEADOW, MA 01028
PHONE (413) 525-8703 FAX (413) 525-9082
DATE: MARCH 2000
CHECKED BY: G.W.
PROJECT NO. 99-074
FILE NAME: ROUTE 83

PROPOSED SANITARY SEWER
FROM
SOMERS ROAD
FOR THE
EAST LONGMEADOW, MA
GLEN HEATHER LANE TO AINSIE DRIVE

SHEET 3 OF 10
REVISED: 3/28/00

BENCHMARKS
1.) TOP FRONT BOLT ON HYDRANT CAP LOCATED ON THE ELY SIDE
OF SOMERS ROAD AT THE SOMERS ROAD AND GLEN HEATHER
LANE INTERSECTION. ELEV = 249.78
2.) TOP OF HYDRANT SPINDLE LOCATED ON THE ELY SIDE OF SOMERS
ROAD AT THE SOMERS ROAD AND AINSIE DRIVE INTERSECTION.
ELEV = 257.48

NOTES
1.) CONTRACTOR TO NOTIFY "BIG SAFE" IN ACCORDANCE WITH M.G.L.
2.) UTILITY POLES TO BE HELD BACK DURING TRENCH EXCAVATION.
3.) ALL BACKFILL FOR CONNECTIONS CROSSING ROAD TO BE CONT.
ROLLED DENSITY FILL.

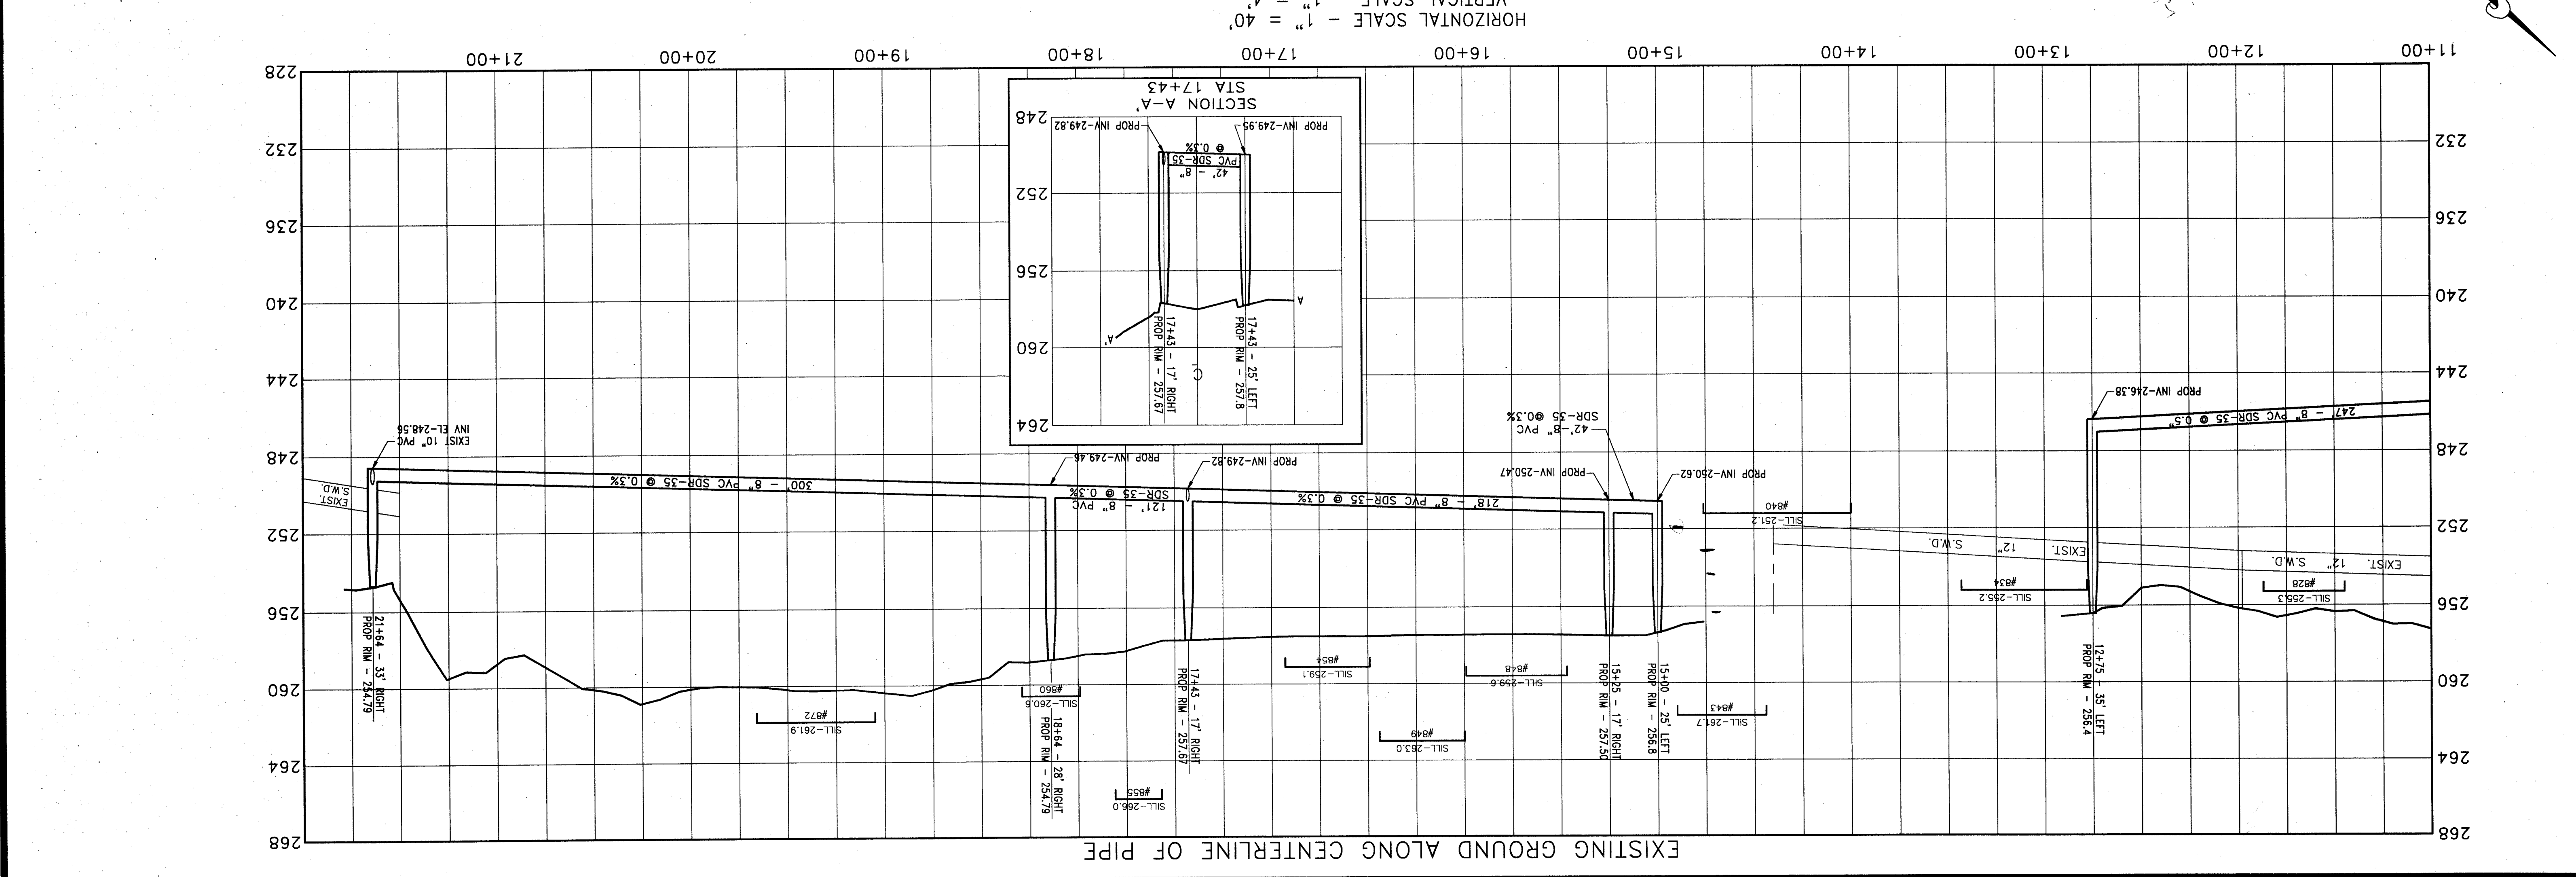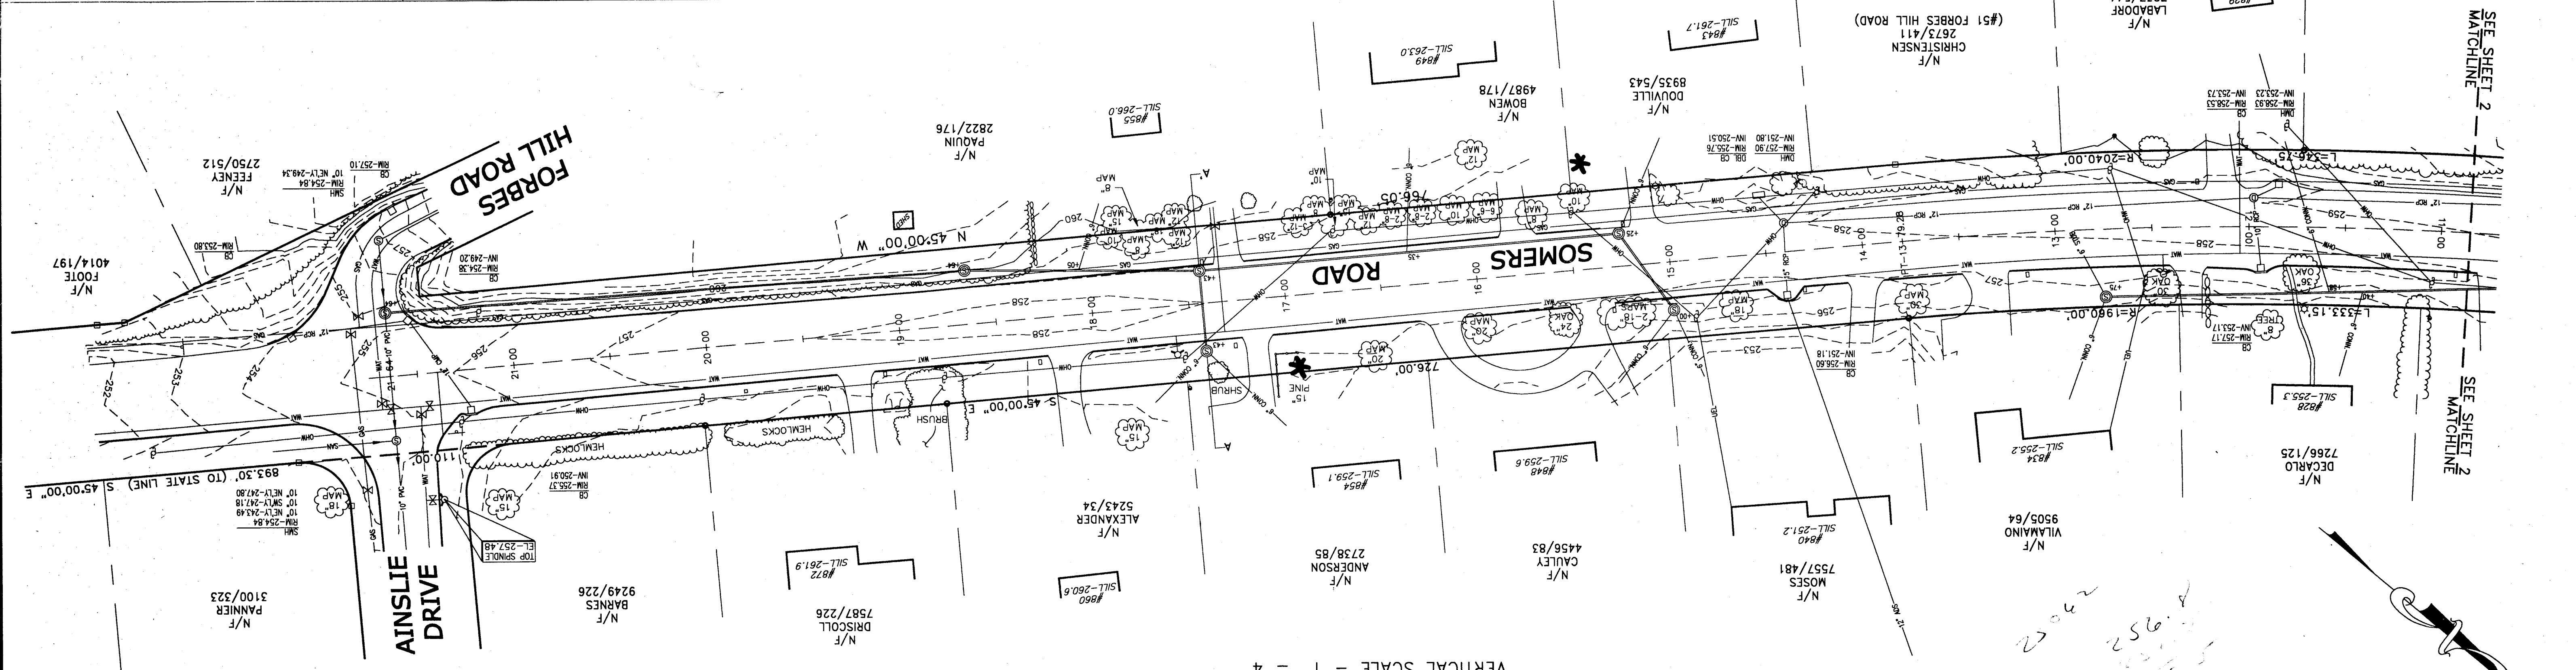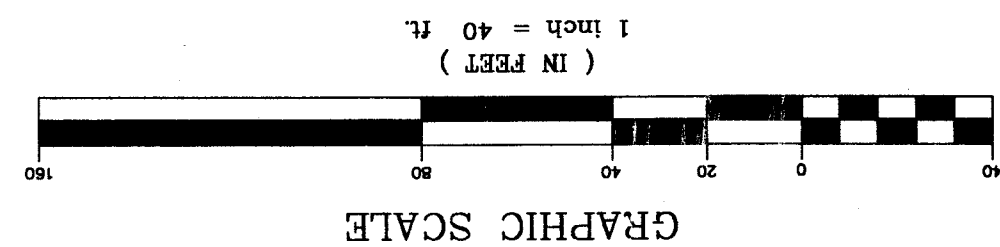

EXISTING GROUND ALONG CENTERLINE OF PIPE