



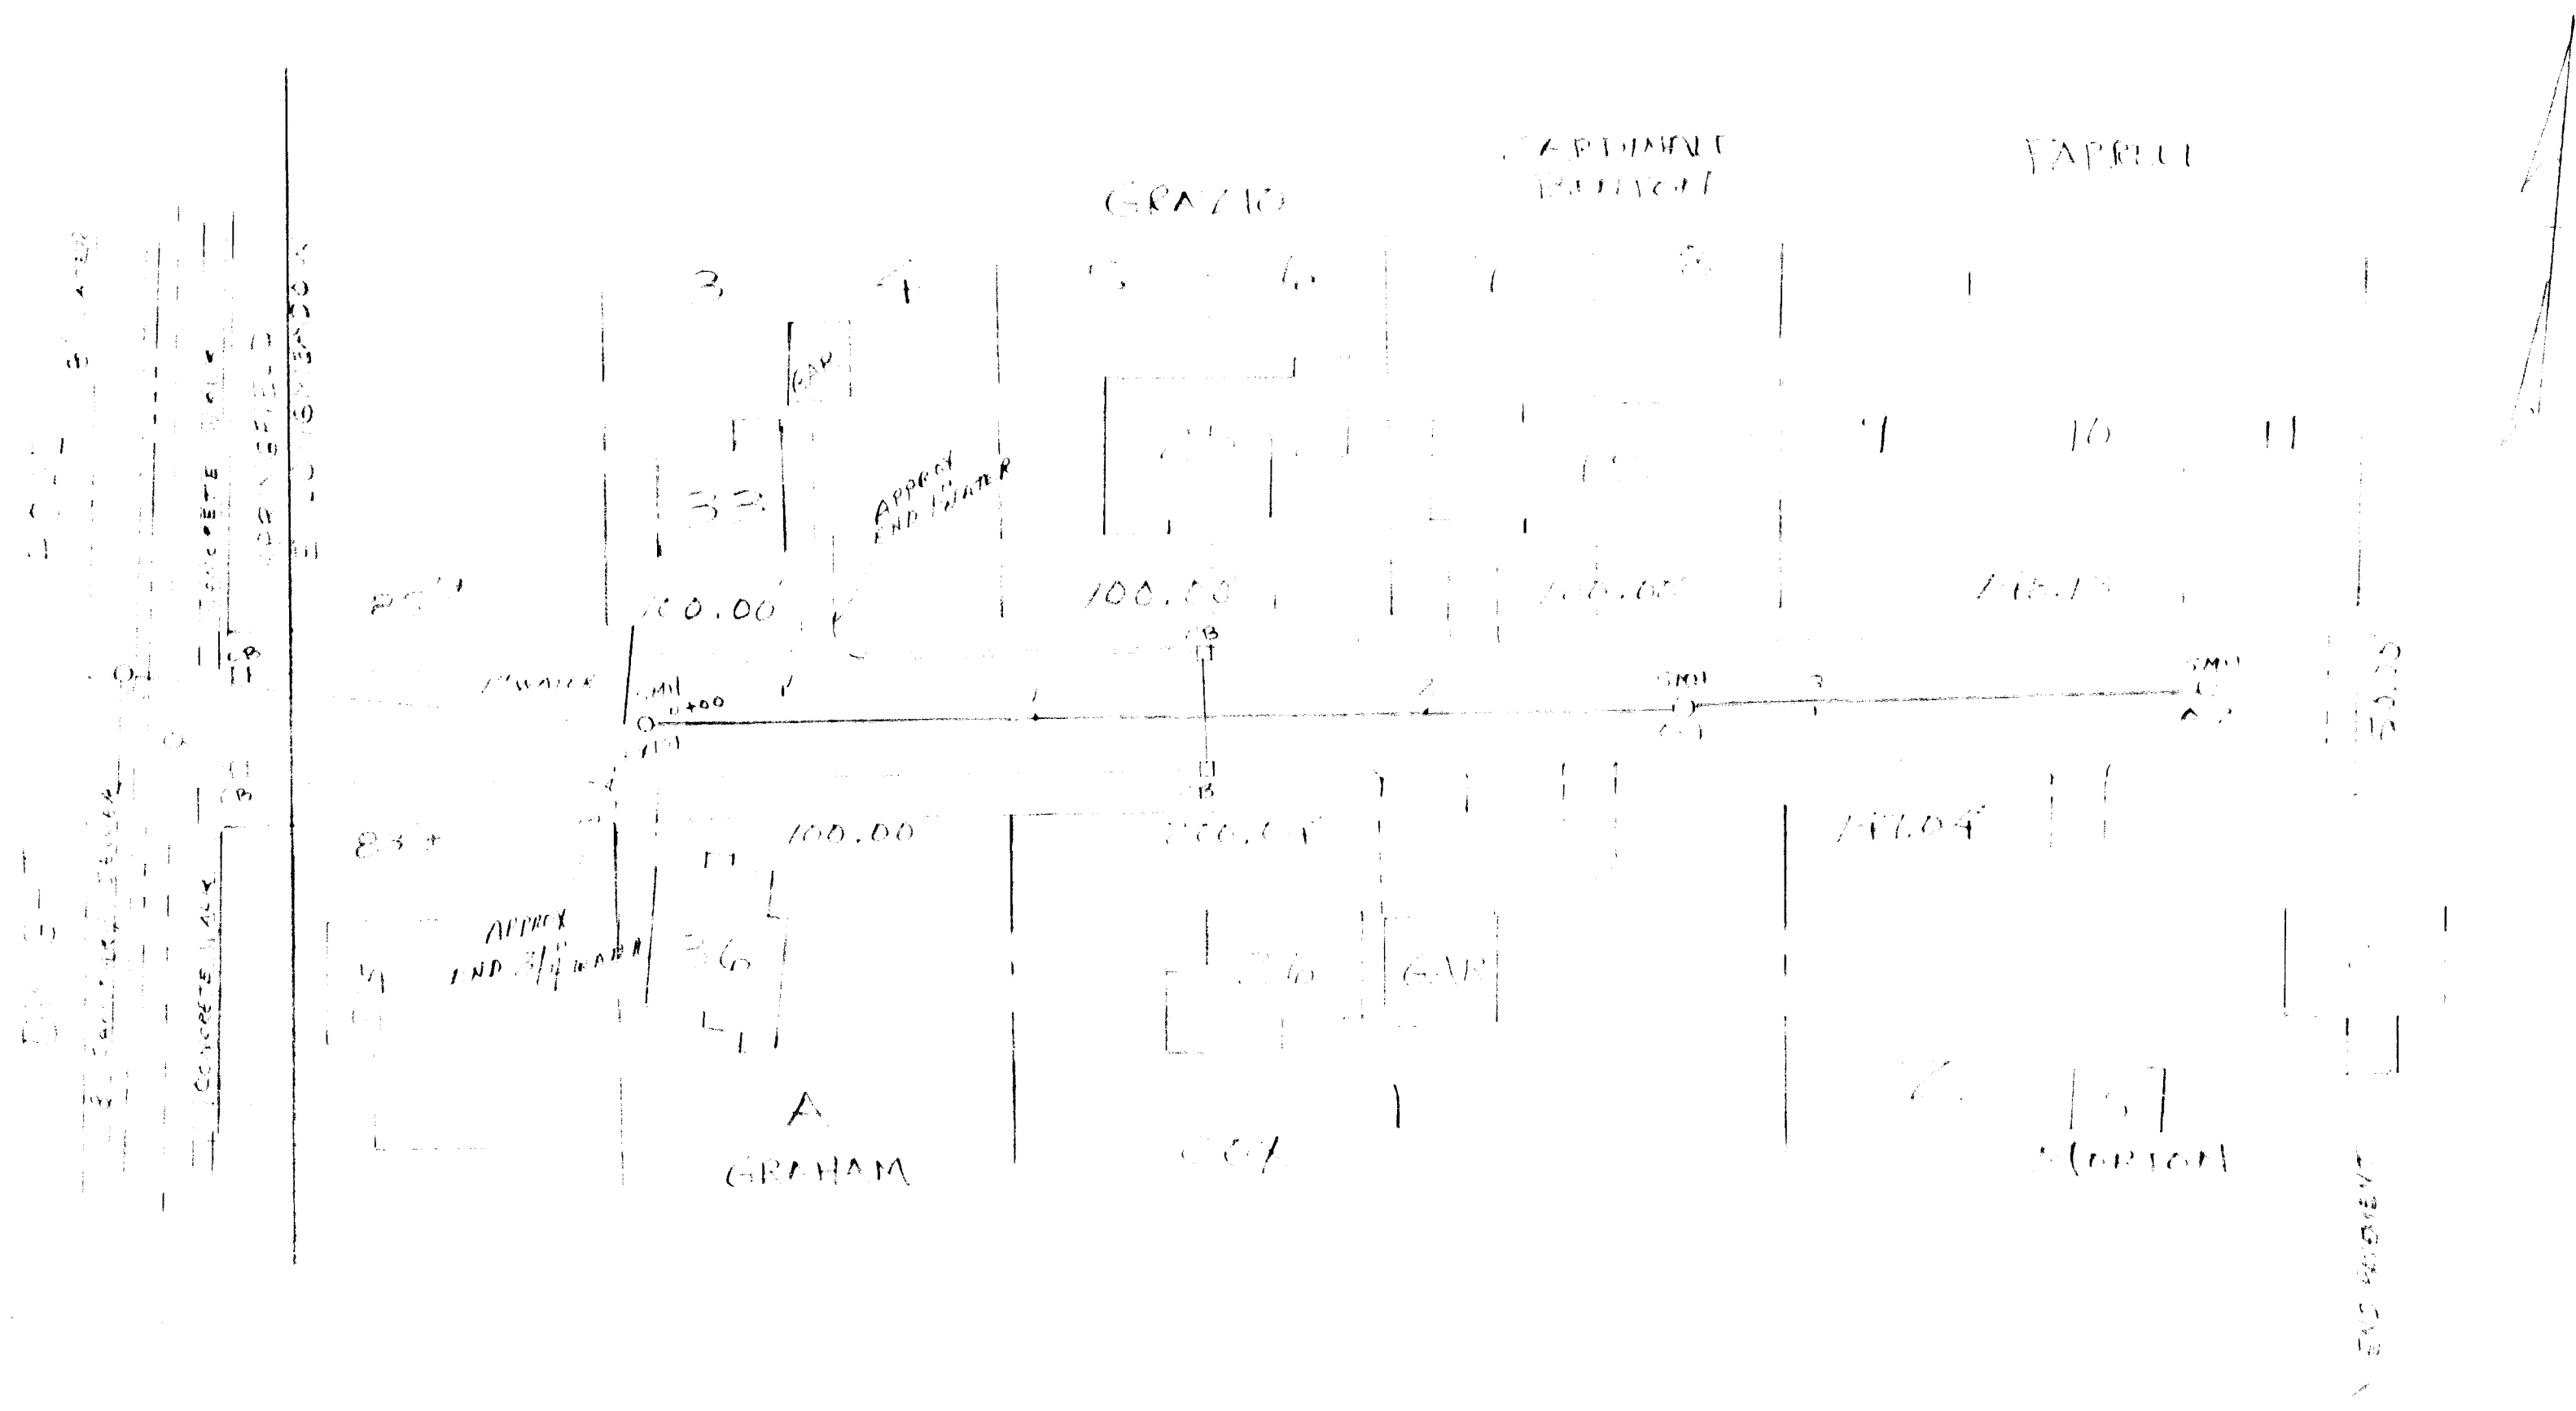

PLAN & PROFILE
 SANITARY SEWER
 BATHING STREET
 EAST LONGMEADOW MA.
 SCALE: 1" = 10' HOR. 1" = 1' VERT. 2003
 RANDY C. COMASER ENGINEER

116 511.6

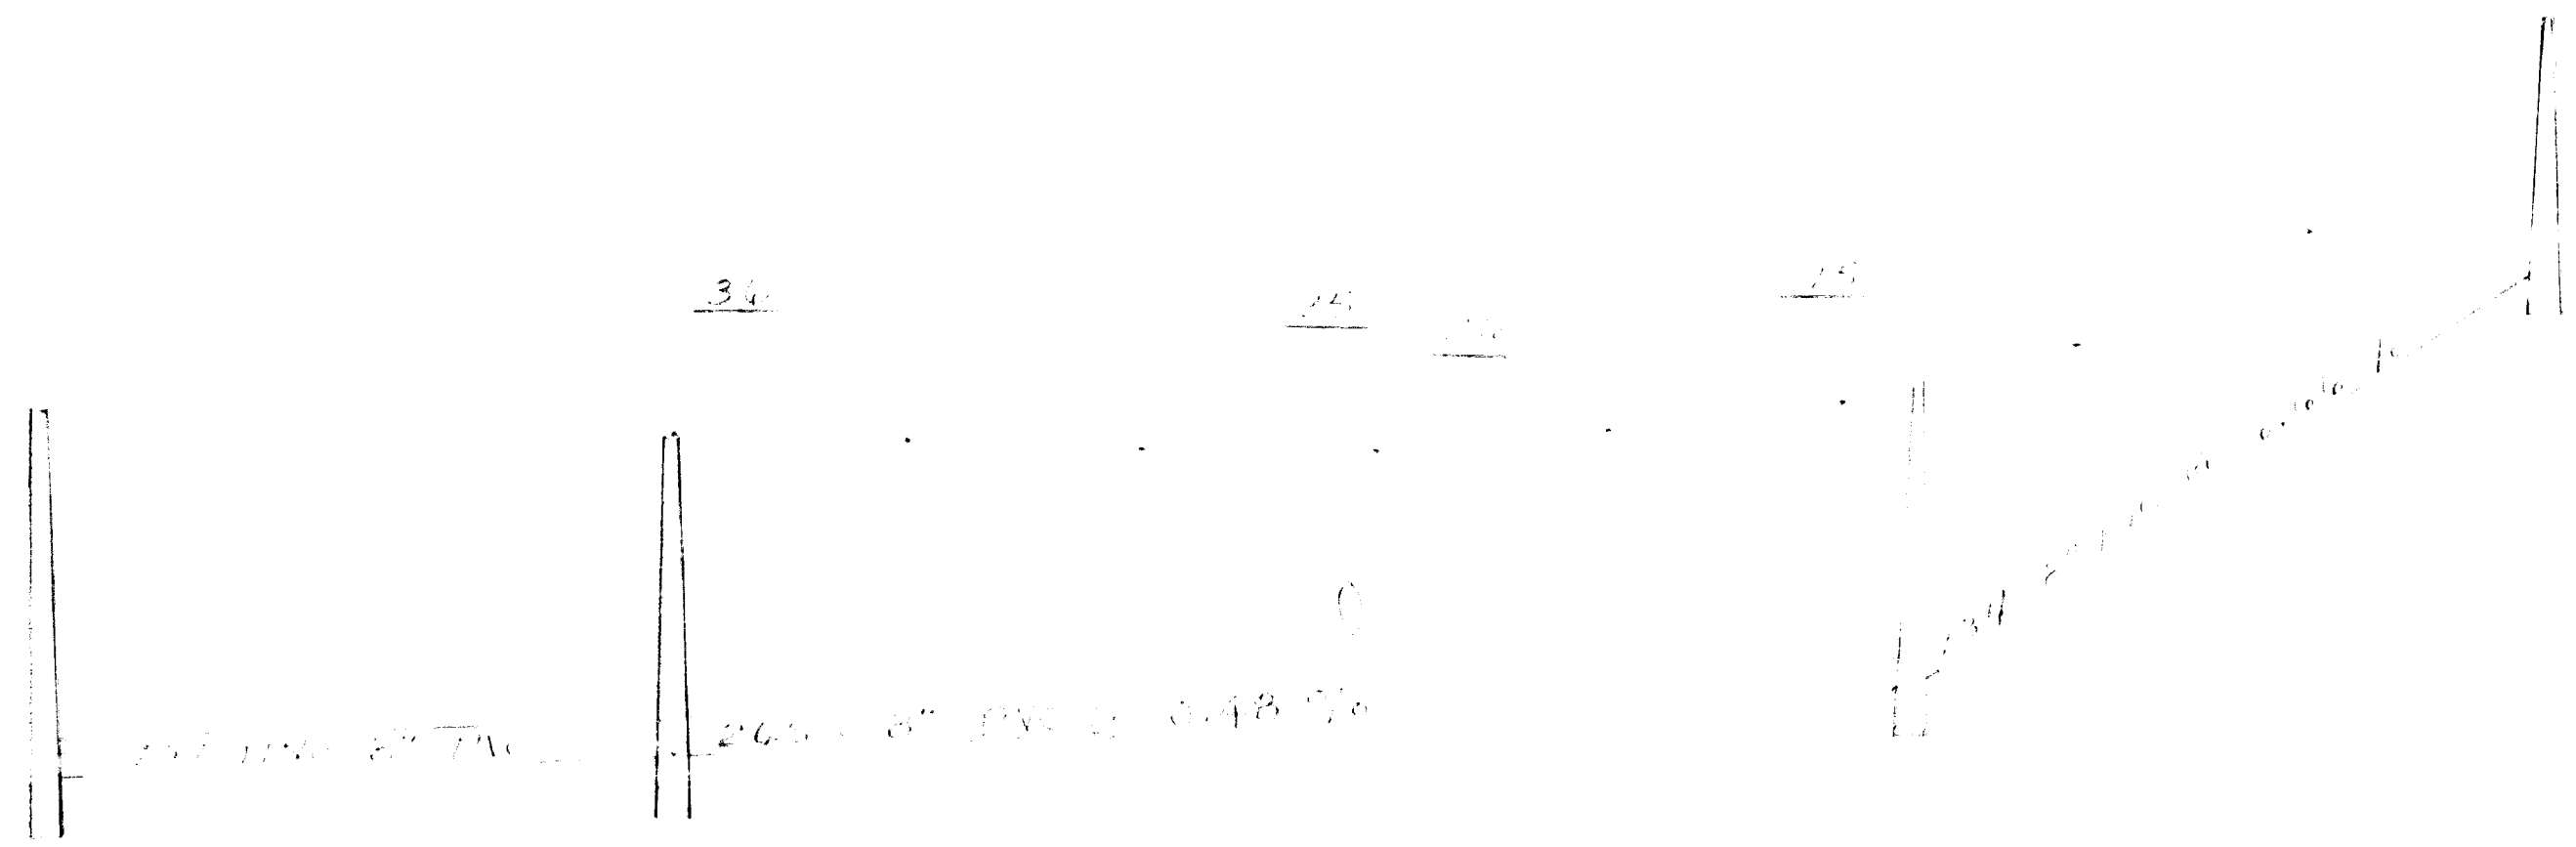

200

110

180

116 511.6

SS-470