



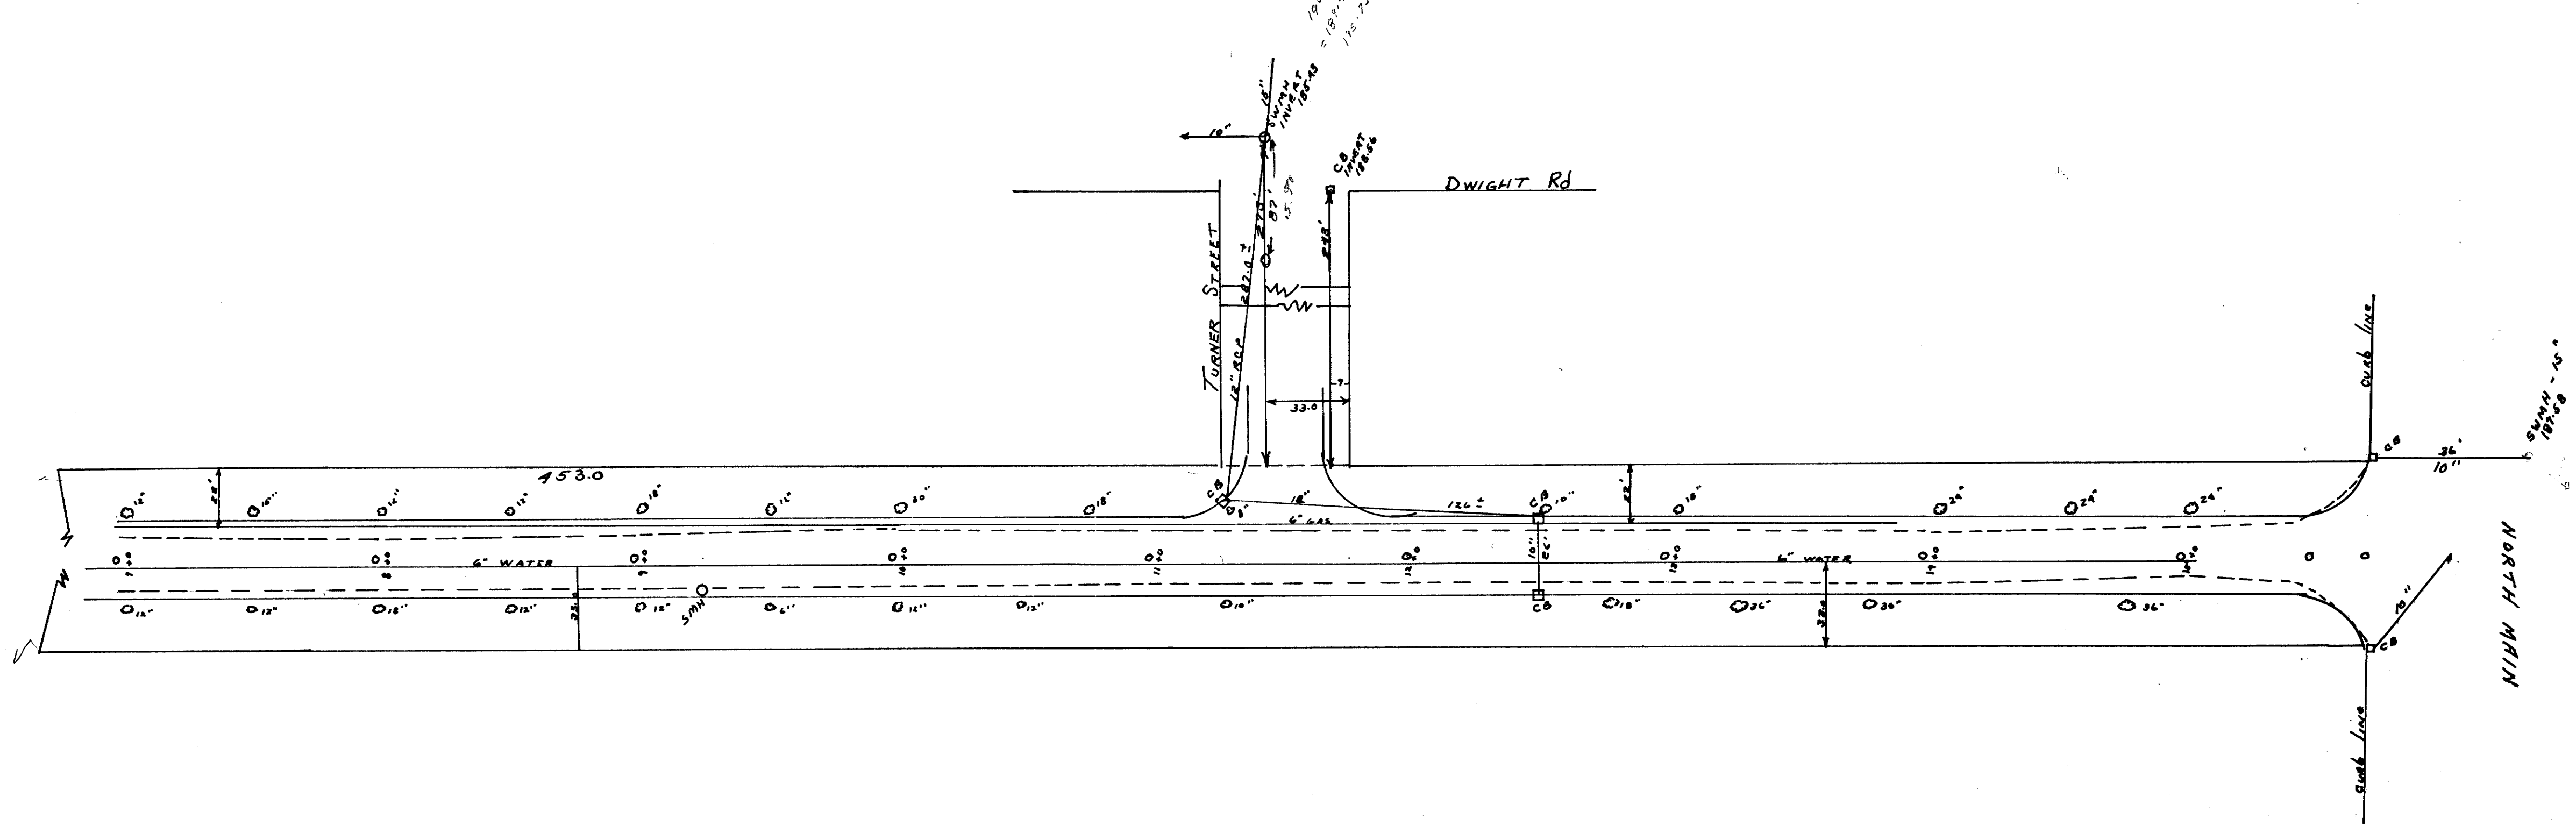

WOOD AVE

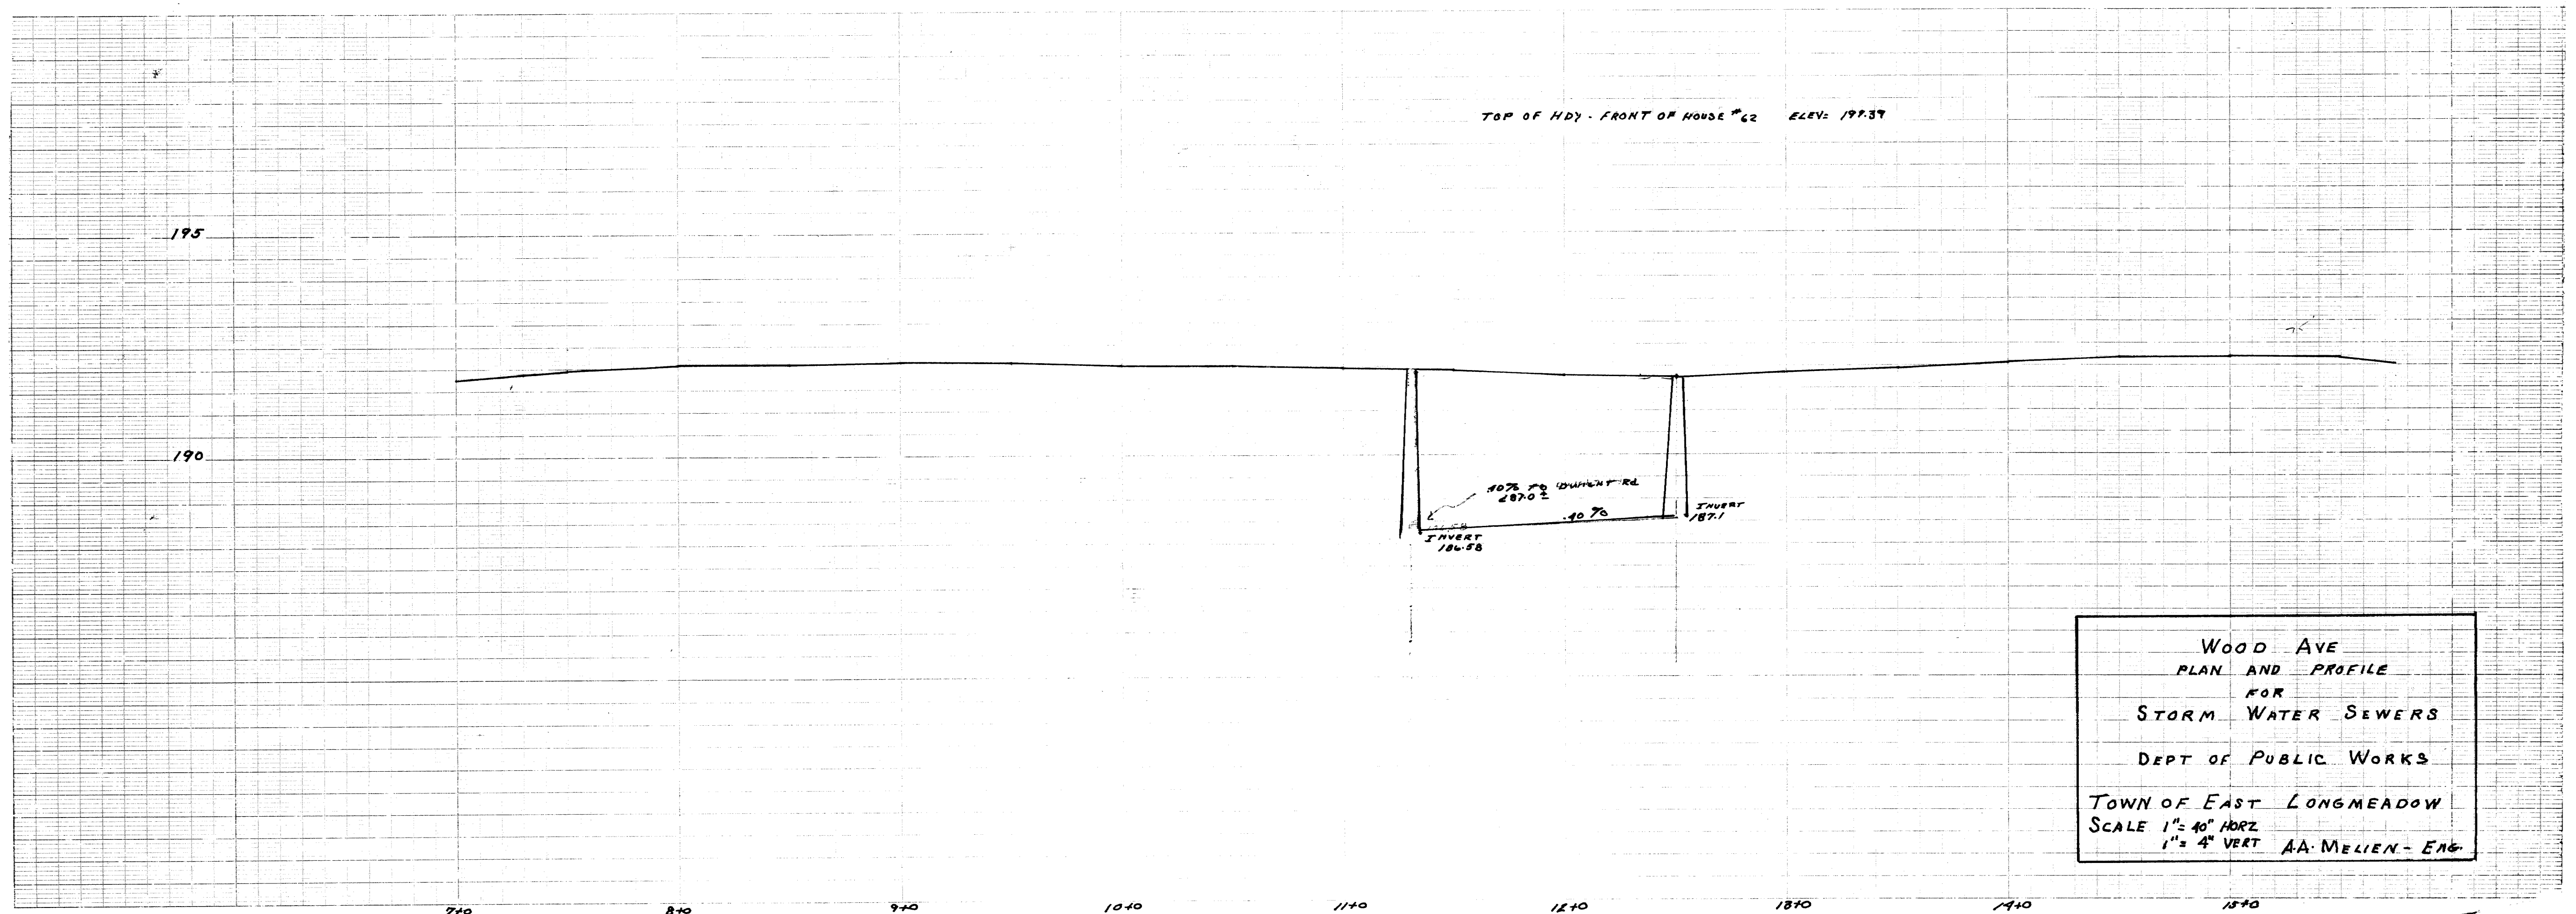

SD-1