

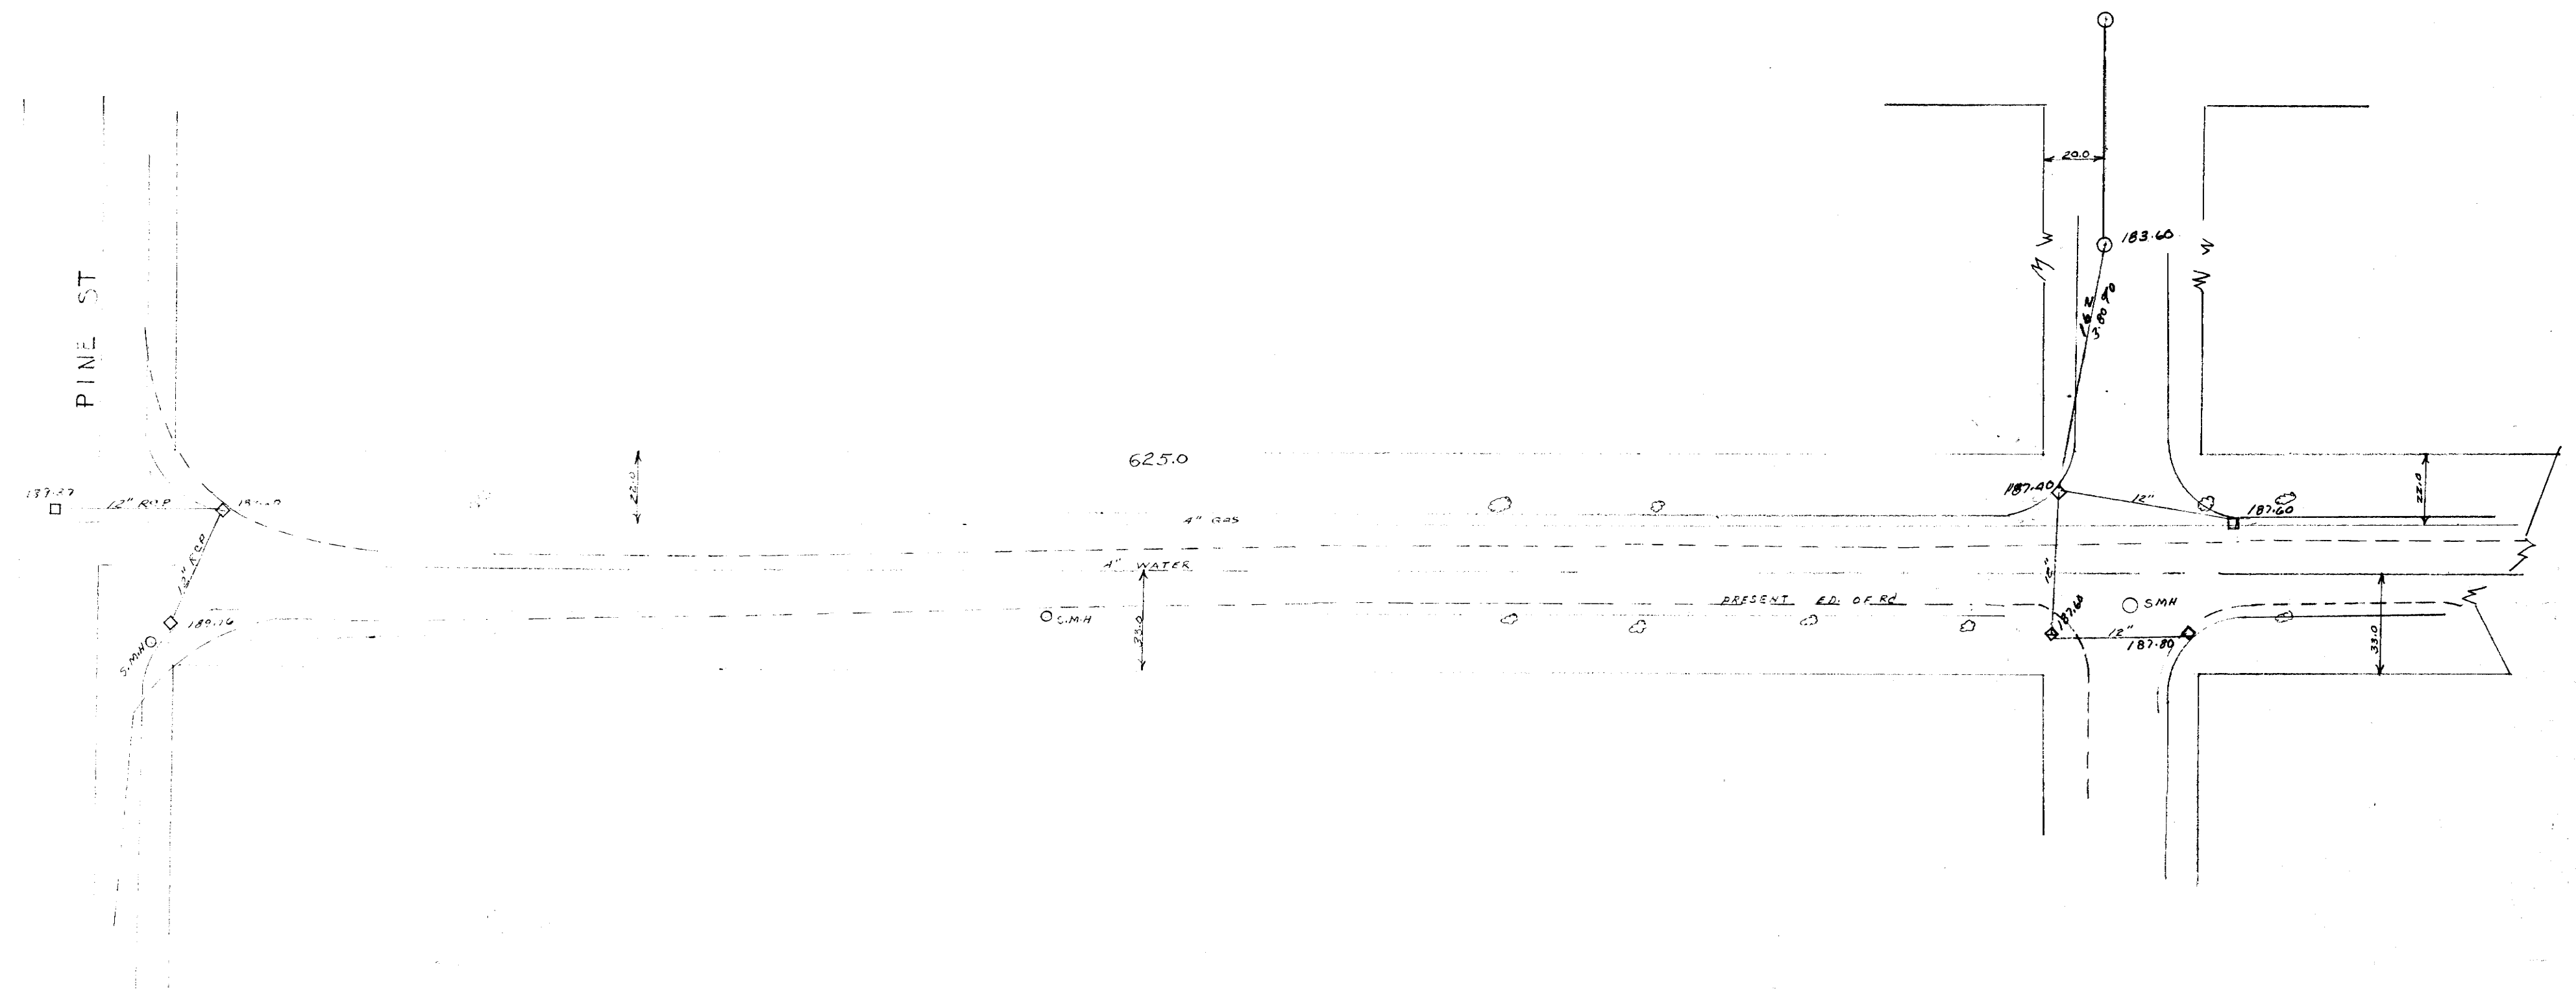
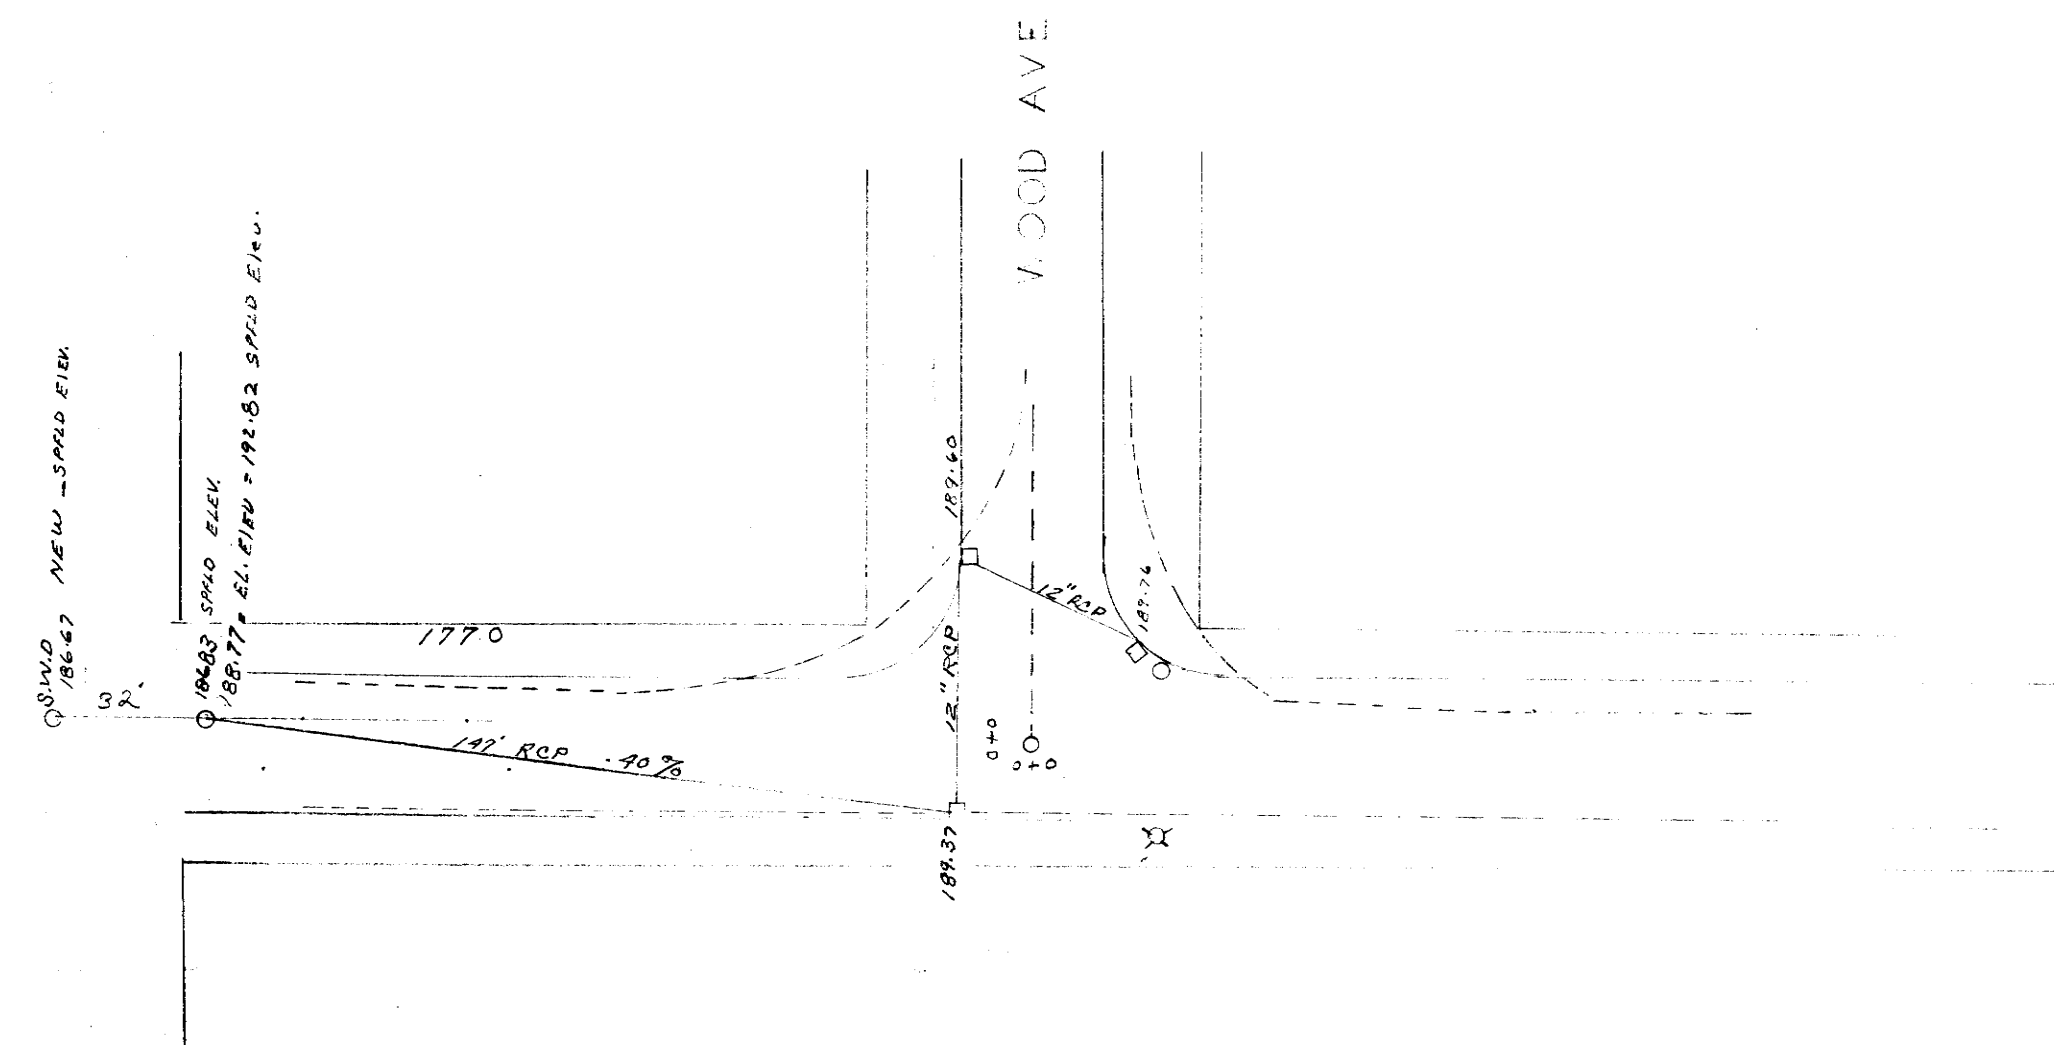


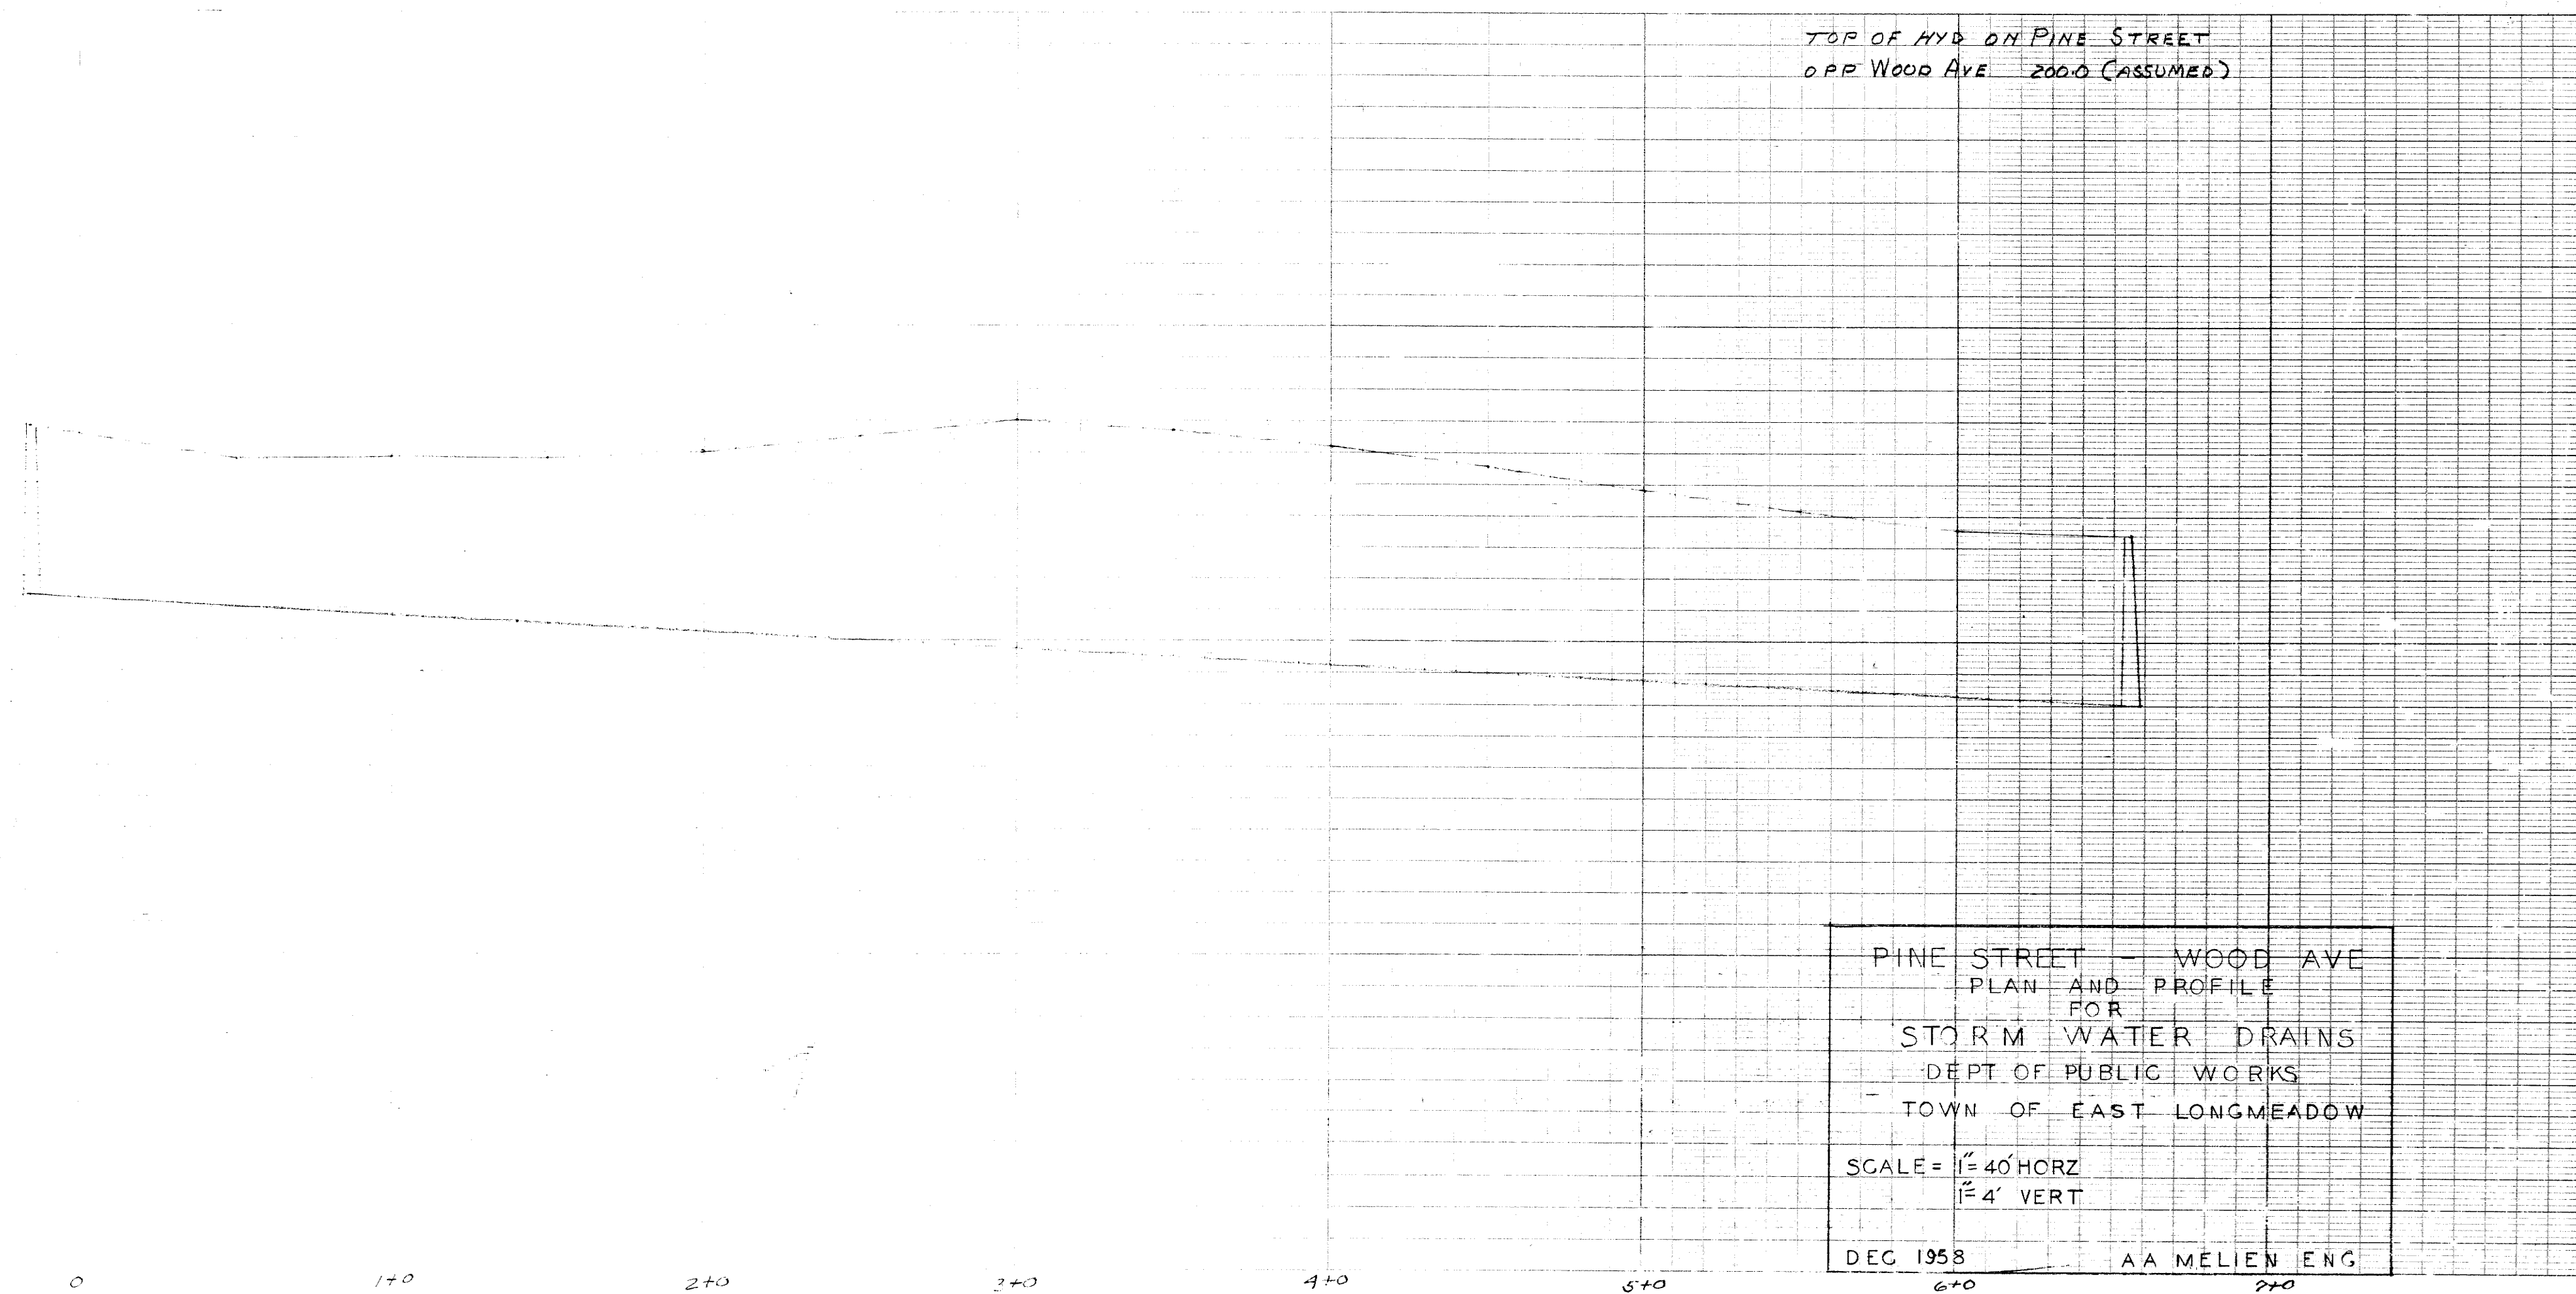

PINE ST

WOOD AVE

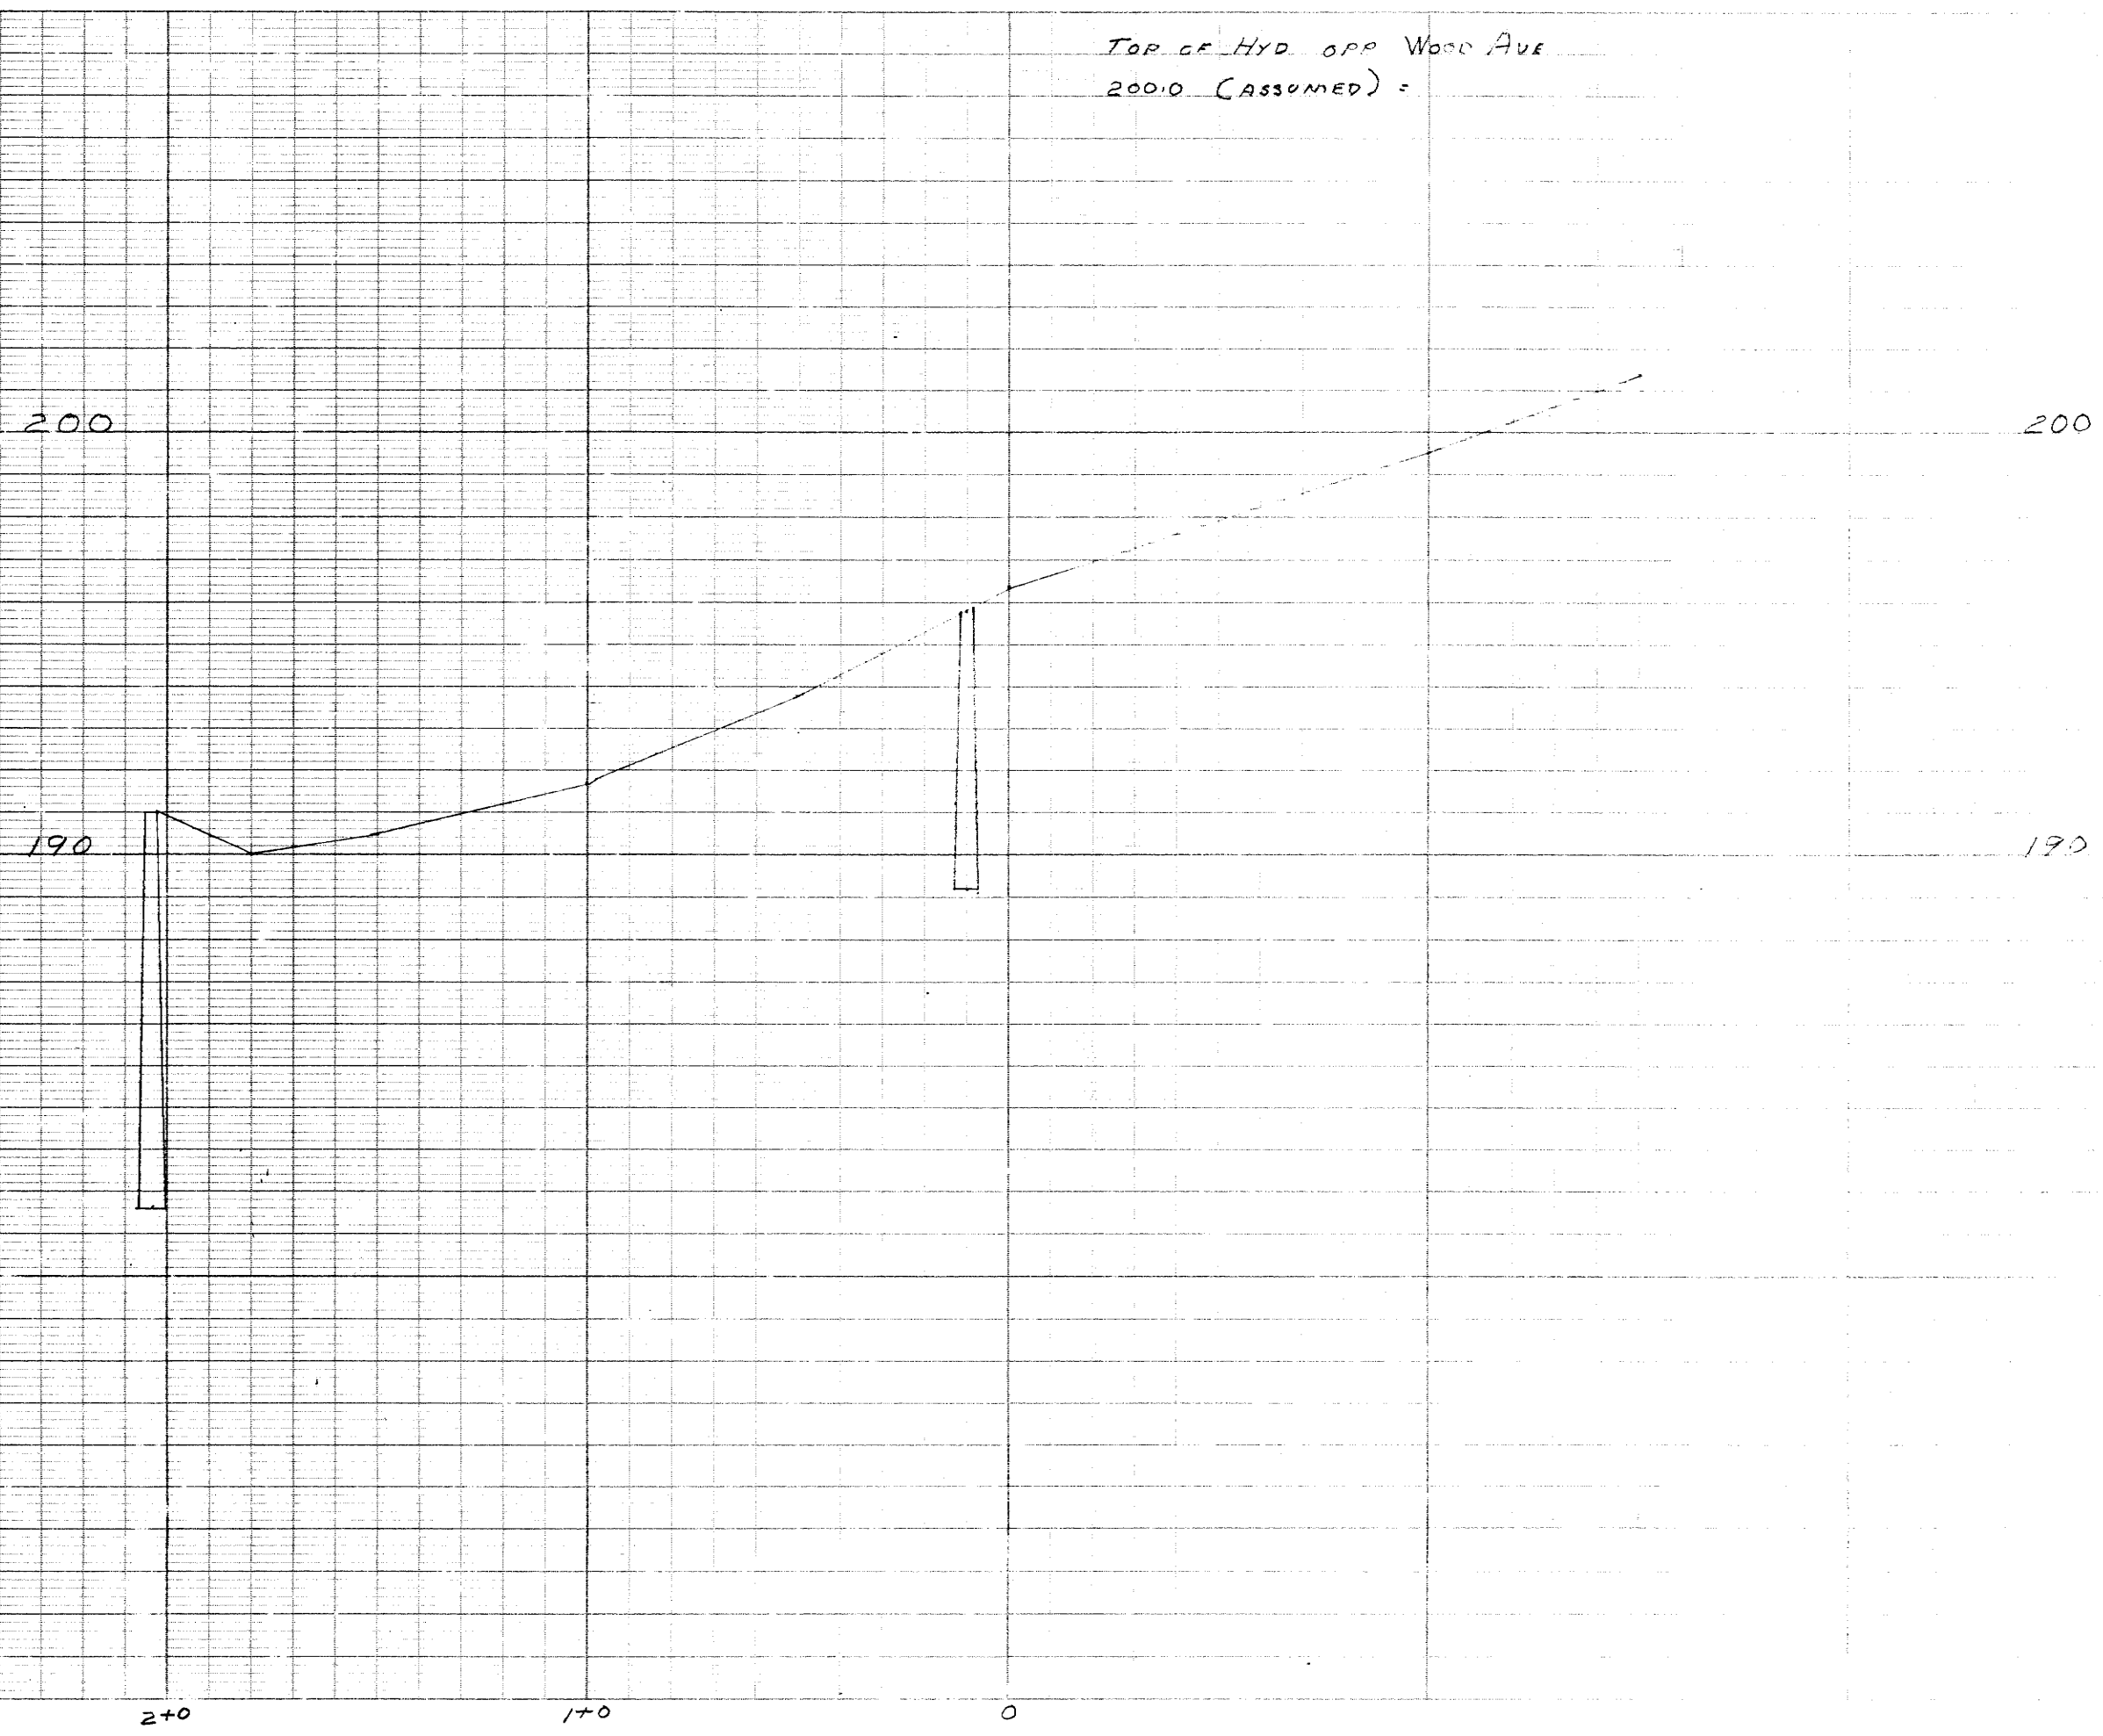

PINE STREET - WOOD AVE
PLAN AND PROFILE
FOR
STORM WATER DRAINS
DEPT OF PUBLIC WORKS
TOWN OF EAST LONGMEADOW
SCALE = 1" = 40' HORZ
1" = 4' VERT
DEC 1958 AA MELIEN ENG

SD #2