



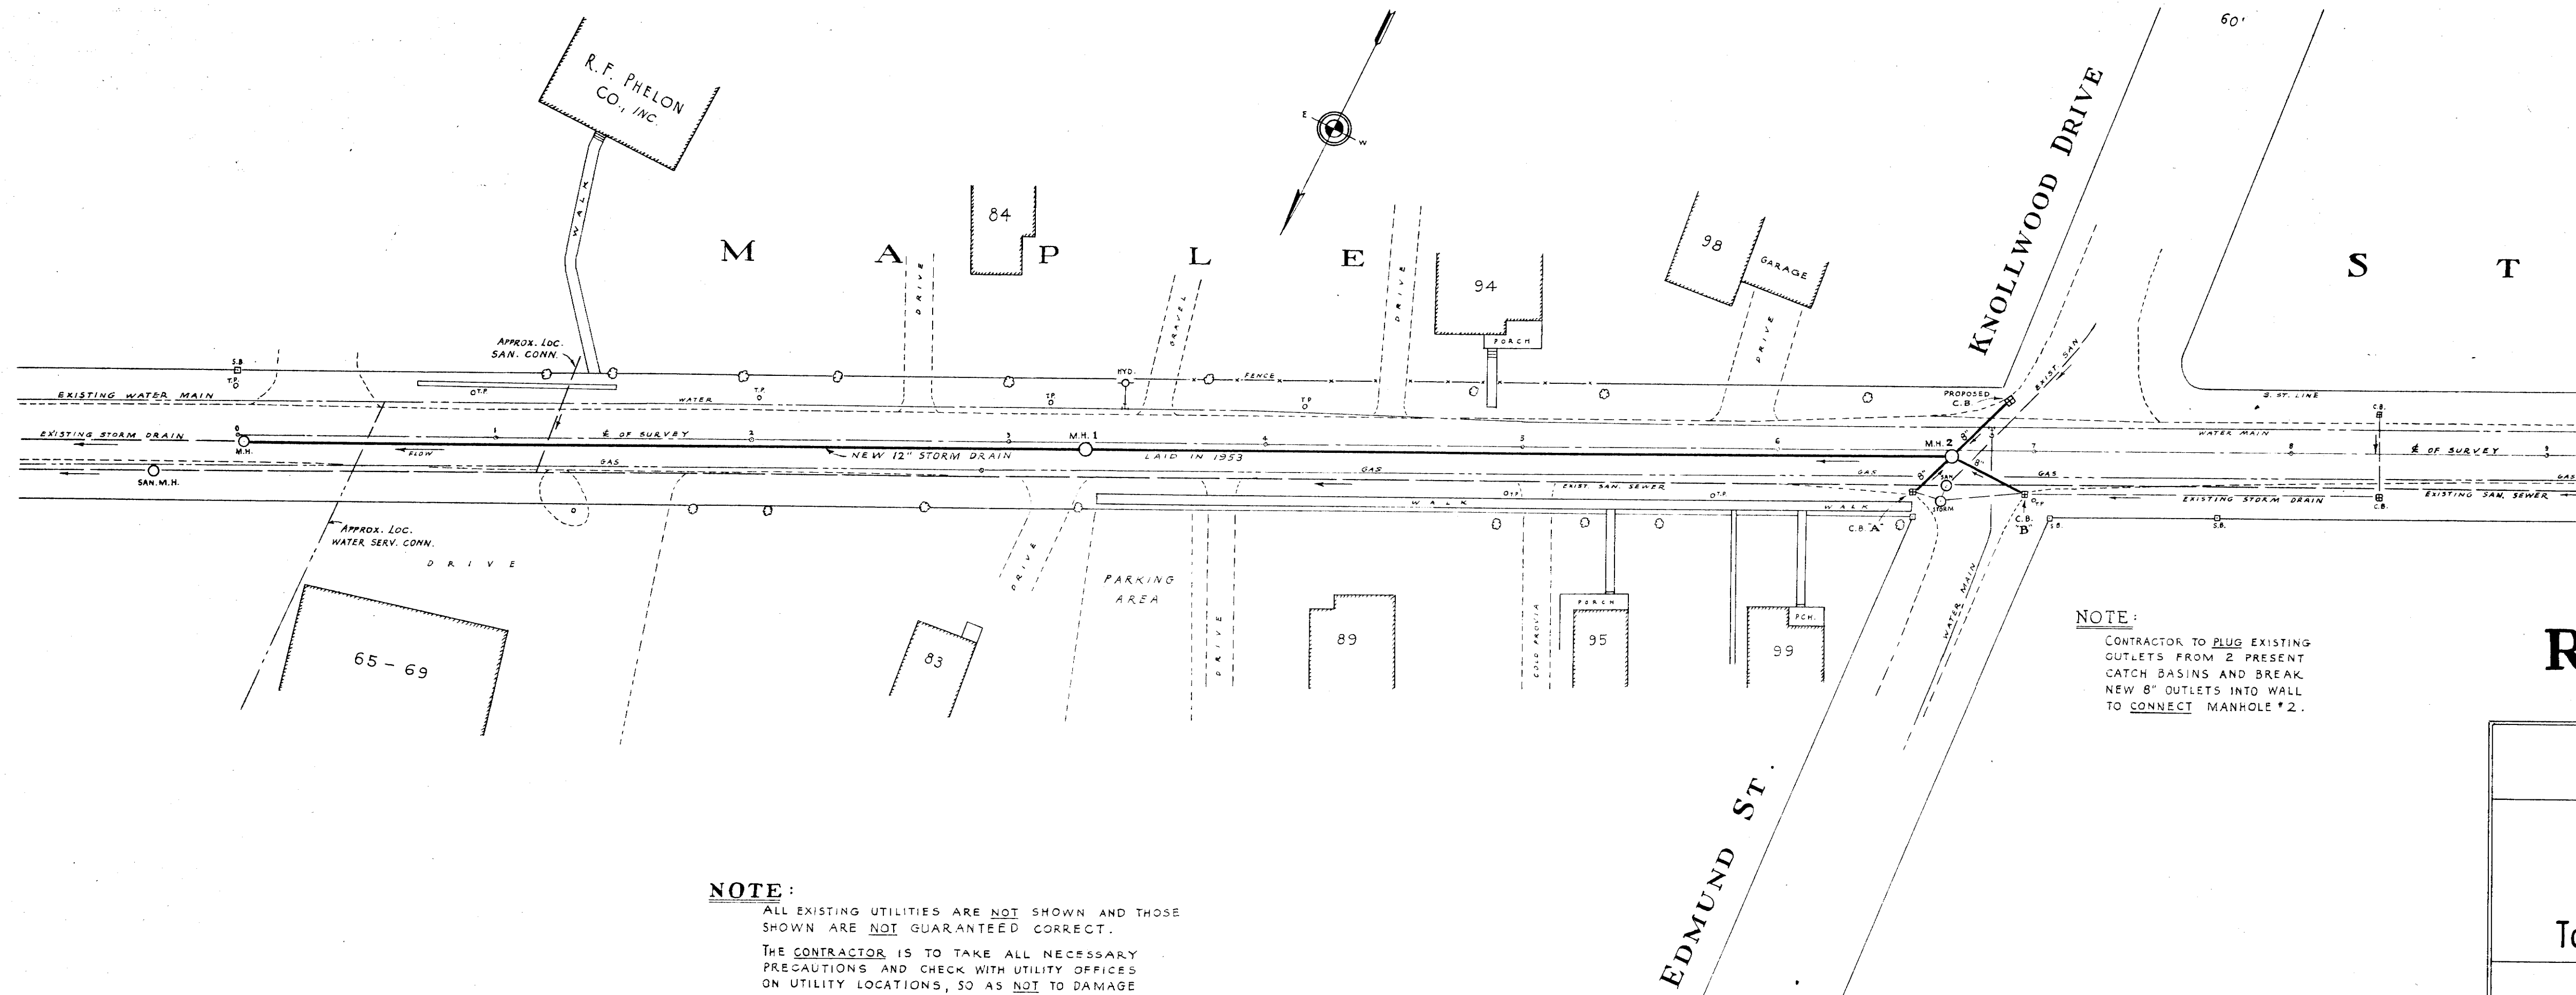

T.B.M. = M.H. RIM
 ELEV. = 100.0' (ASSUMED)

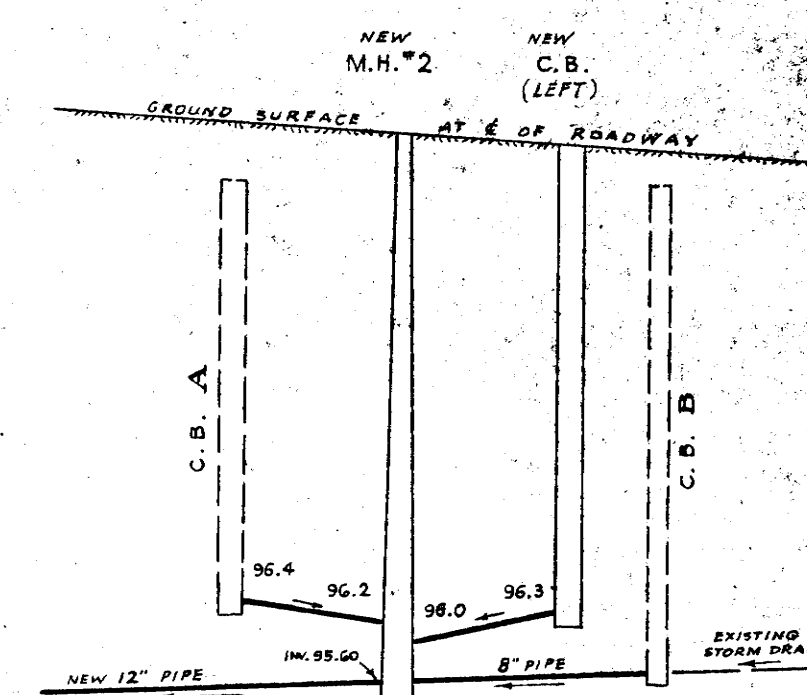


RECORD PLAN STORM WATER DRAIN LAID IN 1953

MAPLE STREET

PROPOSED
STORM WATER DRAIN
 BOARD OF SELECTMEN
TOWN OF EAST LONGMEADOW, MASS.

TIGHE & BOND, CONSULTING ENGINEERS,
 HOLYOKE, MASS.,
 SCALE: HORZ. 1" = 40'
 VERT. 1" = 4' APRIL, 1953

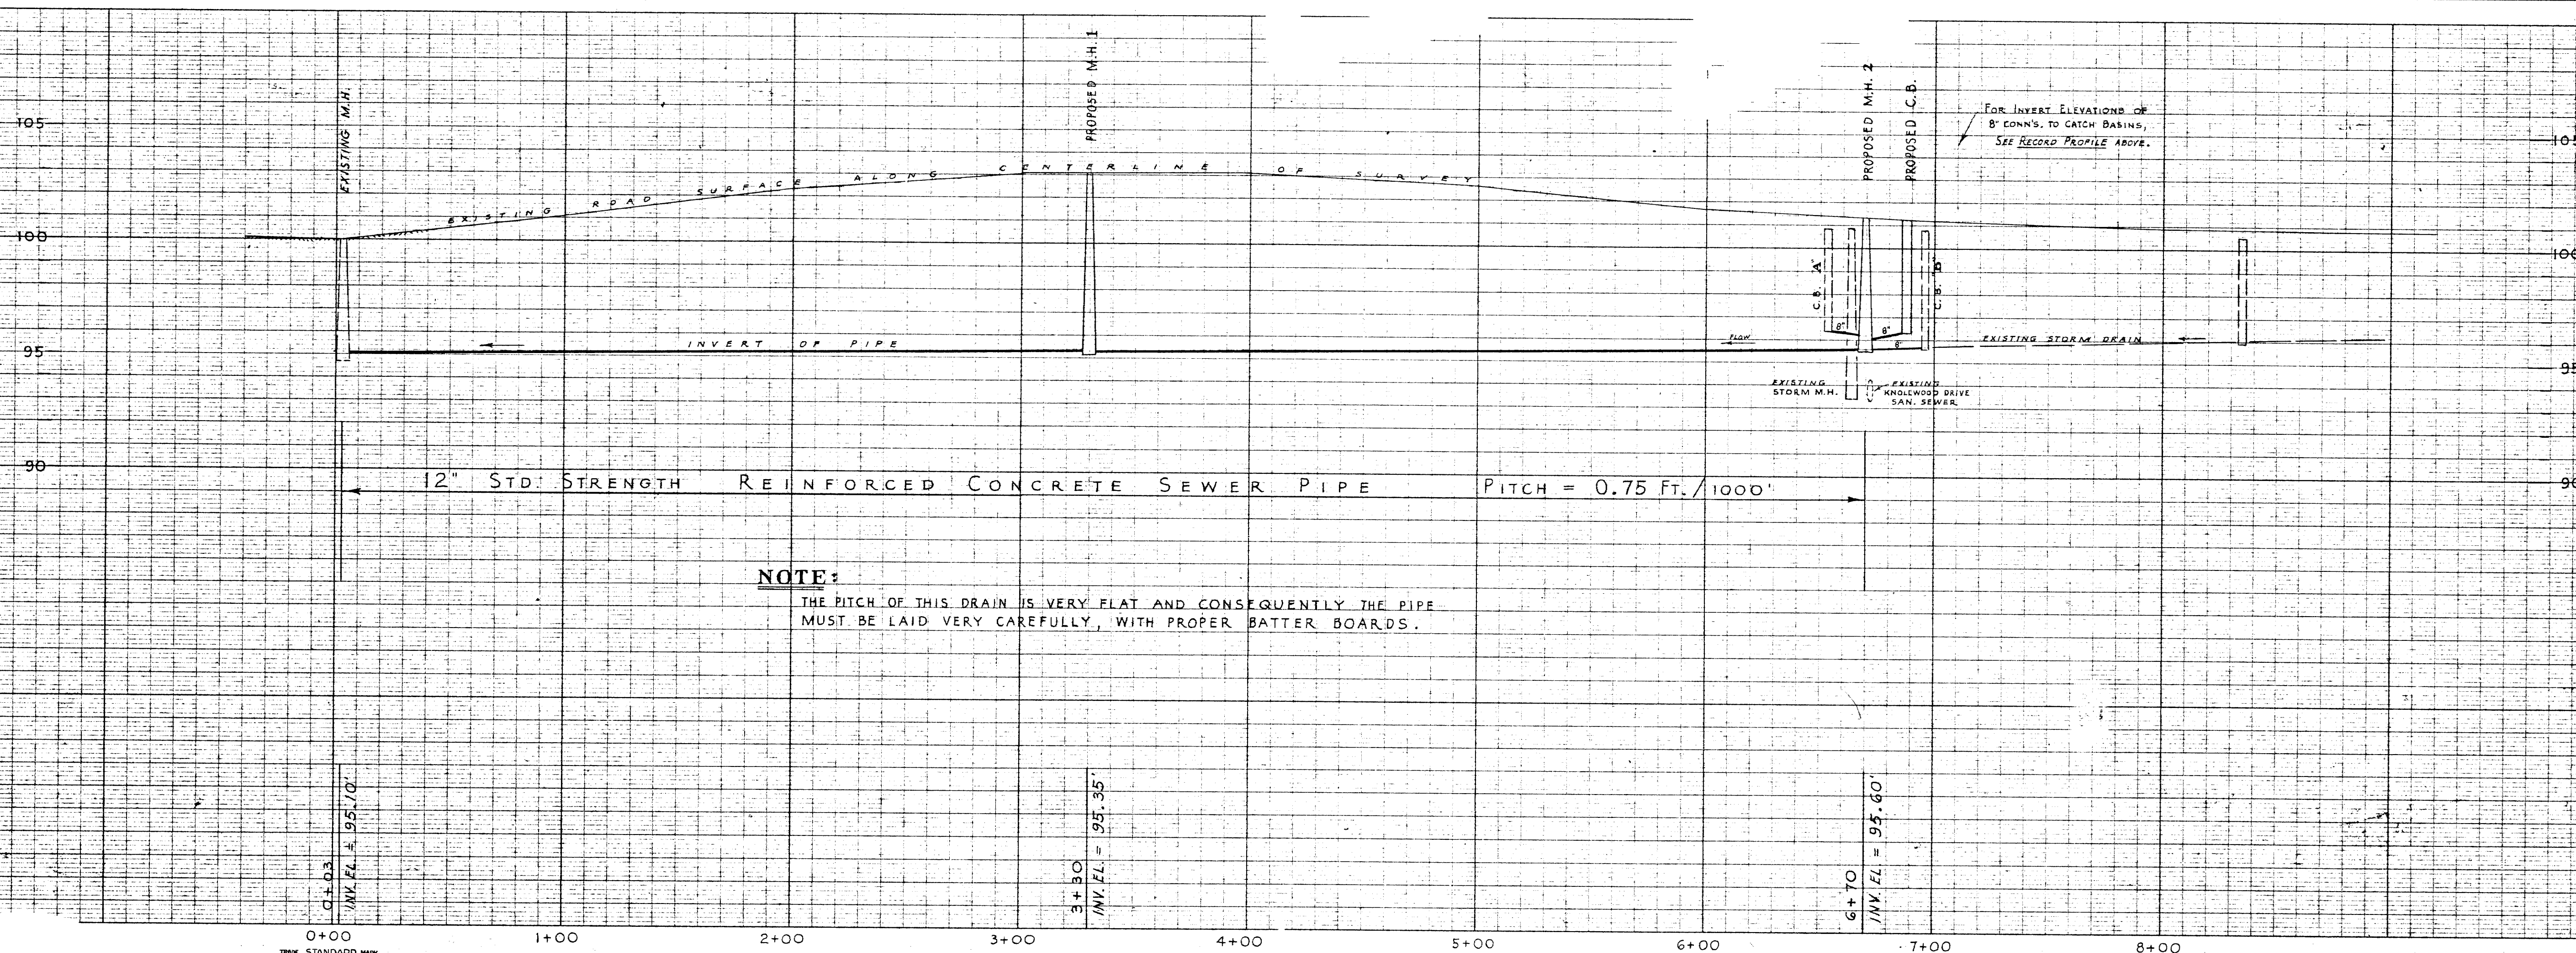

FROM STANDARD MAP
 BEA-115, 1947, 1948
 PROFILE PLATE A, 4 X 20
 100 X 100 PAPER
 SCALE 1" = 40'

KEUFFEL & ESSER CO.
 NEW YORK

FROM STANDARD MAP
 BEA-115, 1947, 1948

KEUFFEL & ESSER CO.
 NEW YORK

50.28 (2)