


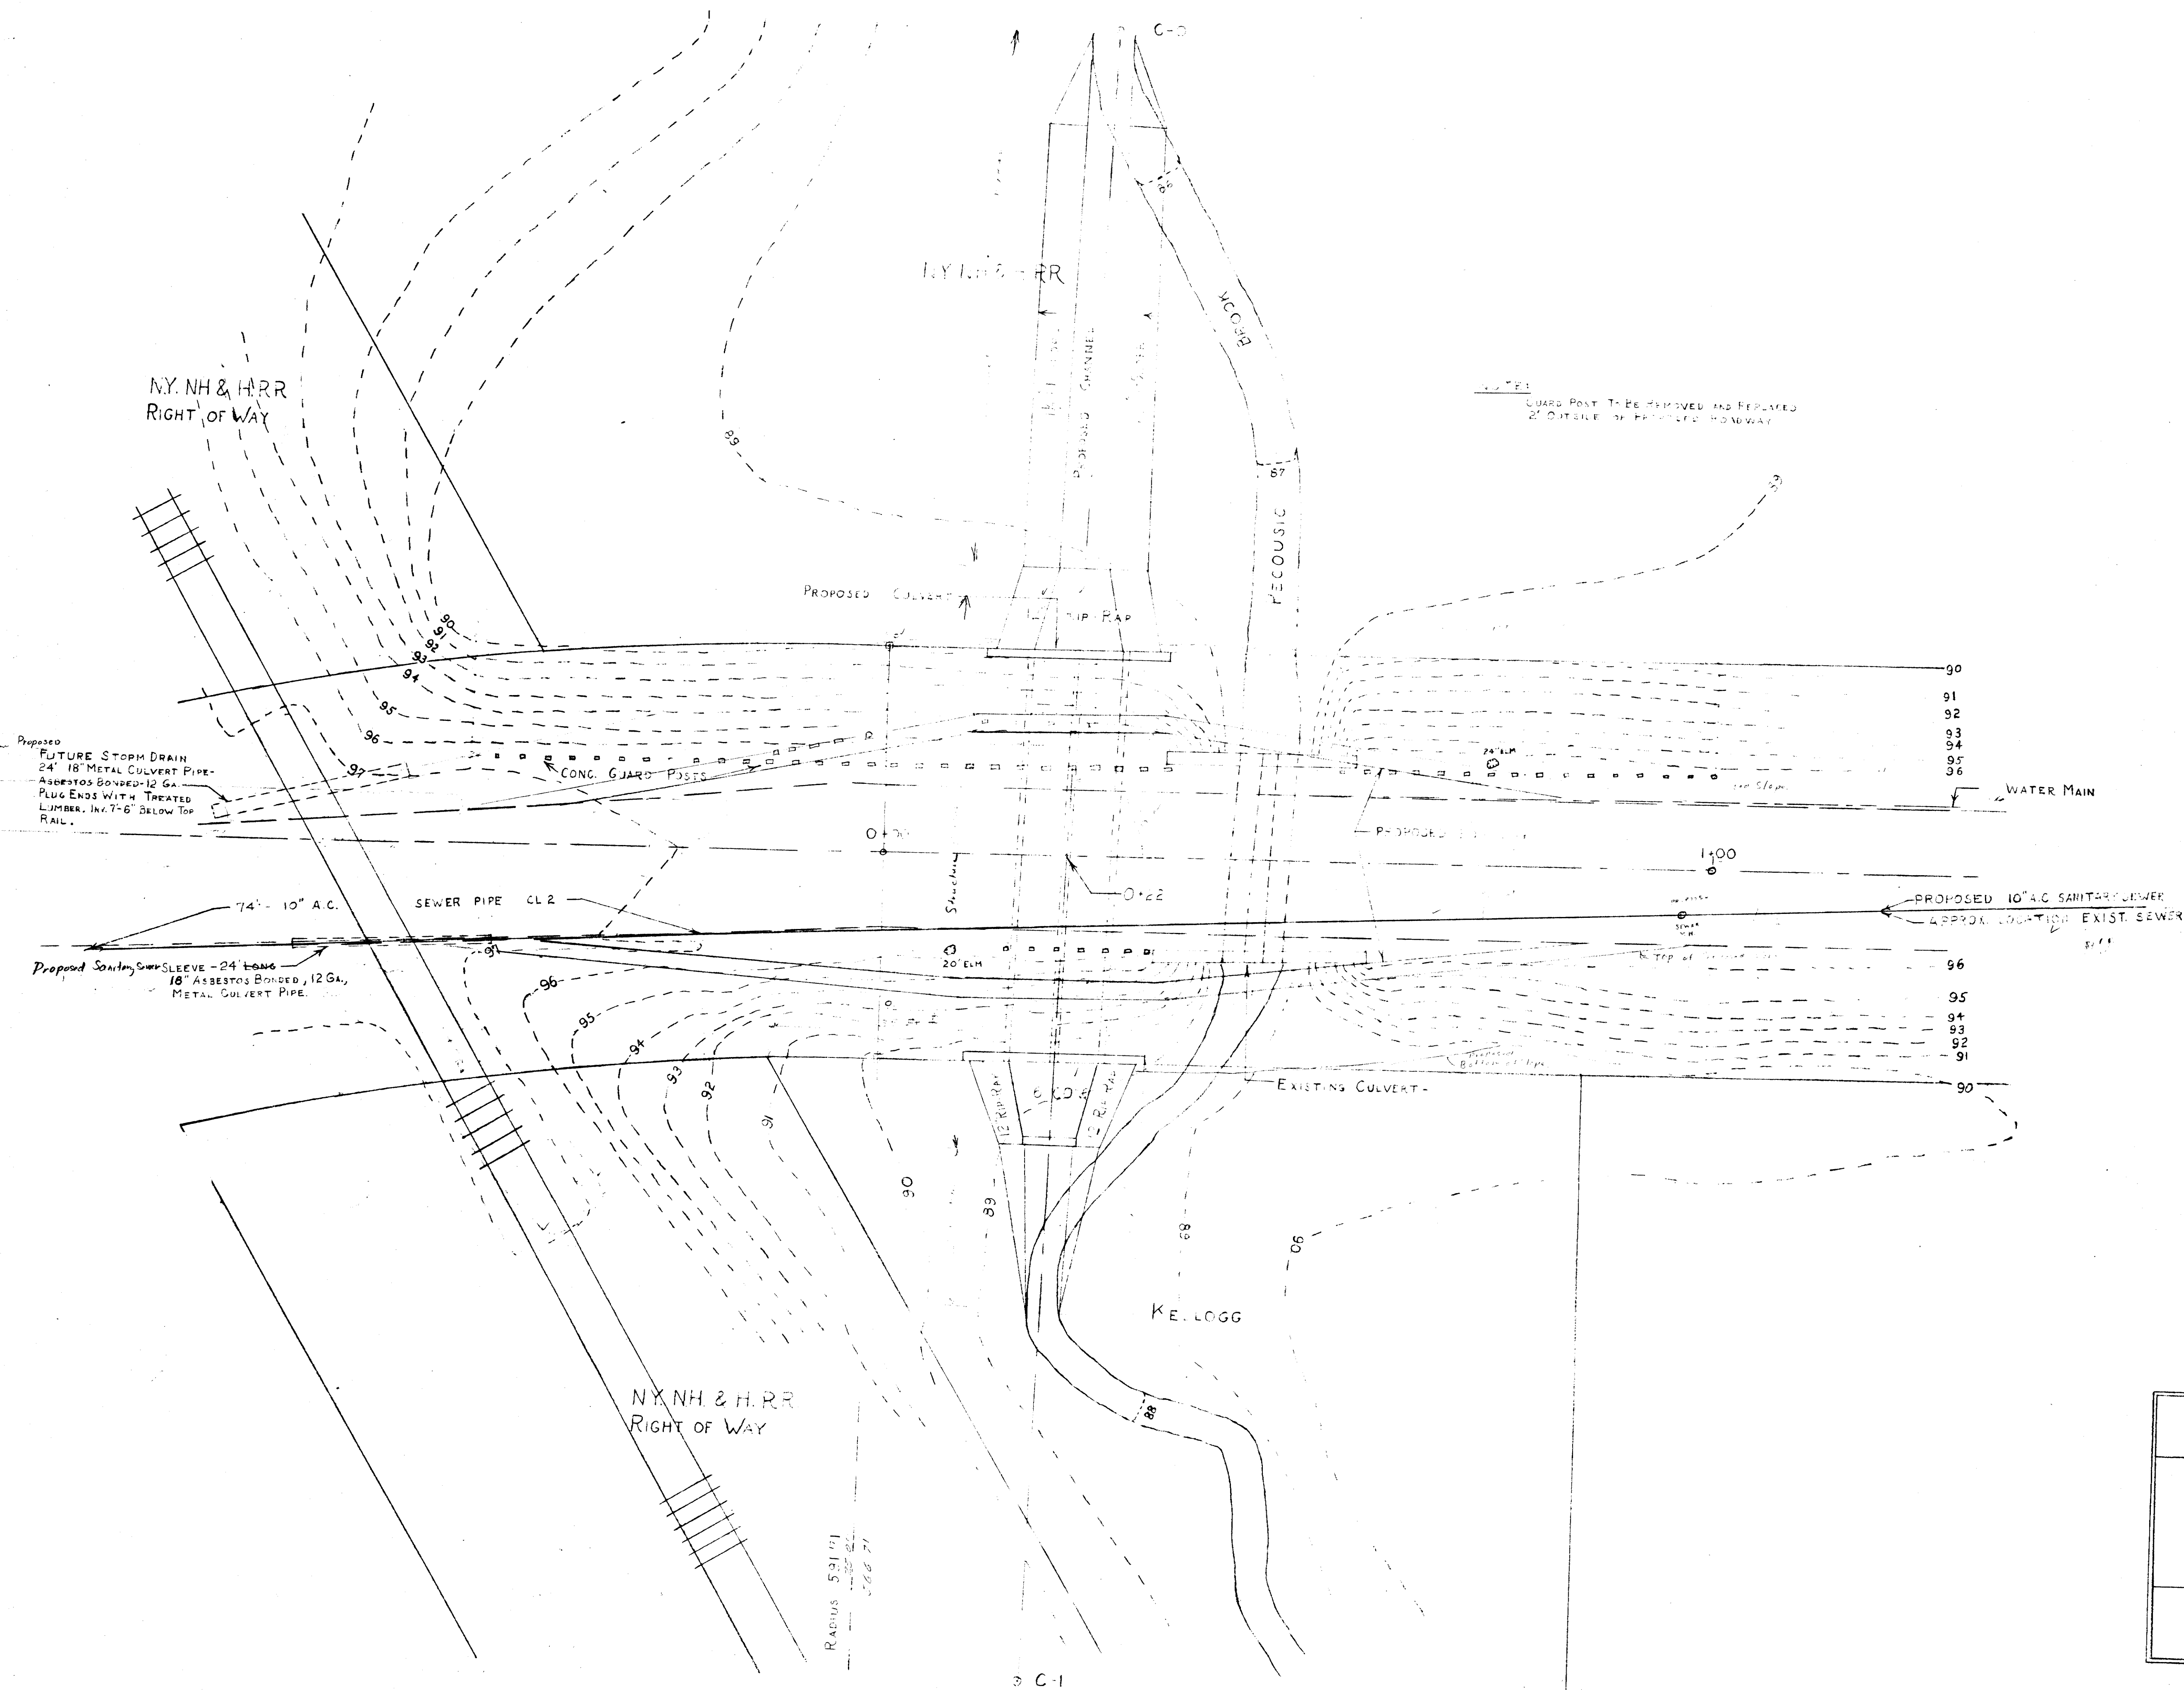

WESTWOOD AVE CULVERT	
PROPOSED CONCRETE CULVERT	
BOARD OF SELECTMEN	
TOWN OF EAST LONGMEADOW, MASS.	
TIGHE & BOND, CONSULTING ENGINEERS, HOLYOKE, MASS.	
HORZ. 1" = 10'	APRIL, 1951
SCALE: VERT.	