


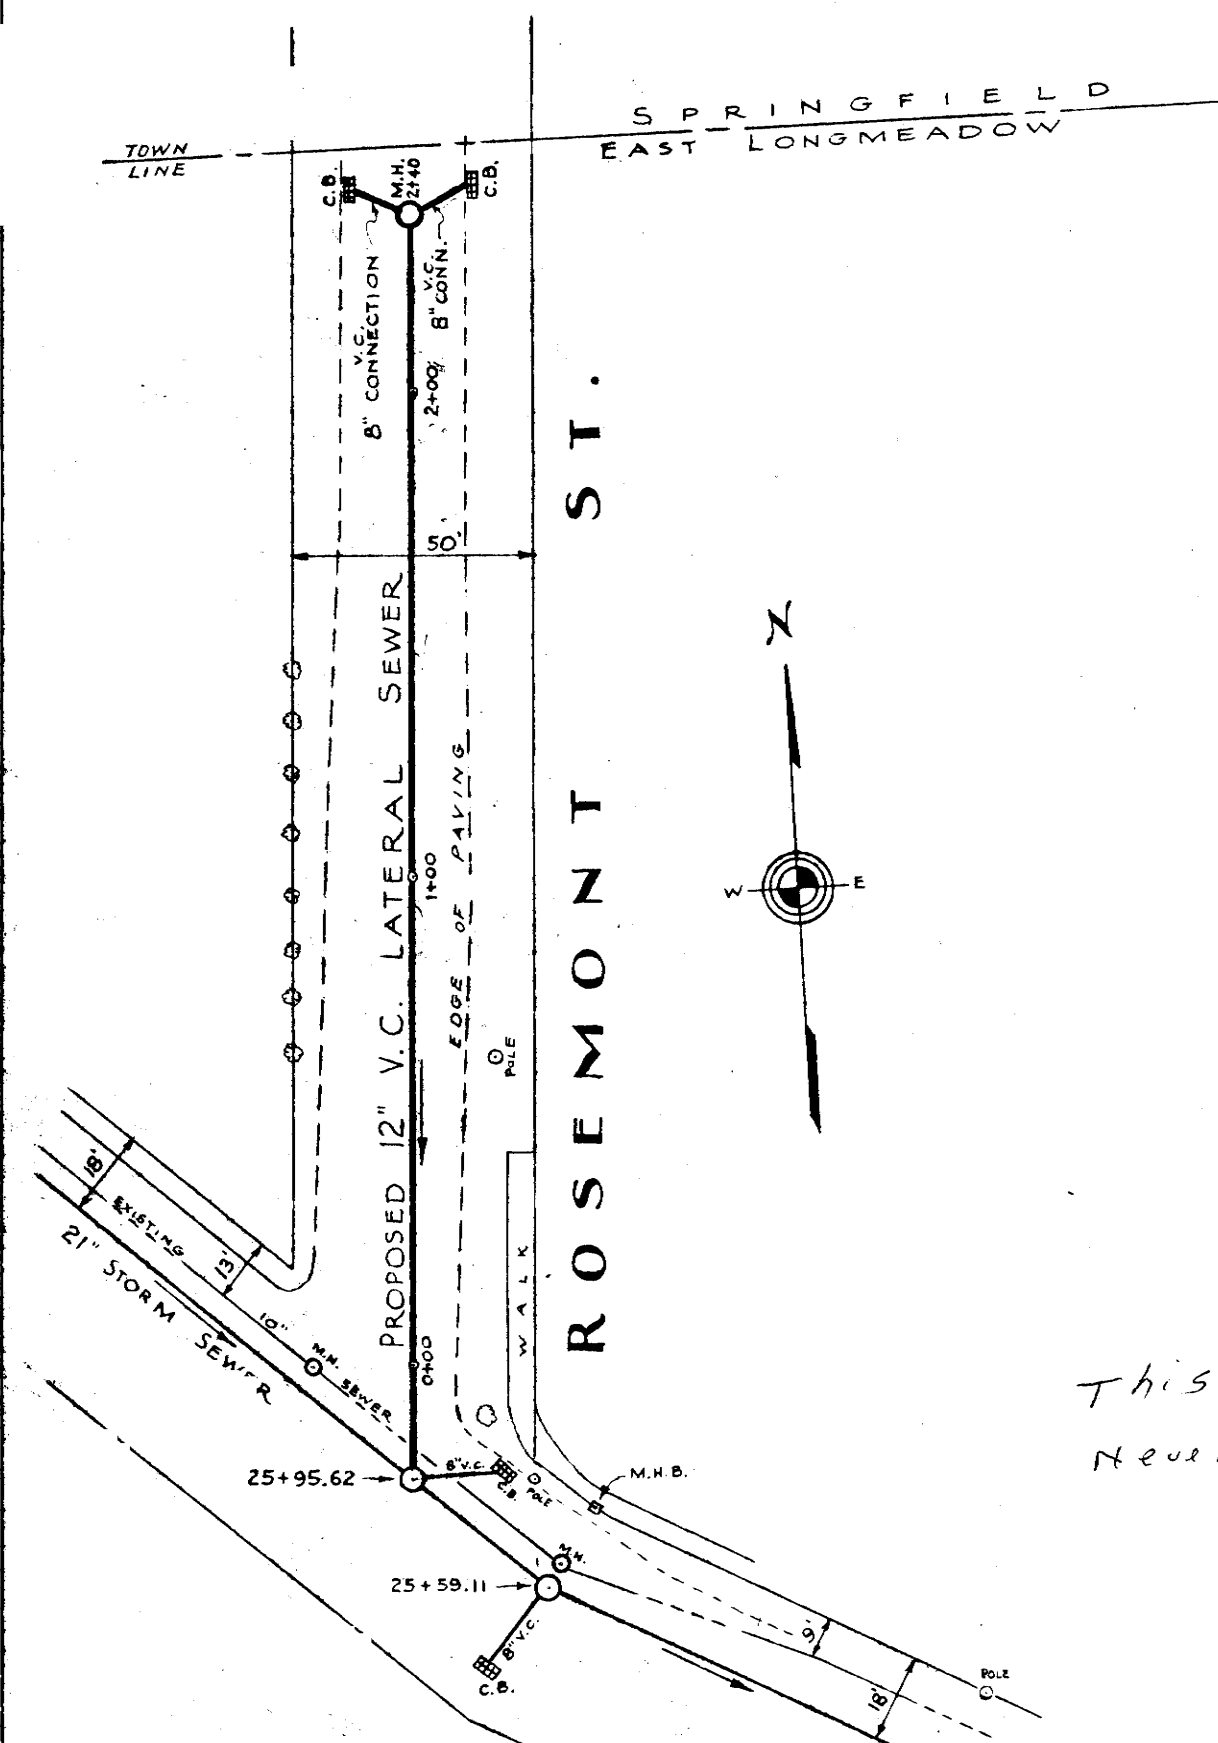

*This proposed work
never constructed.*

