


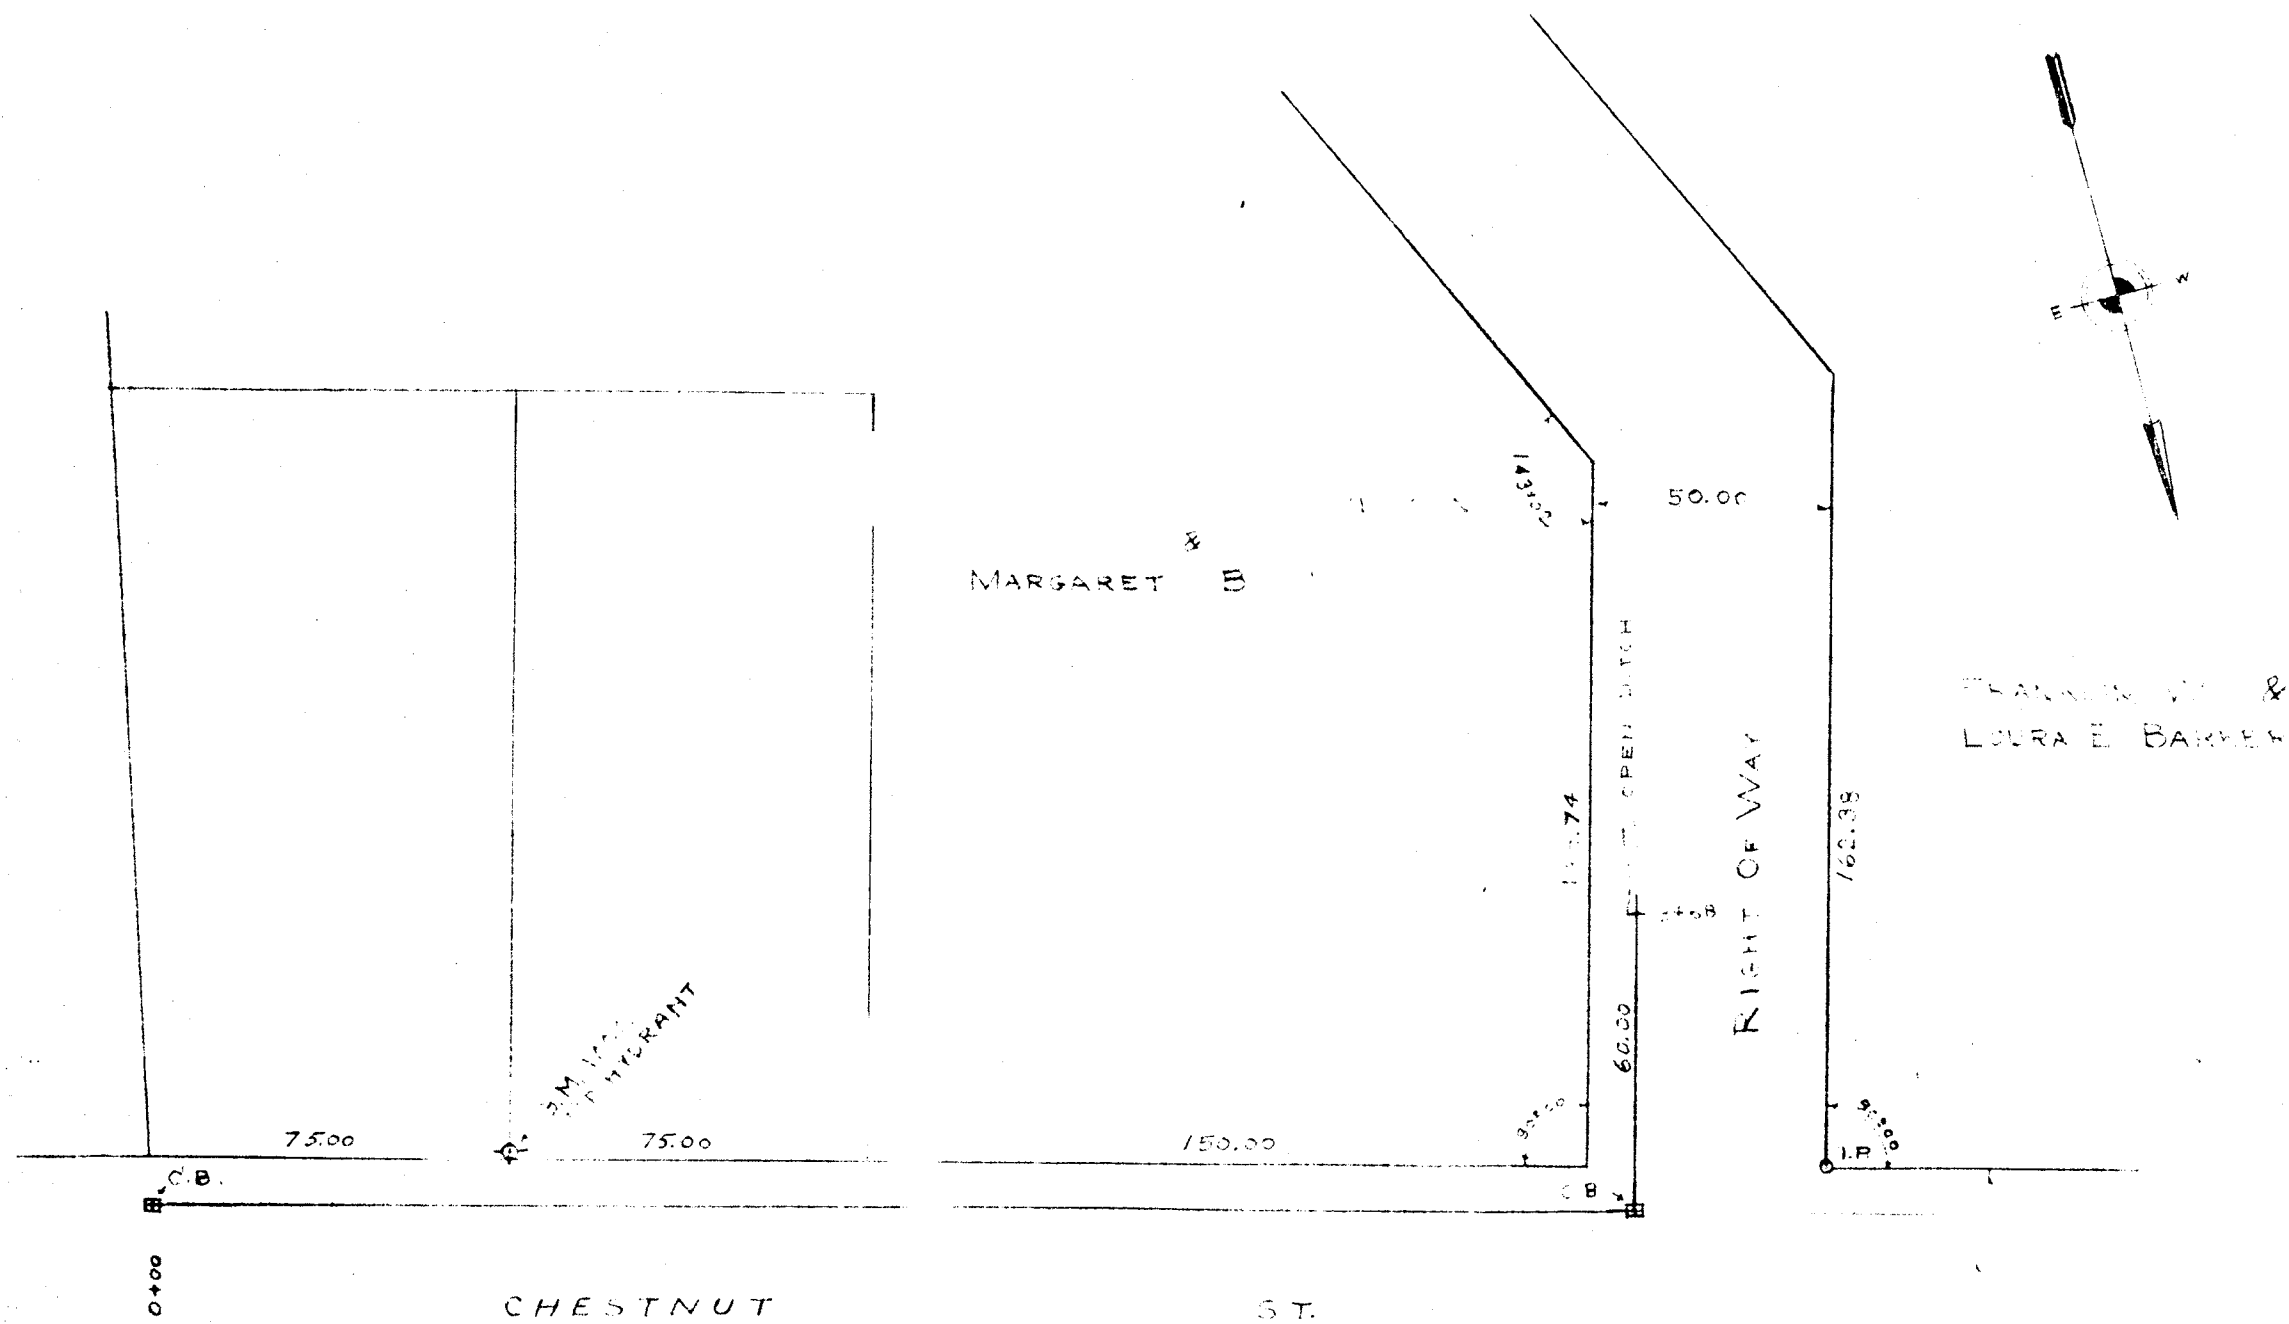

PLAN OF STORM SEWER  
ON CHESTNUT ST. ON RIGHT OF WAY  
OWNED BY GENERAL PROPERTY IMPROVEMENT CO  
BOARD OF PUBLIC WORKS  
TOWN OF EAST LONGMEADOW, MASS.  
SCALE HORZ 1" = 40'  
VERT 1" = 4' AUG. 1957

