
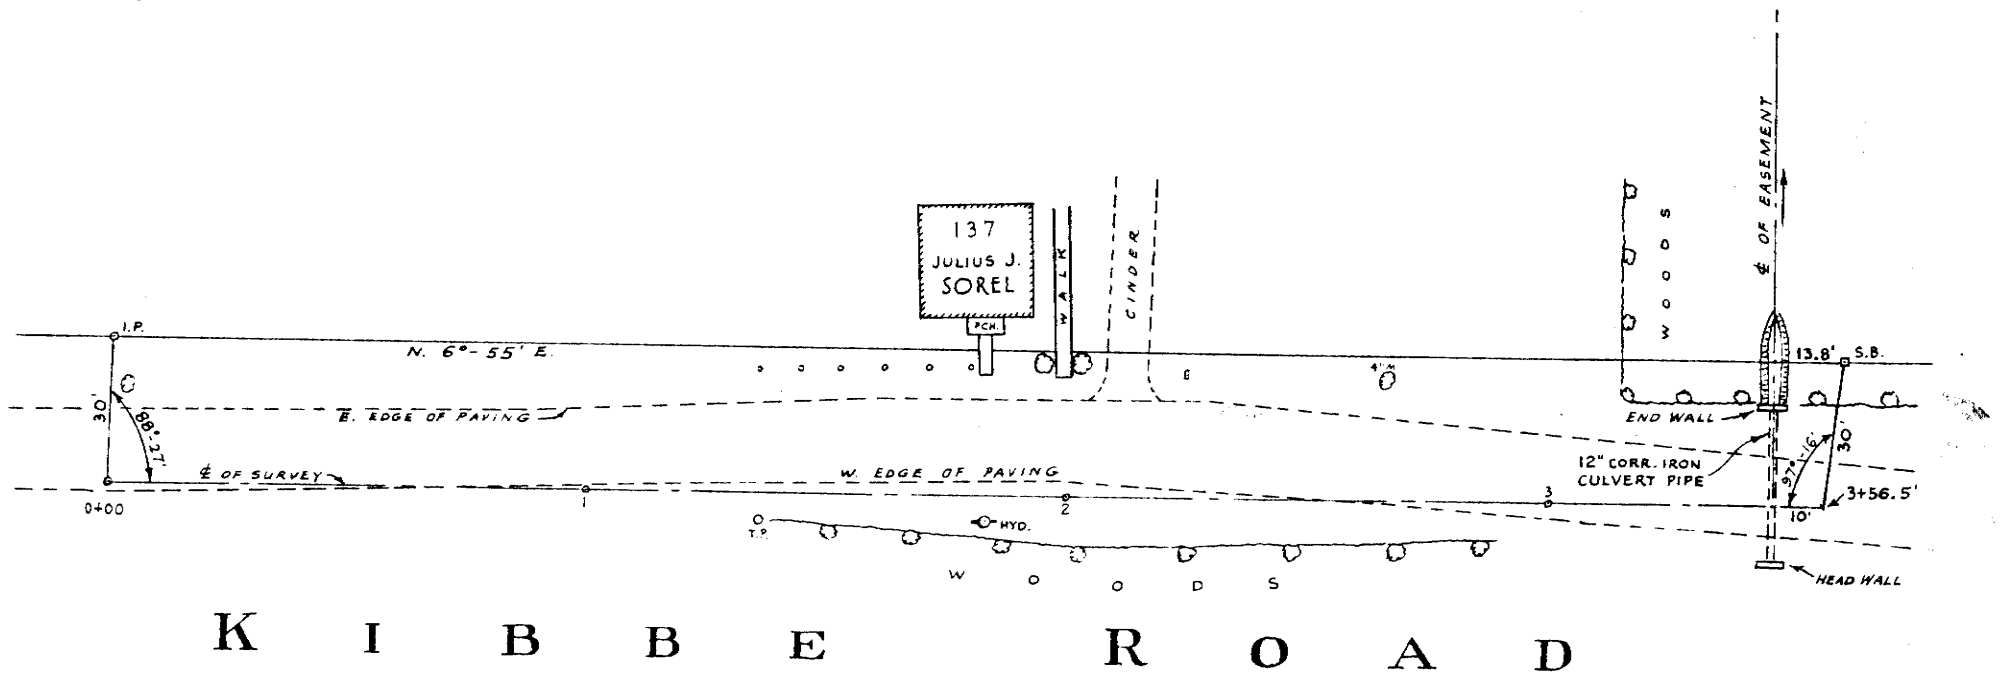


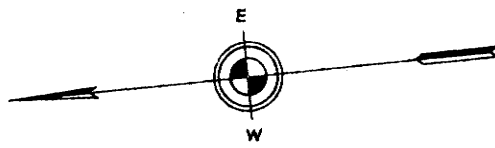

**NOTE:**

DITCH TO BE LOCATED BETWEEN TOE  
OF SLOPE AND WEST EDGE OF PAVING.  
BOTTOM OF DITCH TO BE PAVED WITH  
12" OF GRAVEL, PENETRATED AND SEALED.  
TOP OF BOTH CONCRETE END WALLS TO BE  
ON LEVEL WITH PAVING.

**KIBBE ROAD STORM DRAIN**  
*JULIUS J. SOREL PROPERTY*

BOARD OF SELECTMEN  
**TOWN OF EAST LONGMEADOW, MASS.**

TIGHE & BOND, CONSULTING ENGINEERS,  
HOLYOKE, MASS.,

HORZ. 1" = 40'  
SCALE: VERT. 1" = 4'

JULY, 1951

