
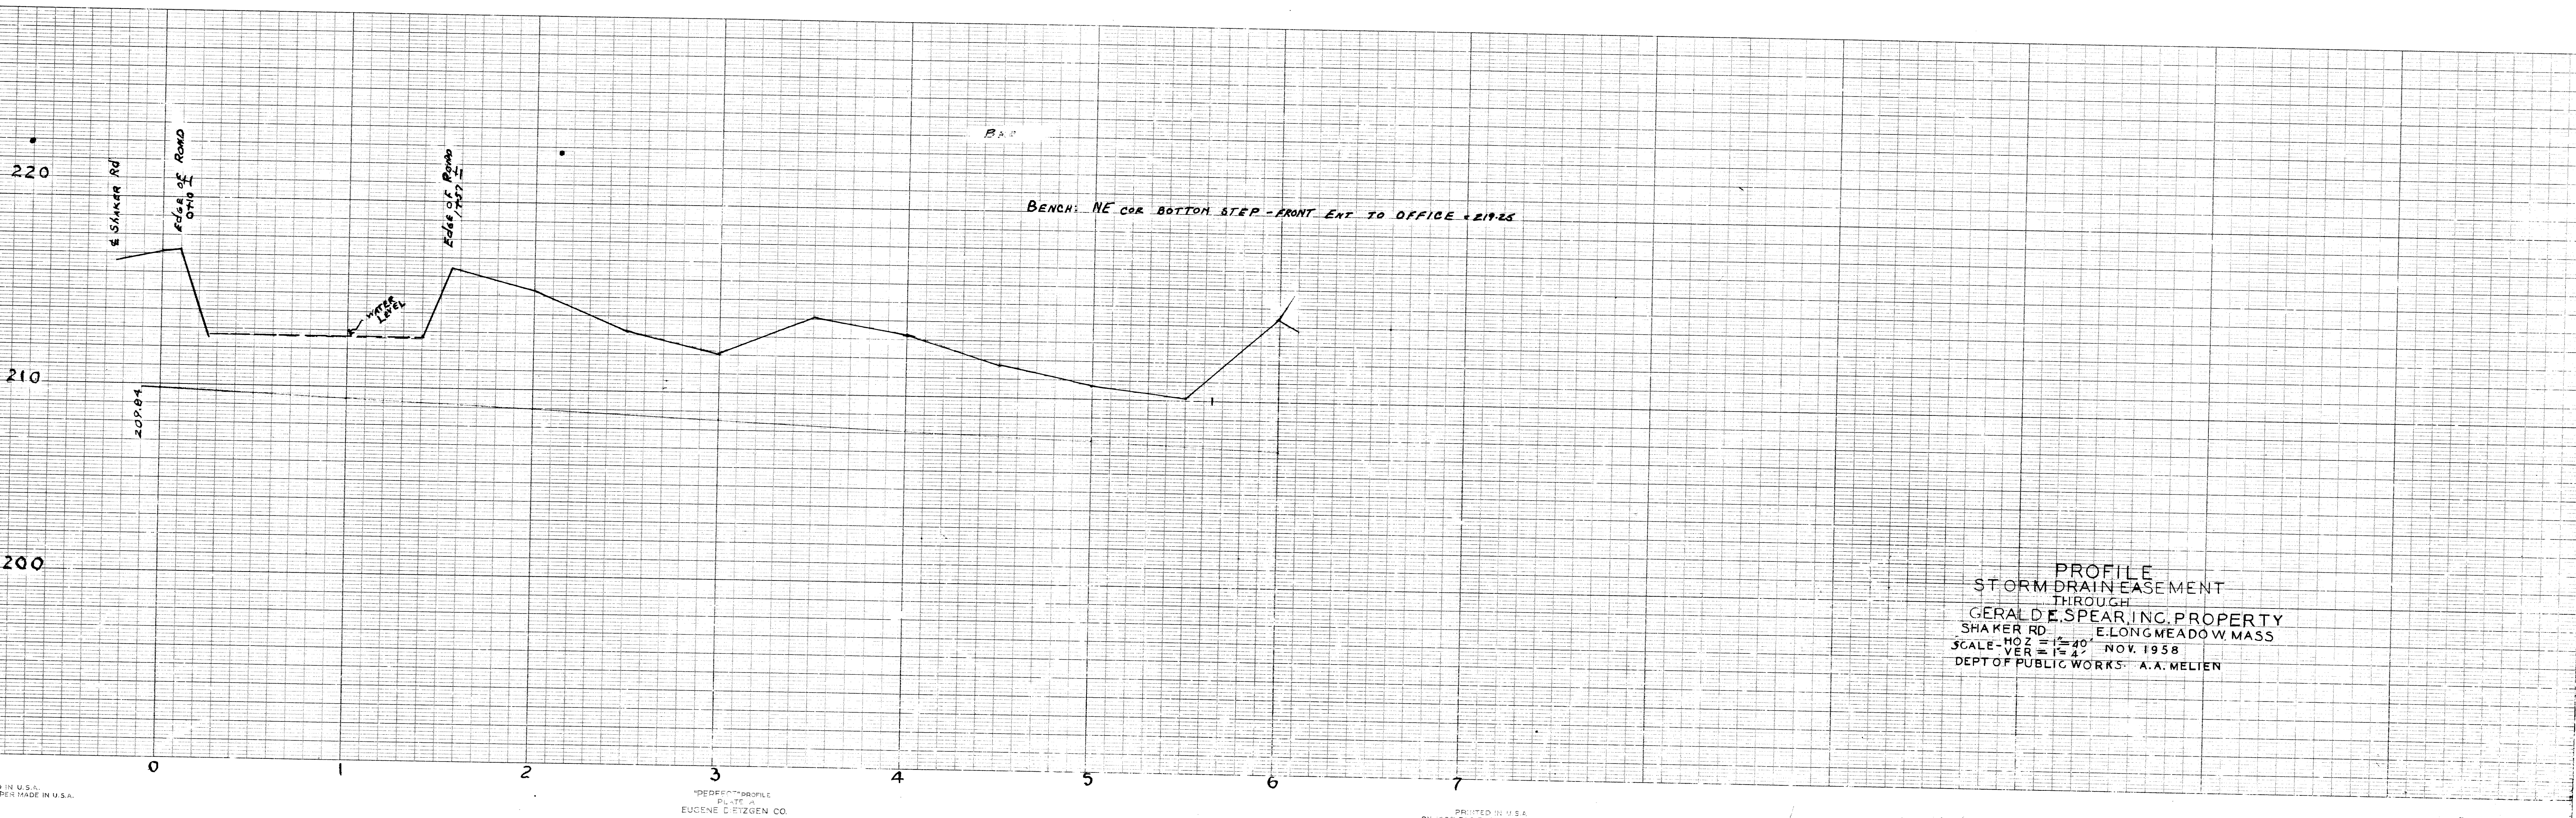


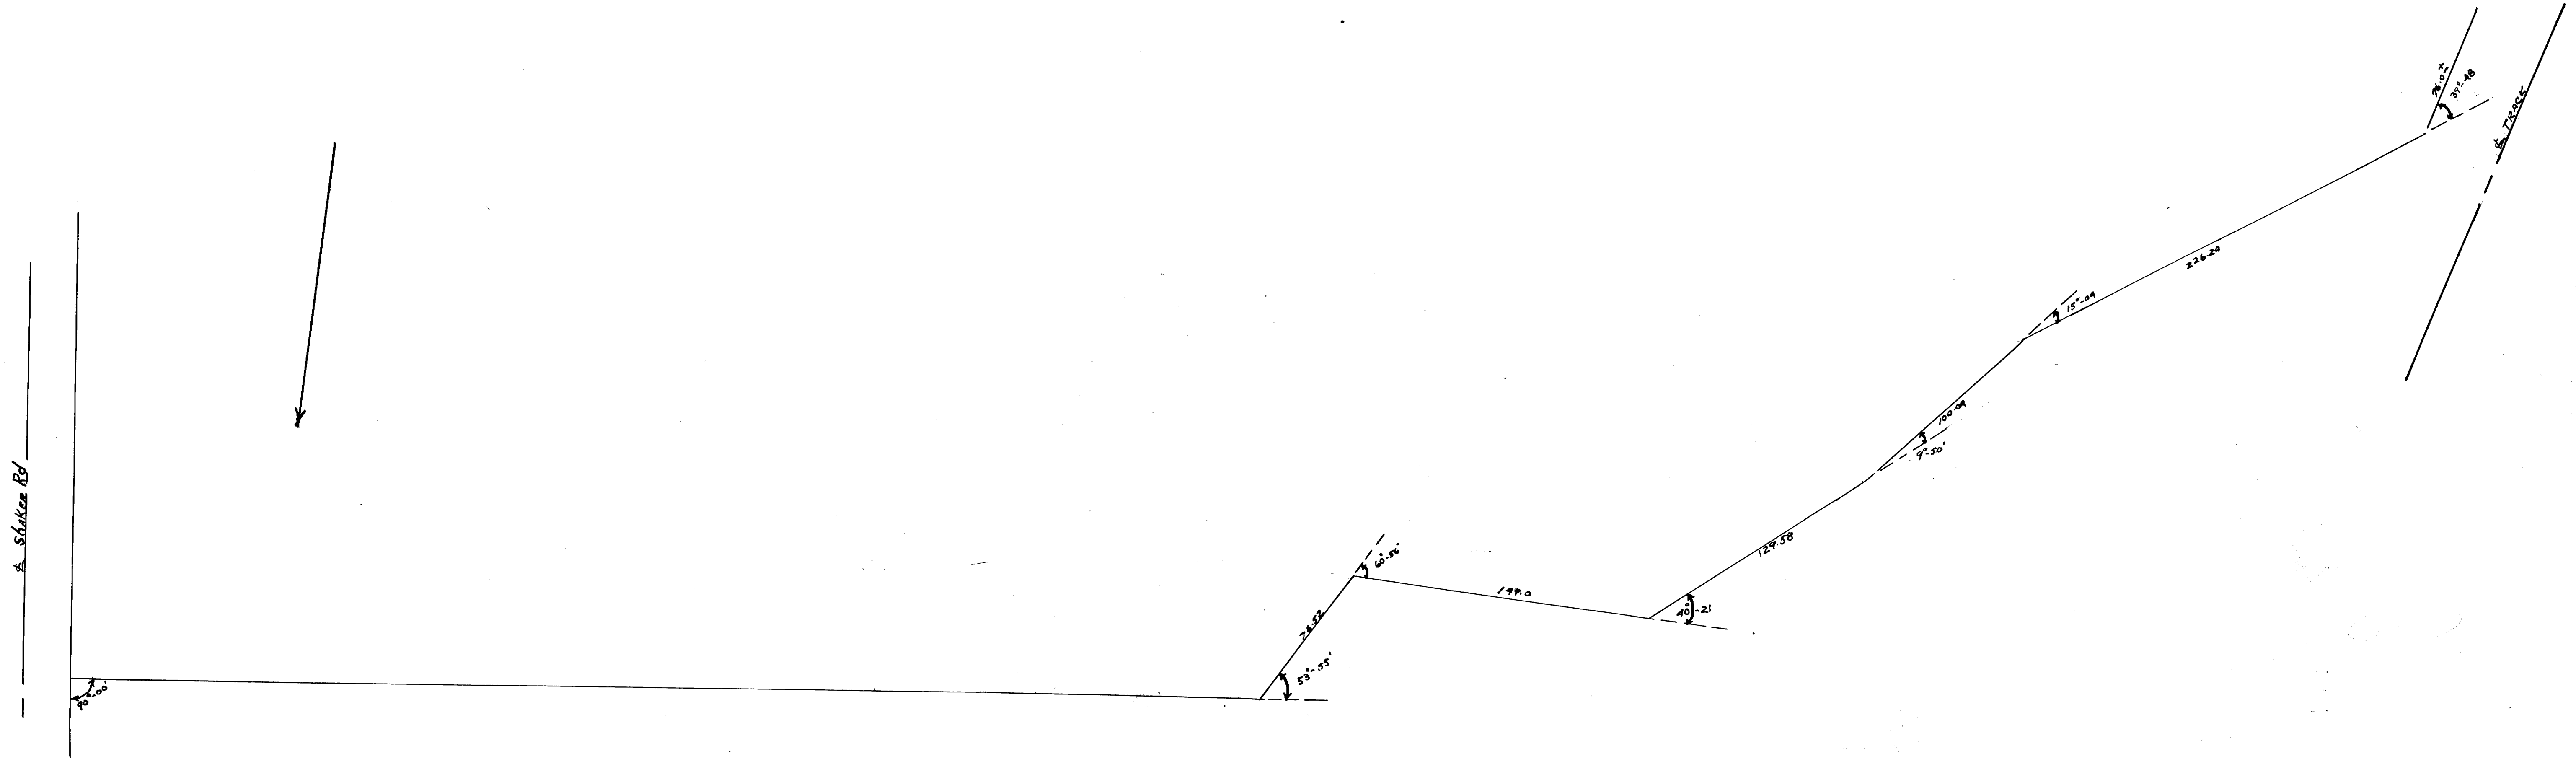

PROFILE
 STORM DRAIN EASEMENT
 THROUGH
 GERALD E. SPEAR, INC. PROPERTY
 SHAKER RD. E. LONGMEADOW MASS
 SCALE - HORIZ = 1" = 40' NOV. 1958
 DEPT OF PUBLIC WORKS A.A. MELIEN