



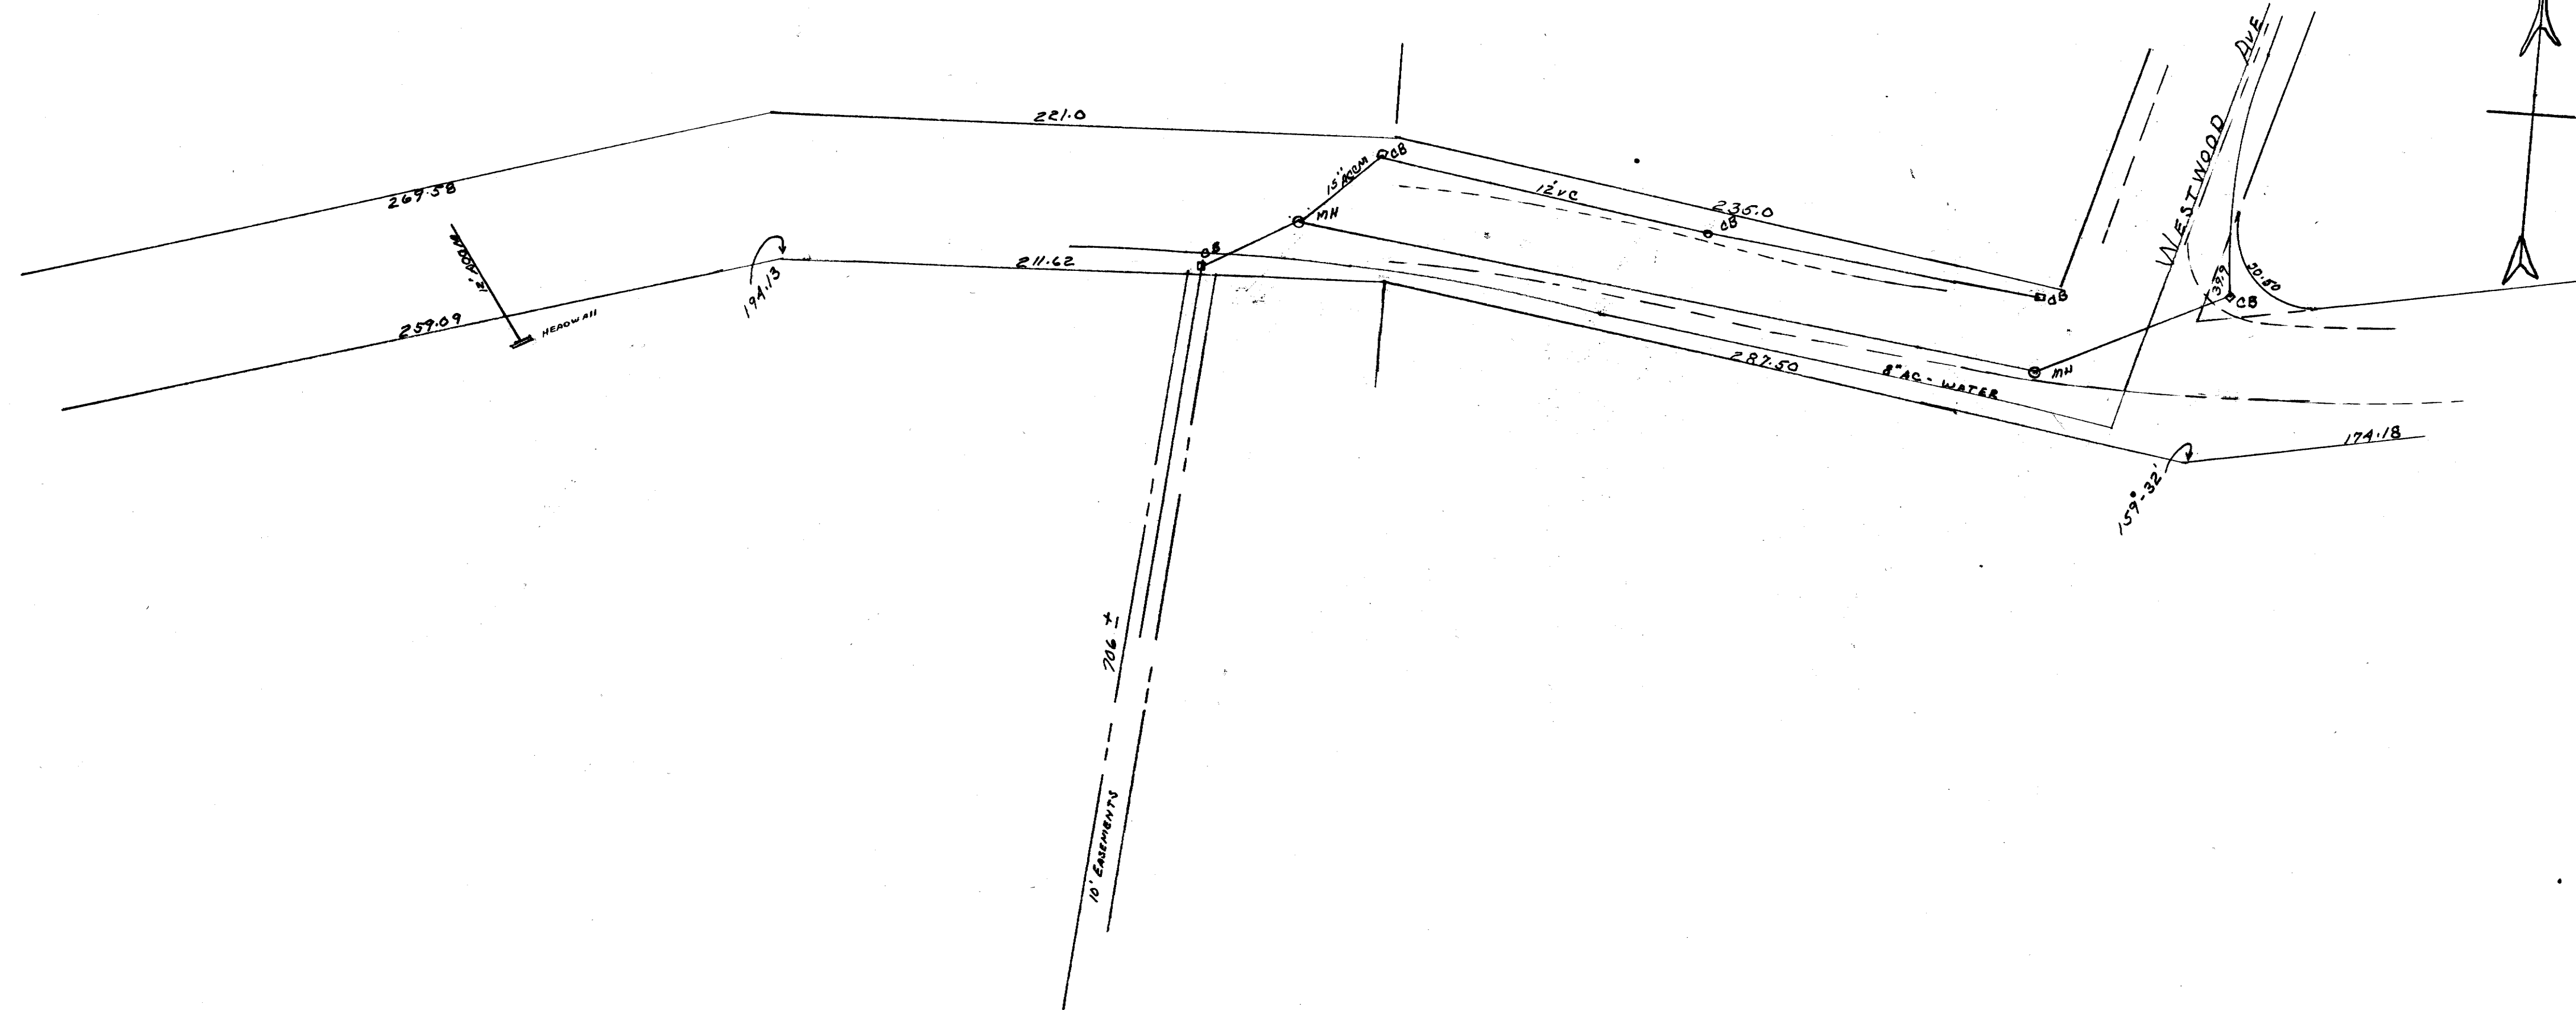

PROFILE TAKEN NORTH SIDE
OF MAPLE - EDGE OF ROAD
0+0 OF SAVOY AVE
STA MEAS. ON NORTH SIDE
OF ROAD.

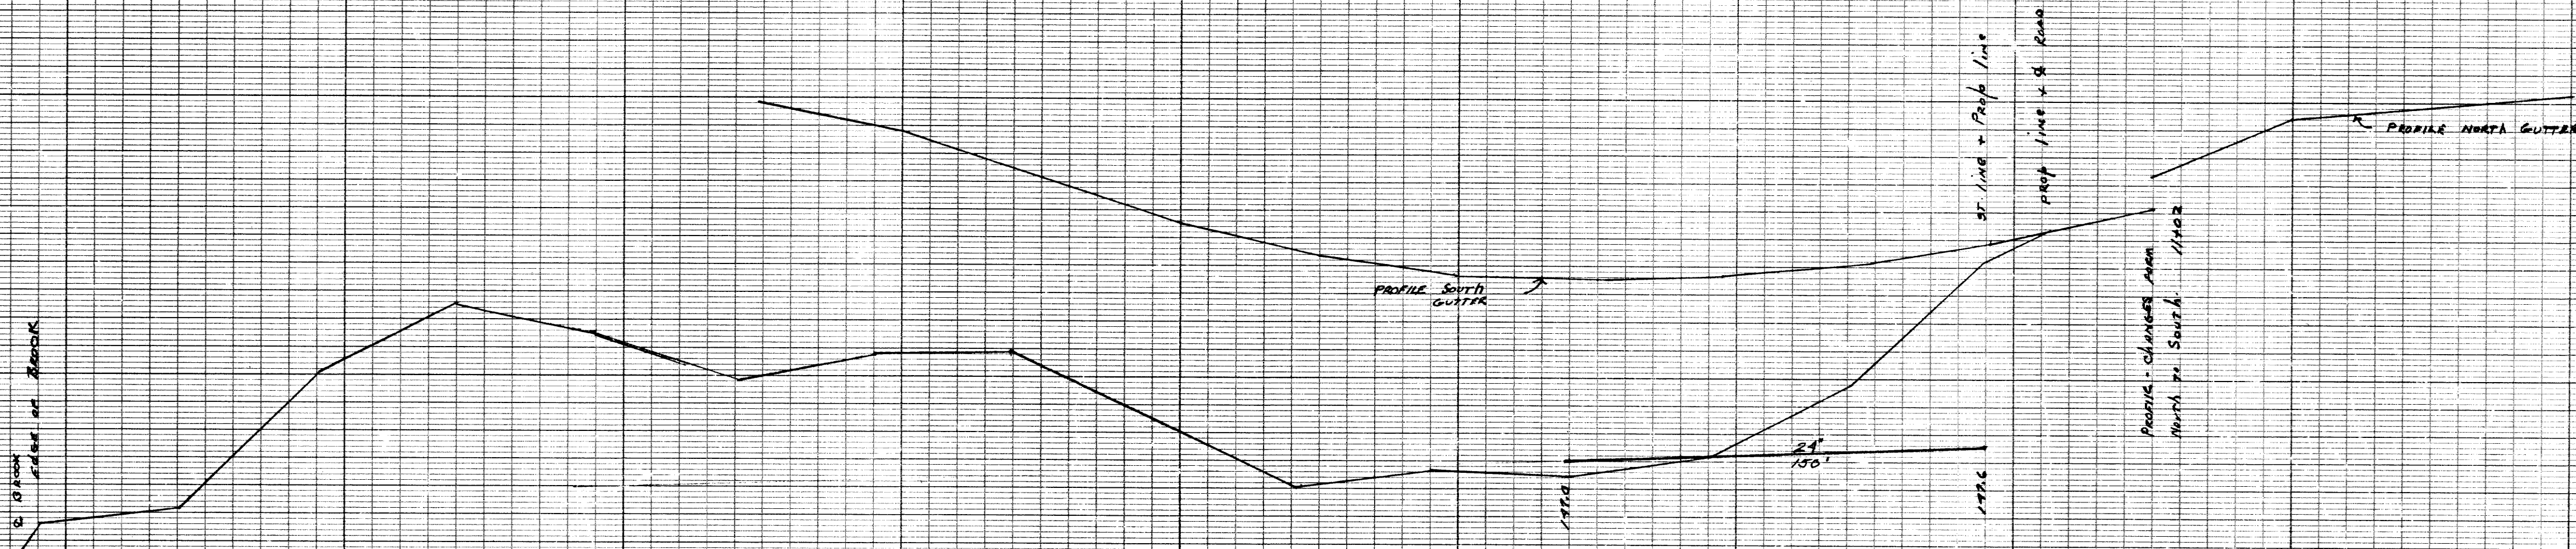

PLAN AND PROFILE
FOR
STORM WATER DRAINS + EASEMENTS
MAPLE STREET
DEPT OF PUBLIC WORKS
TOWN OF EAST LONGMEADOW
SCALE = 1" = 40' HORIZ
1" = 4' VERT AA. MELLEN - ENG