



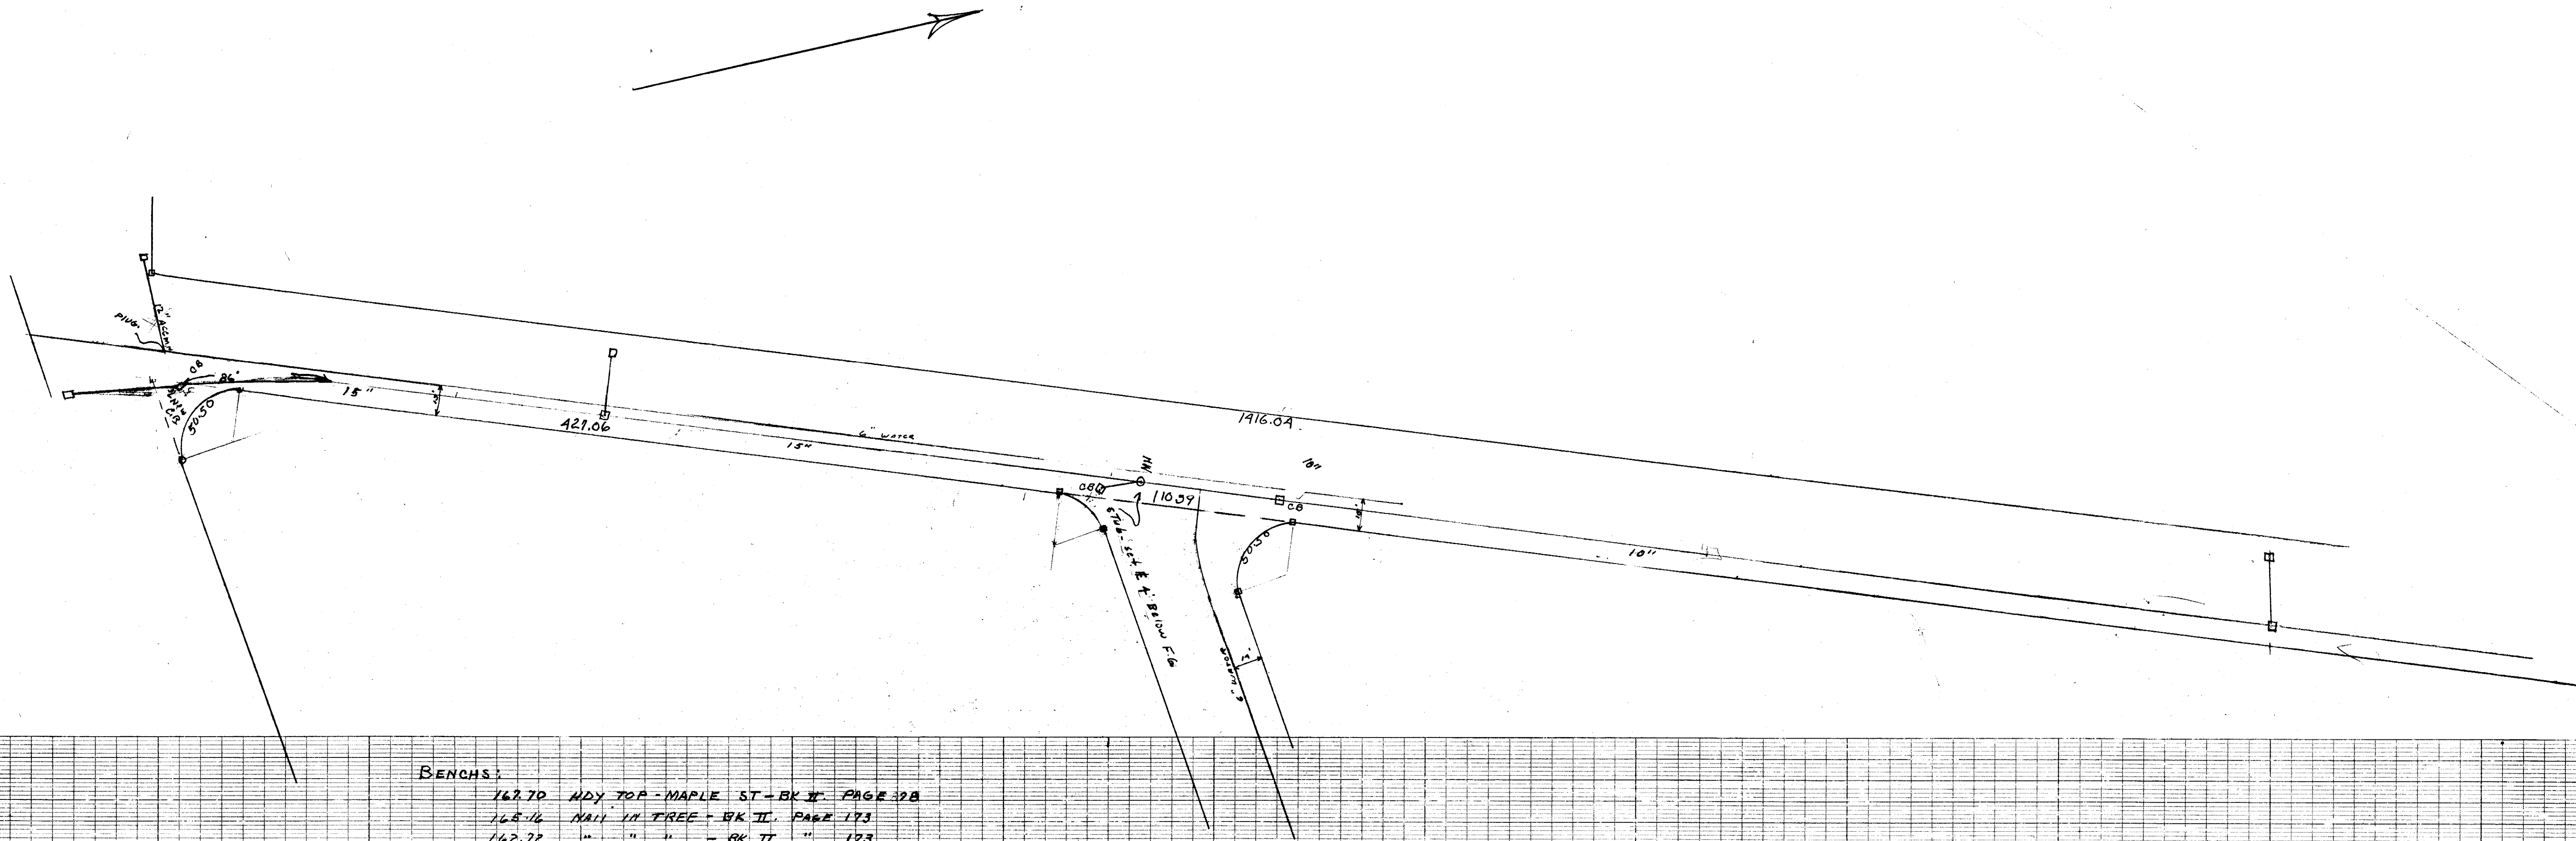

BENCHS:
 162.70 Hdy TOP - MAPLE ST - BK II. PAGE 28
 165.16 NAIL IN TREE - BK II. PAGE 173
 162.72 " " " - BK II. " 173

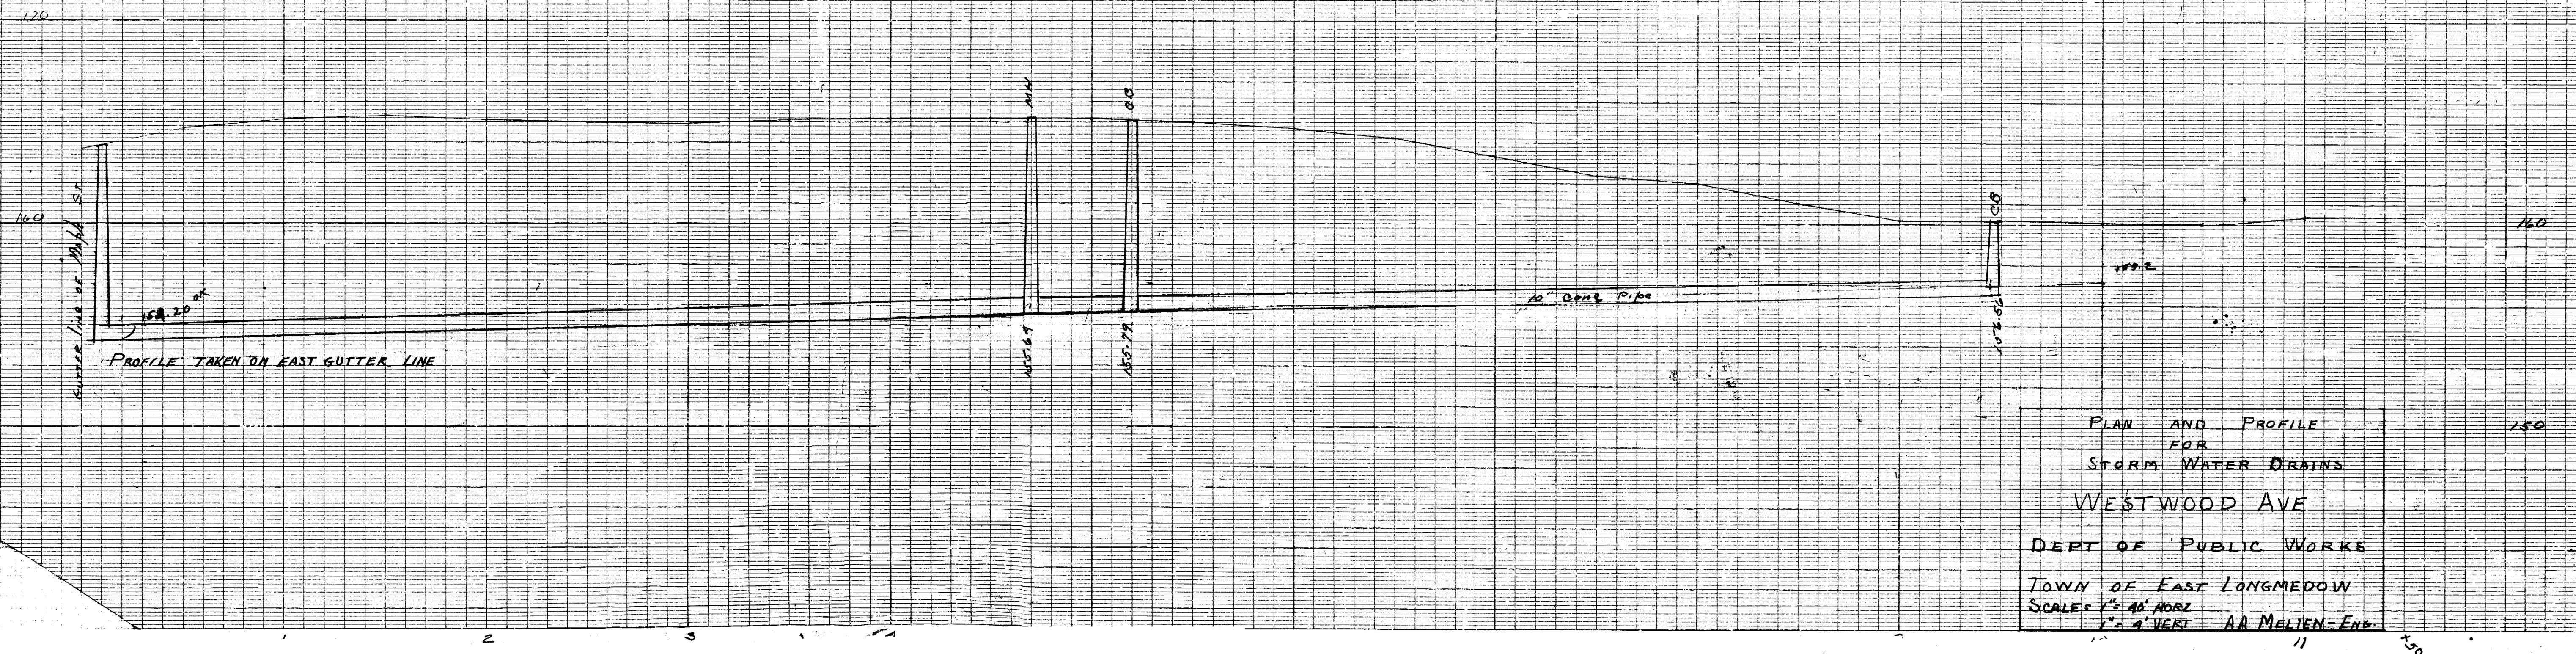

PLAN AND PROFILE
 FOR
 STORM WATER DRAINS
 WESTWOOD AVE
 DEPT OF PUBLIC WORKS
 TOWN OF EAST LONGMEADOW
 SCALE: 1" = 40' HORIZ
 1" = 4' VERT AA MELLEN-ENG