


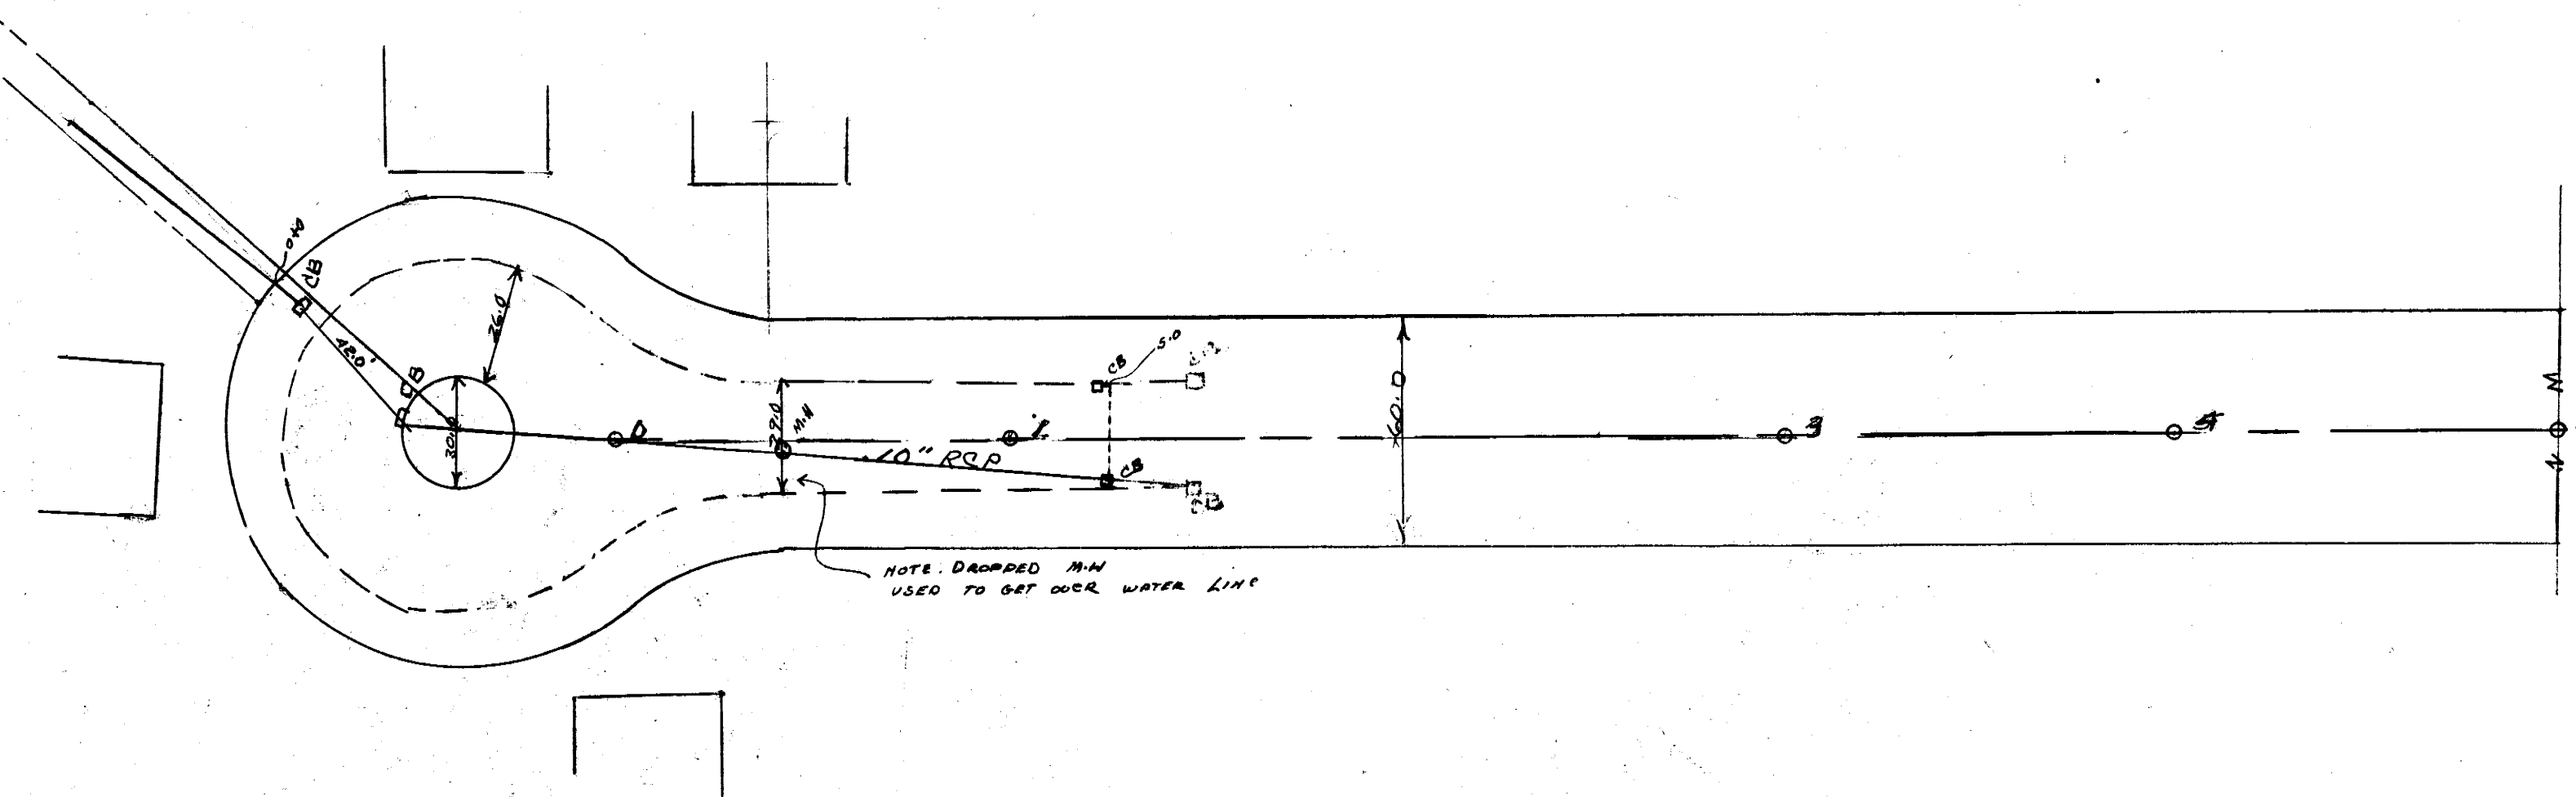


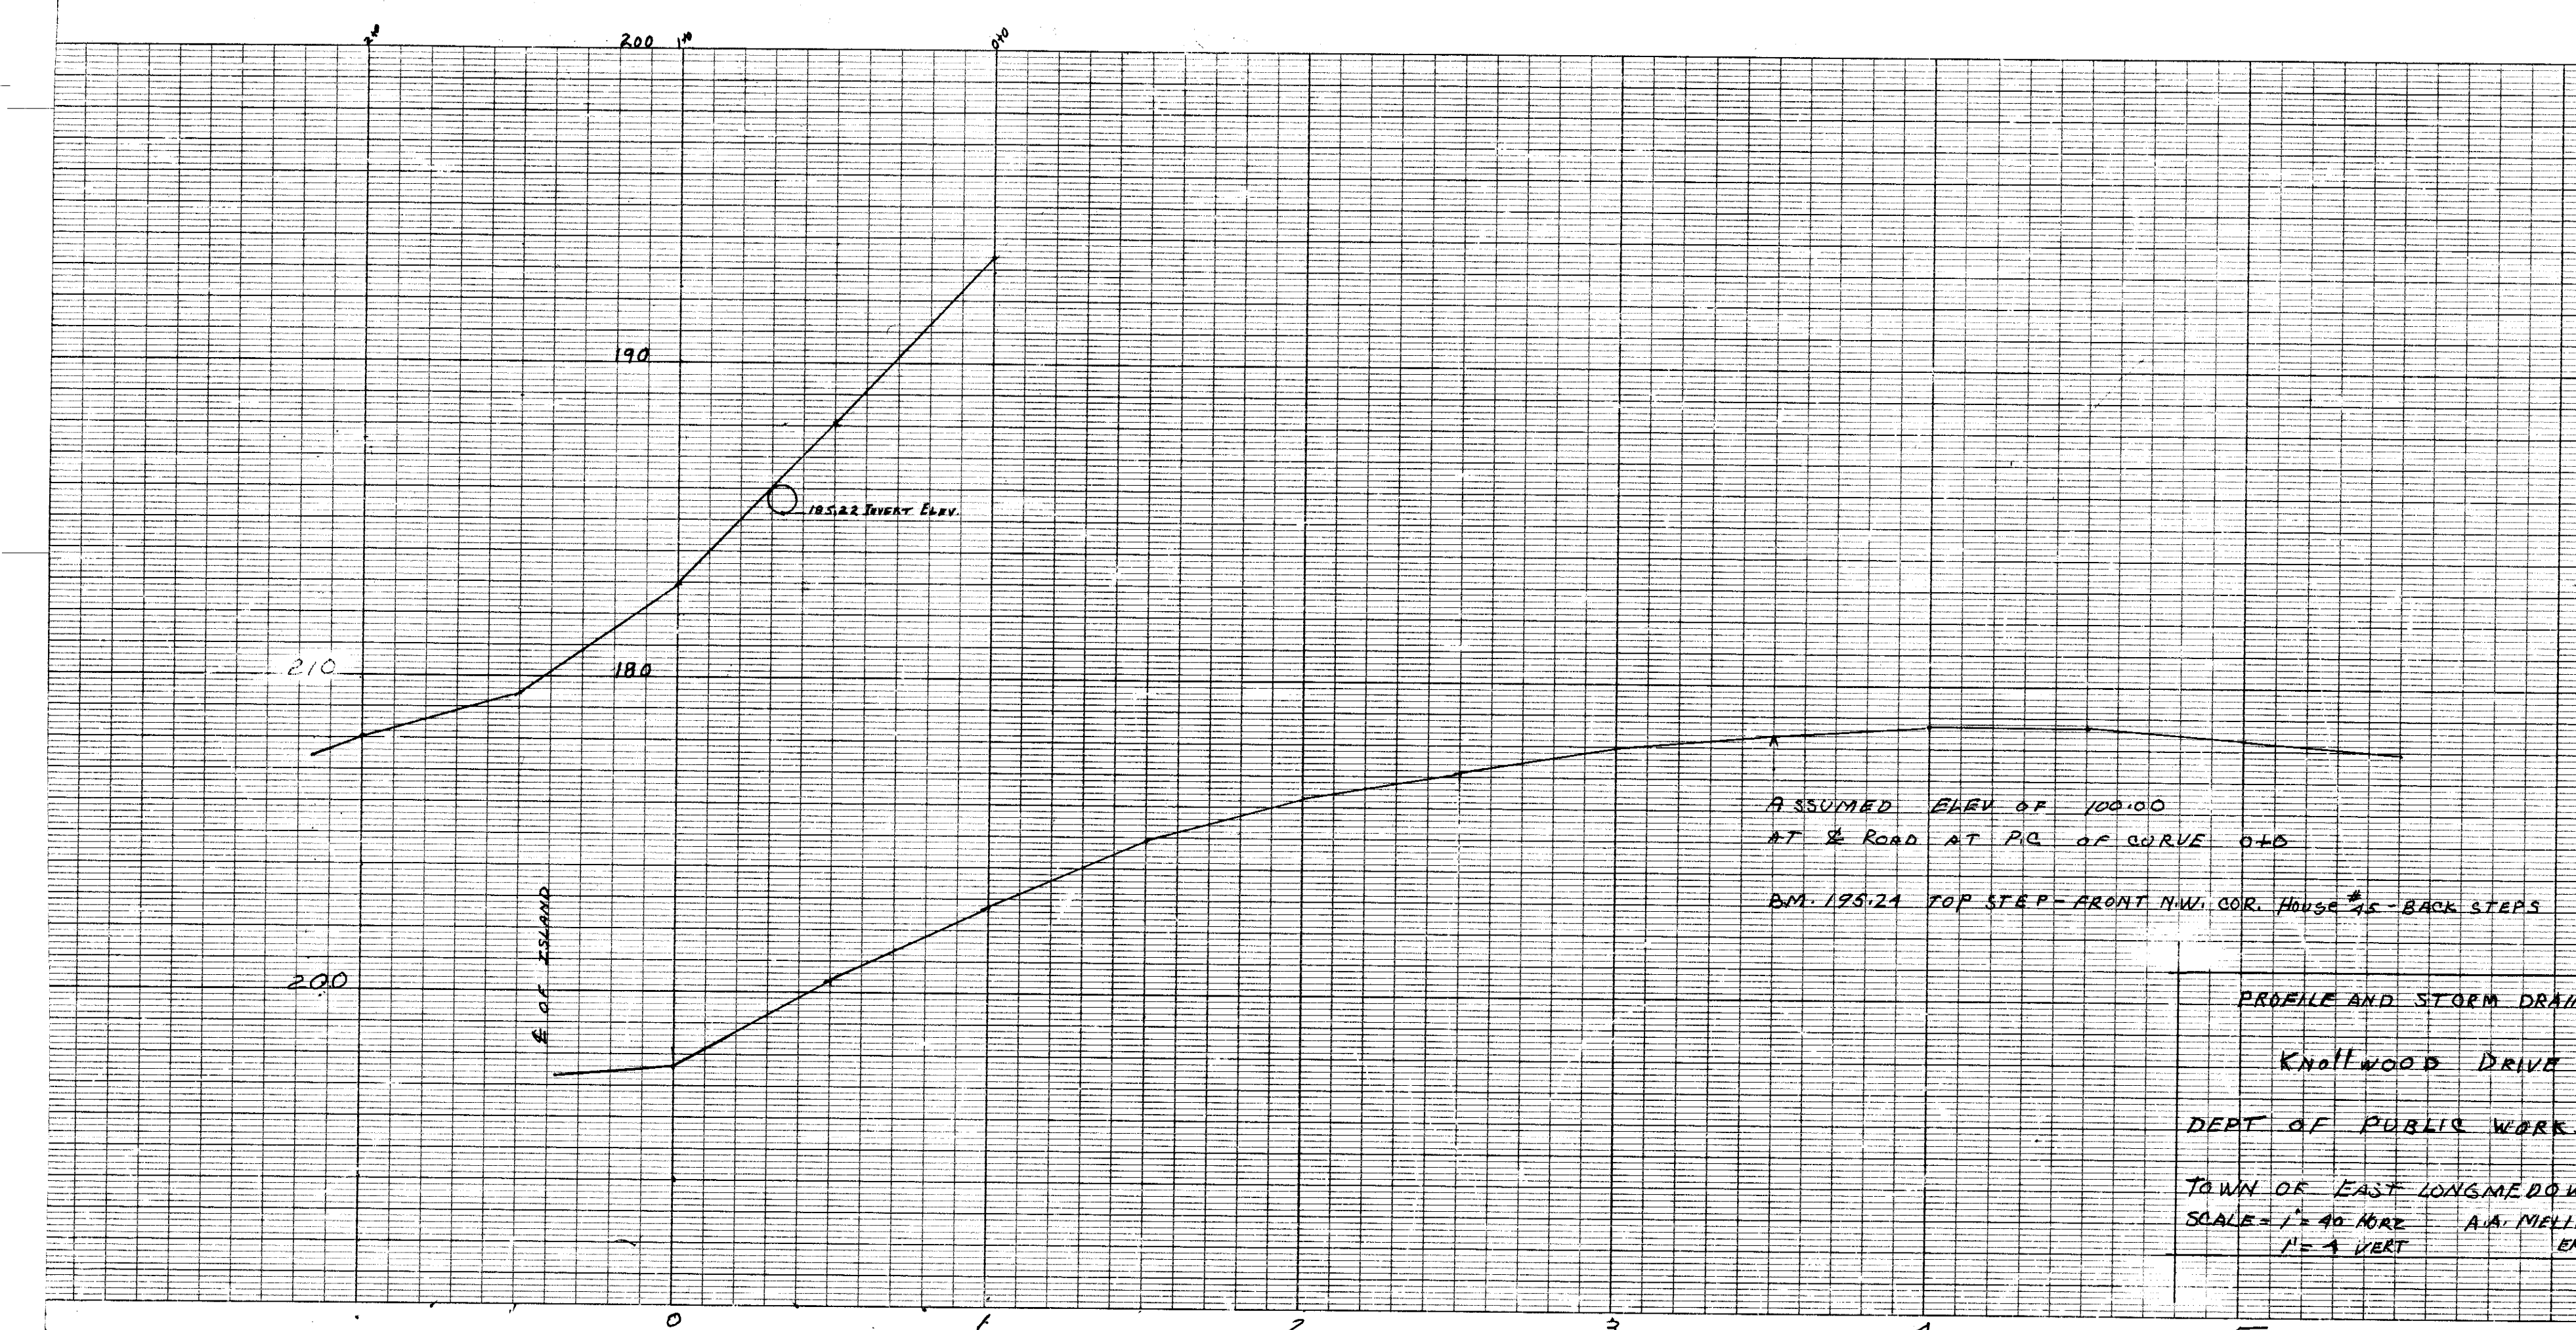

Knollwood Drive

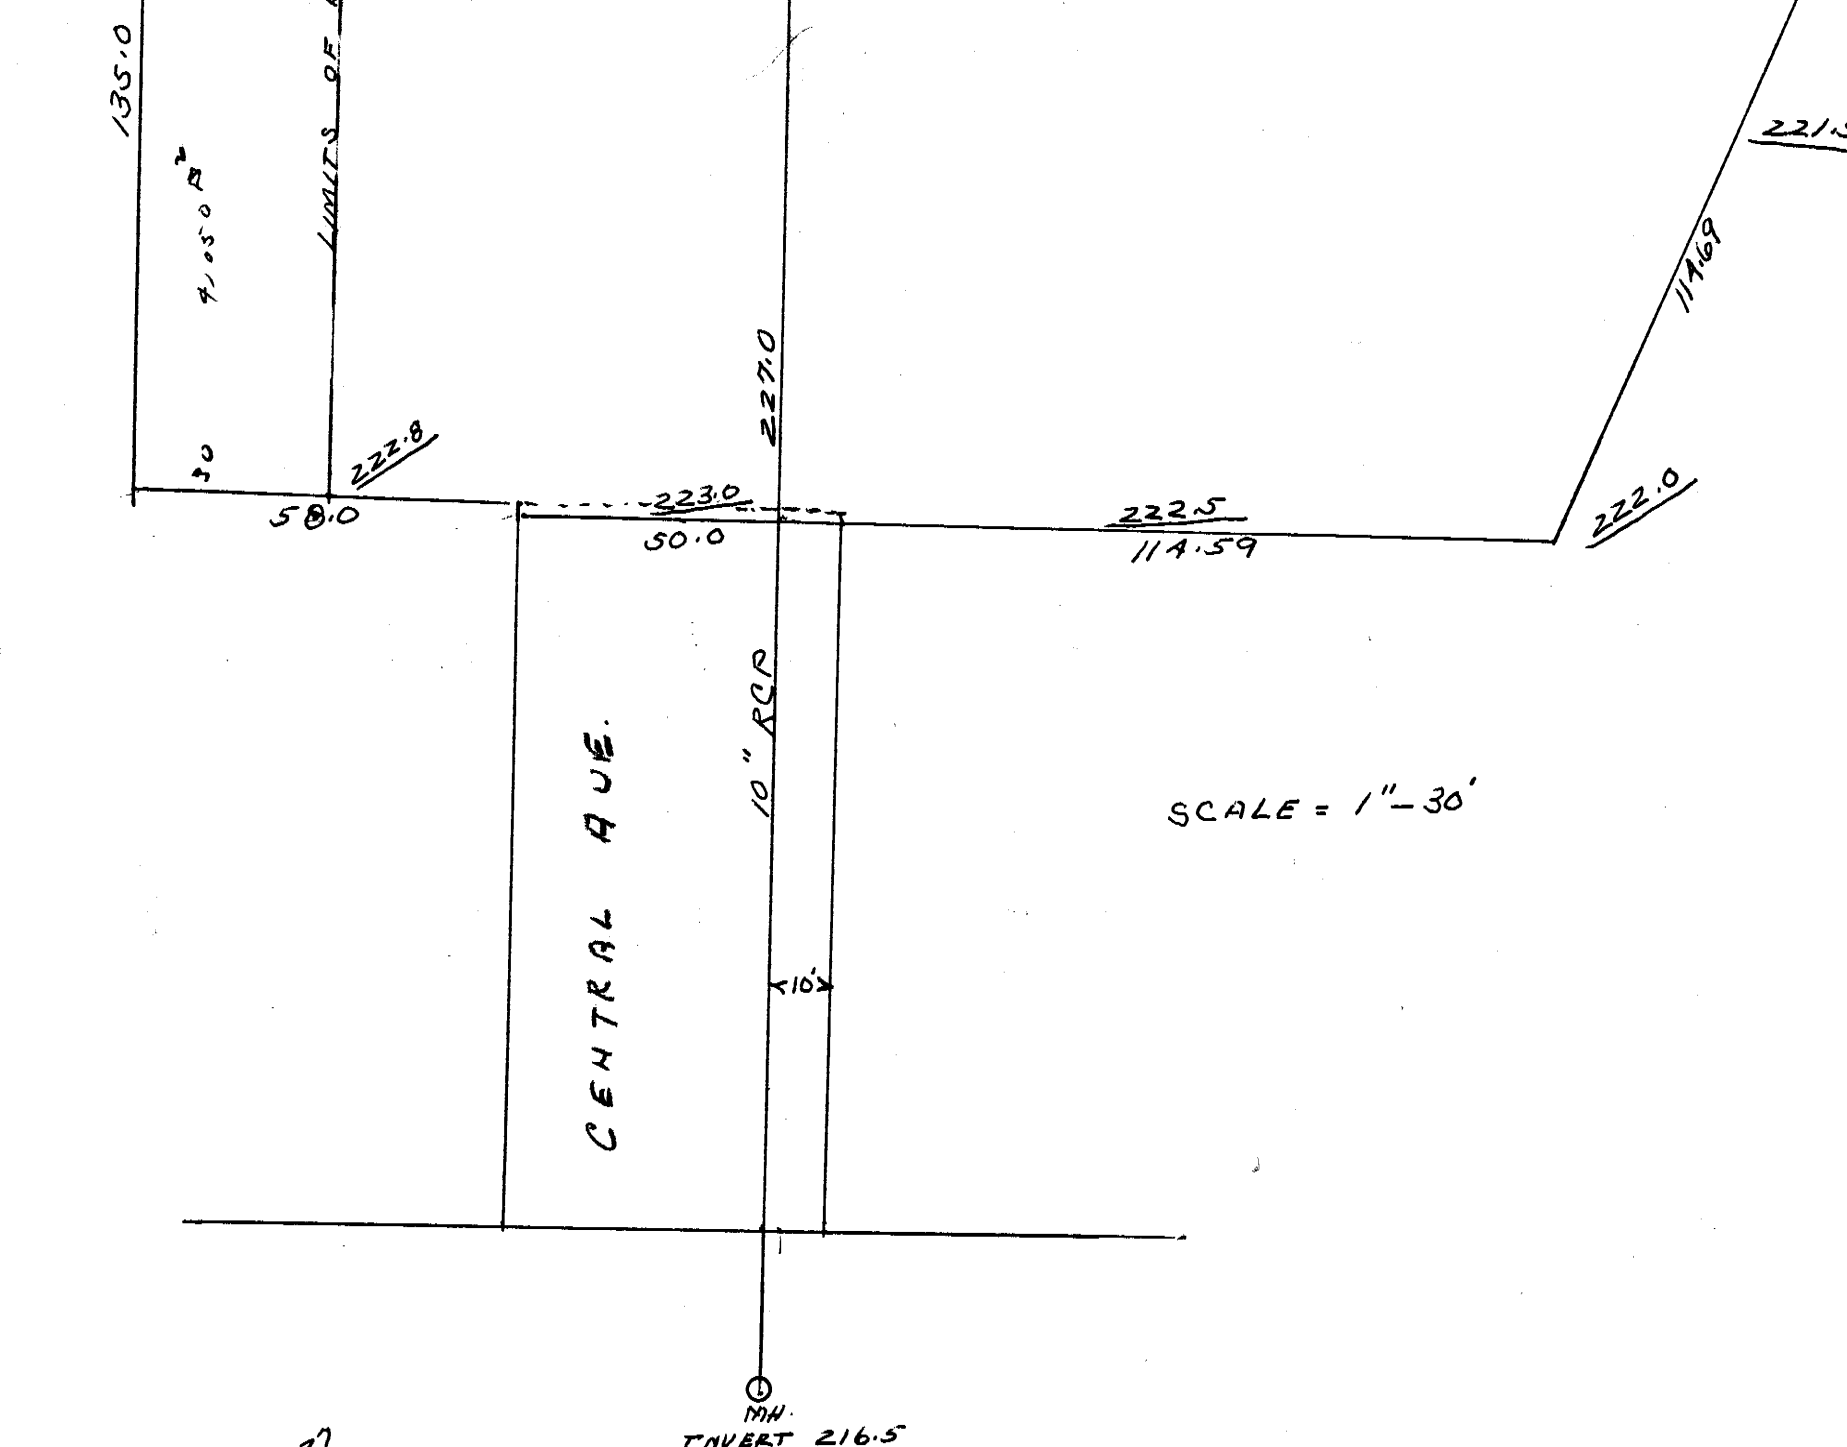

PROFILE AND STORM DRAIN
Knollwood Drive
DEPT. OF PUBLIC WORKS
TOWN OF EAST LONGMEADOW
SCALE = 1" = 40' HORIZ.
1" = 4' VERT
E.M.G.

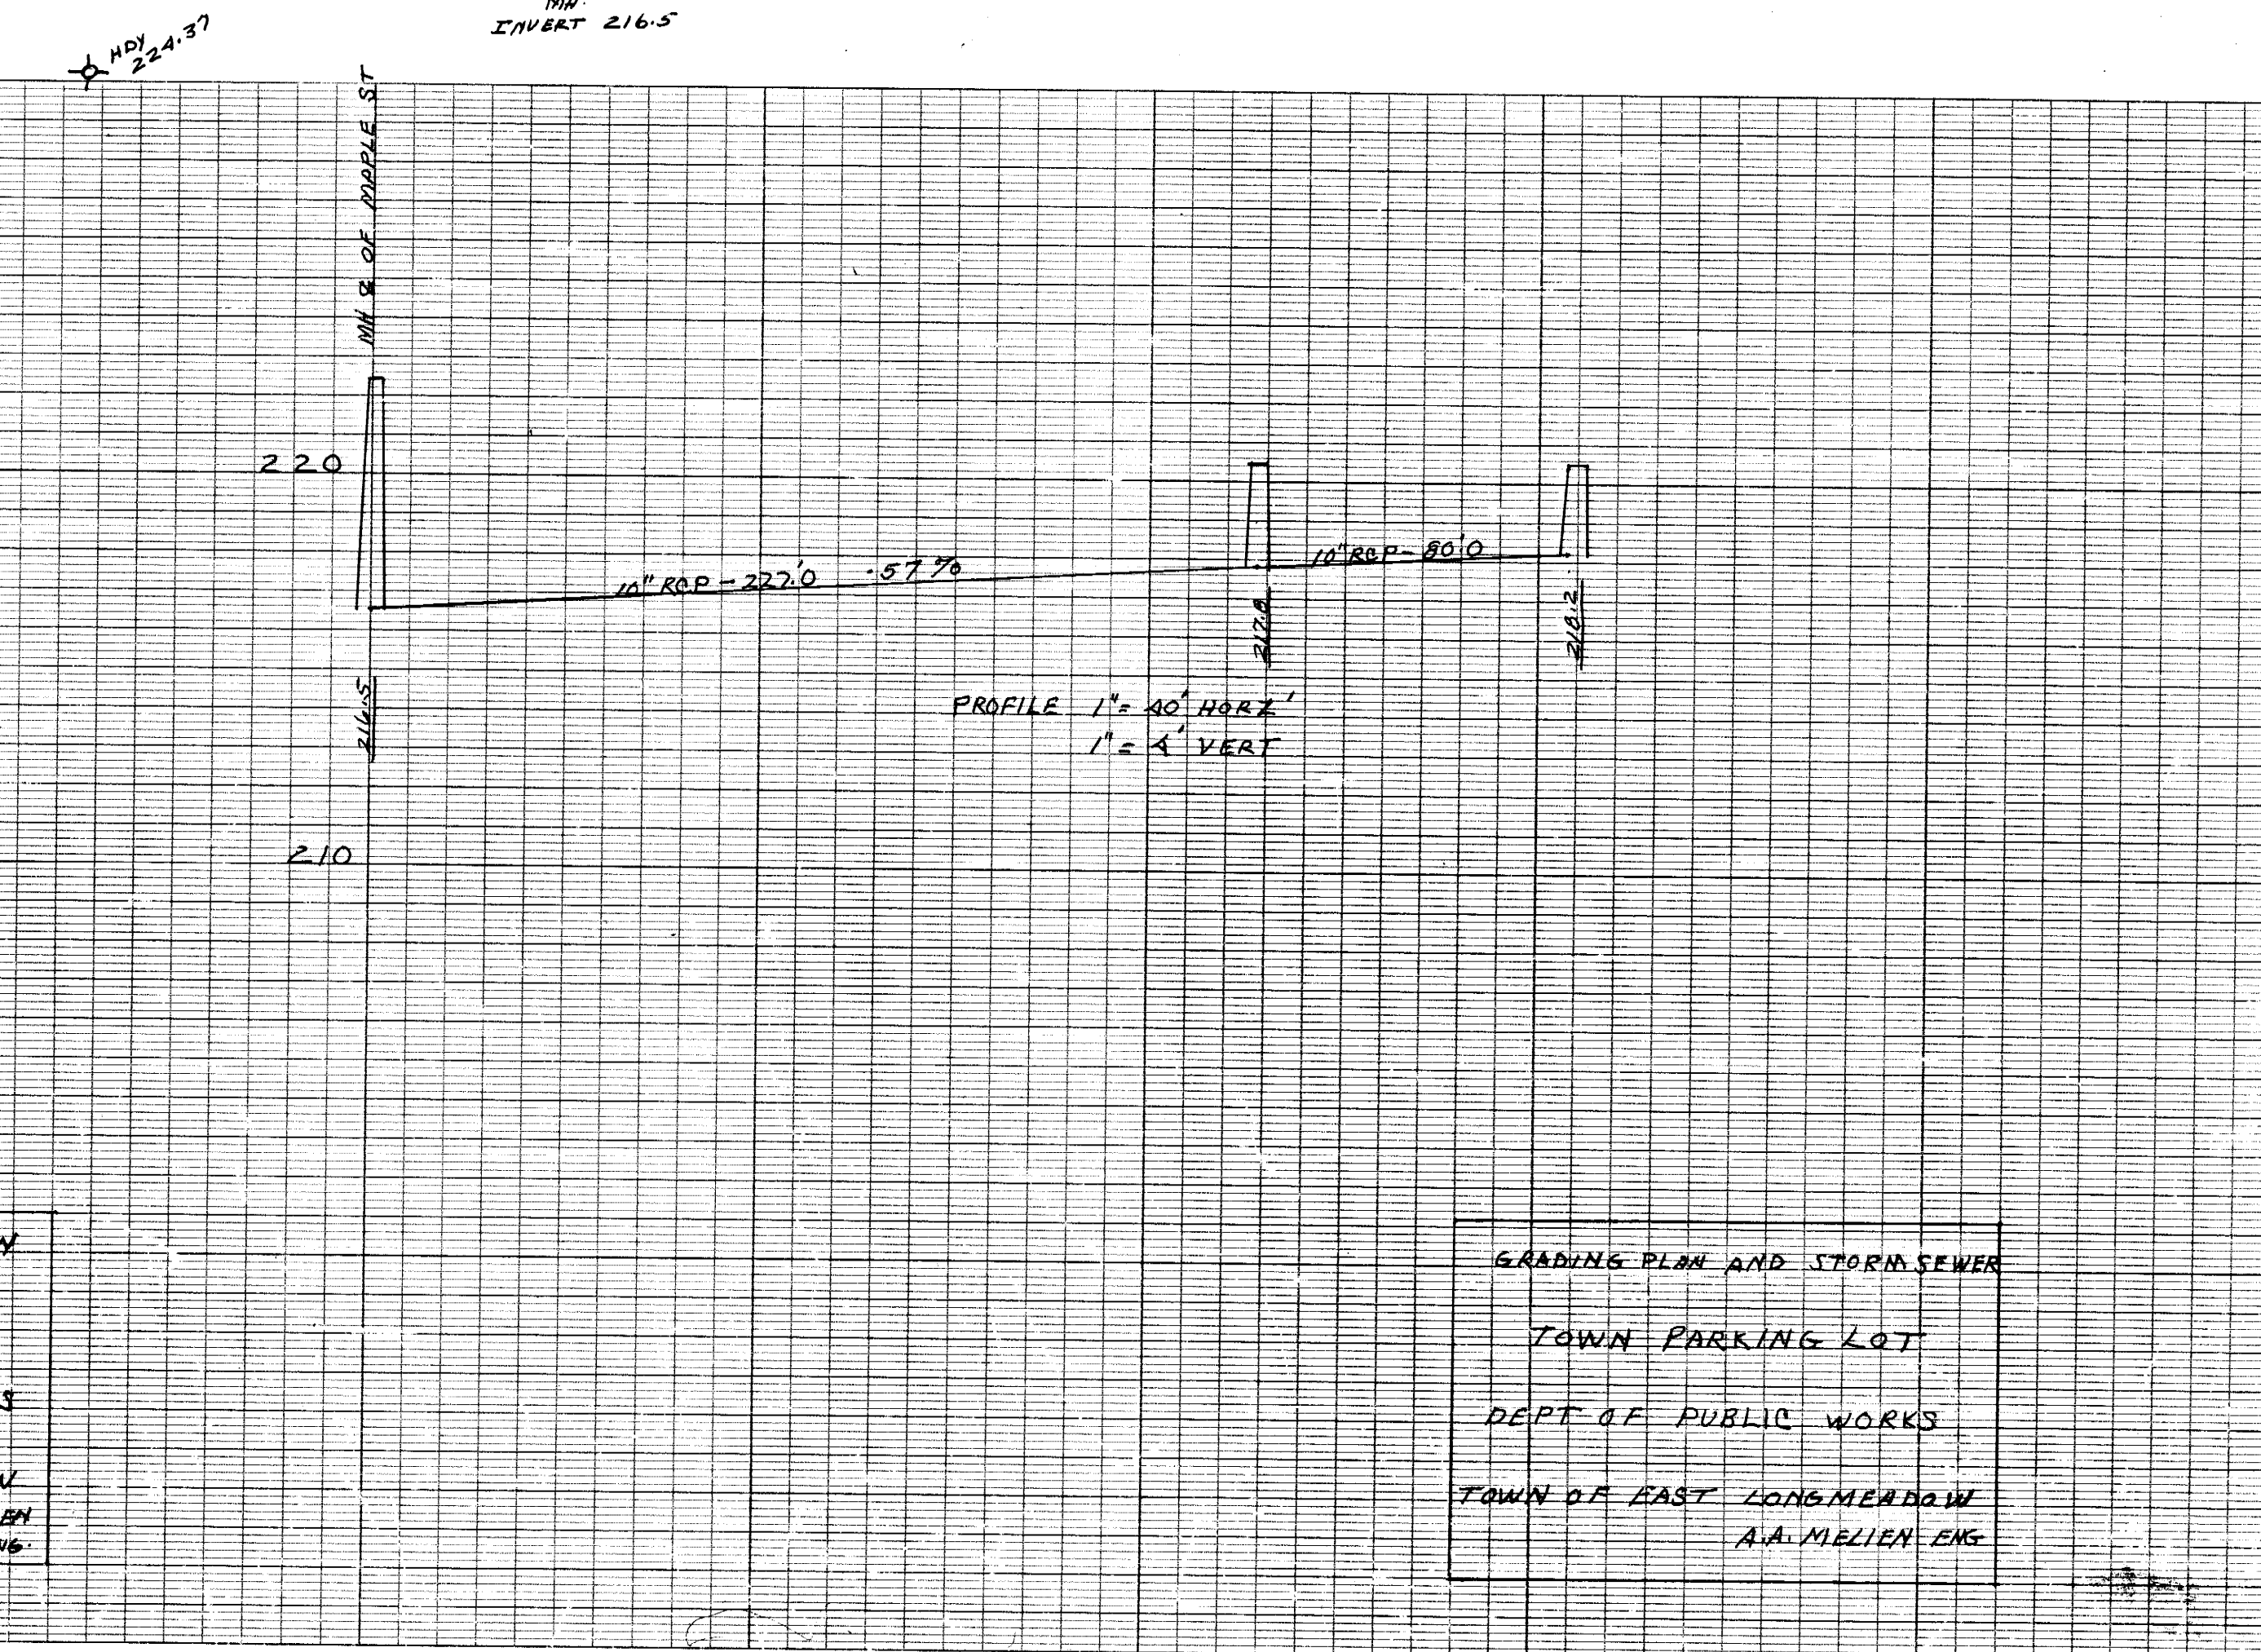

GRADING PLAN AND STORMSEWER
TOWN PARKING LOT
DEPT. OF PUBLIC WORKS
TOWN OF EAST LONGMEADOW
A.A. MELLON ENG.