




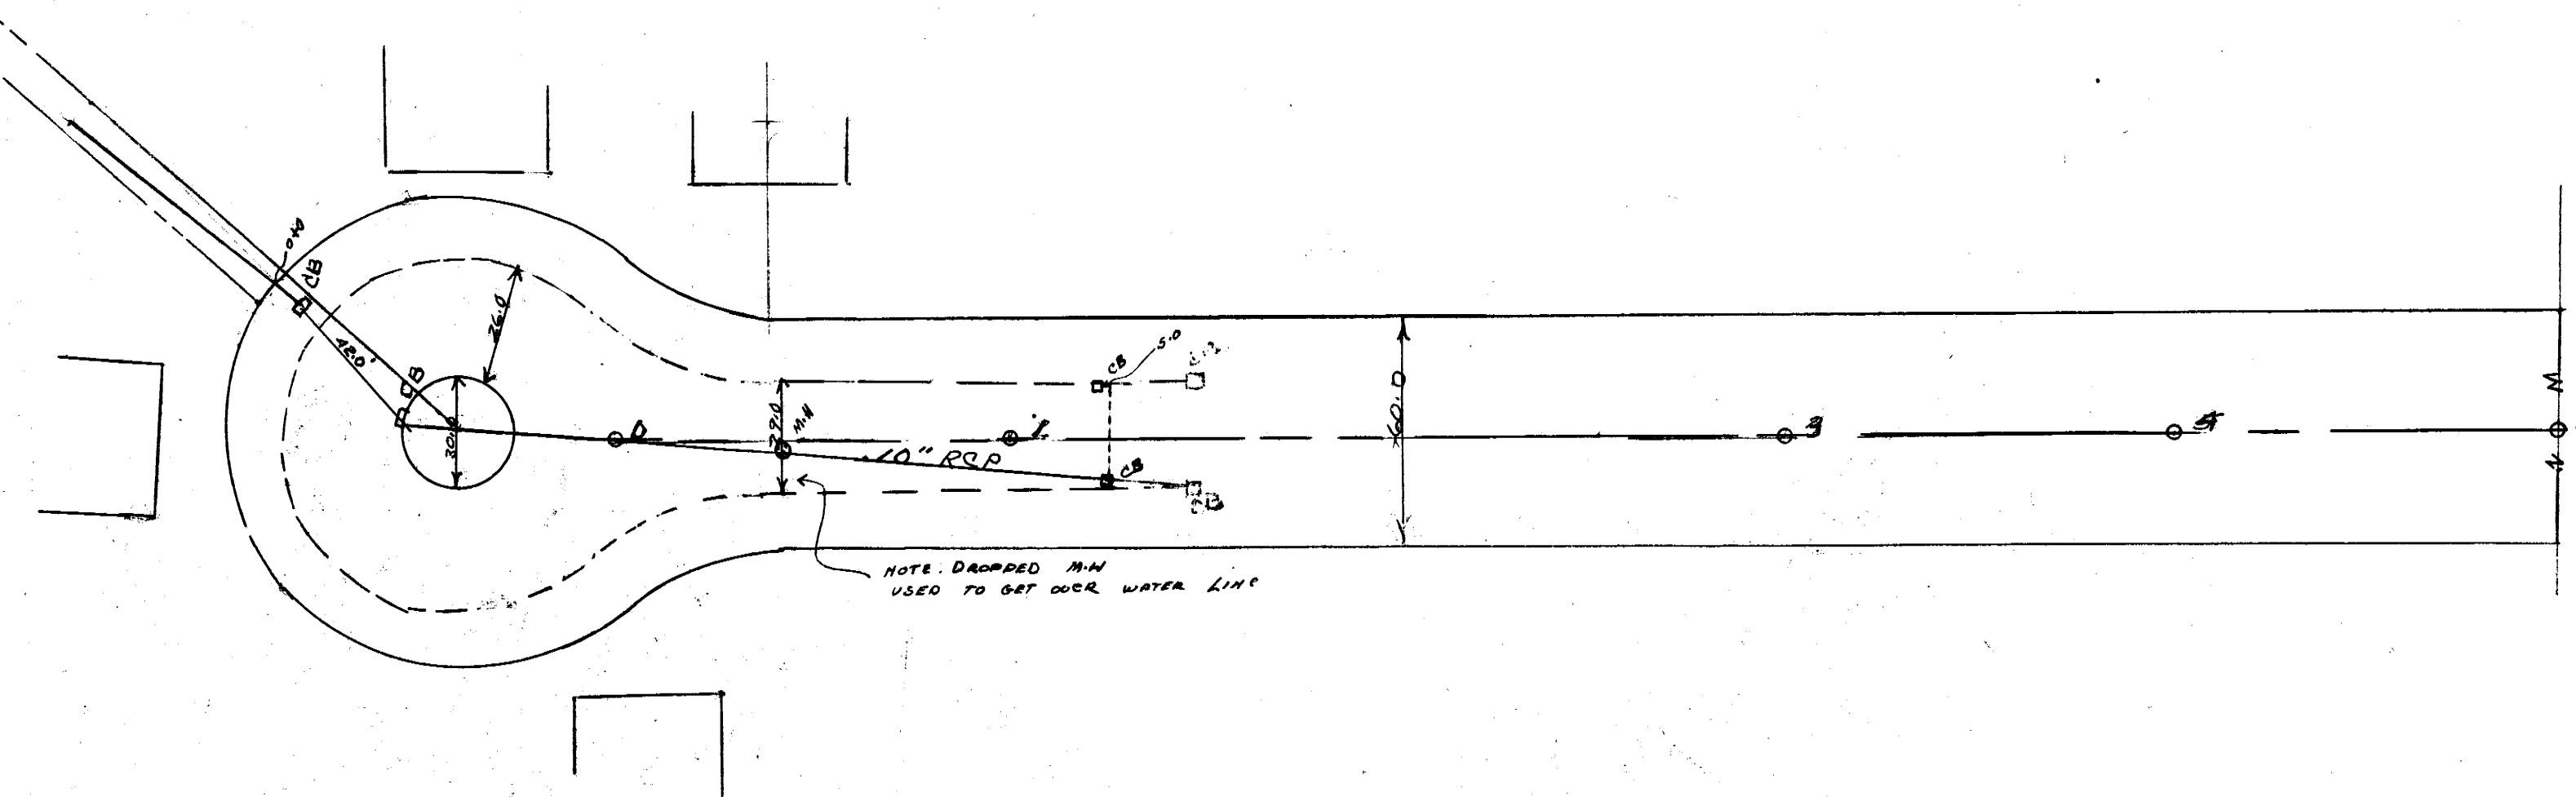


Knollwood Drive

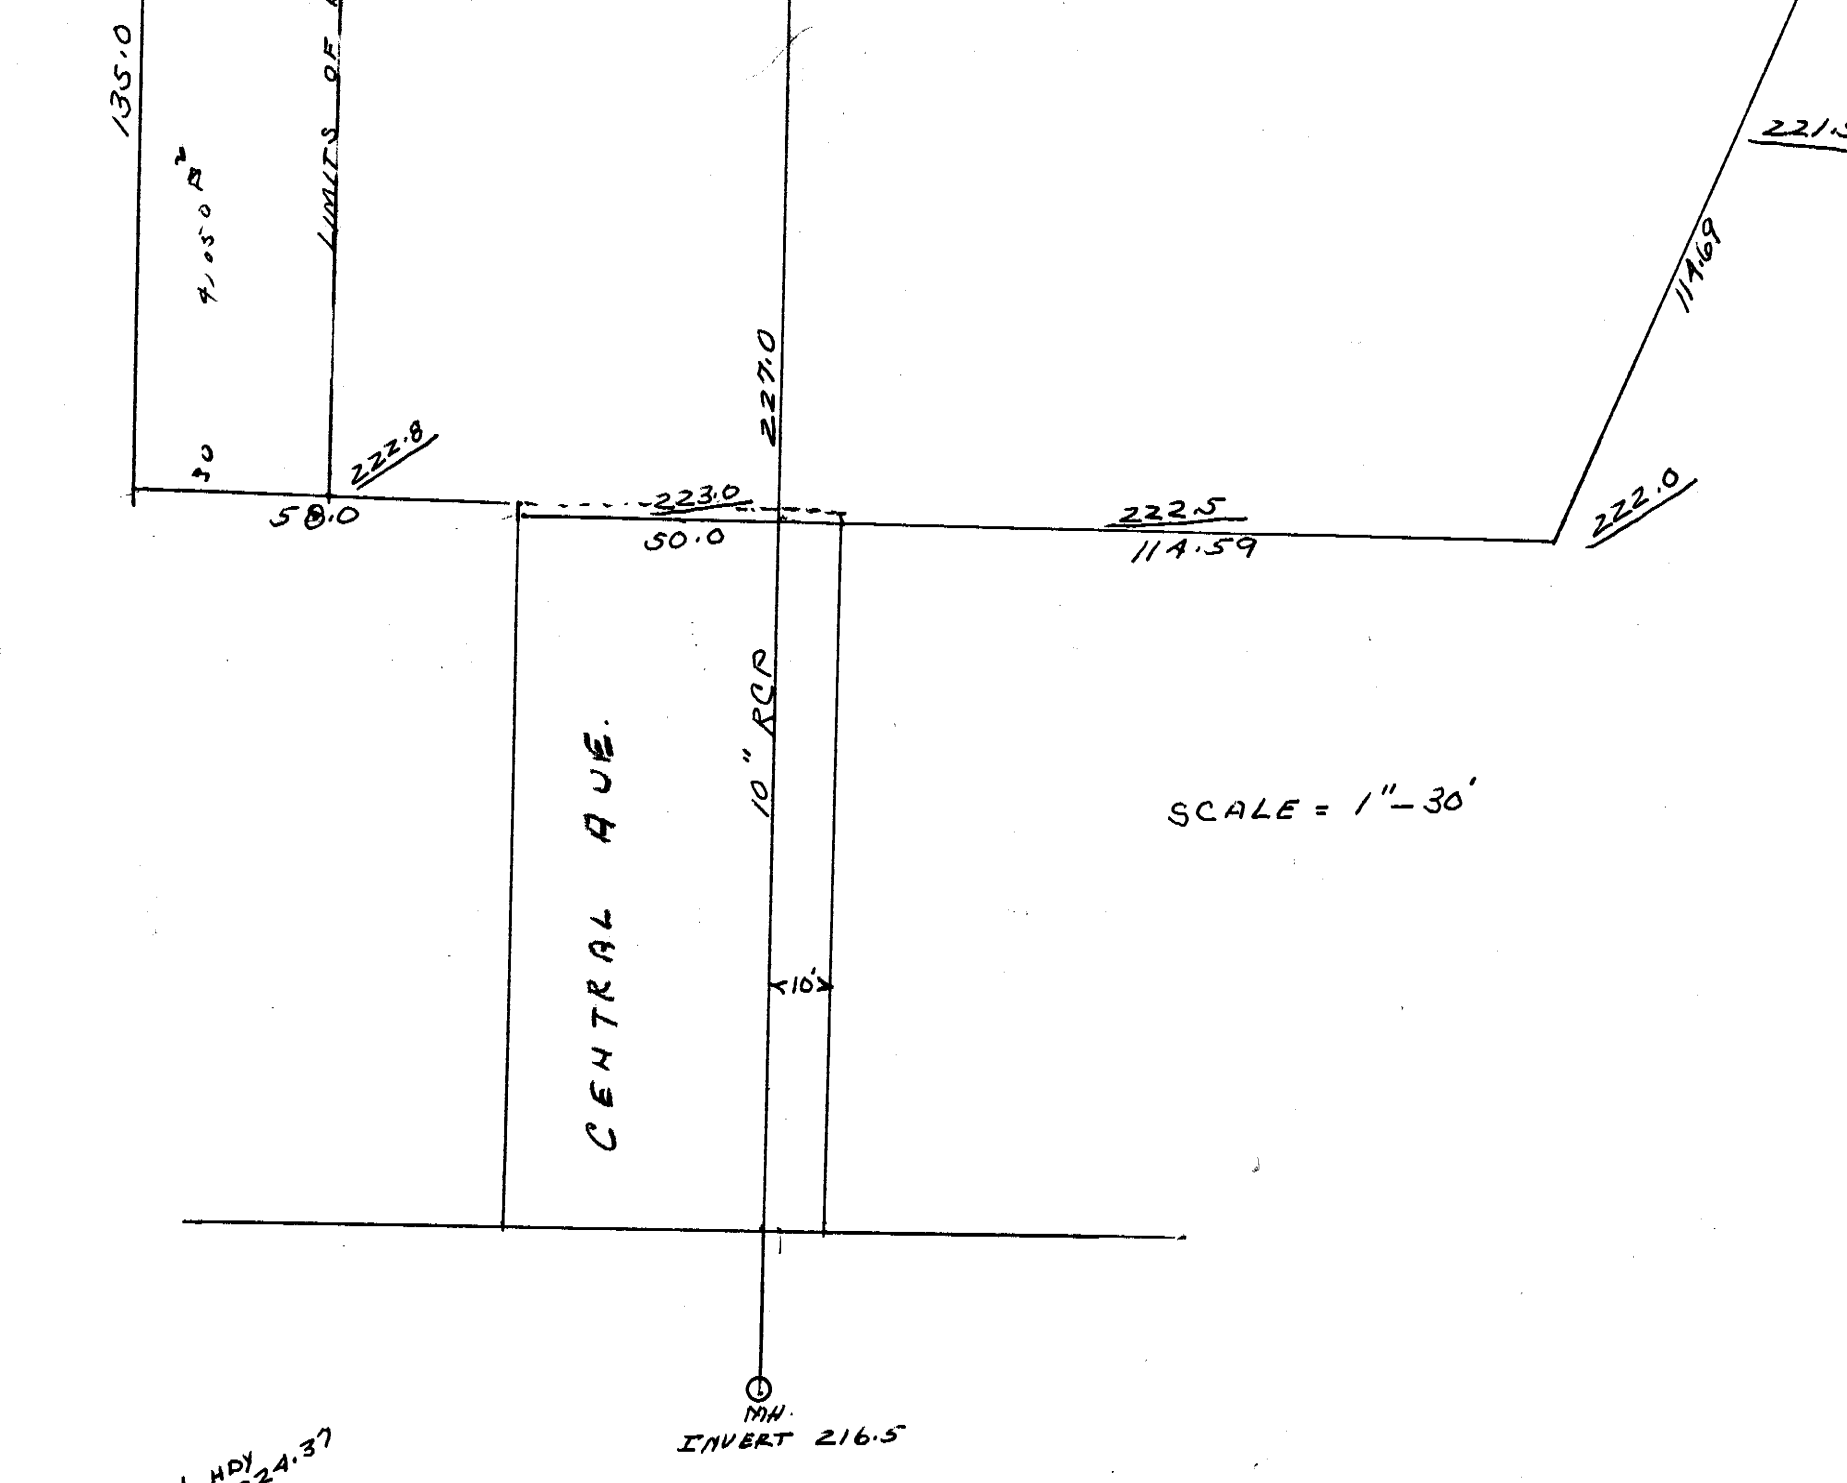

SCALE = 1" = 30'

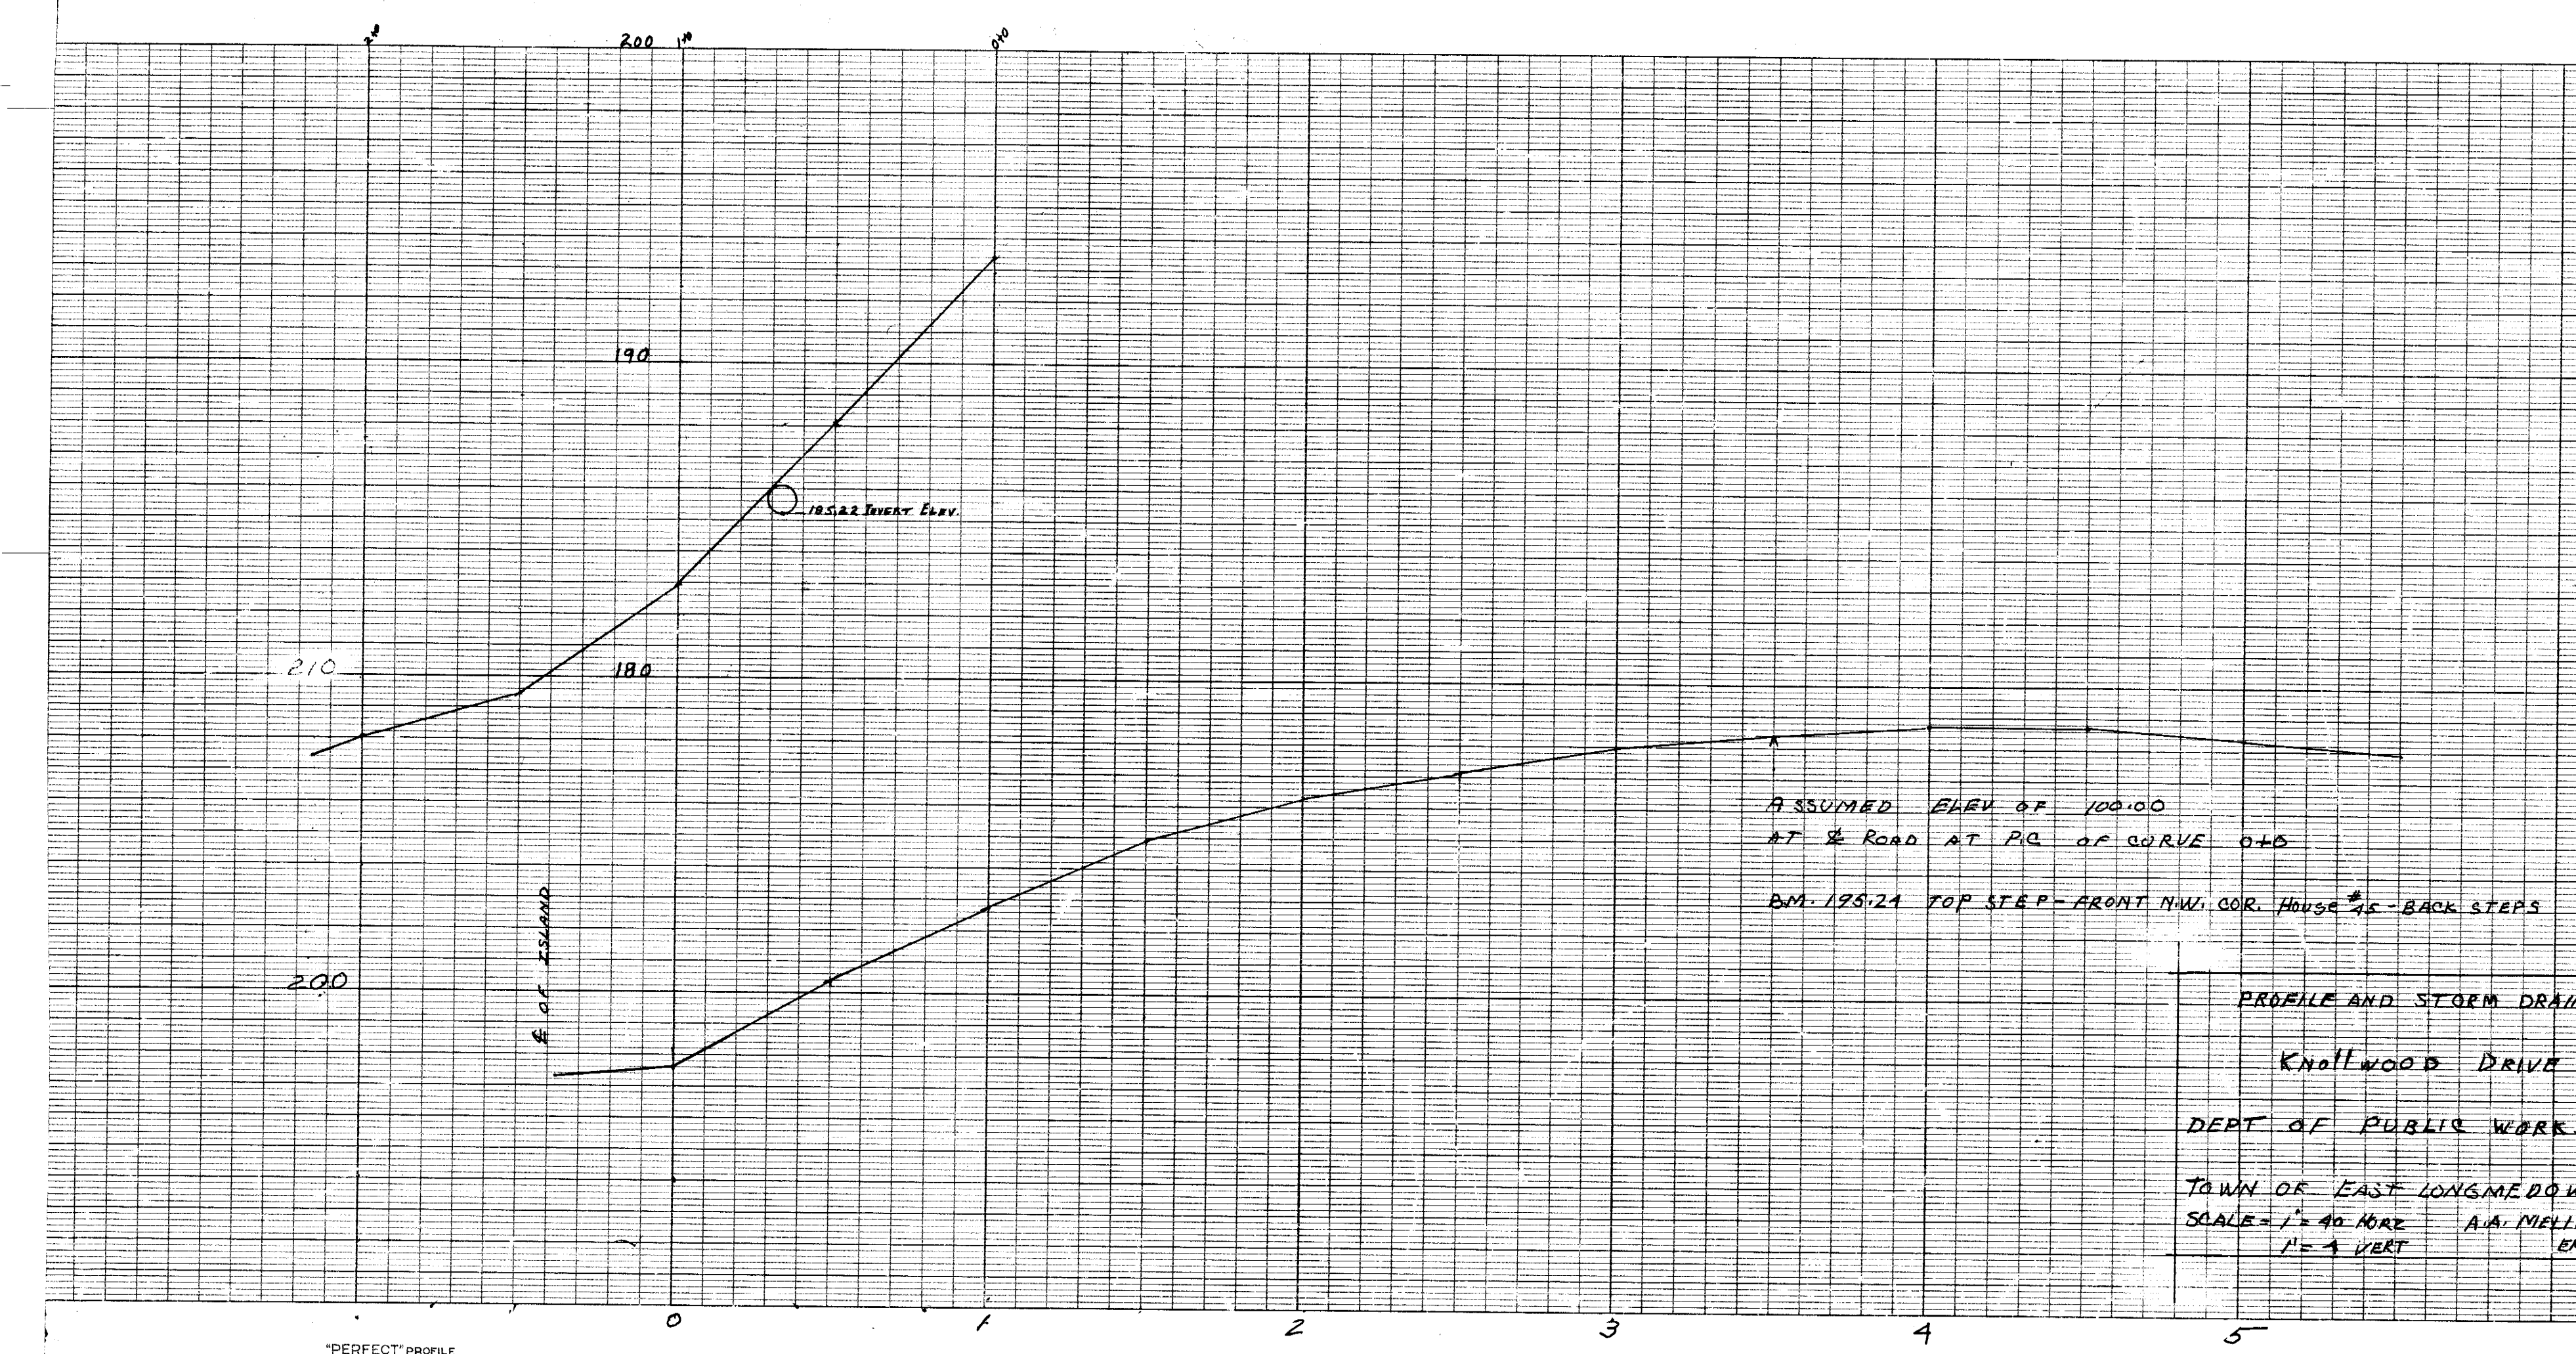

PROFILE AND STORM DRAIN
Knollwood Drive
DEPT. OF PUBLIC WORKS
TOWN OF EAST LONGMEADOW
SCALE = 1" = 40' HORIZ.
1" = 4' VERT
A.A. MELLON
ENG.

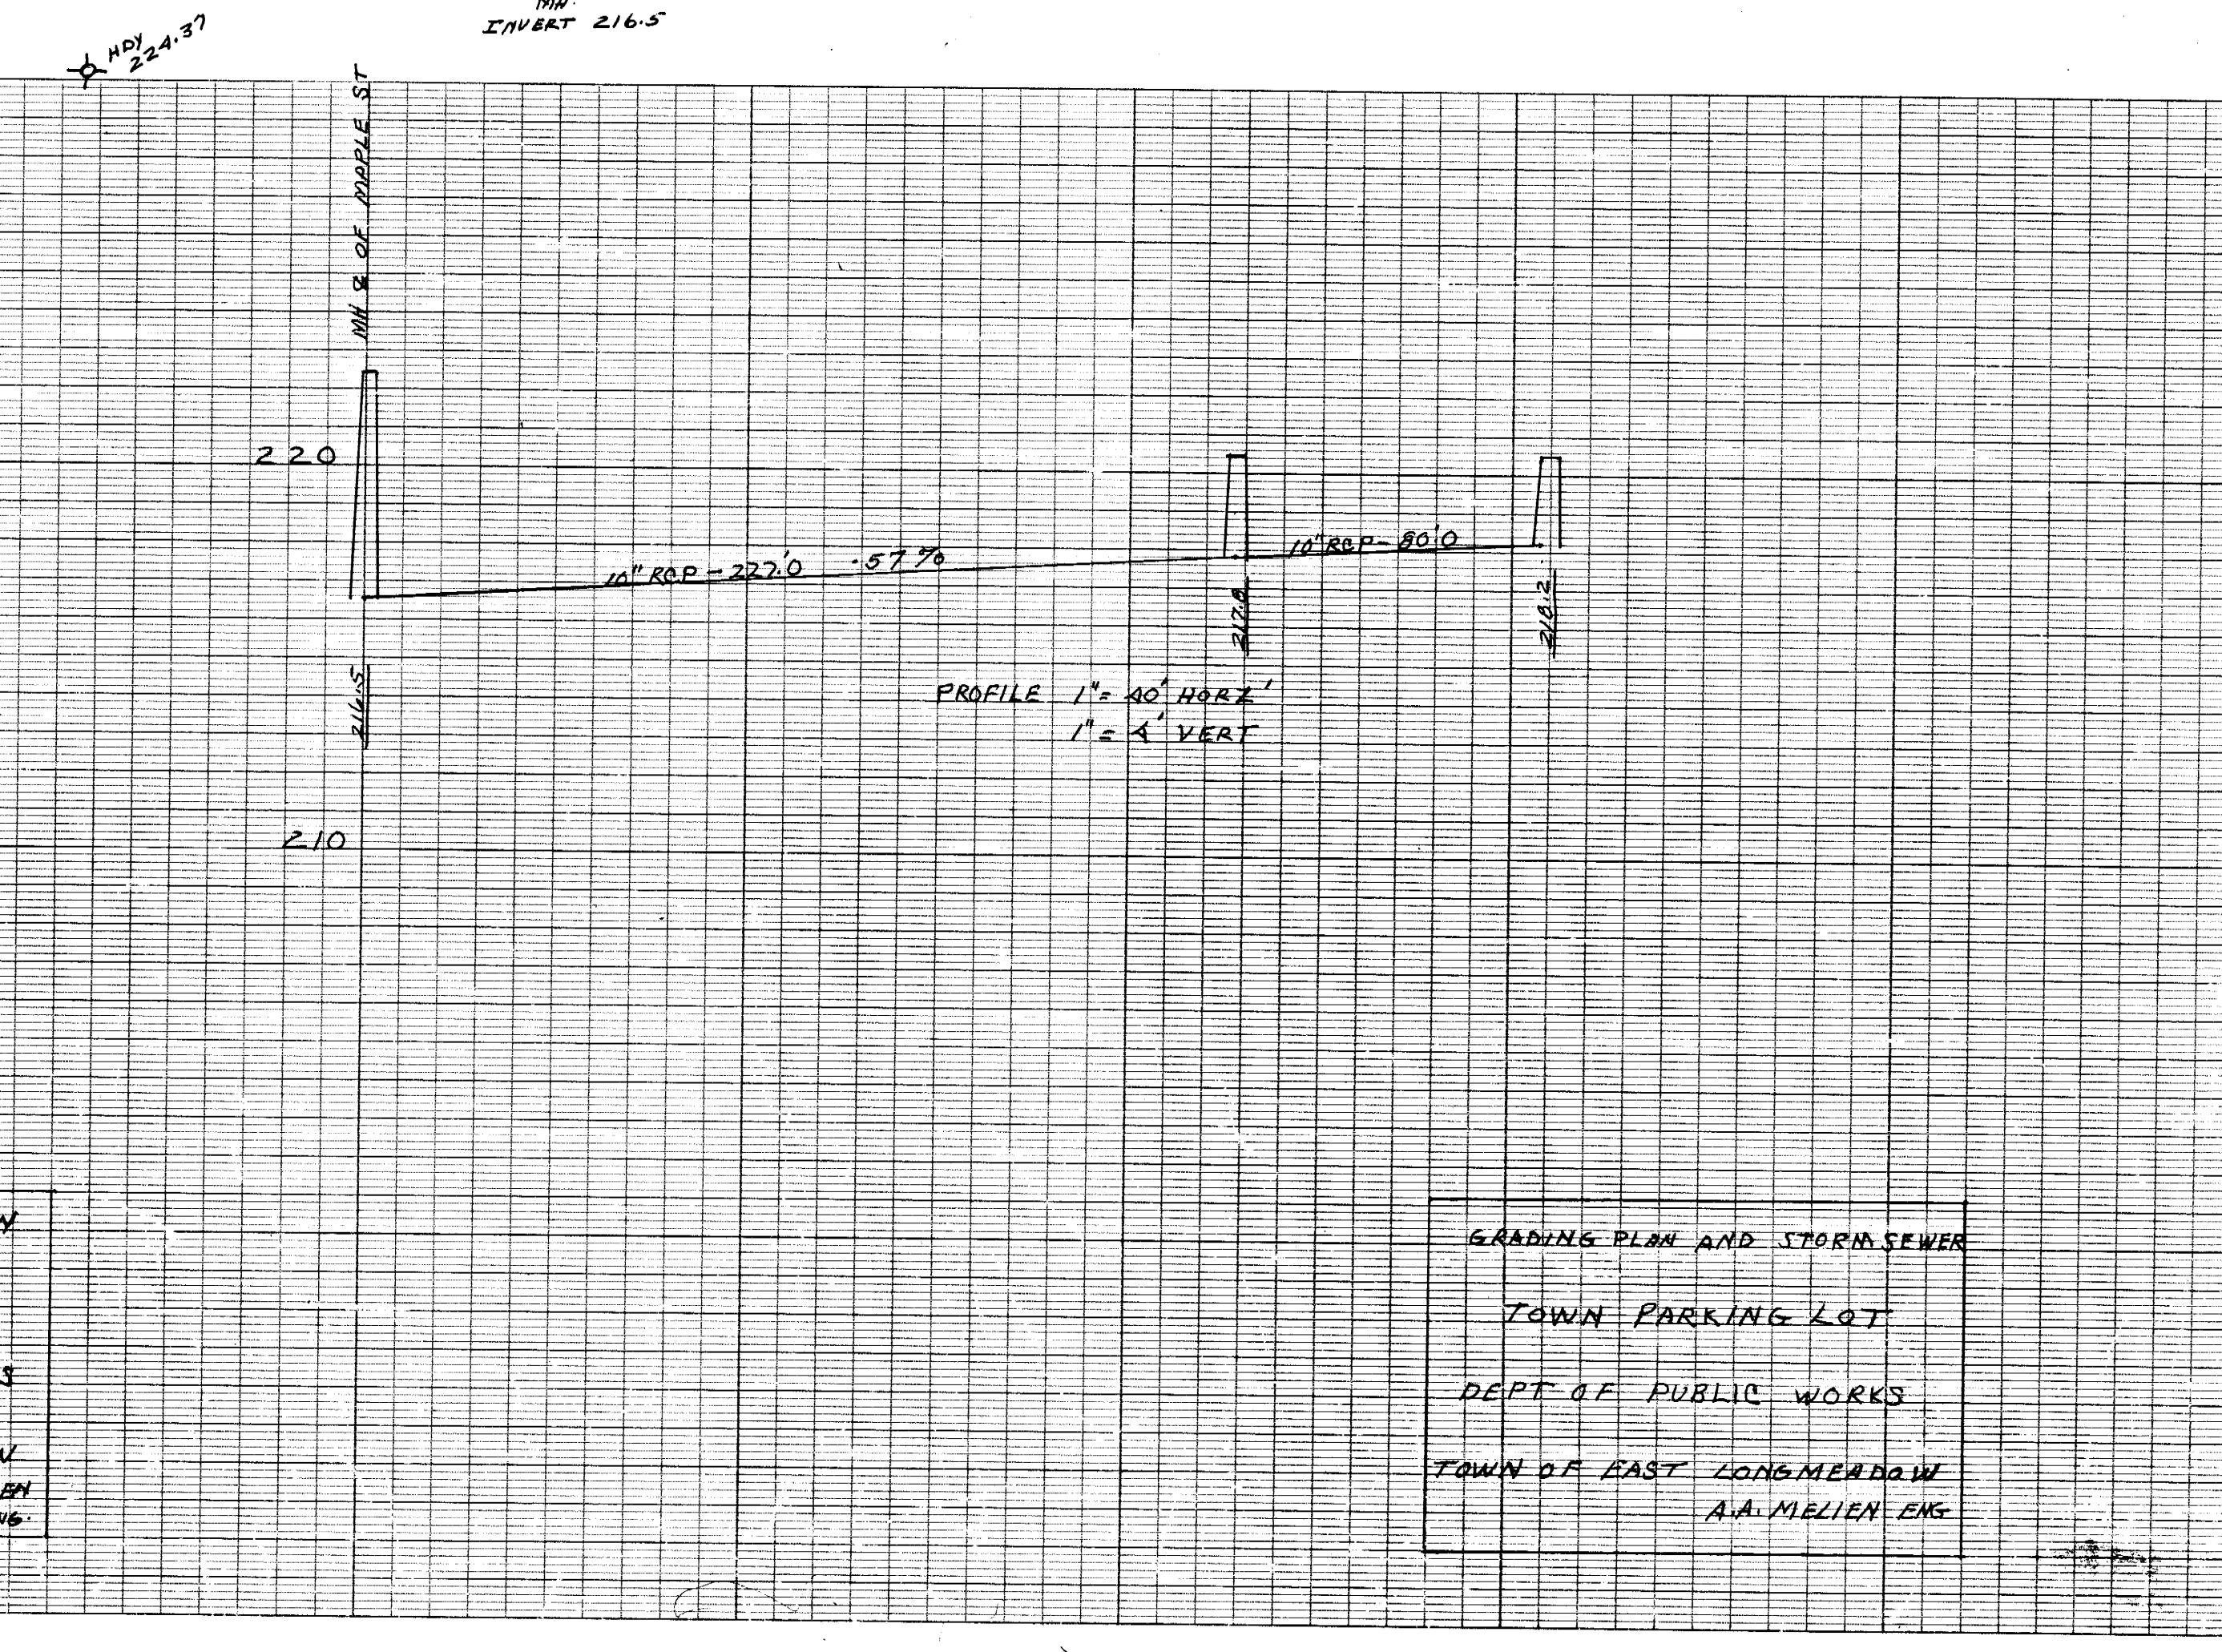

GRADING PLAN AND STORMSEWER
TOWN PARKING LOT
DEPT. OF PUBLIC WORKS
TOWN OF EAST LONGMEADOW
A.A. MELLON
ENG.