


$$\begin{array}{r} 258 \\ 367 \\ \hline 625 \\ \hline 432 \end{array}$$
$$\begin{array}{r} 96 \\ 3 \overline{) 93} \\ \underline{93} \\ 0 \end{array}$$

١٠٠



240' of 12"
435' of 10"
100' of 8"
8 - C.B
1 - M.H.-

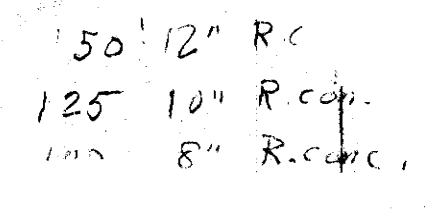