
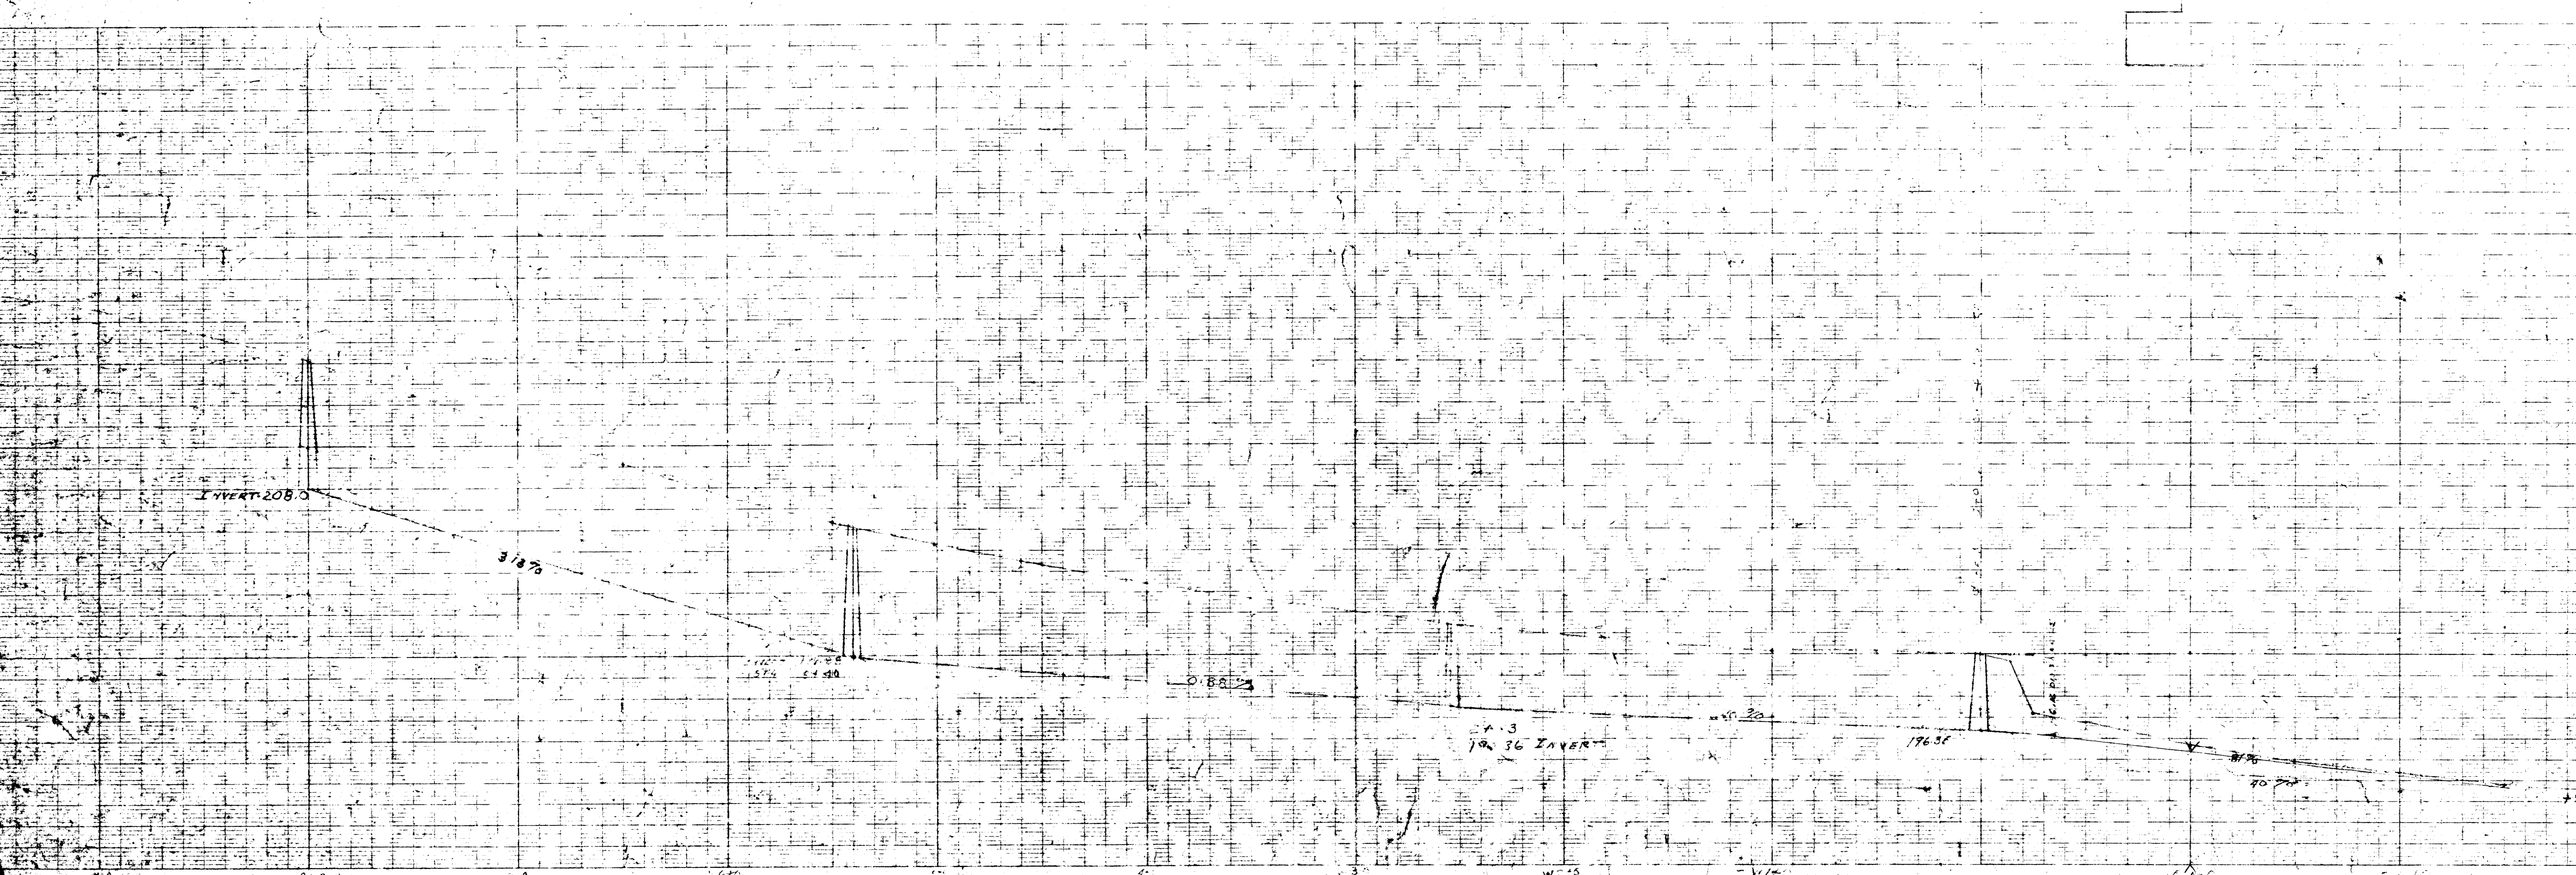


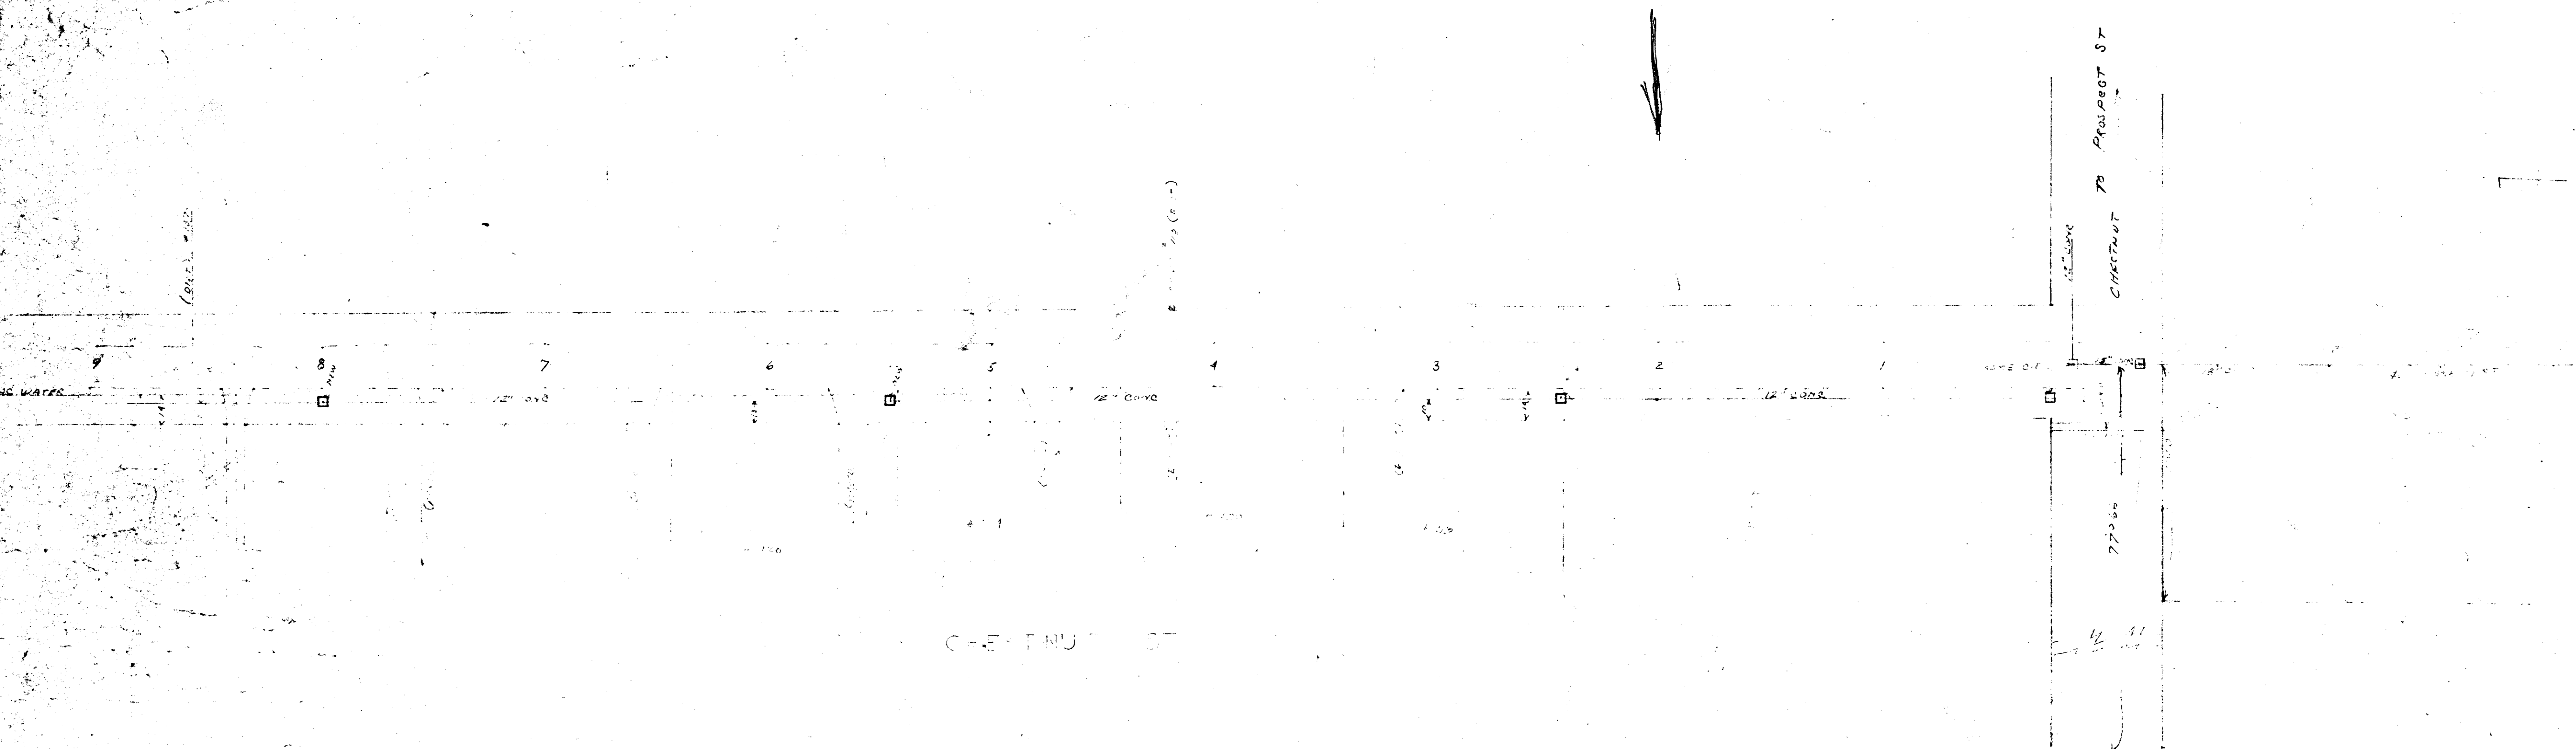

PLAN AND PROFILE
 ST. NUS ST
 TOWN OF EAST LON MEADOW
 OCT 1959
 AA WE TEN

SD 72

PERFECT PROFILE
 PLATE 1
 EUGENE DIETZEN CO

PRINTED IN U.S.A.
 ON 30% MAG PAPER MADE IN U.S.A.

PERFECT PROFILE
 PLATE 1
 EUGENE DIETZEN CO