


SCALE 1" = 40' HORZ
1" = 4' VERT

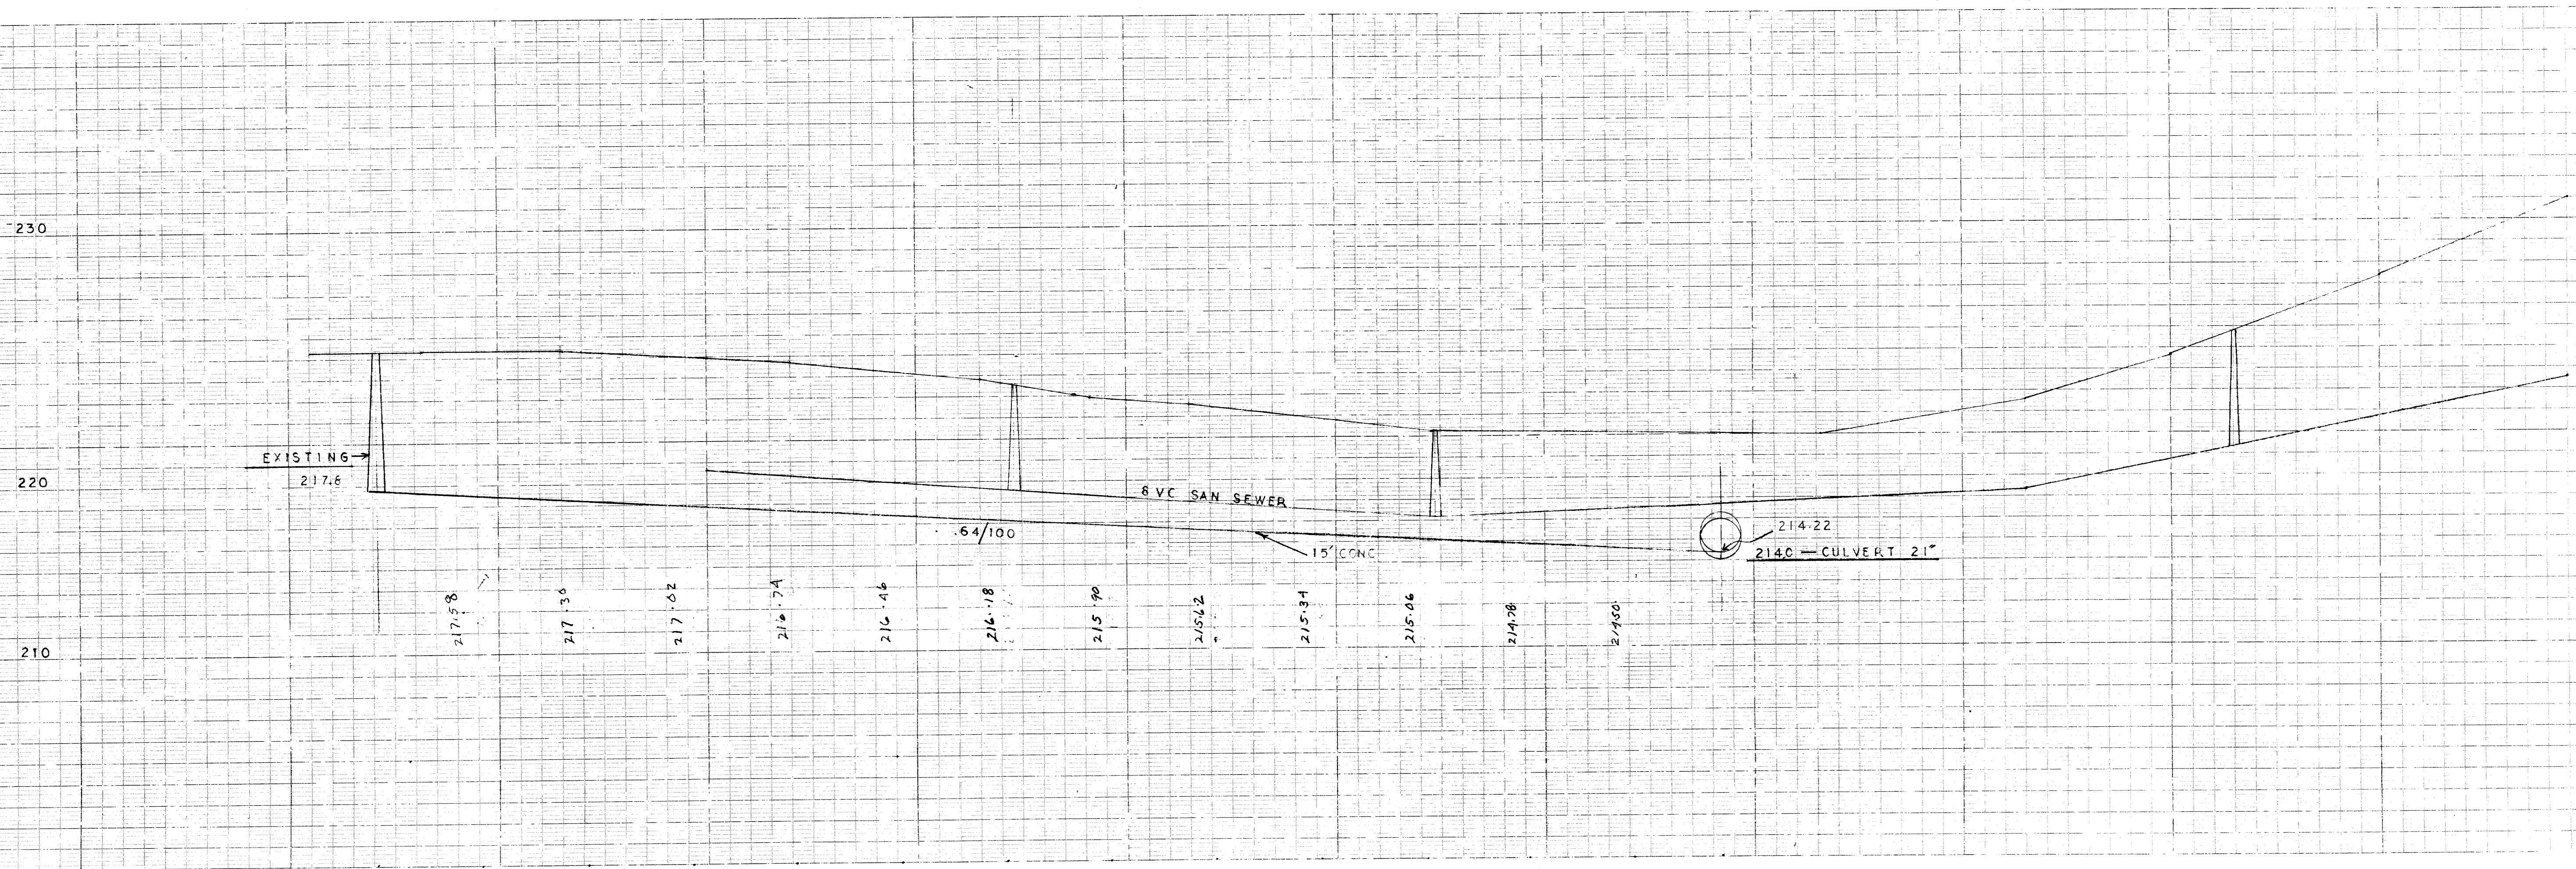

EDMUND STREET