



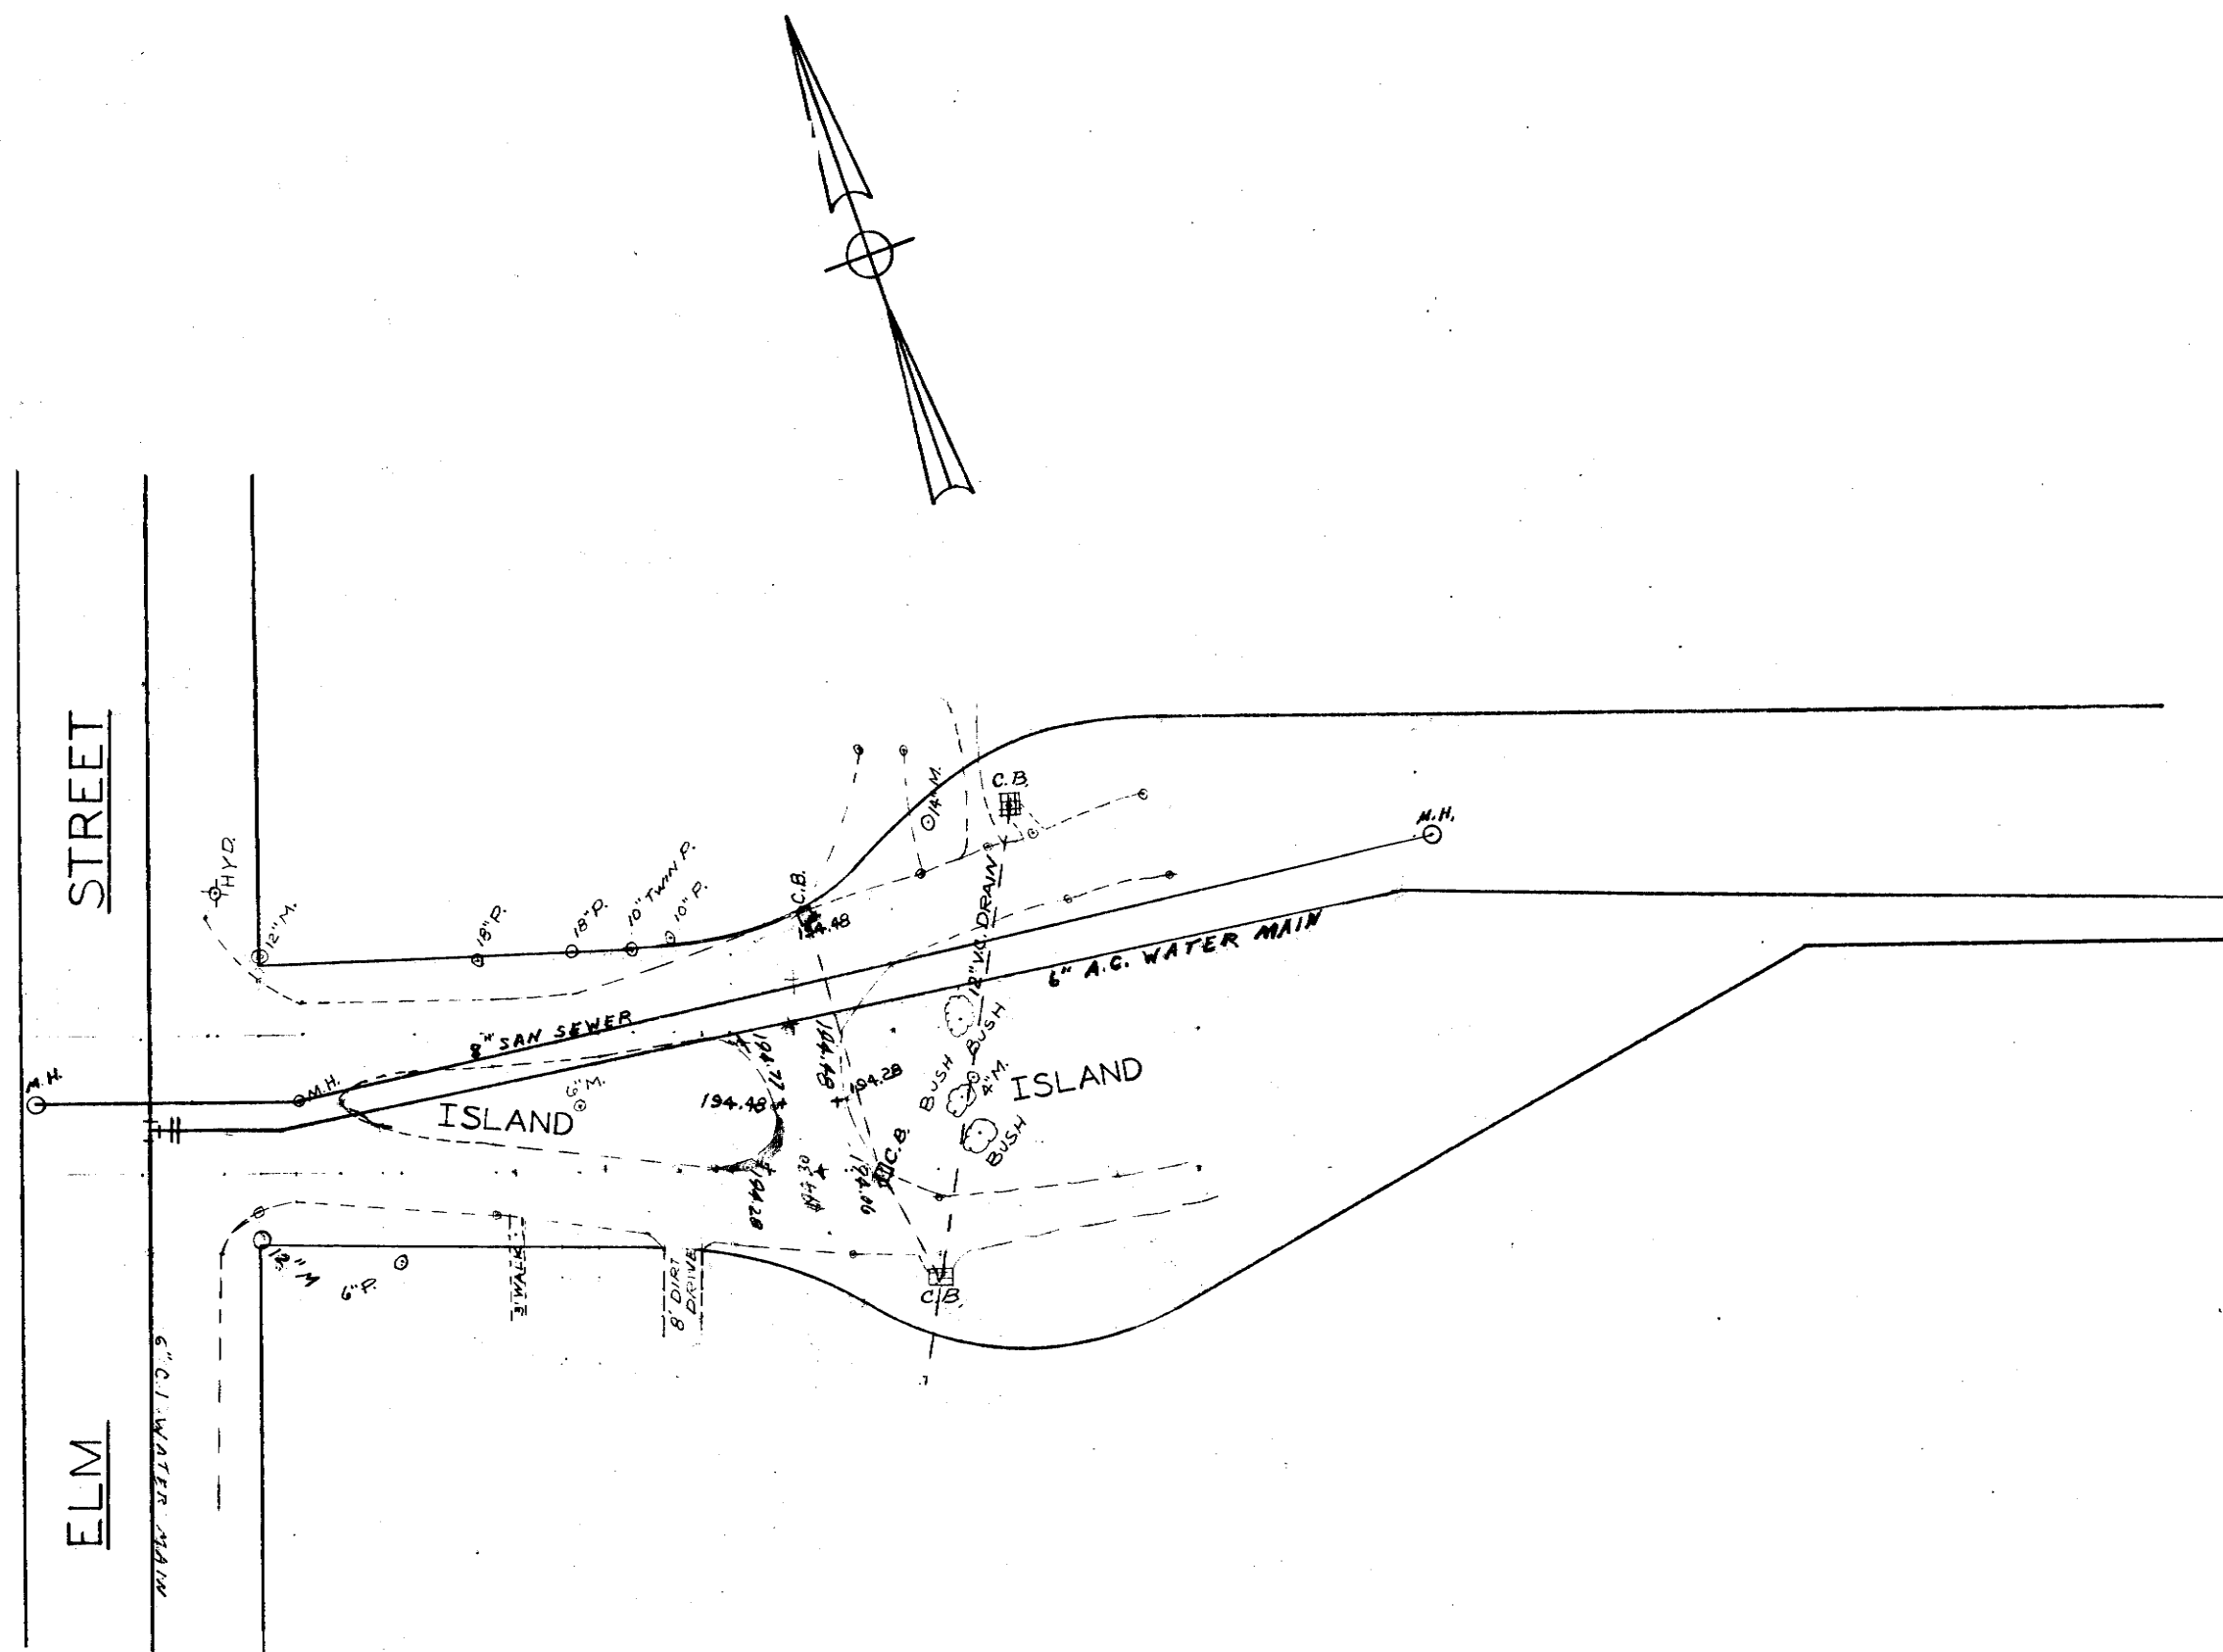

SCALE: 1" = 40' HORIZ.
1" = 4' VERT.

BENCH: TOP OF HYD SPINDLE EAST SIDE OF ELM-ELEV. 200.00 (ASSUMED)

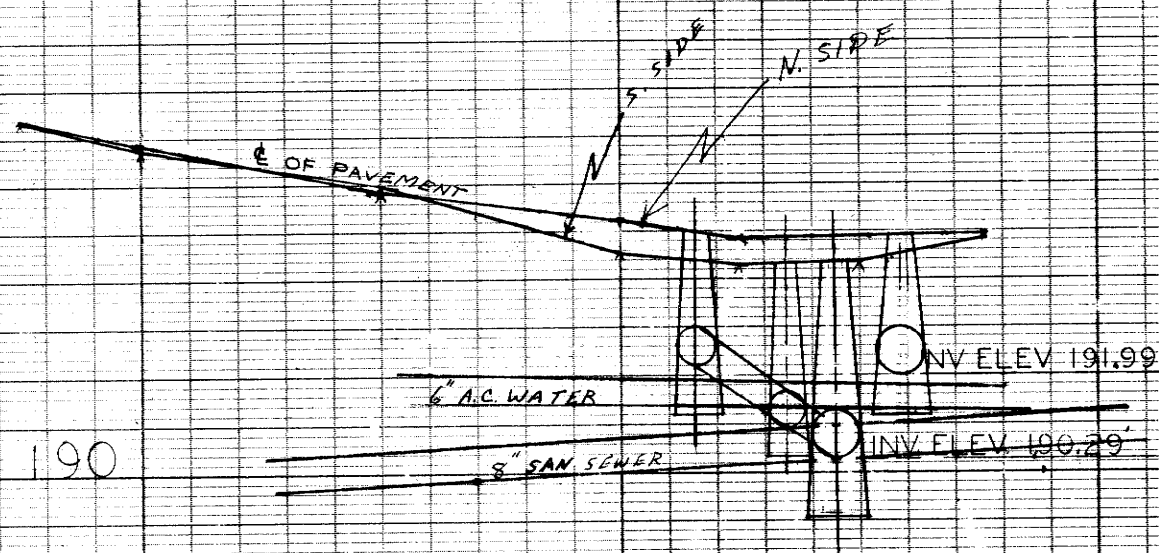

PLAN SHOWING PLAN & PROFILE
TAYLOR STREET
DEPT OF PUBLIC WORKS, AMELIEN-ENG.
TOWN OF EAST LONGMEADOW, MASS.
SCALE: 1" = 40' SEPT. 1, 1960

TAYLOR STREET

SD-78